


Fed. Proj. No.

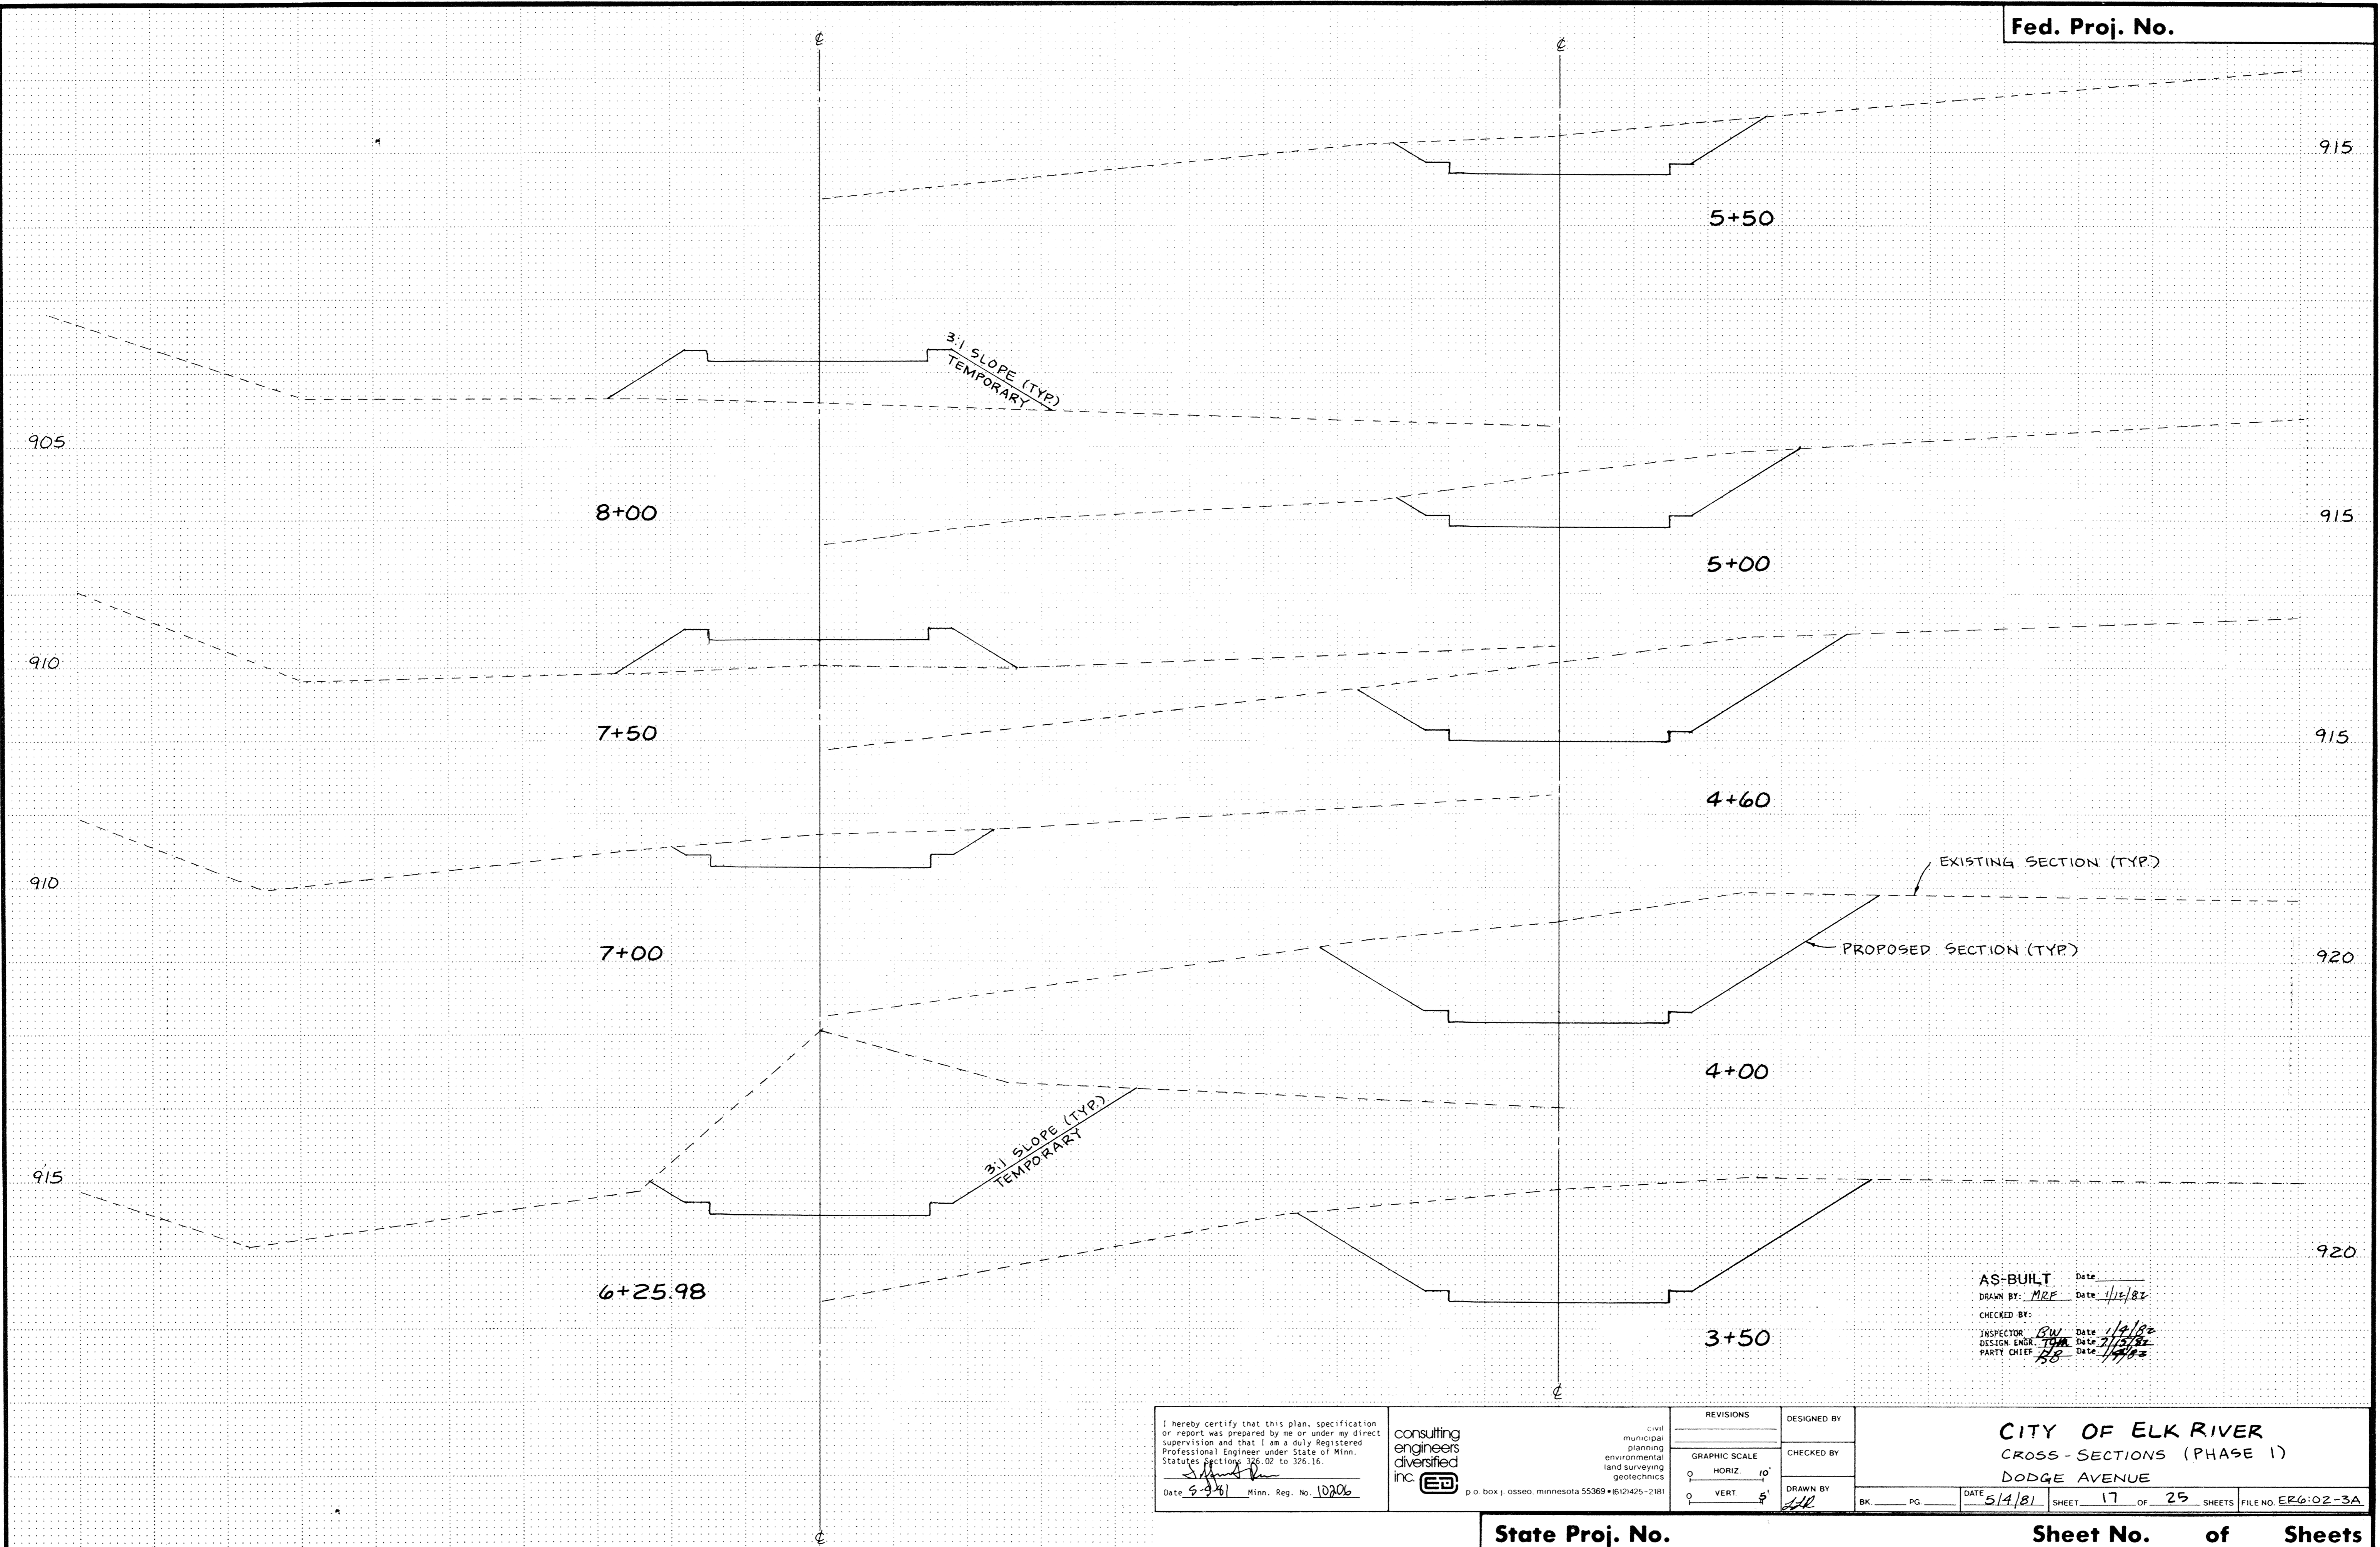

AS-BUILT Date _____
 DRAWN BY: MRF Date 1/12/82
 CHECKED BY: _____
 INSPECTOR: RW Date 1/14/82
 DESIGN ENGR: TMM Date 7/15/82
 PARTY CHIEF: RB Date 1/14/82

I hereby certify that this plan, specification or report was prepared by me or under my direct supervision and that I am a duly Registered Professional Engineer under State of Minn. Statutes sections 326.02 to 326.16.
 Date 5-9-81 Minn. Reg. No. 10206

consulting engineers diversified inc. p.o. box 1 osseo, minnesota 55369 • (612) 425-2181
 Civil municipal planning environmental land surveying geotechnics

REVISIONS	

DESIGNED BY	CITY OF ELK RIVER	
CHECKED BY	CROSS-SECTIONS (PHASE 1)	
DRAWN BY	DODGE AVENUE	
DATE	5/14/81	SHEET 17 OF 25 SHEETS FILE NO. ERG-02-3A