


Fed. Proj. No.

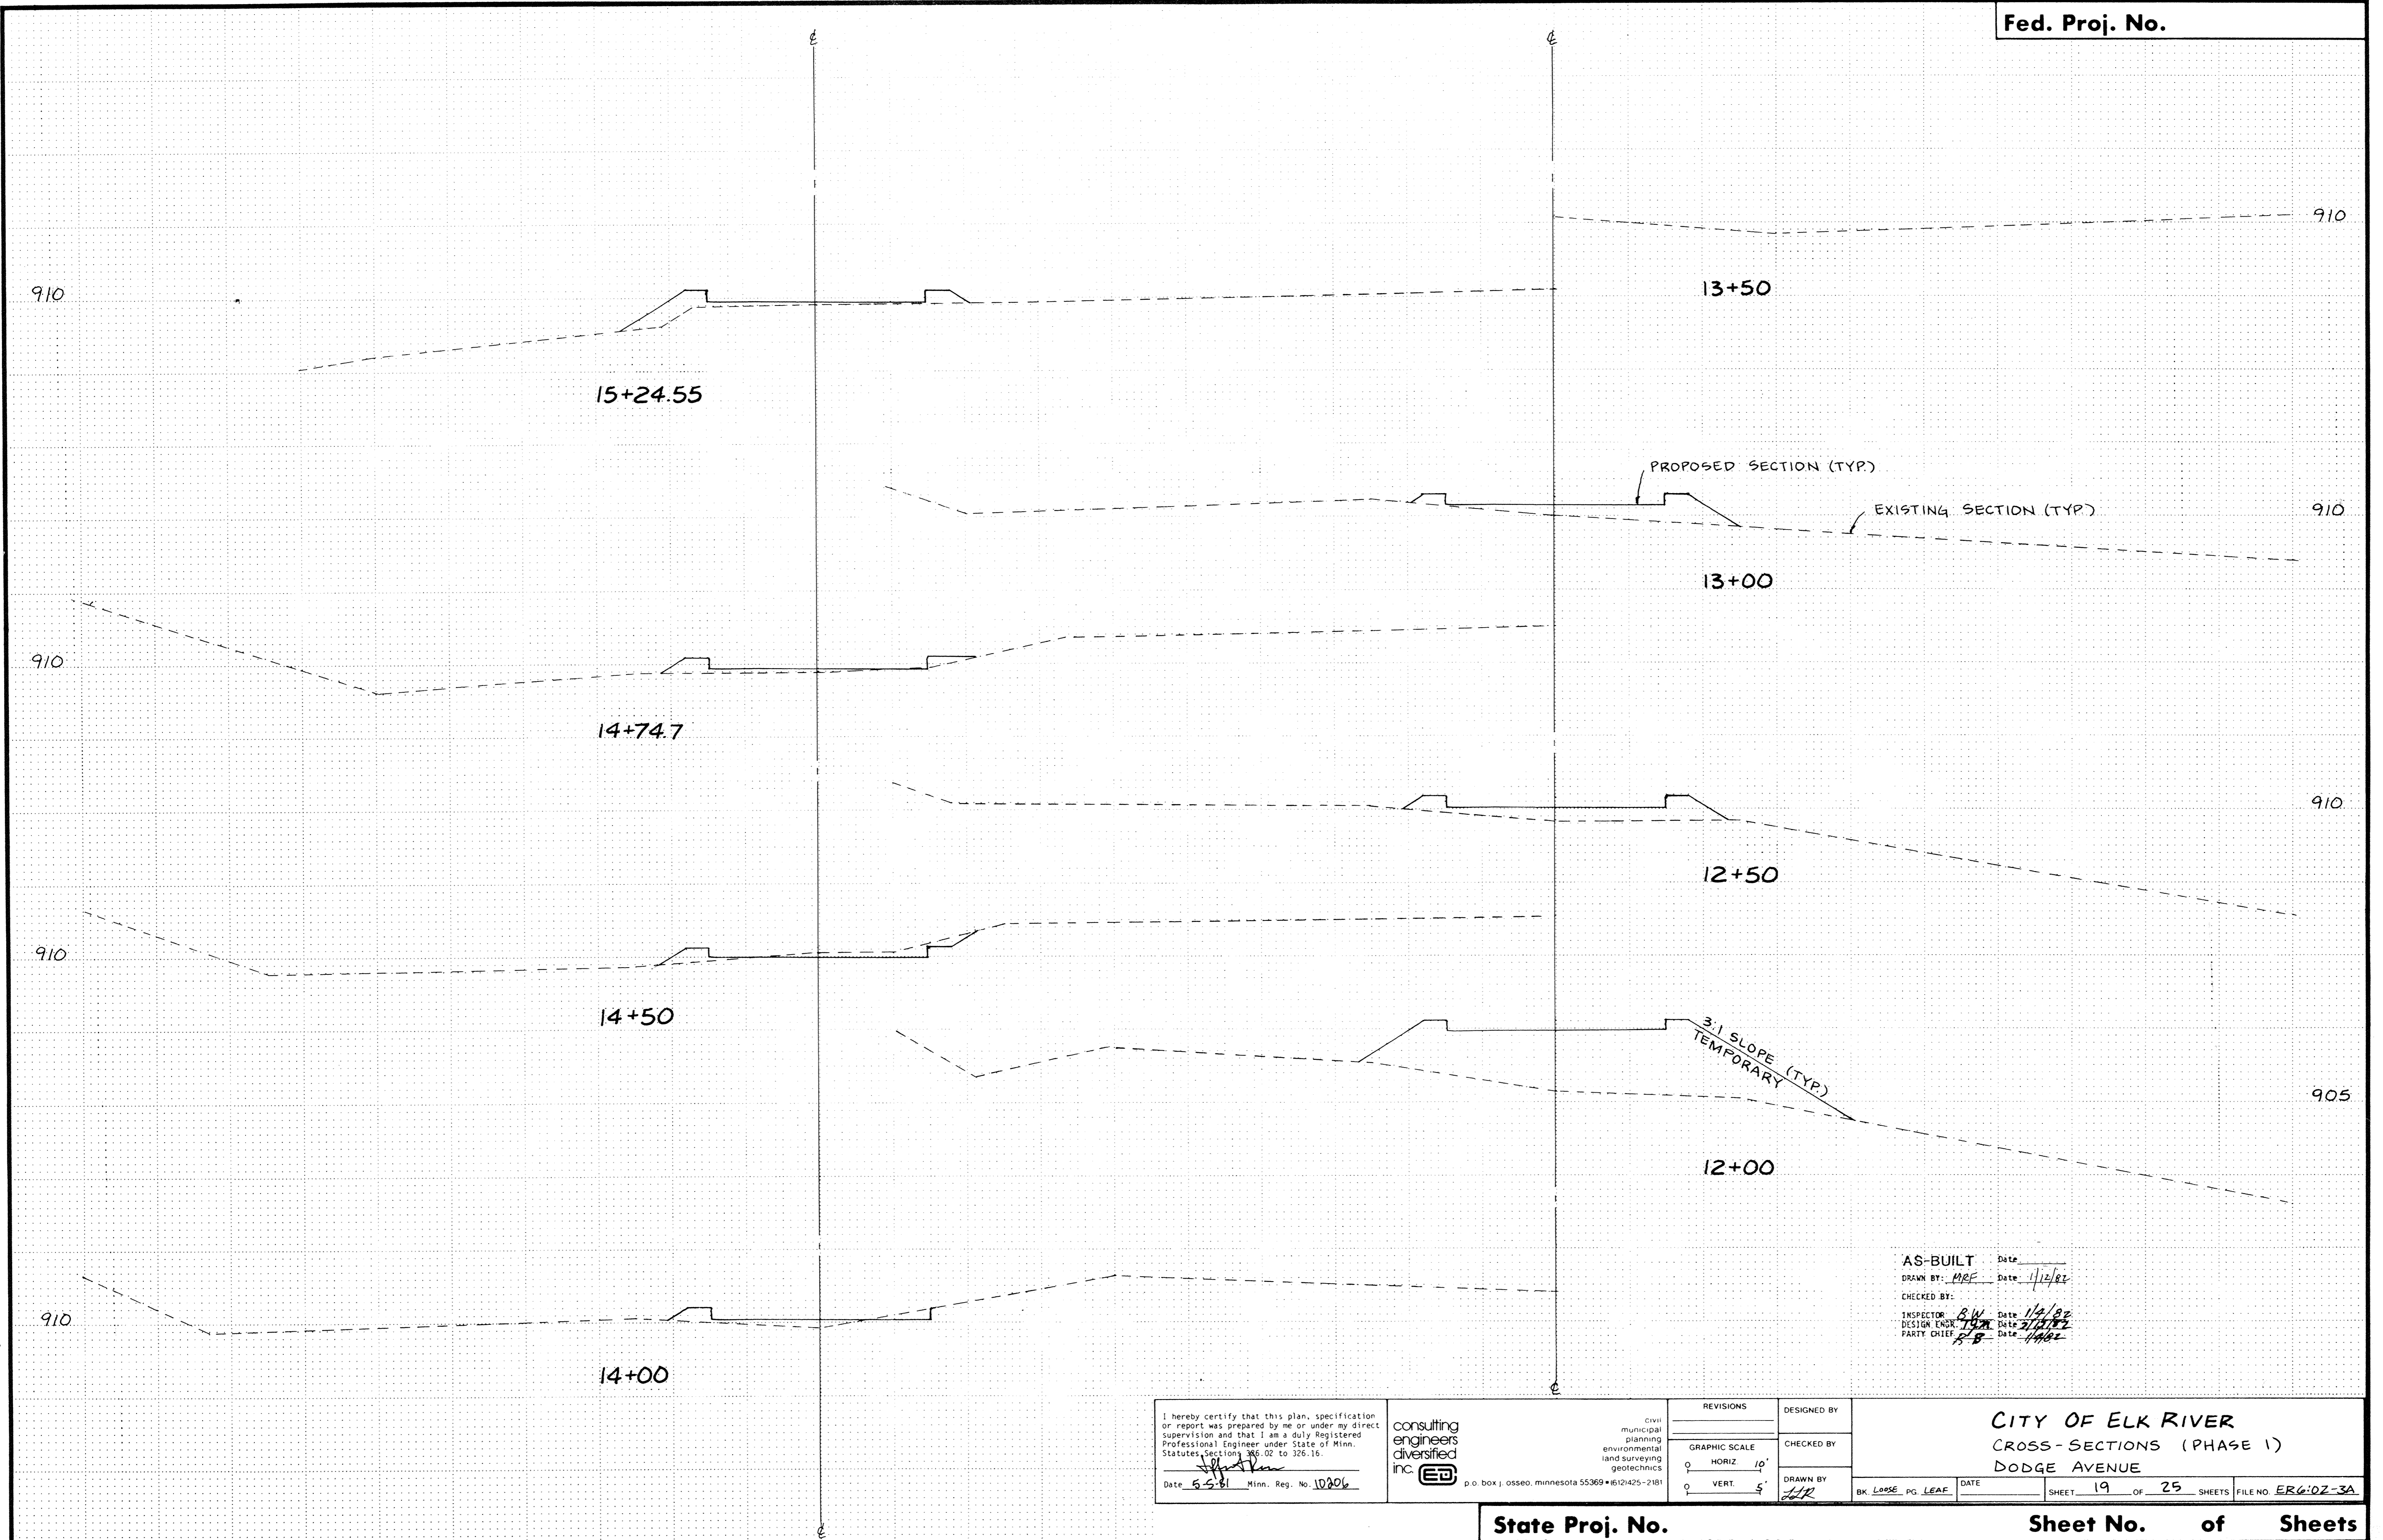

AS-BUILT Date _____
 DRAWN BY: MFE Date: 1/12/02
 CHECKED BY: _____
 INSPECTOR: RW Date: 1/16/02
 DESIGN ENGR: TR Date: 3/15/02
 PARTY CHIEF: PS Date: 1/16/02

I hereby certify that this plan, specification or report was prepared by me or under my direct supervision and that I am a duly Registered Professional Engineer under State of Minn. Statutes Sections 326.02 to 326.15.
[Signature]
 Date 5-5-01 Minn. Reg. No. 10206

consulting engineers diversified inc. p.o. box j, osseo, minnesota 55369 • (612) 425-2181
 civil municipal planning environmental and surveying geotechnics

REVISIONS	DESIGNED BY
GRAPHIC SCALE	CHECKED BY
0 HORIZ 10'	DRAWN BY
0 VERT 5'	<u>[Signature]</u>

CITY OF ELK RIVER
CROSS-SECTIONS (PHASE 1)
DODGE AVENUE
 BK LOOSE PG. LEAF _____ DATE _____ SHEET 19 OF 25 SHEETS FILE NO. ERG'02-3A

State Proj. No.

Sheet No. of Sheets