



SANITARY SEWER

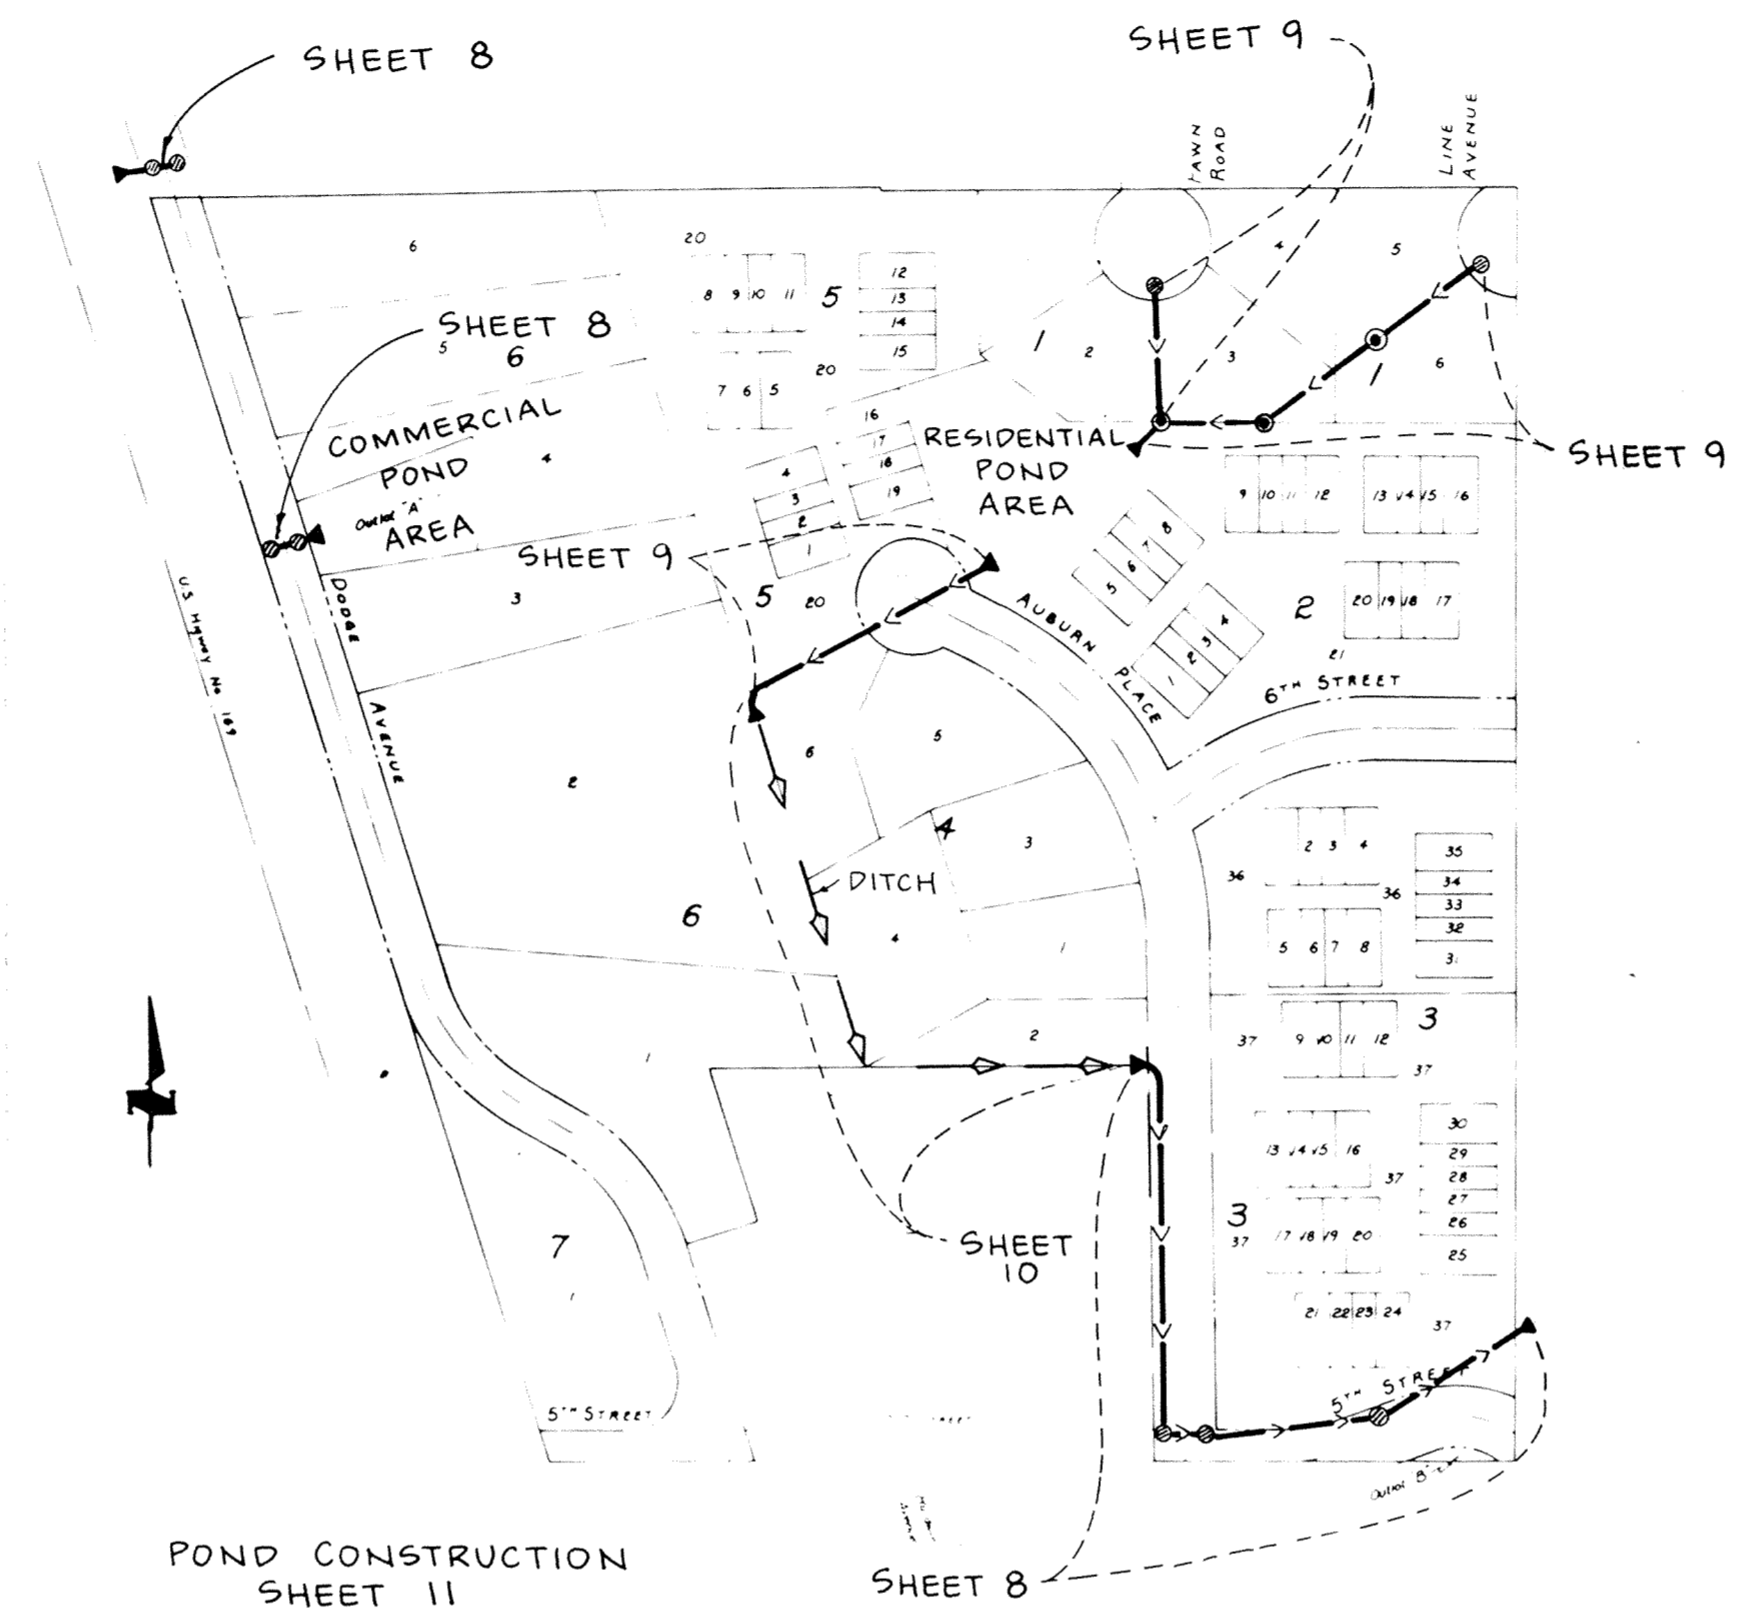

STORM SEWER

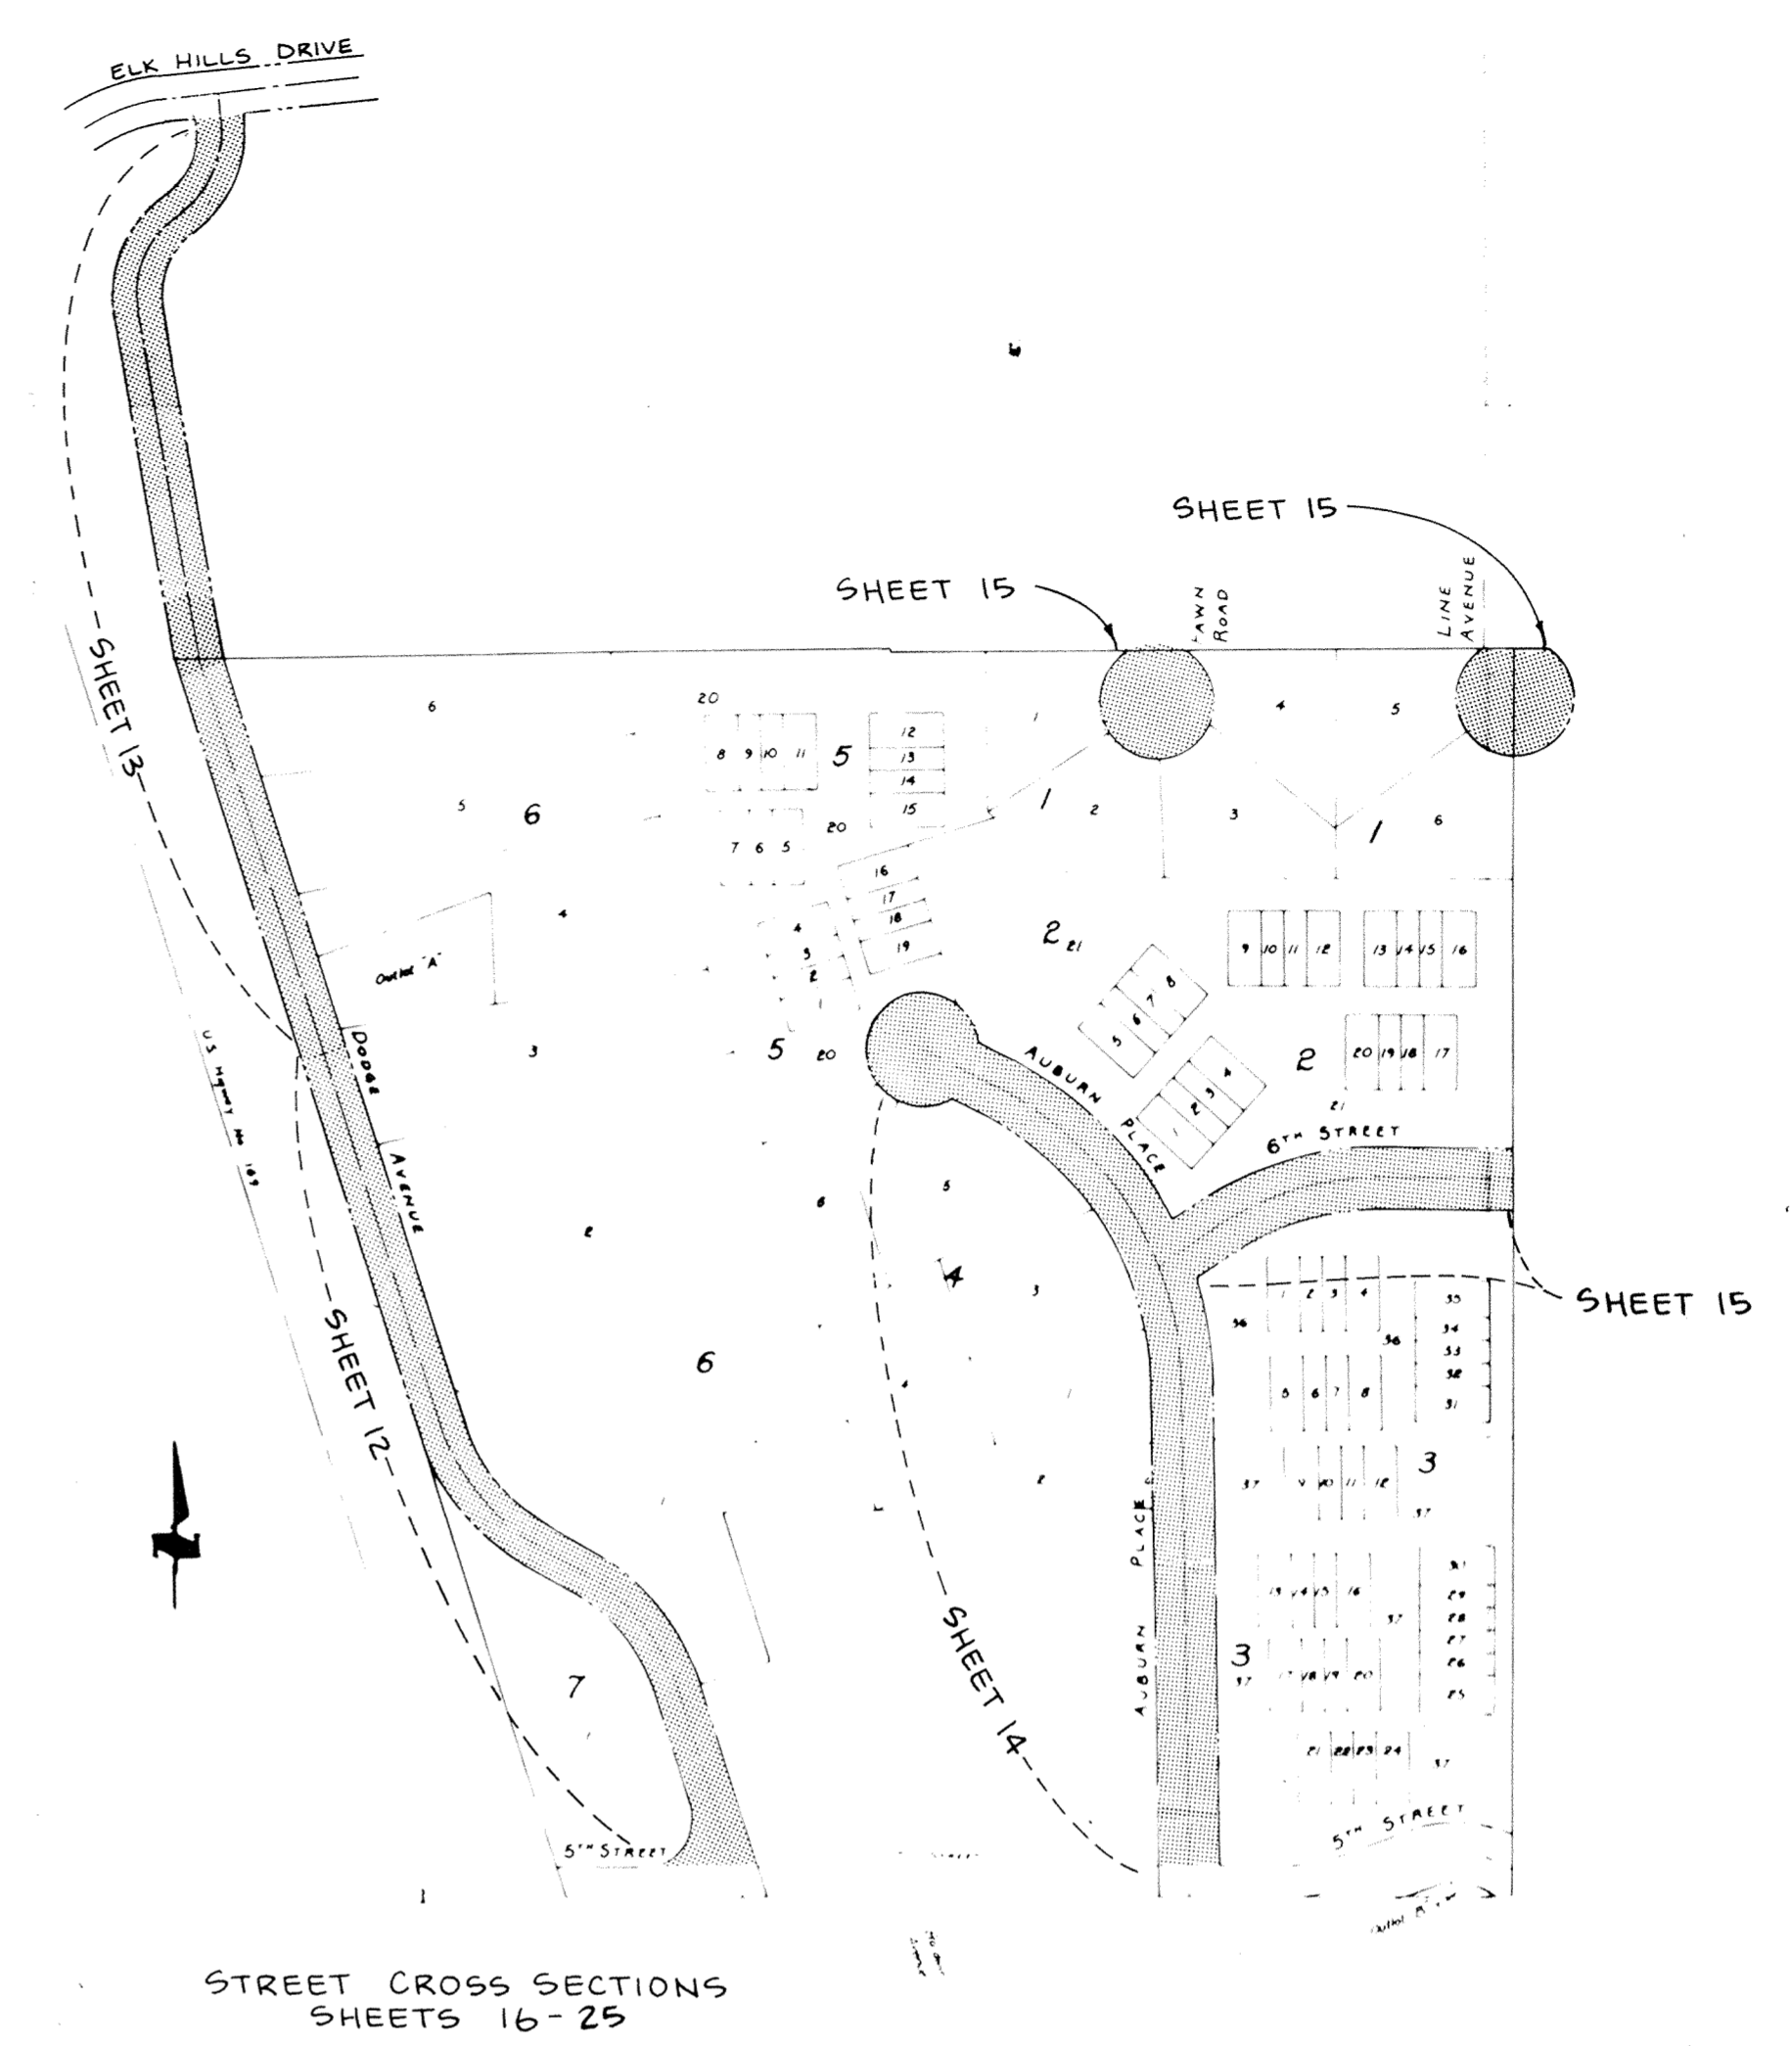

STREET CONSTRUCTION

AS-BUILT Date _____
 DRAWN BY: MRF Date 1/7/82
 CHECKED BY: _____
 INSPECTOR: BW Date 1/4/82
 DESIGN ENR: TLR Date 5/14/82
 PARTY CHIEF: RB Date 1/4/82

SEE SHEET 7 FOR WATERMAIN

I hereby certify that this plan, specification or report was prepared by me or under my direct supervision and that I am a duly Registered Professional Engineer under State of Minn. Statutes sections 326.02 to 326.16. <i>Jeffrey J. Paus</i> Date 6-5-81 Minn. Reg. No. 10806	consulting engineers diversified inc. p.o. box j, osseo, minnesota 55369 • (612)425-2181	civil municipal planning environmental land surveying geotechnics	REVISIONS	DESIGNED BY TAK TM	CITY OF ELK RIVER BARRINGTON PLACE INDEX SHEET
			GRAPHIC SCALE HORIZ 0 200 VERT 0 NONE	CHECKED BY PRR	
			DRAWN BY TAK LLR	BK. _____ PG. _____	DATE APRIL 81 SHEET 2 OF 25 SHEETS FILE NO. ER6:02-3A