


Fed. Proj. No.

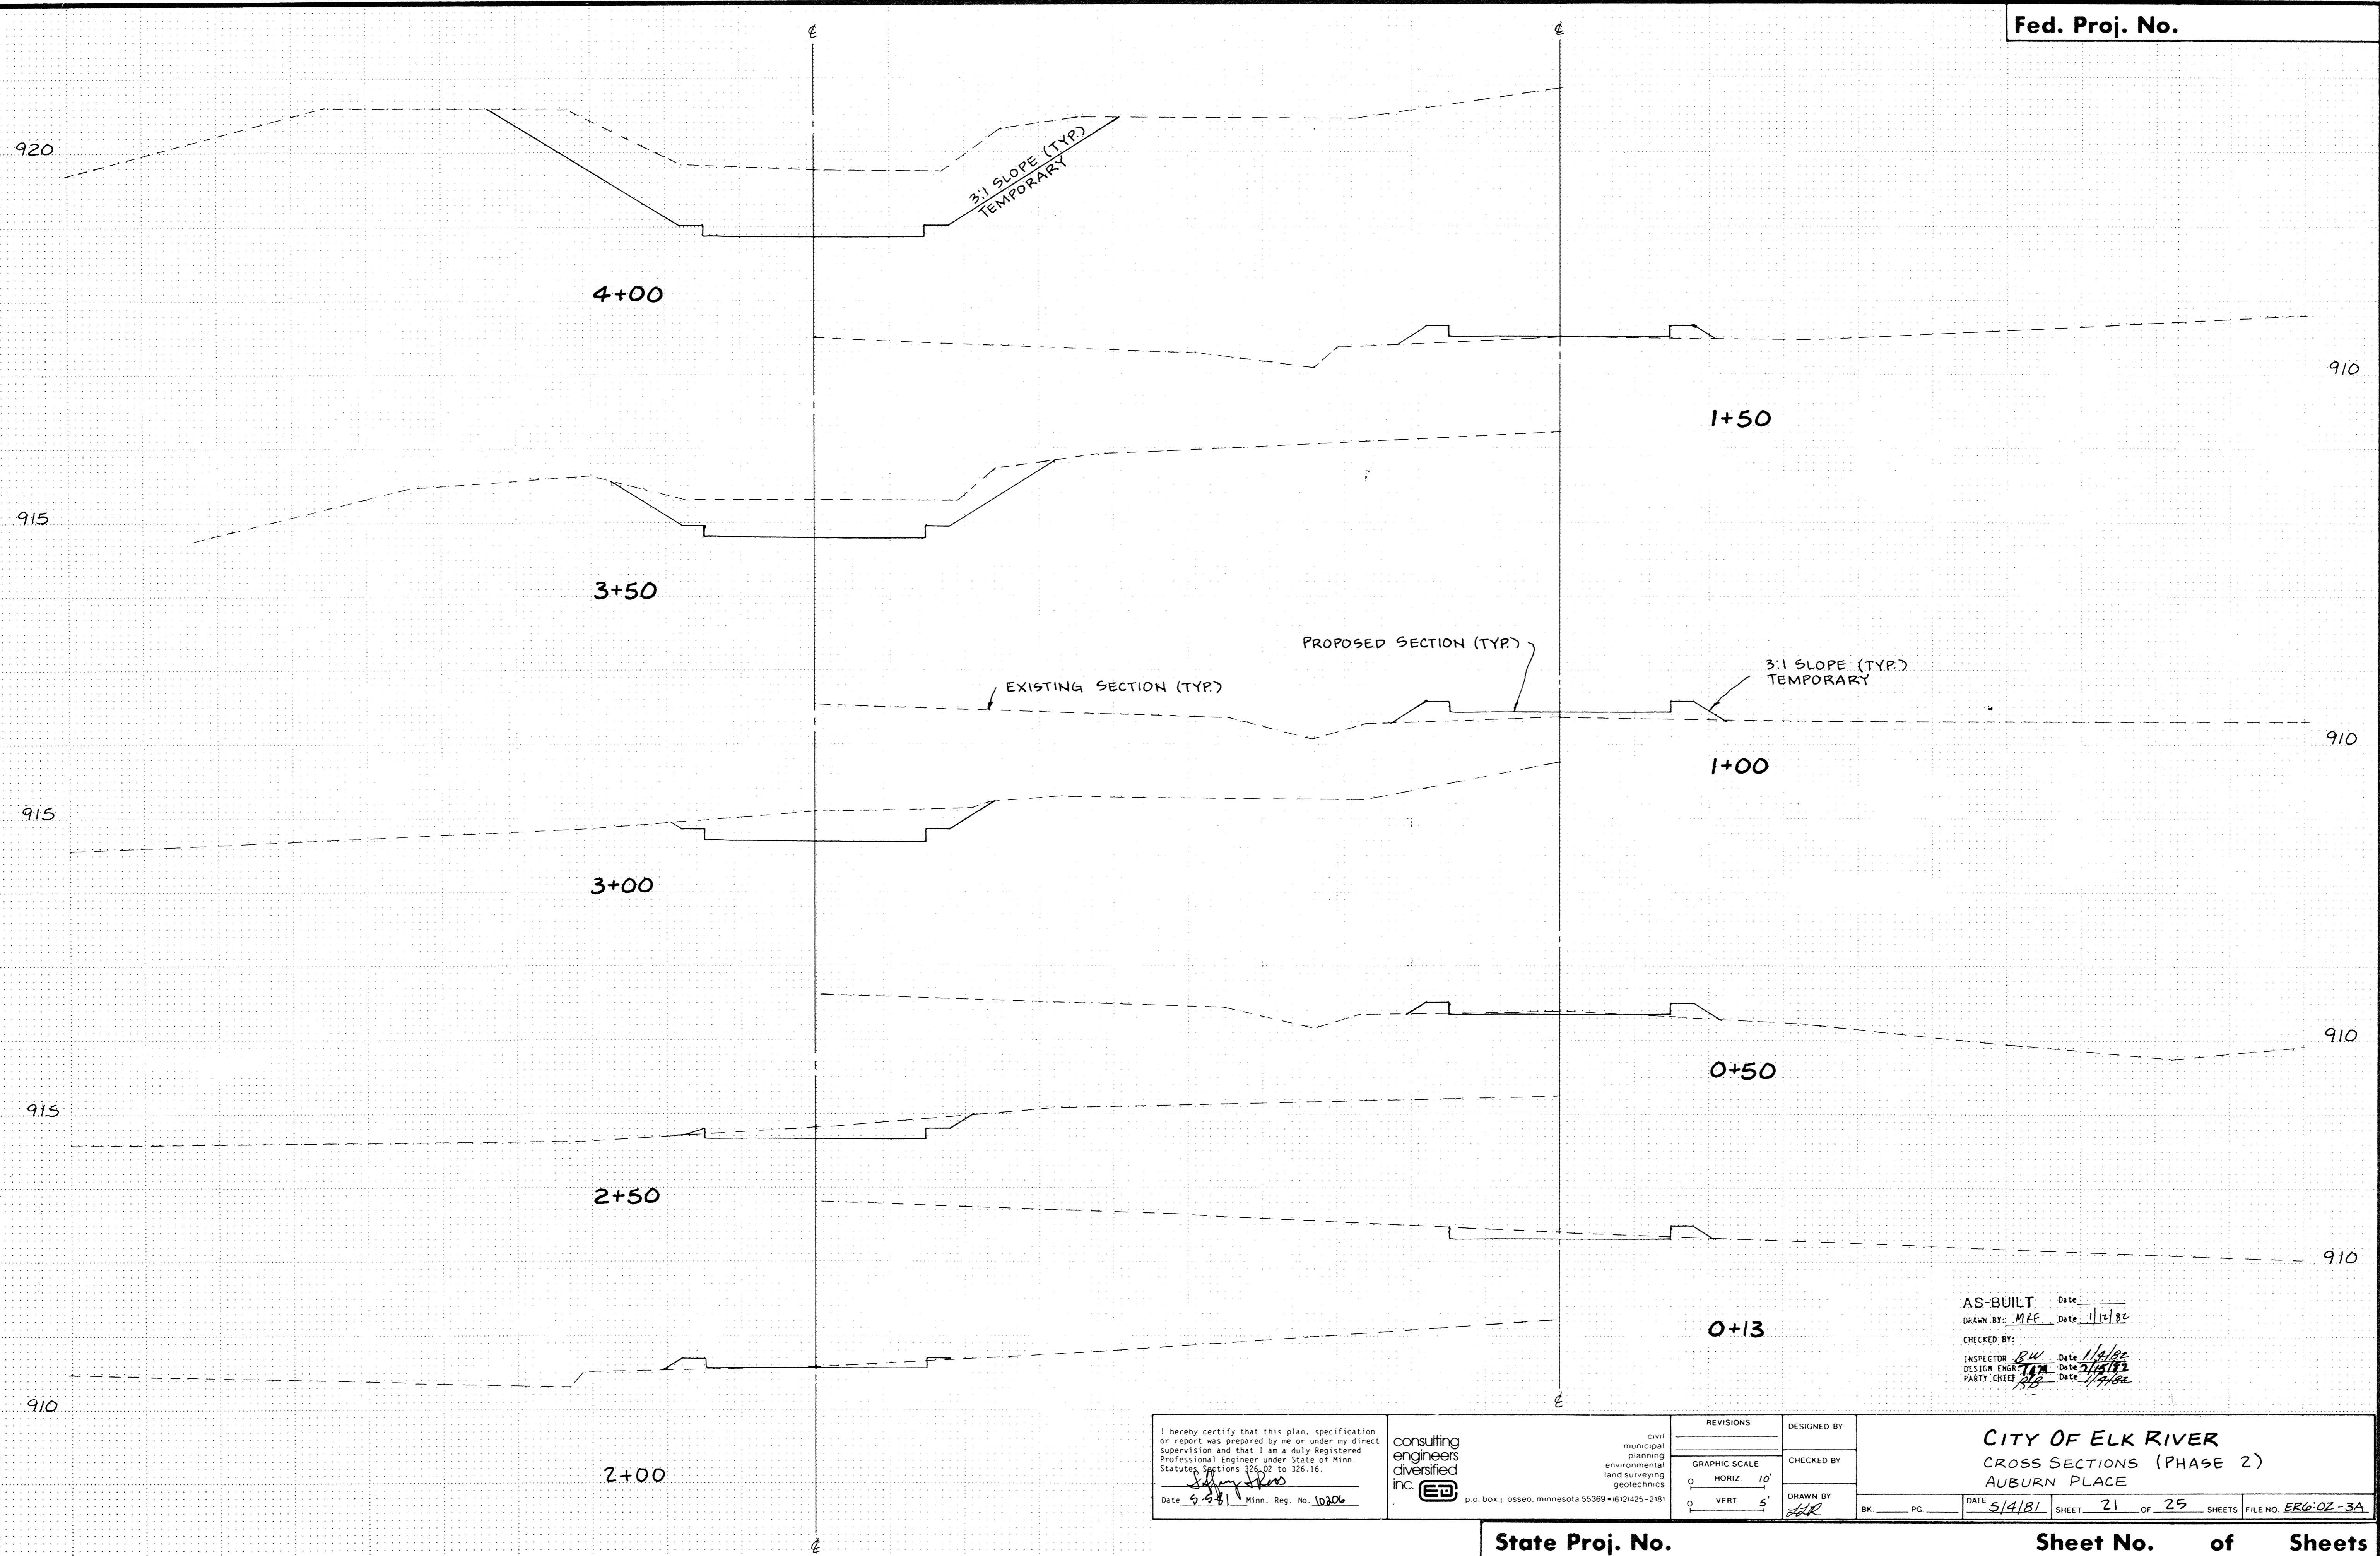

AS-BUILT Date \_\_\_\_\_  
 DRAWN BY: MRF Date: 1/12/82  
 CHECKED BY: \_\_\_\_\_  
 INSPECTOR: BW Date: 1/14/82  
 DESIGN ENGR: TAF Date: 2/16/82  
 PARTY CHIEF: JLB Date: 1/14/82

I hereby certify that this plan, specification or report was prepared by me or under my direct supervision and that I am a duly Registered Professional Engineer under State of Minn. Statutes, Sections 326.02 to 326.15. <i>[Signature]</i> Date: 5-2-81 Minn. Reg. No. 10206	consulting engineers diversified inc.  p.o. box 1 osseo, minnesota 55369 • (612) 425-2181	civil municipal planning environmental land surveying geotechnics	REVISIONS	DESIGNED BY	<b>CITY OF ELK RIVER</b> <b>CROSS SECTIONS (PHASE 2)</b> <b>AUBURN PLACE</b>
			GRAPHIC SCALE 0 HORIZ 10' 0 VERT 5'	CHECKED BY	
			DRAWN BY	BK _____ PG. _____	DATE: 5/4/81 SHEET: 21 OF 25 SHEETS FILE NO: ER6-02-3A

State Proj. No.

Sheet No. of Sheets