


Fed. Proj. No.

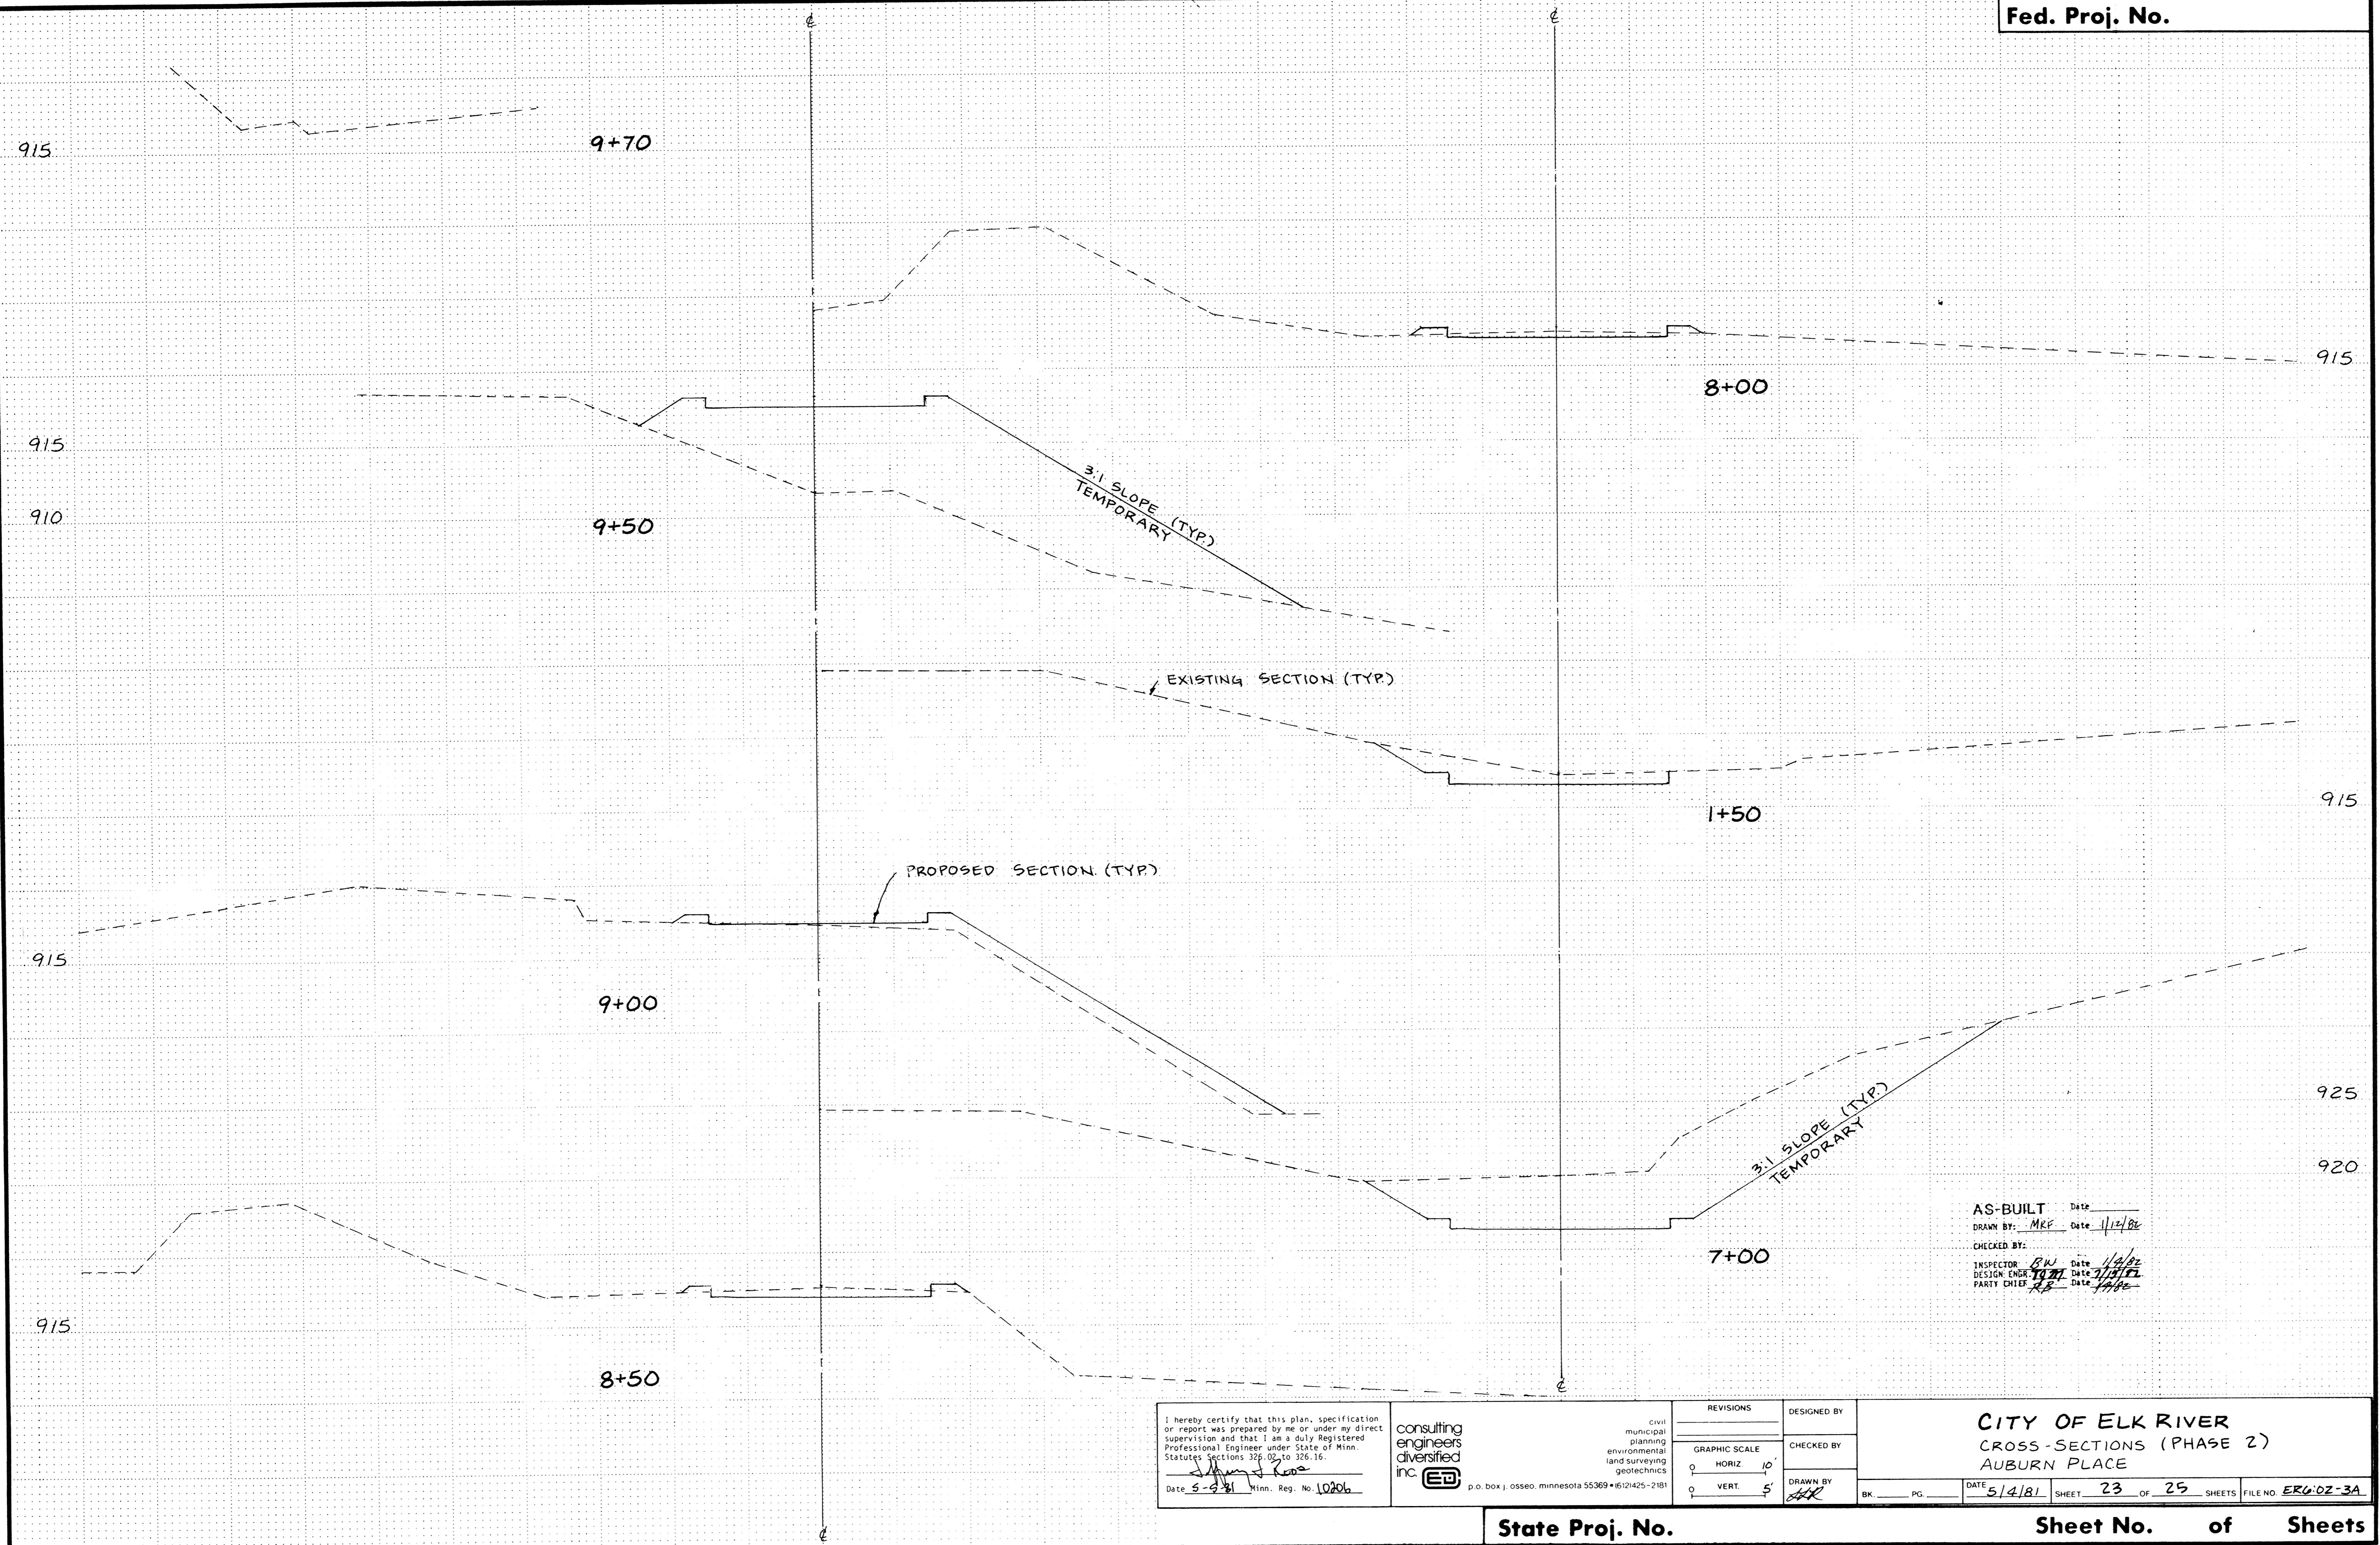

AS-BUILT Date _____
 DRAWN BY: MKF Date 11/2/82
 CHECKED BY: _____
 INSPECTOR: RW Date 11/4/82
 DESIGN ENGR: TWT Date 7/13/82
 PARTY CHIEF: RB Date 7/13/82

I hereby certify that this plan, specification or report was prepared by me or under my direct supervision and that I am a duly Registered Professional Engineer under State of Minn. Statute Sections 329.02 to 329.16.
 Date 5-9-81 Minn. Reg. No. 10206

consulting engineers diversified inc. ED
 p.o. box 1, osseo, minnesota 55369 • (612) 425-2181
 Civil municipal planning environmental land surveying geotechnics

REVISIONS	DESIGNED BY
GRAPHIC SCALE	CHECKED BY
0 HORIZ 10'	DRAWN BY
0 VERT 5'	DATE

CITY OF ELK RIVER
 CROSS-SECTIONS (PHASE 2)
 AUBURN PLACE

BK _____ PG. _____ DATE 5/4/81 SHEET 23 OF 25 SHEETS FILE NO ERG-02-3A

State Proj. No.

Sheet No. of Sheets