


Fed. Proj. No.

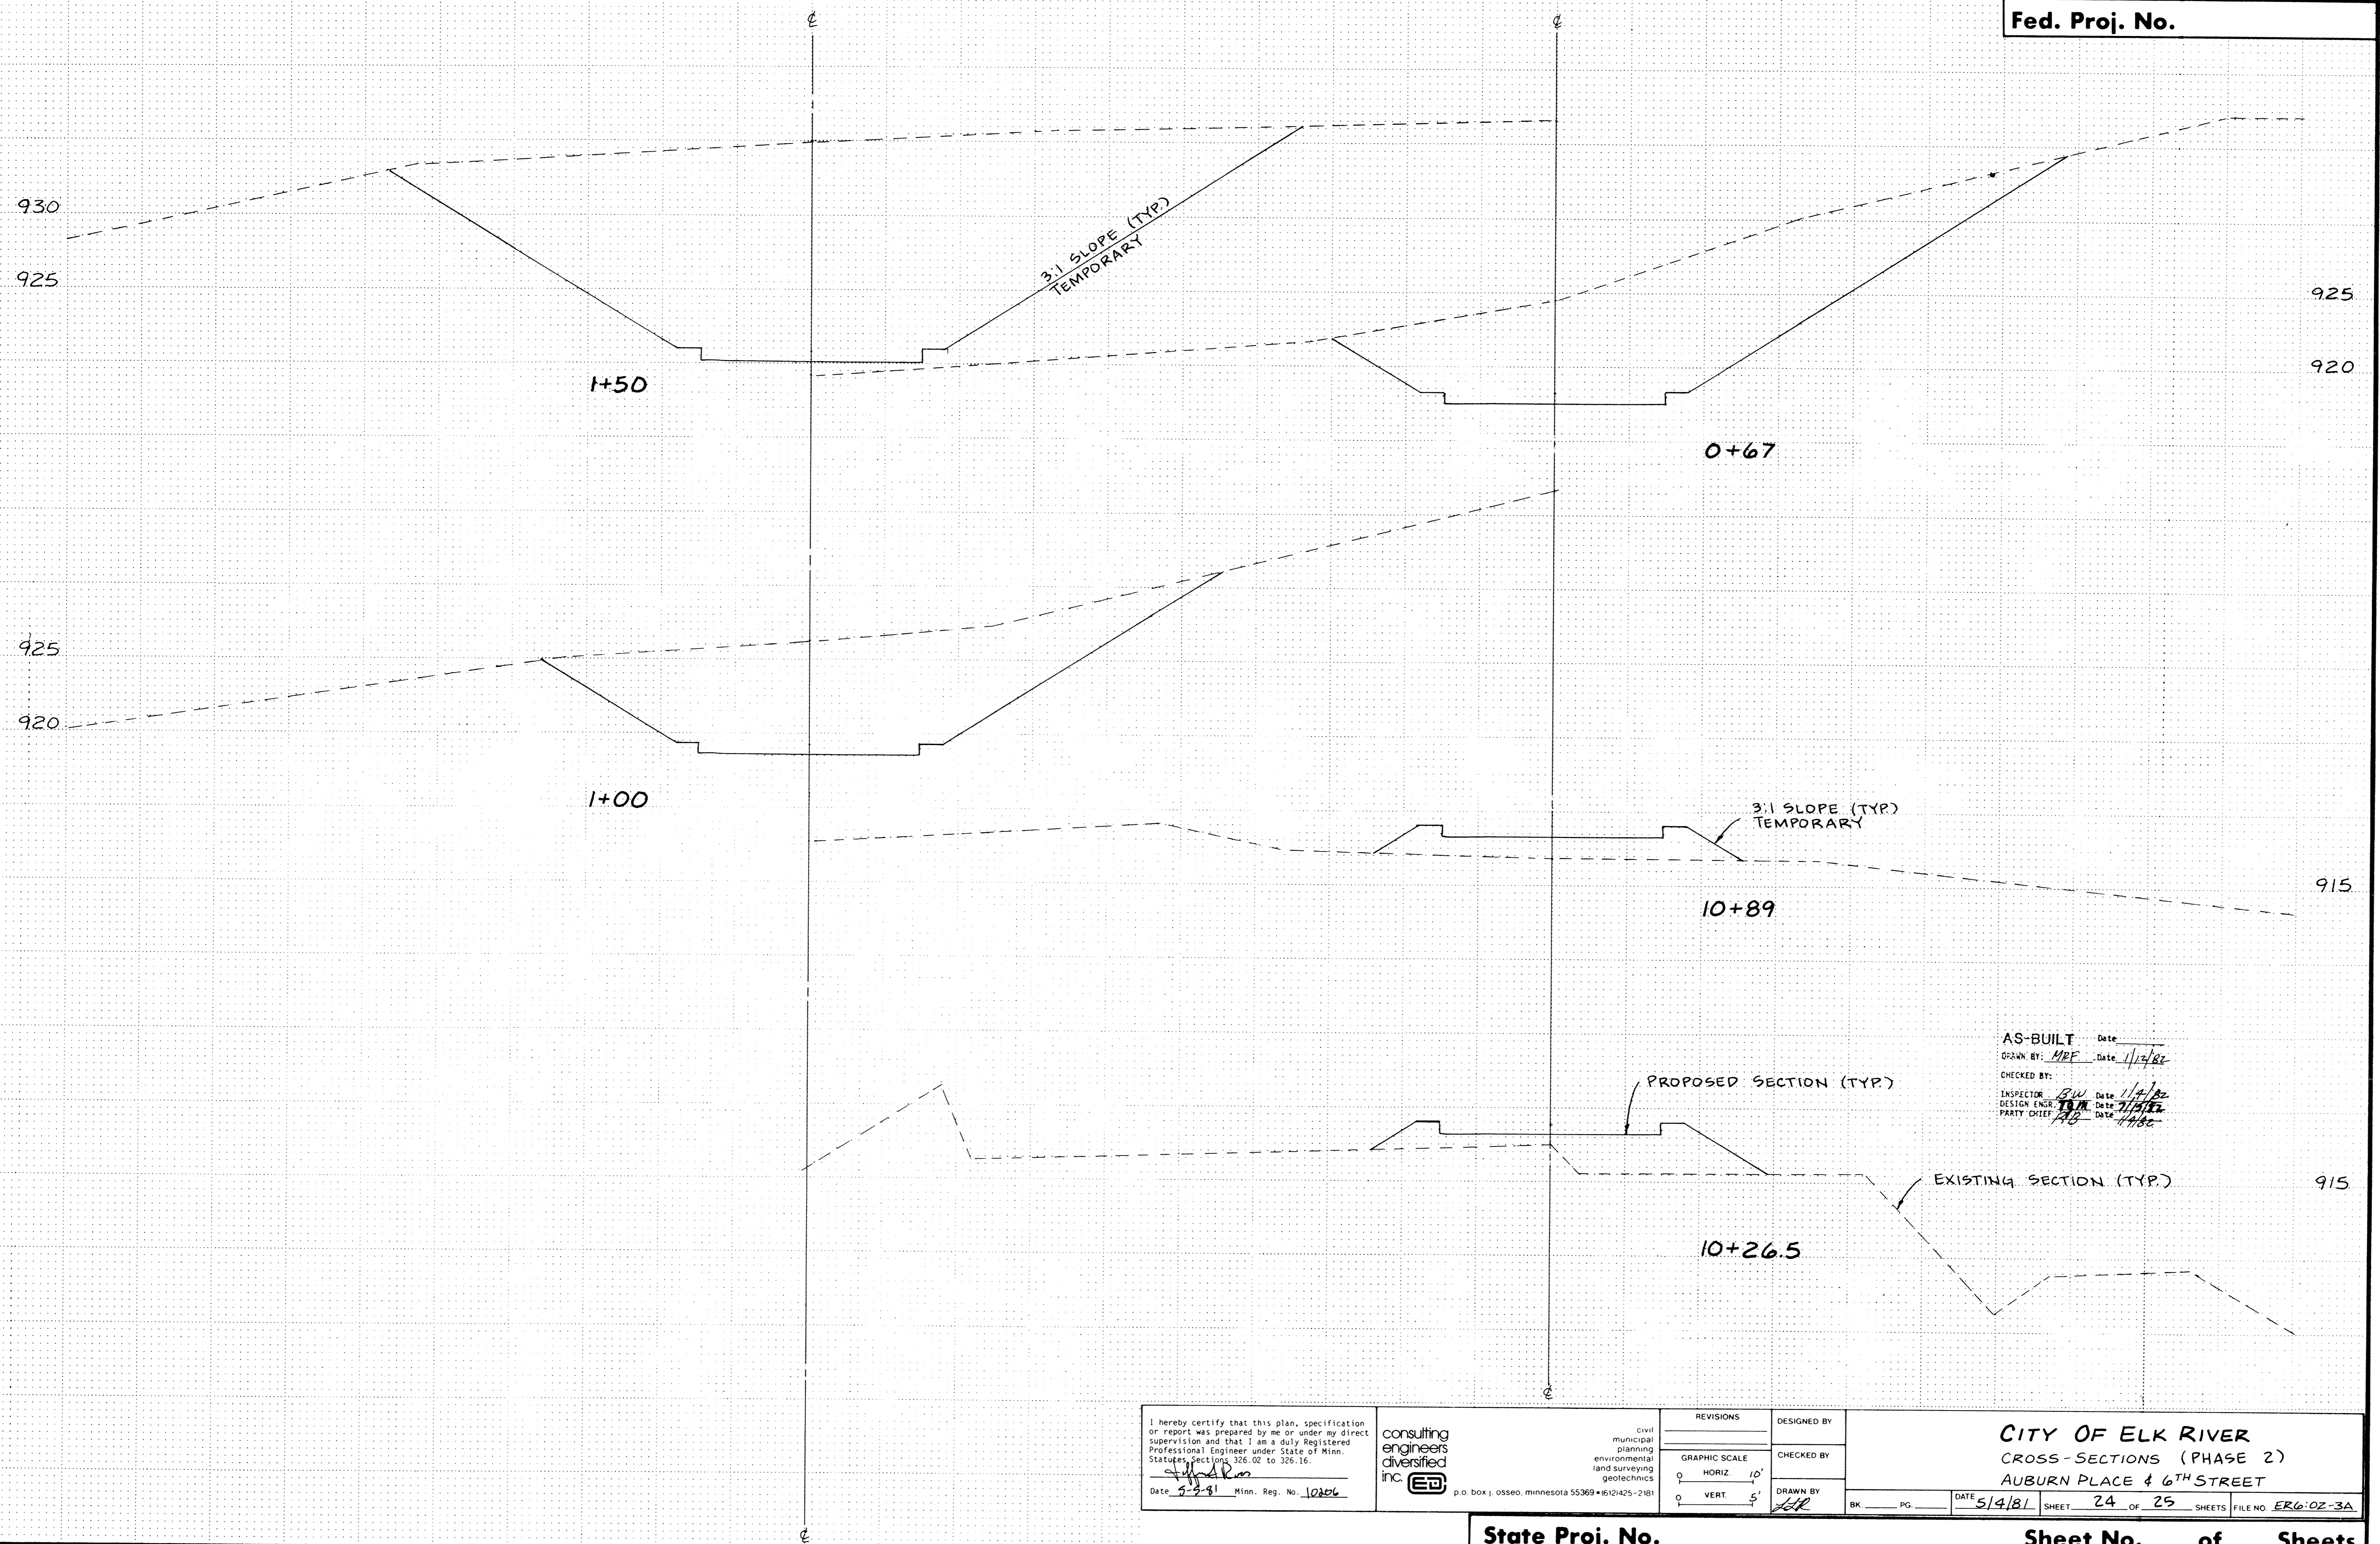

AS-BUILT Date _____
 DRAWN BY: MRF Date 1/12/82
 CHECKED BY: _____
 INSPECTOR: BW Date 1/17/82
 DESIGN ENGR: JRM Date 7/14/82
 PARTY CHIEF: JAB Date 4/82

I hereby certify that this plan, specification or report was prepared by me or under my direct supervision and that I am a duly Registered Professional Engineer under State of Minn. Statutes, Sections 326.02 to 326.16.
 Date 5-2-81 Minn. Reg. No. 10256

consulting engineers diversified inc. p.o. box j. osseo, minnesota 55369 • (612) 425-2181
 Civil municipal planning environmental land surveying geotechnics

REVISIONS	

GRAPHIC SCALE
 0' HORIZ. 10'
 0' VERT. 5'

DESIGNED BY _____
 CHECKED BY _____
 DRAWN BY JLR
 CITY OF ELK RIVER
 CROSS-SECTIONS (PHASE 2)
 AUBURN PLACE & 6TH STREET
 BK. _____ PG. _____ DATE 5/4/81 SHEET 24 OF 25 SHEETS FILE NO. ERG-02-3A

State Proj. No.

Sheet No. of Sheets