


SAICO PRODUCTS • NEW HOPE, MINNESOTA  
REPORTER BY PART NUMBER 8533  
PRINTED ON THE BASIS OF THE STATE OF MINN.

SAICO PRODUCTS • NEW HOPE, MINNESOTA  
REPORTER BY PART NUMBER 8533  
PRINTED ON THE BASIS OF THE STATE OF MINN.


SAICO PRODUCTS • NEW HOPE, MINNESOTA  
REPORTER BY PART NUMBER 8533  
PRINTED ON THE BASIS OF THE STATE OF MINN.

SAICO PRODUCTS • NEW HOPE, MINNESOTA  
REPORTER BY PART NUMBER 8533  
PRINTED ON THE BASIS OF THE STATE OF MINN.

Fed. Proj. No.

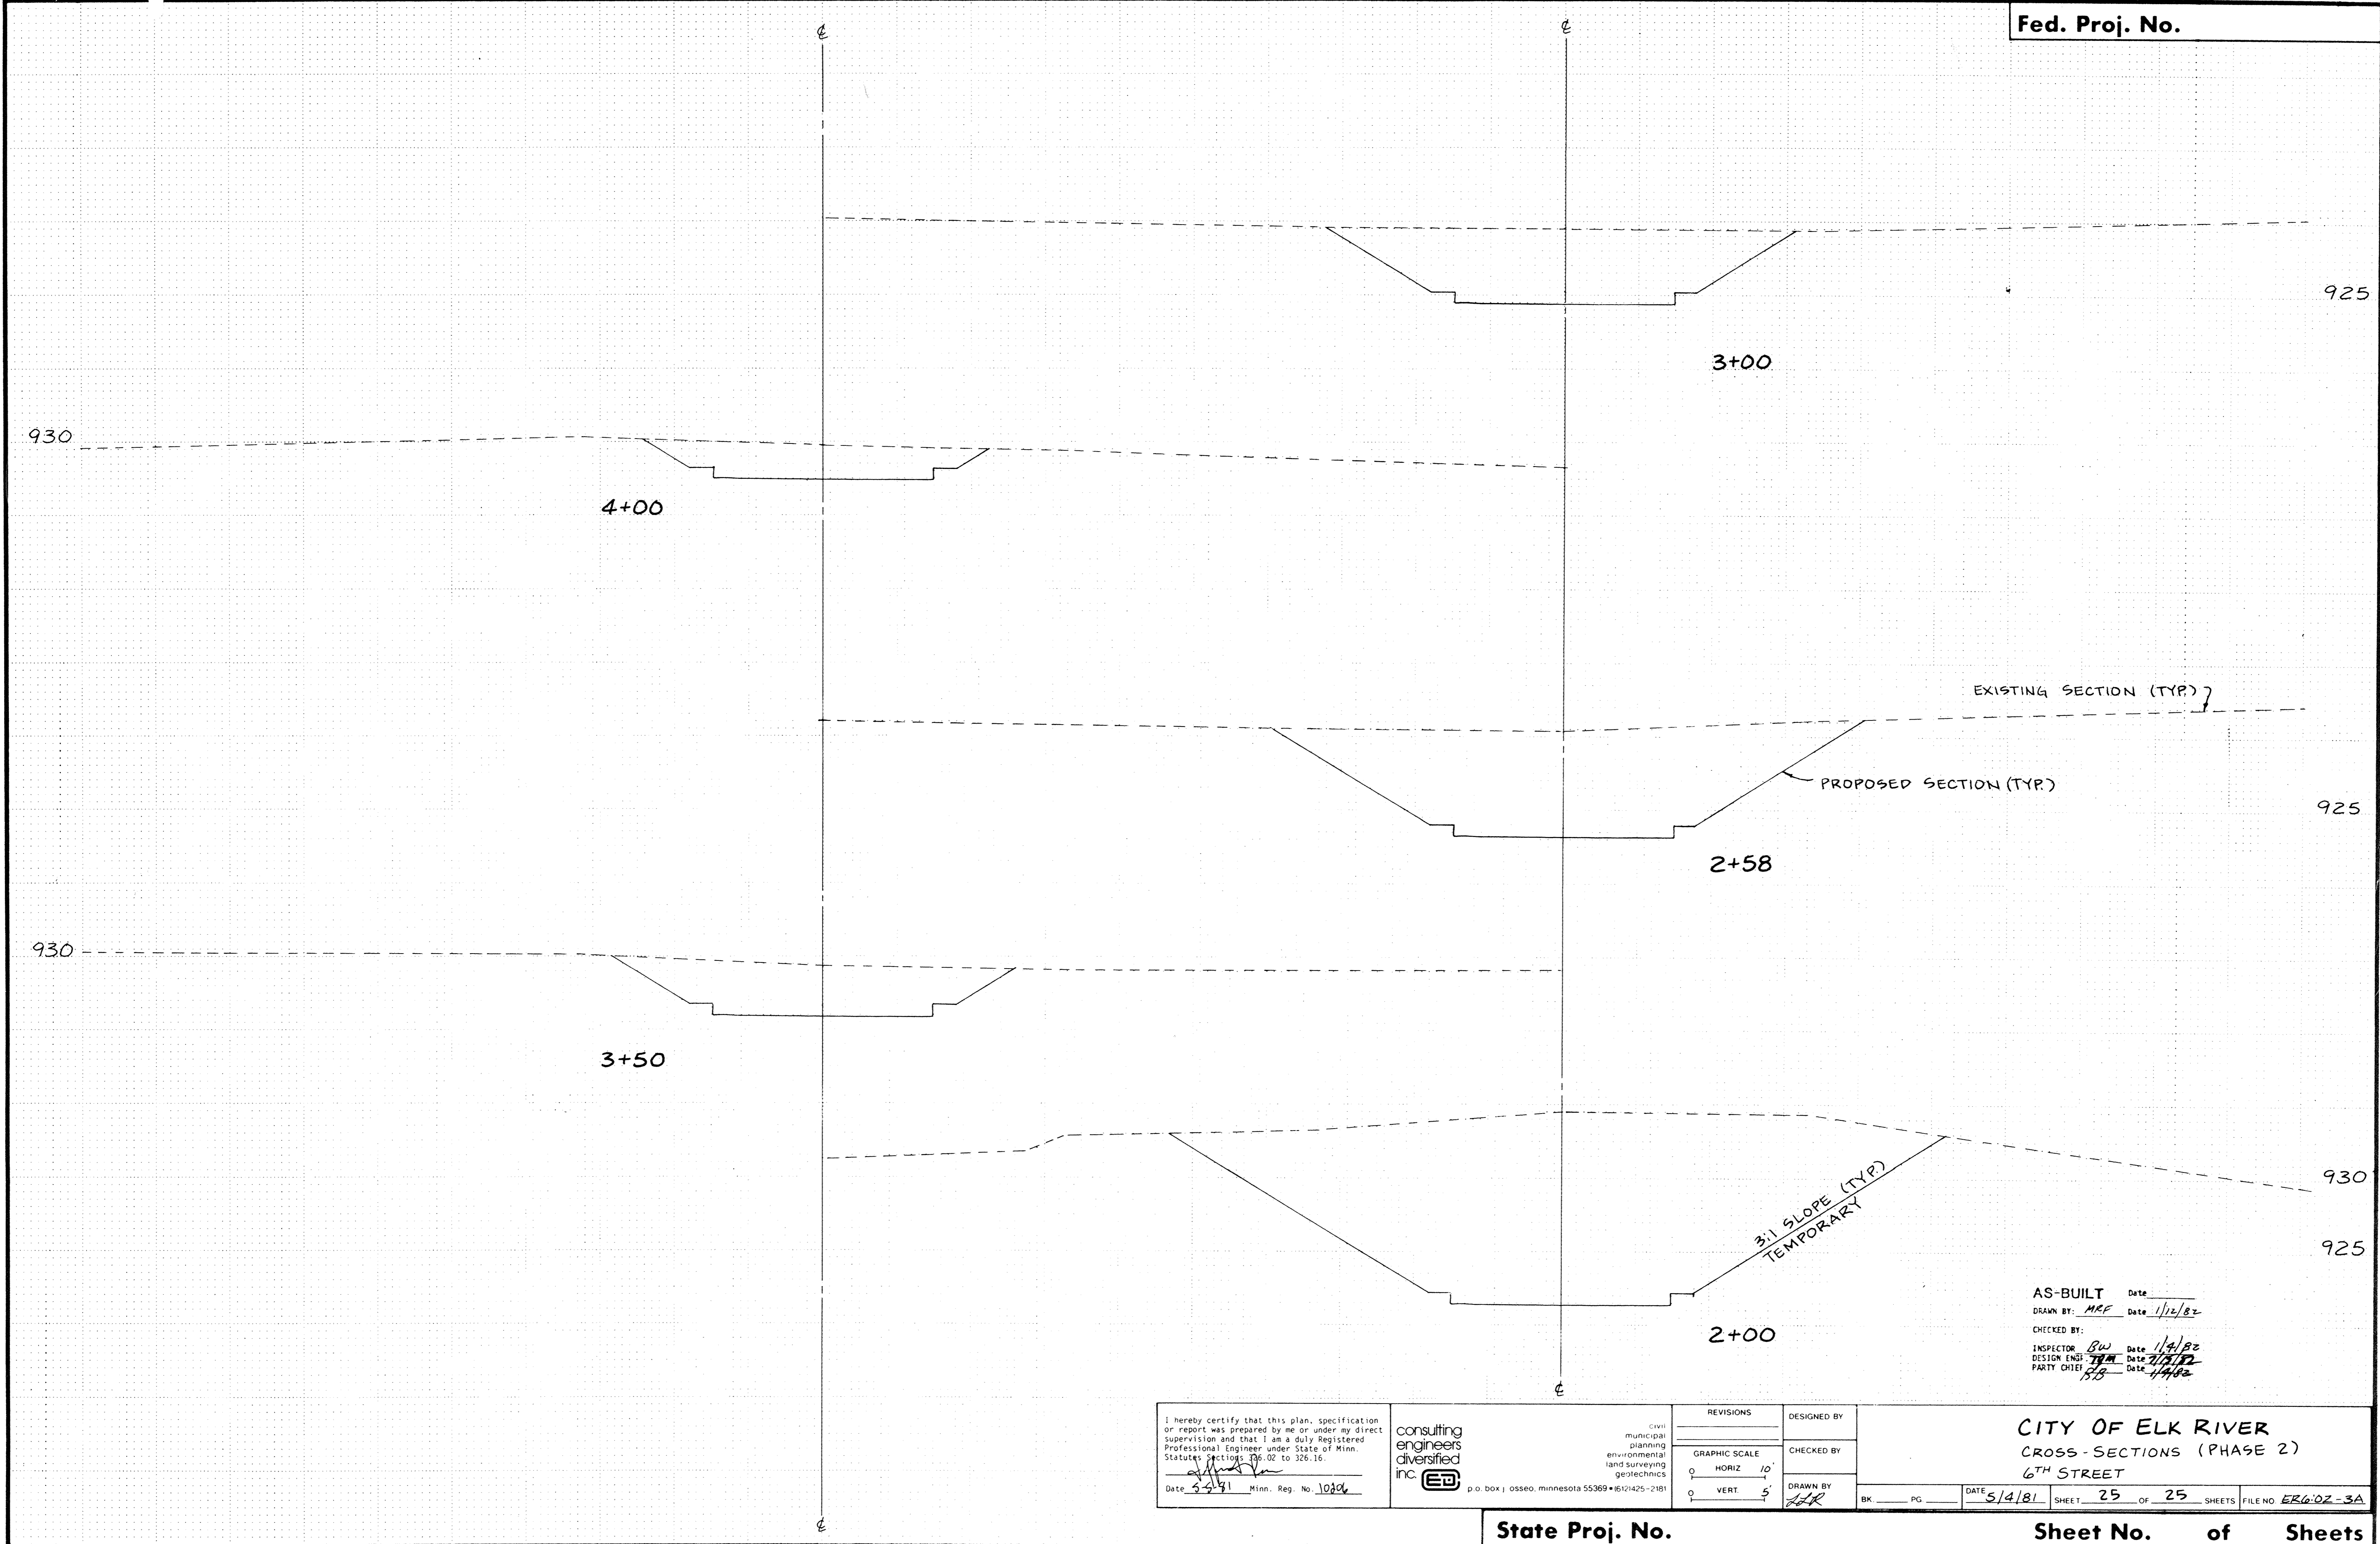

AS-BUILT Date \_\_\_\_\_  
 DRAWN BY: MRF Date 1/12/82  
 CHECKED BY: \_\_\_\_\_  
 INSPECTOR: BW Date 1/4/82  
 DESIGN ENGR: JJA Date 7/17/82  
 PARTY CHIEF: JTB Date 1/1/82

I hereby certify that this plan, specification or report was prepared by me or under my direct supervision and that I am a duly Registered Professional Engineer under State of Minn. Statutes Sections 326.02 to 326.16. Date 5/4/81 Minn. Reg. No. 10306	consulting engineers diversified inc.  p.o. box 1 osseo, minnesota 55369 • (612) 425-2181	CIVIL municipal planning environmental land surveying geotechnics	REVISIONS	DESIGNED BY	<b>CITY OF ELK RIVER</b> <b>CROSS SECTIONS (PHASE 2)</b> <b>6TH STREET</b>
			GRAPHIC SCALE 0 HORIZ 10' 0 VERT 5'	CHECKED BY	
			DRAWN BY		

State Proj. No. \_\_\_\_\_ Sheet No. \_\_\_\_\_ of \_\_\_\_\_ Sheets