


AS-BUILT Date _____
 DRAWN BY: MRF Date 1/10/82
 CHECKED BY: _____
 INSPECTOR: EW Date 1/4/82
 DESIGN ENGR: JLB Date 1/15/82
 PARTY CHIEF: RLB Date 1/18/82

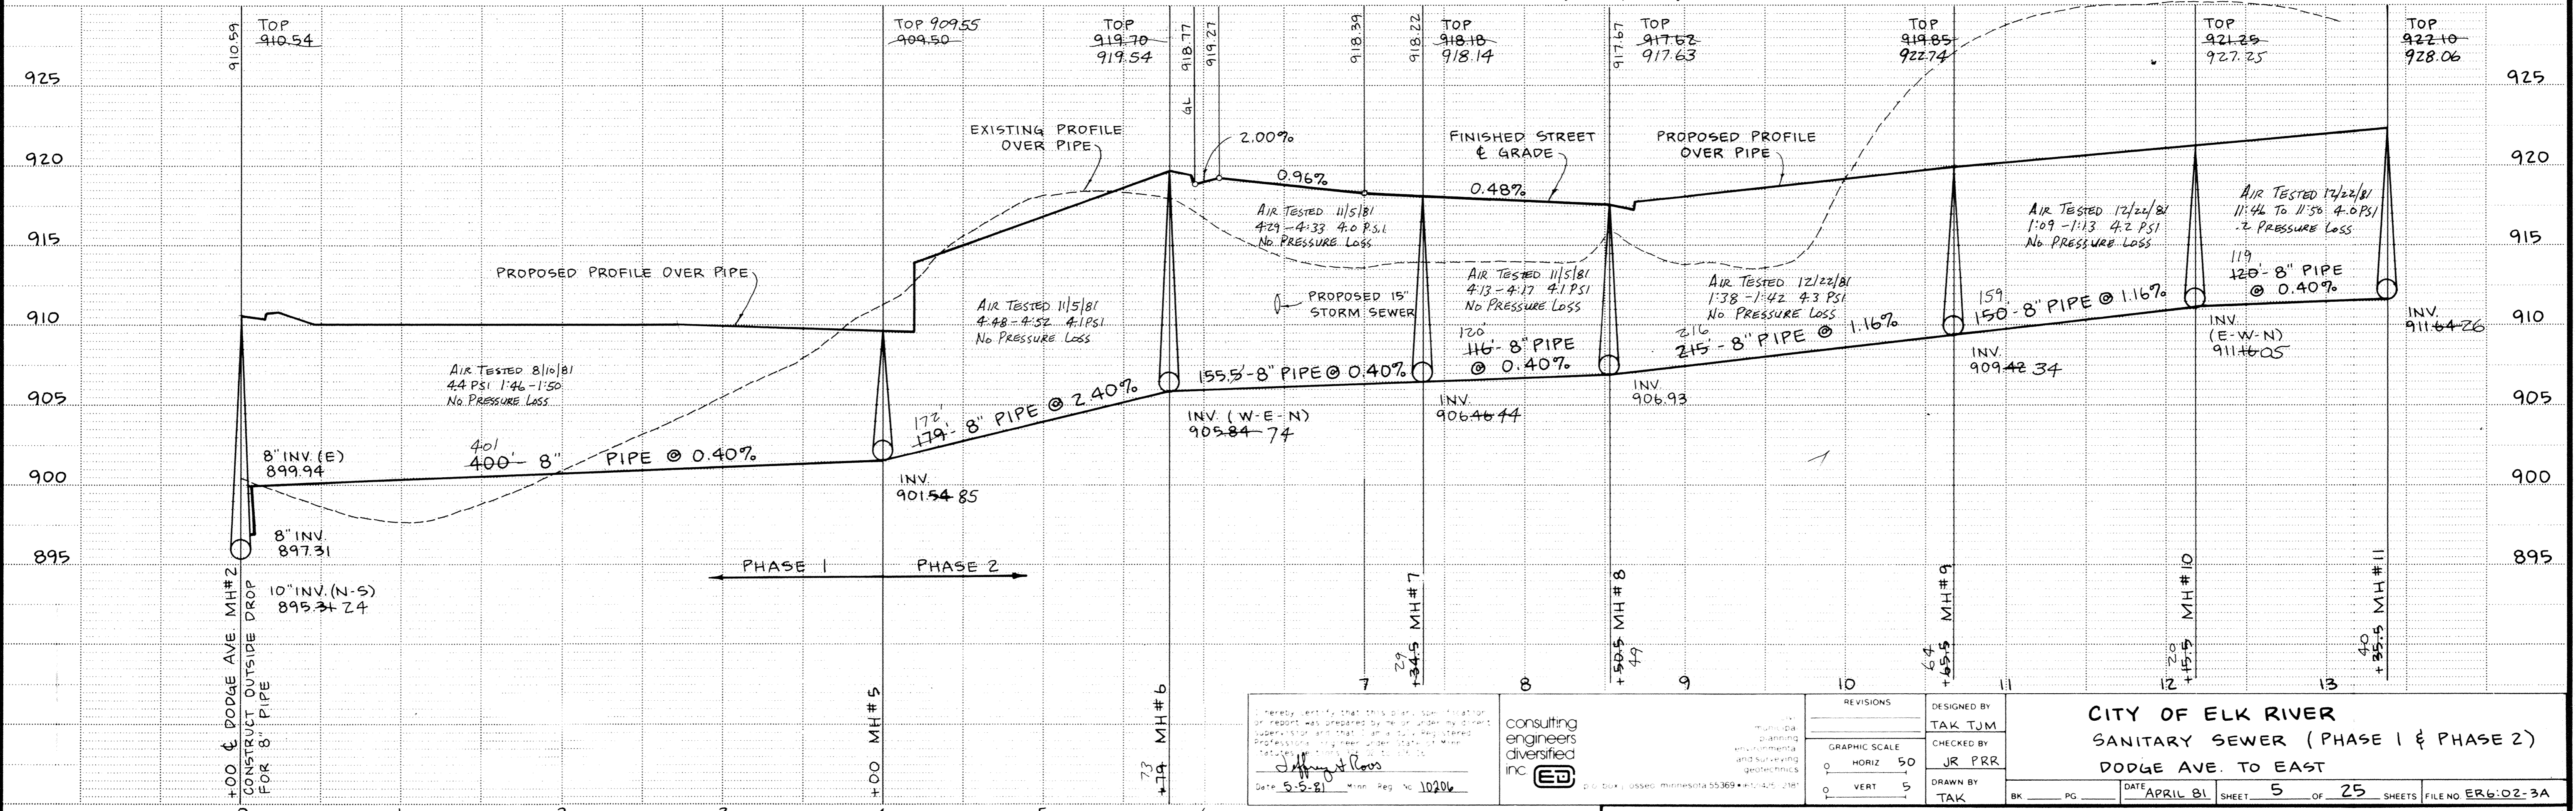

I hereby certify that this plan, specification or report was prepared by me or under my direct supervision and that I am a duly licensed professional engineer in the State of Minnesota. Date 5-5-81 Minn. Reg. No. 10204 consulting engineers diversified inc.	DESIGNED BY TAK TJM CHECKED BY JR PRR DRAWN BY TAK	REVISIONS GRAPHIC SCALE 0 HORIZ 50 0 VERT 1	CITY OF ELK RIVER SANITARY SEWER (PHASE I & PHASE 2) DODGE AVE. TO EAST APRIL 81 SHEET 5 OF 25 SHEETS FILE NO. ER6-02-3A
	State Proj. No. _____ Sheet No. _____ of _____ Sheets		