


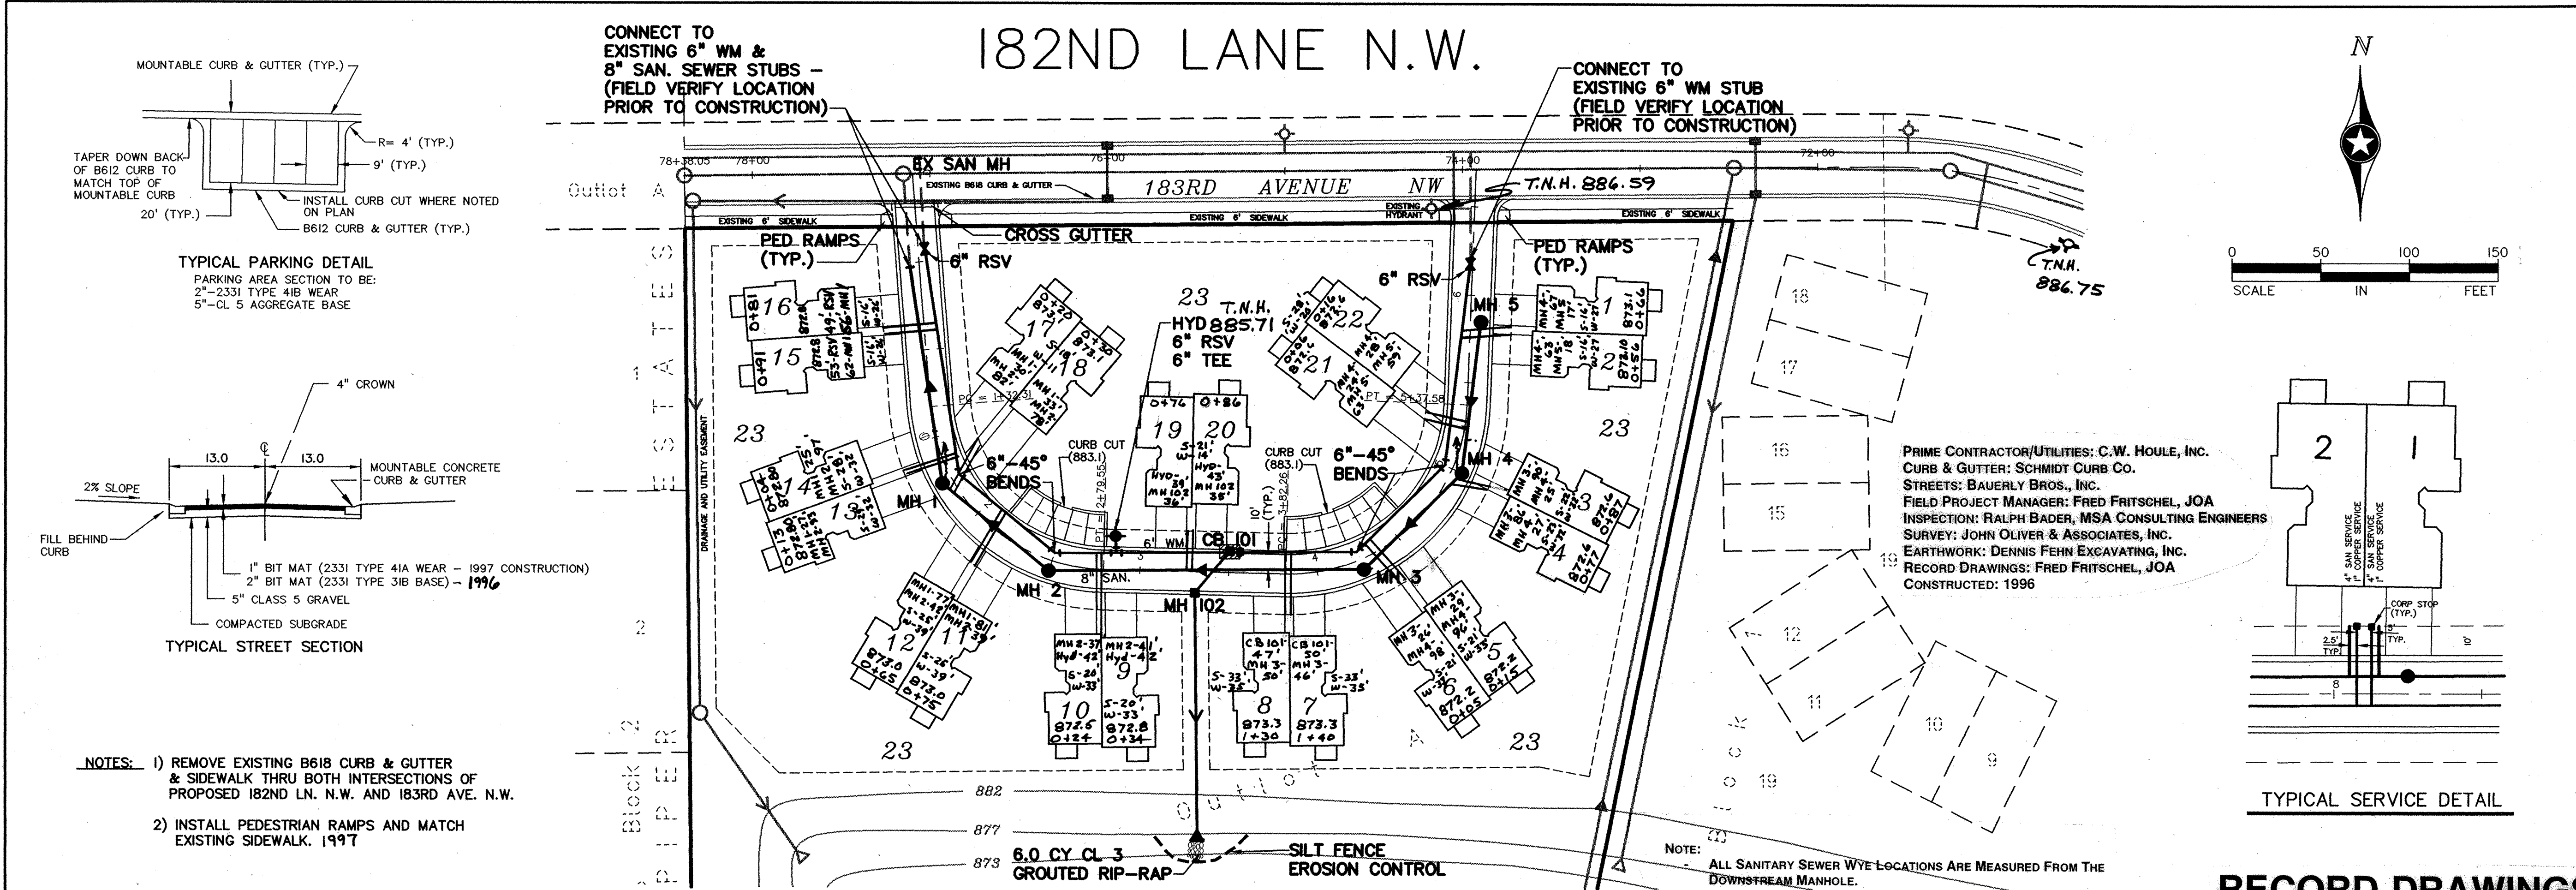


CITY ENGINEER		DATE	
Terry Meyer		9/19/96	
REV.	NO.	DATE	DESCRIPTION
1	1	8/28/96	8/28/96
2	2	2/26/97	RECORDED DRAWINGS
DESIGN BY:		TM/DC	
DRAWN BY:		BG	
CHECKED BY:		TM	
DWG FILE:		TH3-PP1	
TEXT FILE:		6719.21	
FILE NO.:		6719.21	

I hereby certify that this plan was prepared by me or under my direct supervision and that I am a duly Registered Professional Engineer under the laws of the State of Minnesota.

Signed: *[Signature]* Date: 8/15/96 Reg. No. 20383

RECORD DRAWINGS

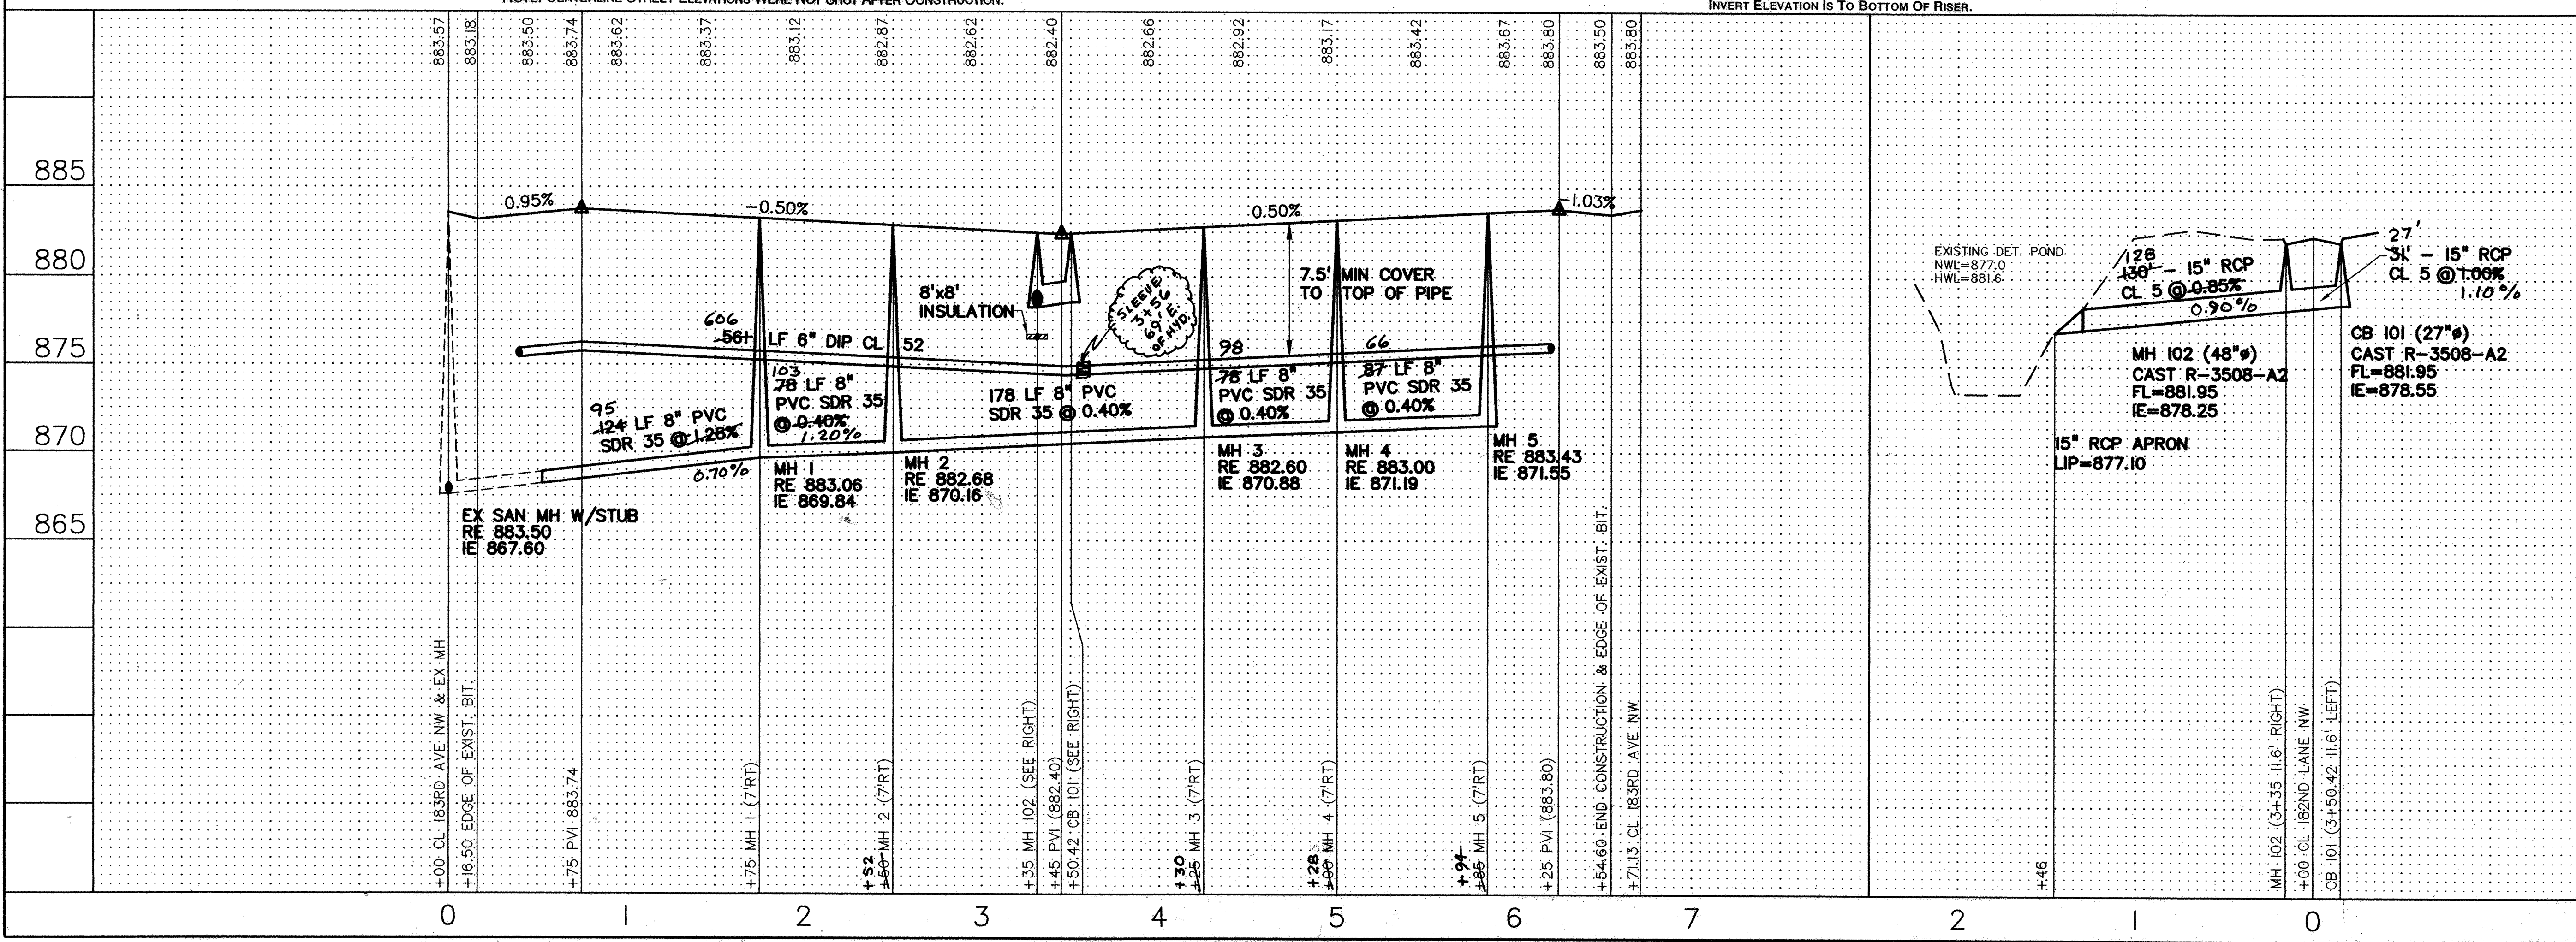

John Oliver & Associates, Inc.
Civil Engineering, Land Surveying, Land Planning
580 Dodge Avenue
Elk River, MN 55330
(612)441-2072 (FAX)441-5665

201 W. Travelers Trail, Suite 200
Burnsville, MN 55337
(612)894-3045 (FAX)894-3049

COUNTRY CROSSING TOWNHOMES
THIRD ADDITION
ELK RIVER, MINNESOTA
KINGMAN BUILDING COMPANY
STREET, SANITARY SEWER,
WATERMAIN AND STORM SEWER

SHEET NO. 1 OF 1

1048