



SAFECO PRODUCTS • NEW HOPE, MINNESOTA
RENDERED BY PART NUMBER 6502
CITY OF ELK RIVER, MINNESOTA
RENDERED BY PART NUMBER 6502

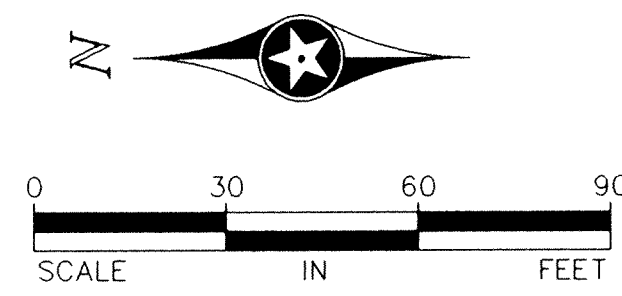

COUNTRY CROSSING

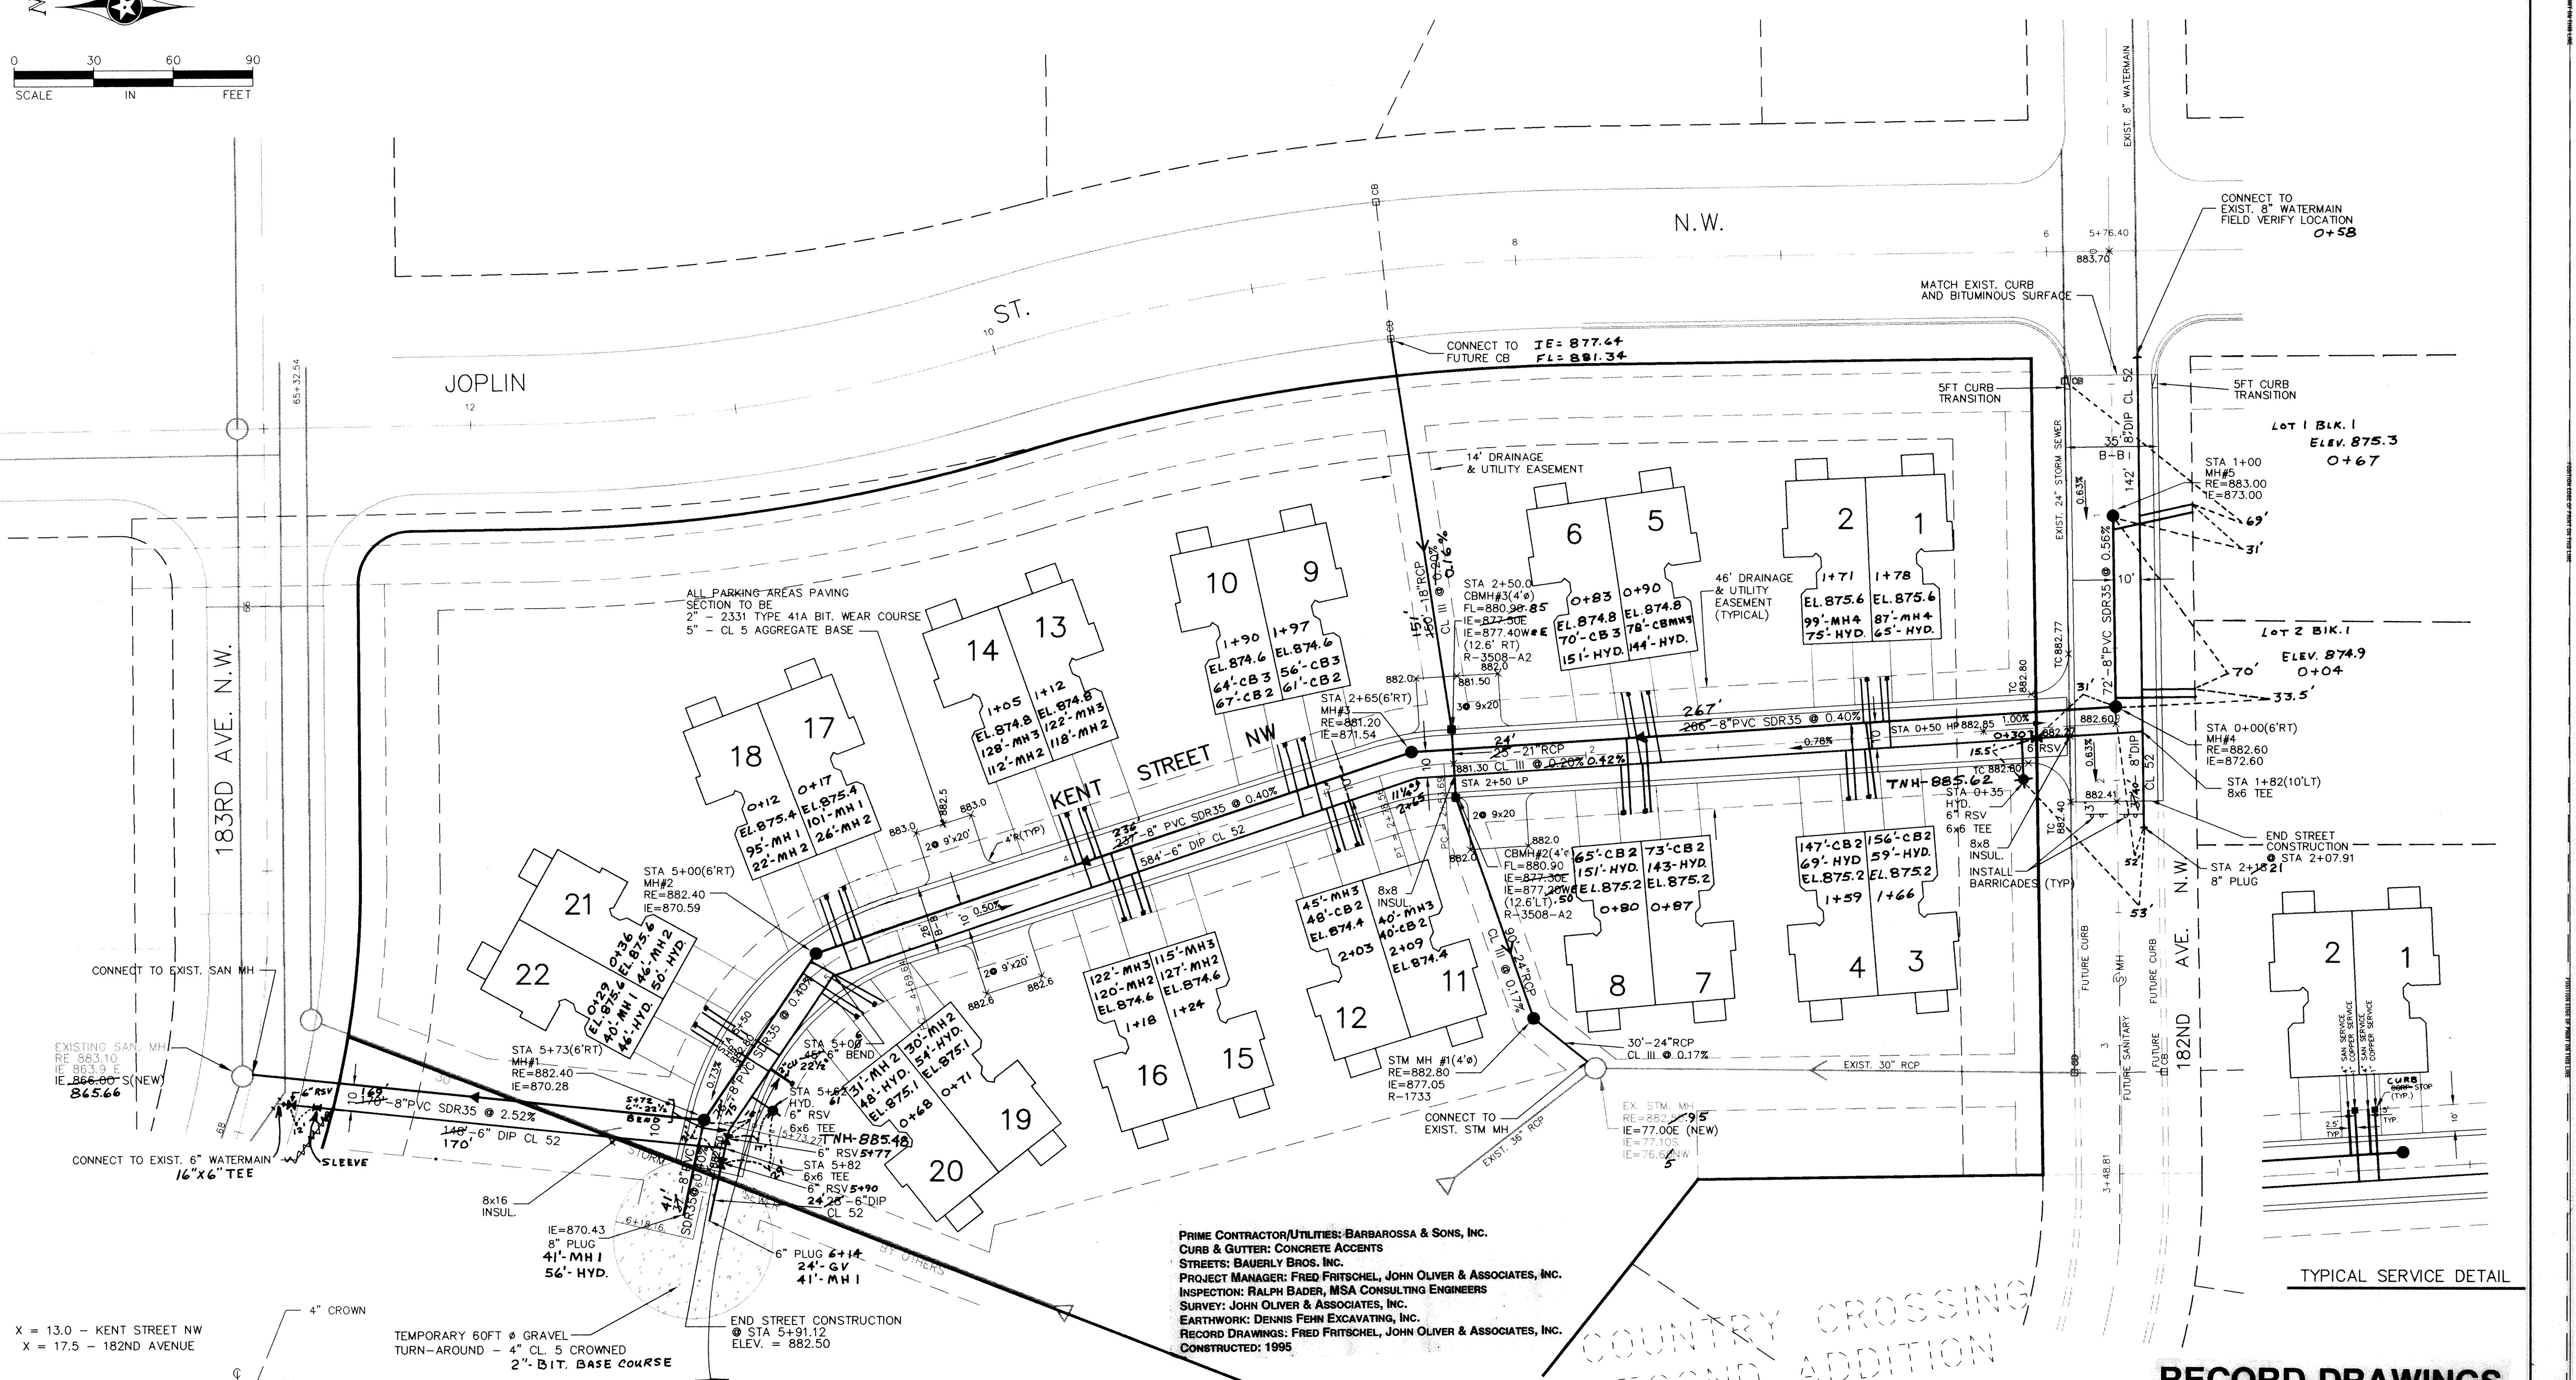


PRIME CONTRACTOR/UTILITIES: BARBAROSSA & SONS, INC.
CURB & GUTTER: CONCRETE ACCENTS
STREETS: BAUERLY BROS. INC.
PROJECT MANAGER: FRED FRITSCHER, JOHN OLIVER & ASSOCIATES, INC.
INSPECTION: RALPH BADER, MSA CONSULTING ENGINEERS
SURVEY: JOHN OLIVER & ASSOCIATES, INC.
EARTHWORK: DENNIS FEHN EXCAVATING, INC.
RECORD DRAWINGS: FRED FRITSCHER, JOHN OLIVER & ASSOCIATES, INC.
CONSTRUCTED: 1995

COUNTRY CROSSING SECOND ADDITION

RECORD DRAWINGS

NOTE: CENTERLINE STREET ELEVATIONS WERE NOT SHOT AFTER CONSTRUCTION.

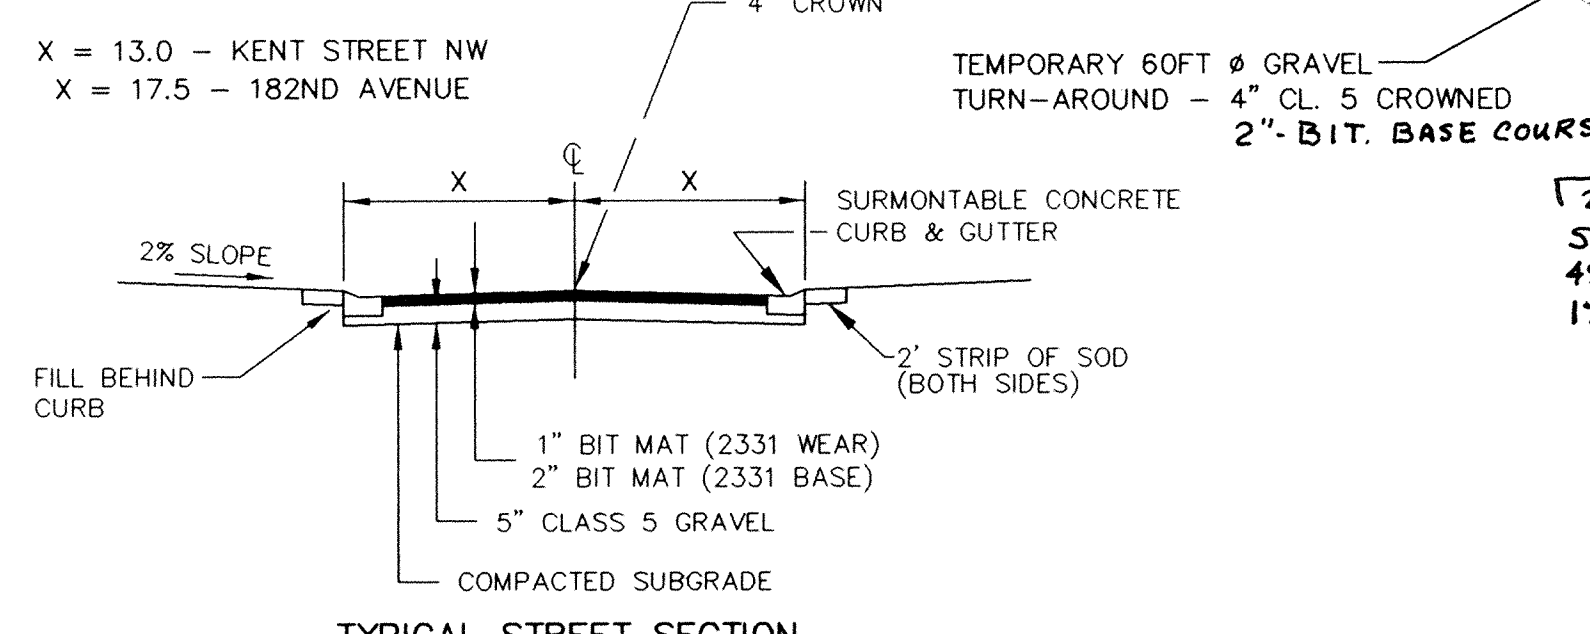

- NOTE:
- SANITARY SEWER SERVICE ELEVATIONS ARE INVERT AT THE 45 DEGREE BEND
 - SANITARY SEWER SERVICE WYES STATIONED FROM DOWNSTREAM MANHOLE, BEING 0+00
 - SERVICE TIES ARE TO WATER CURB STOP
 - SANITARY SEWER SERVICES ARE 4" PVC
 - WATER SERVICES ARE 1" COPPER

DATE: 3/9/95
DESIGN BY: TM
DRAWN BY:
CHECKED BY: TM

REVISIONS:
3/17/95 - SAN. INVERTS
4/12/95 - STREET GRADES
1/12/96 - RECORDED

I hereby certify that this plan was prepared by me or under my direct supervision and that I am a duly Registered Engineer under the laws of the State of Minnesota.

Signed: *John Oliver*
Date: 3/9/95 Reg. No. 20383

John Oliver & Associates, Inc.
Civil Engineering, Land Surveying, Land Planning
580 Dodge Avenue
Elk River, Minnesota
(612)441-2072 (FAX)441-5665

201 W. Travelers Trail, Suite 200
Burnsville, MN 55337
(612)894-3045 (FAX)894-3049

COUNTRY CROSSING TOWNHOMES
FOR
KINGMAN BUILDING CO.
SANITARY SEWER, STORM SEWER,
STREET AND WATERMAIN PLAN

DRAWING FILE: 6719.21-TH-FUTL
TEXT FILE: DISC: NAME

SHEET 1 OF 1
FILE NO. 6719.21-03

CITY OF ELK RIVER, CITY ENGINEER _____ DATE _____