



**179TH
HERITAGE CIRCLE**

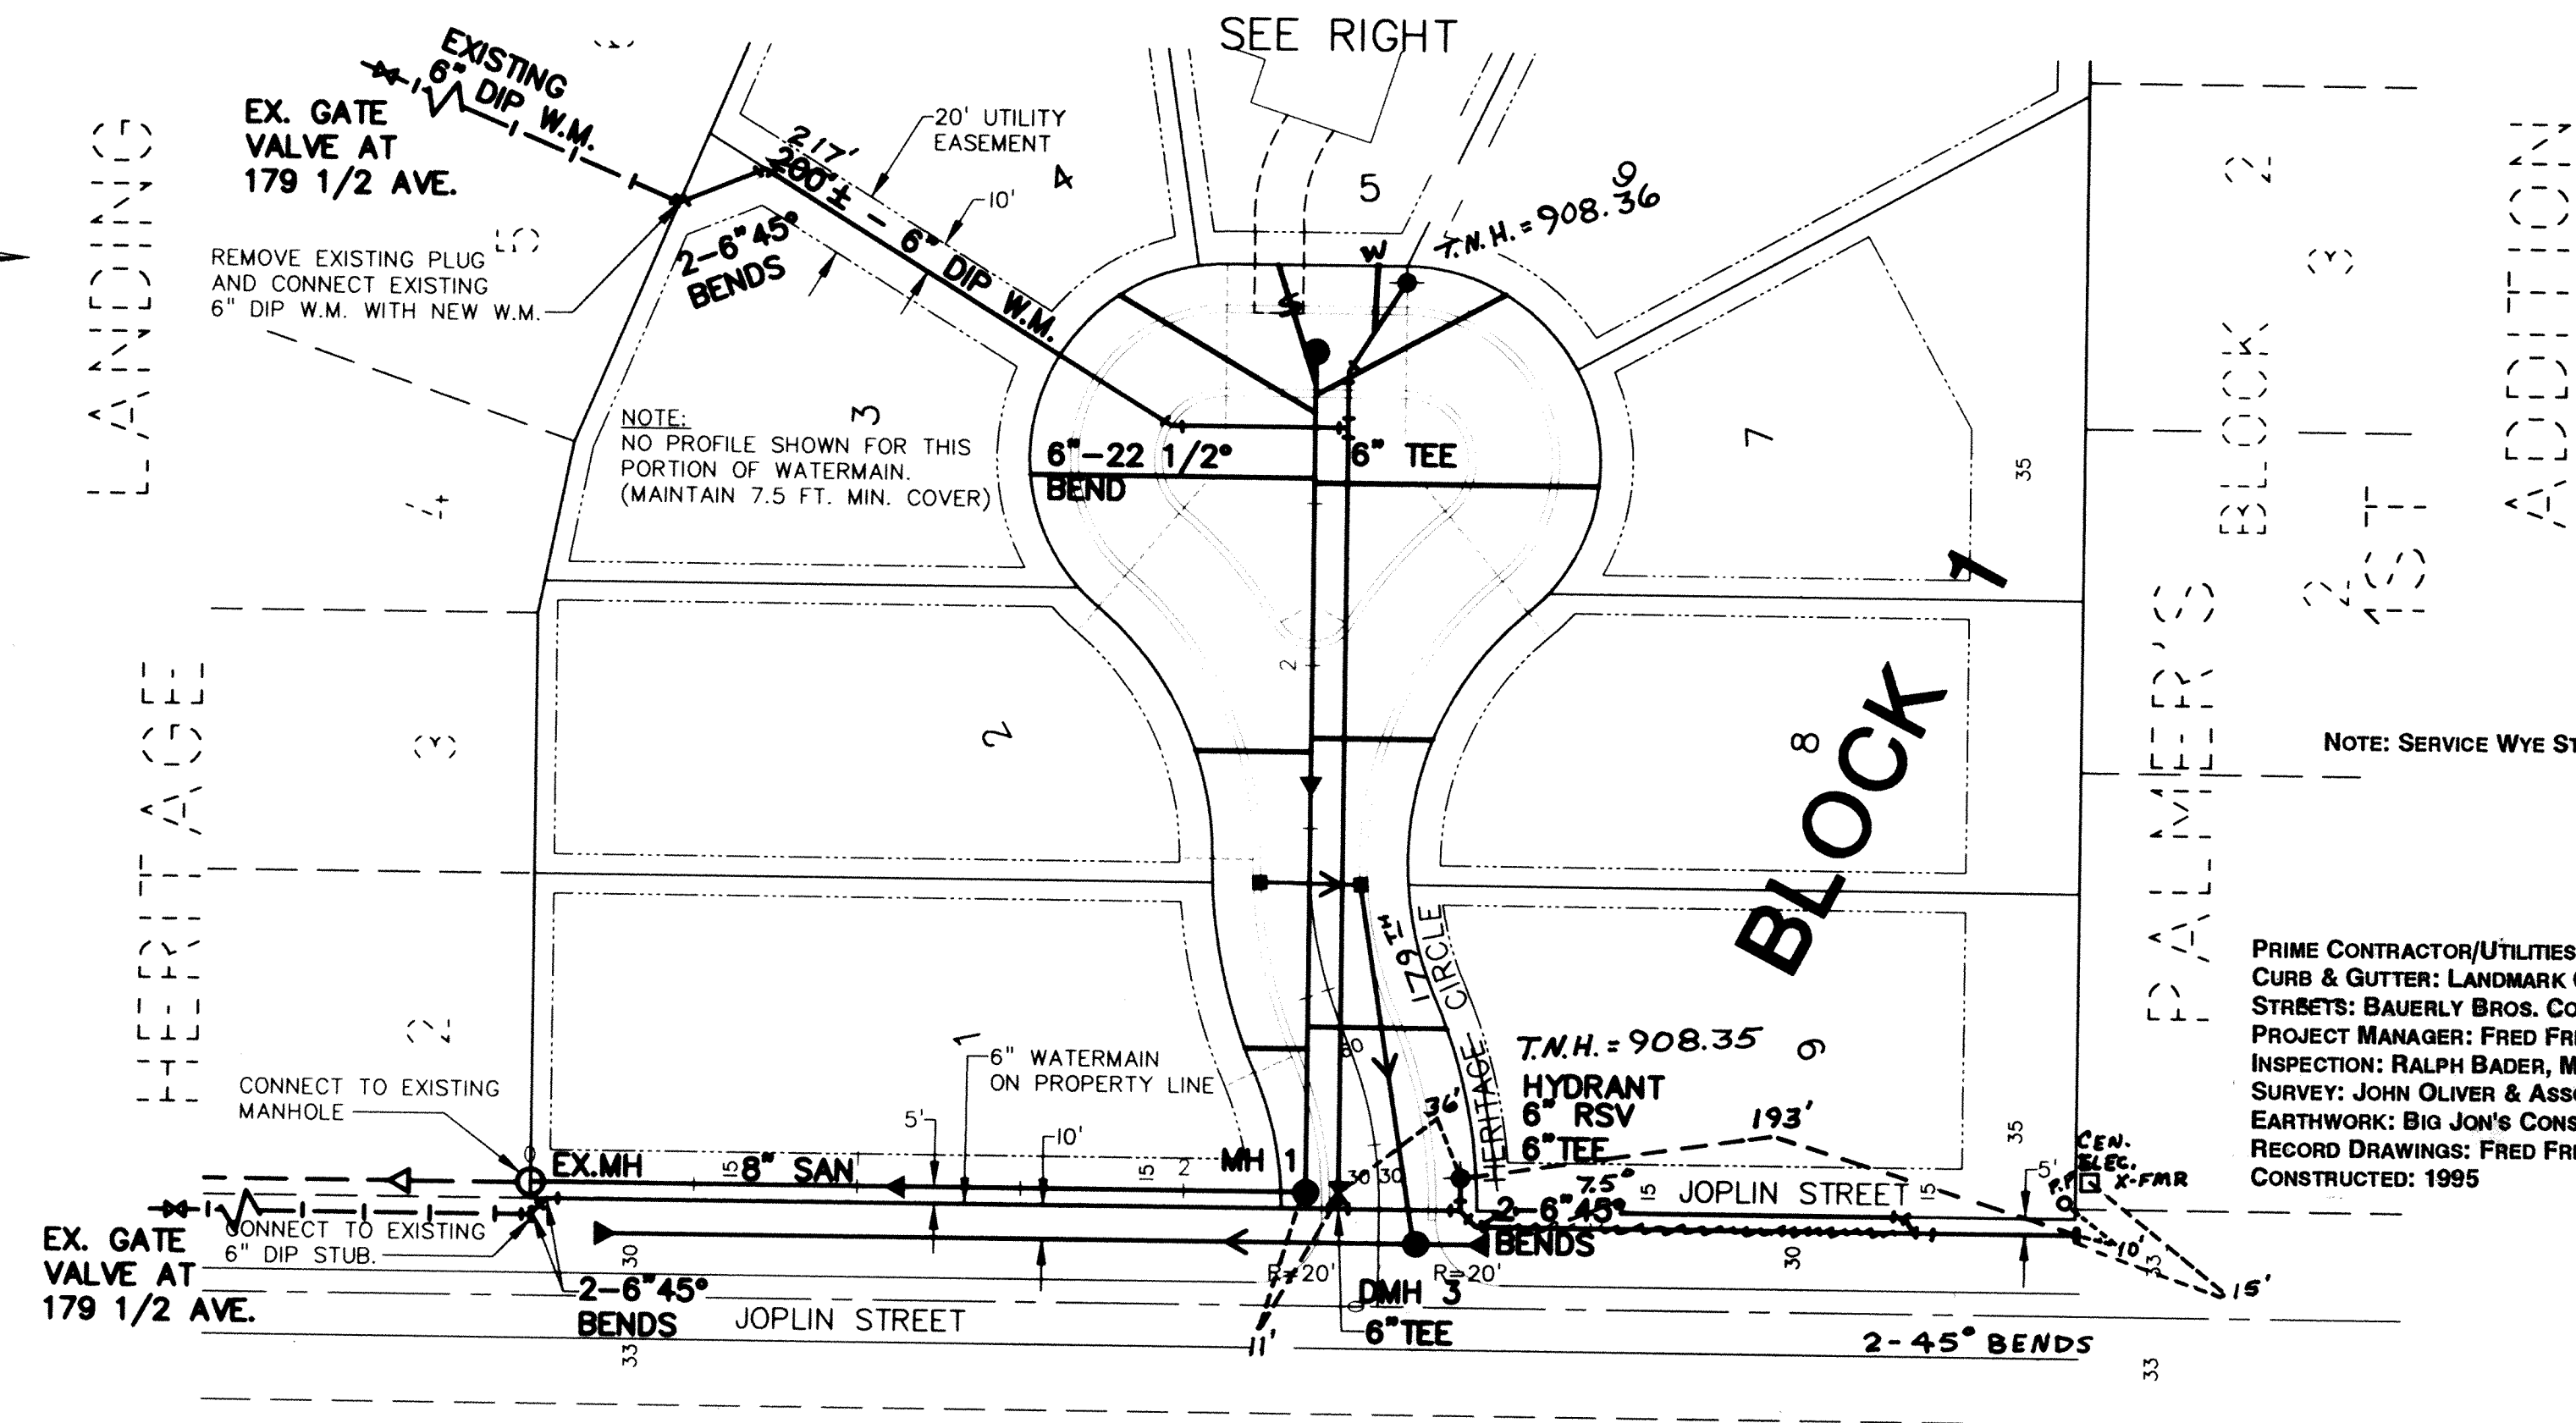


PRIME CONTRACTOR/UTILITIES: BIG JON'S CONSTRUCTION
CURB & GUTTER: LANDMARK CONCRETE, INC.
STREETS: BAUERLY BROS. COMPANIES
PROJECT MANAGER: FRED FRITSCHEL, JOHN OLIVER & ASSOCIATES, INC.
INSPECTION: RALPH BADER, MSA CONSULTING ENGINEERS
SURVEY: JOHN OLIVER & ASSOCIATES, INC.
EARTHWORK: BIG JON'S CONSTRUCTION
RECORD DRAWINGS: FRED FRITSCHEL, JOHN OLIVER & ASSOCIATES, INC.
CONSTRUCTED: 1995

NOTE:
ISLAND TO BE B618
CURB SECTION WITH
OUTFALL GUTTER.

ISLAND TO BE LANDSCAPED
BY OTHERS.

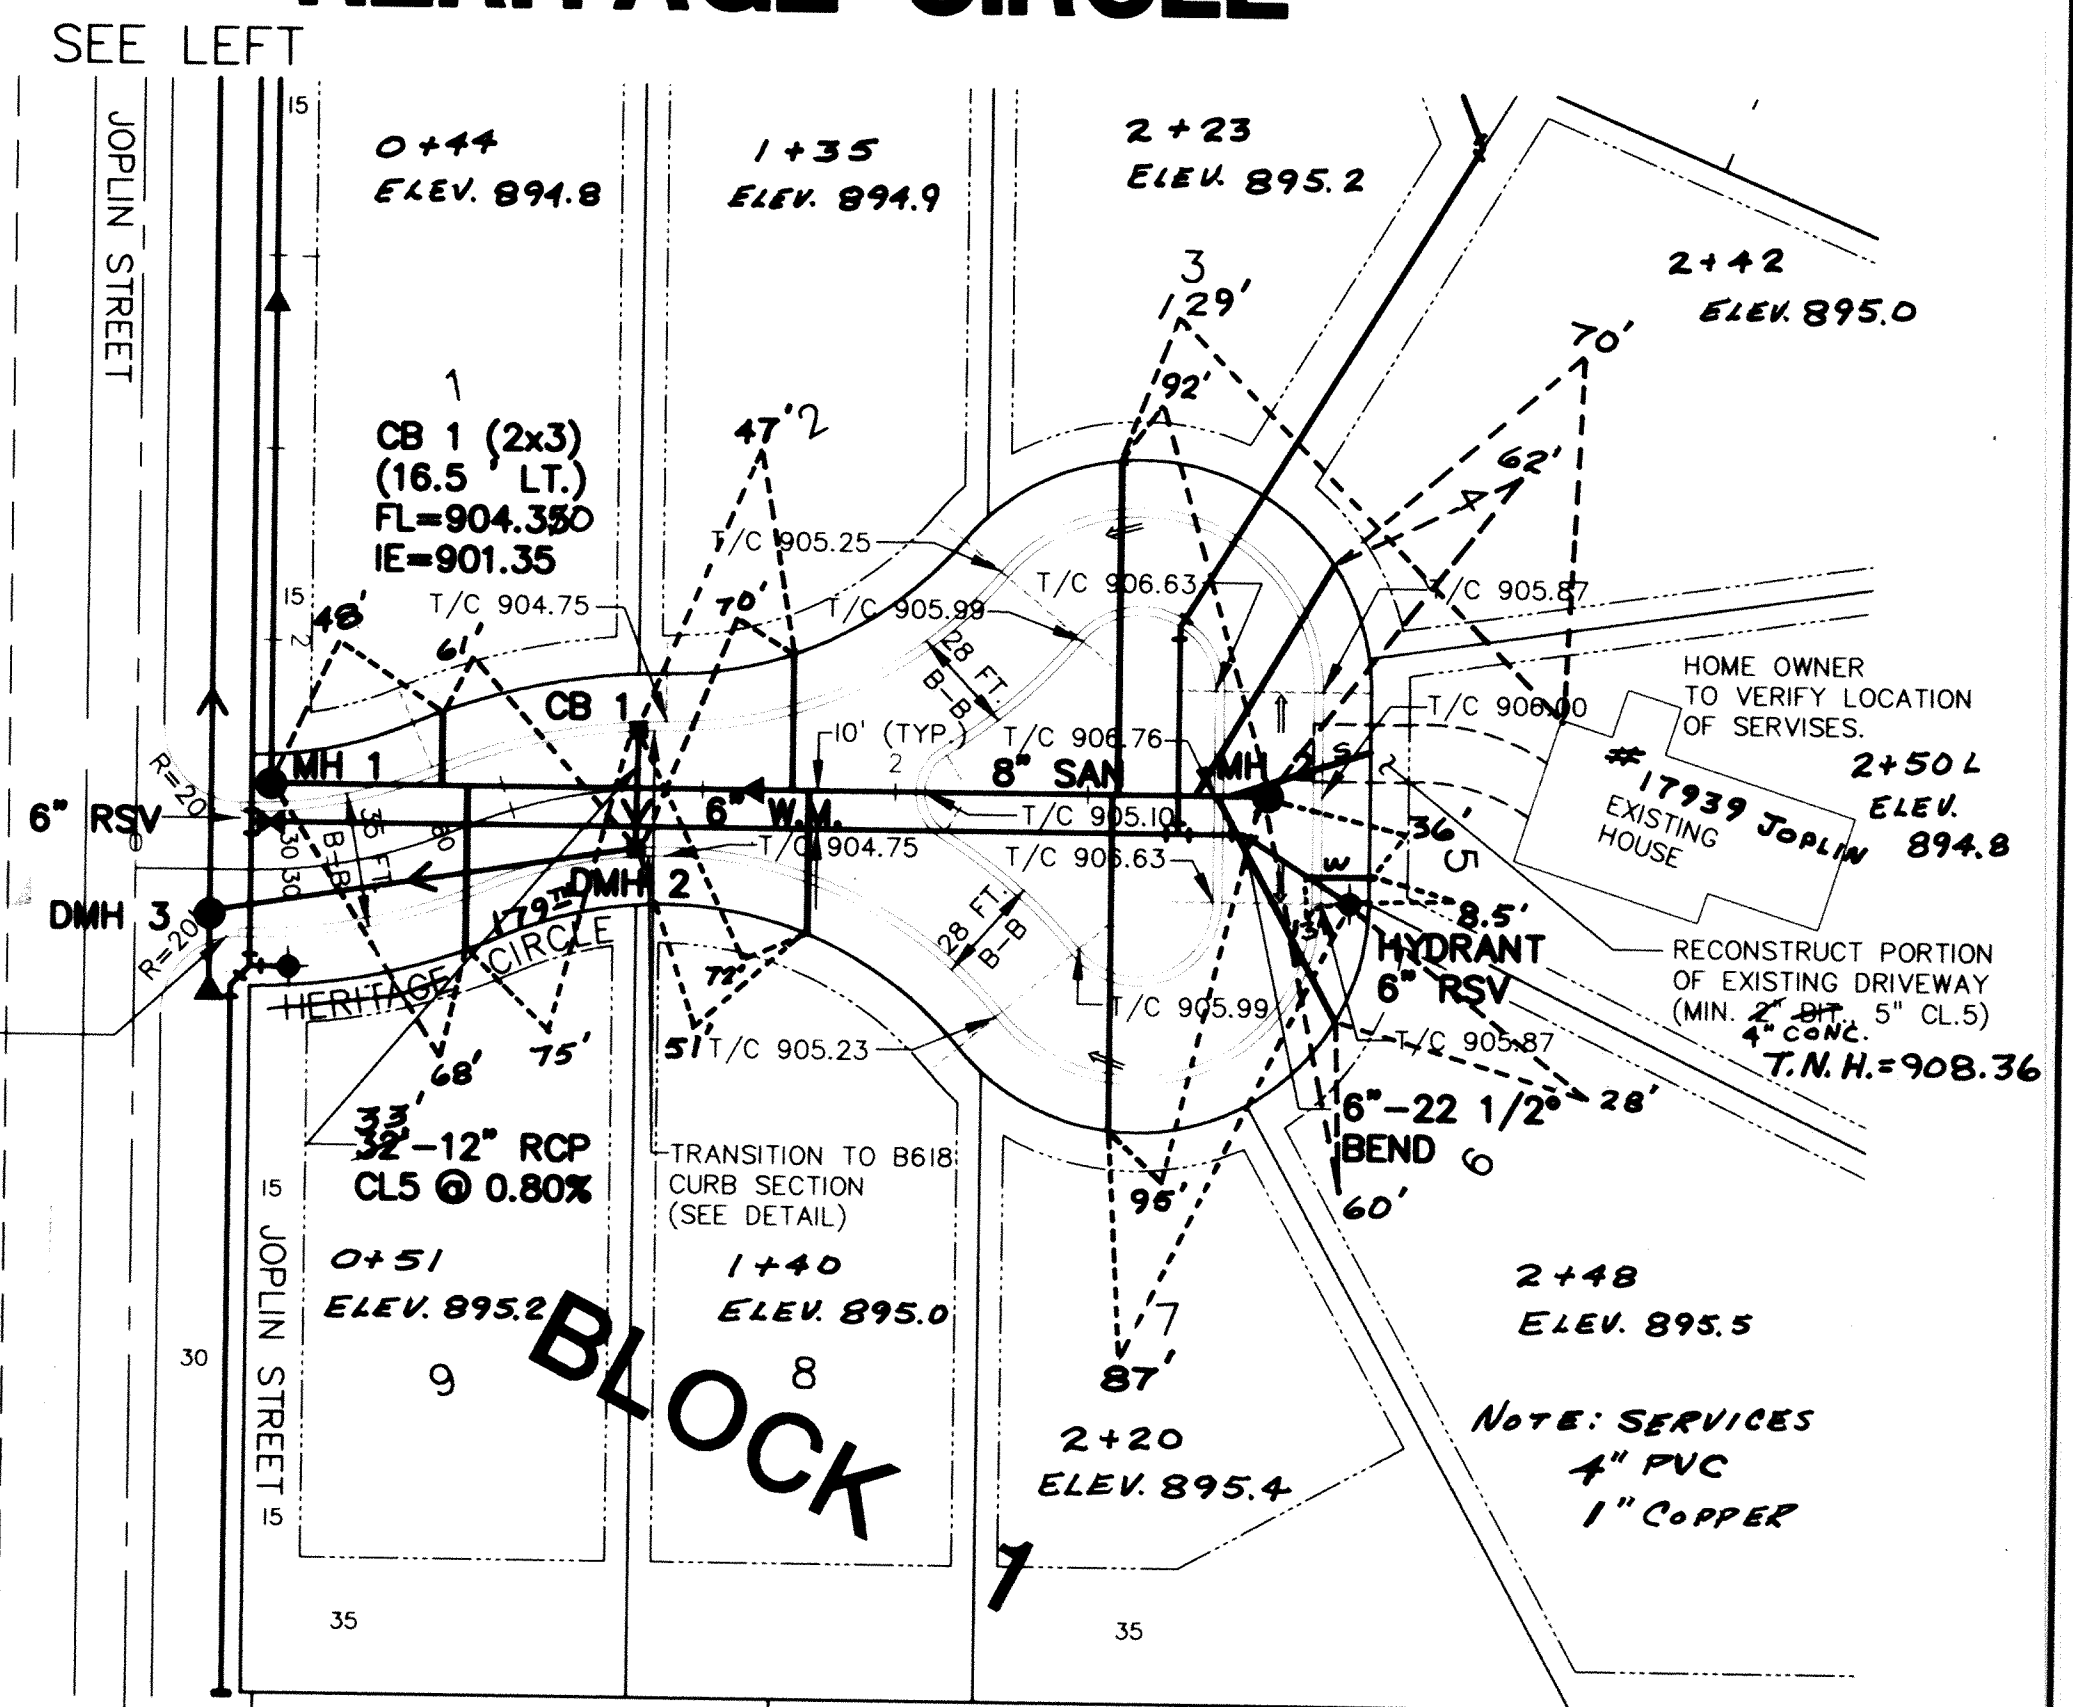

NOTE: CENTERLINE STREET ELEVATIONS HAVE NOT BEEN
SHOT AFTER CONSTRUCTION

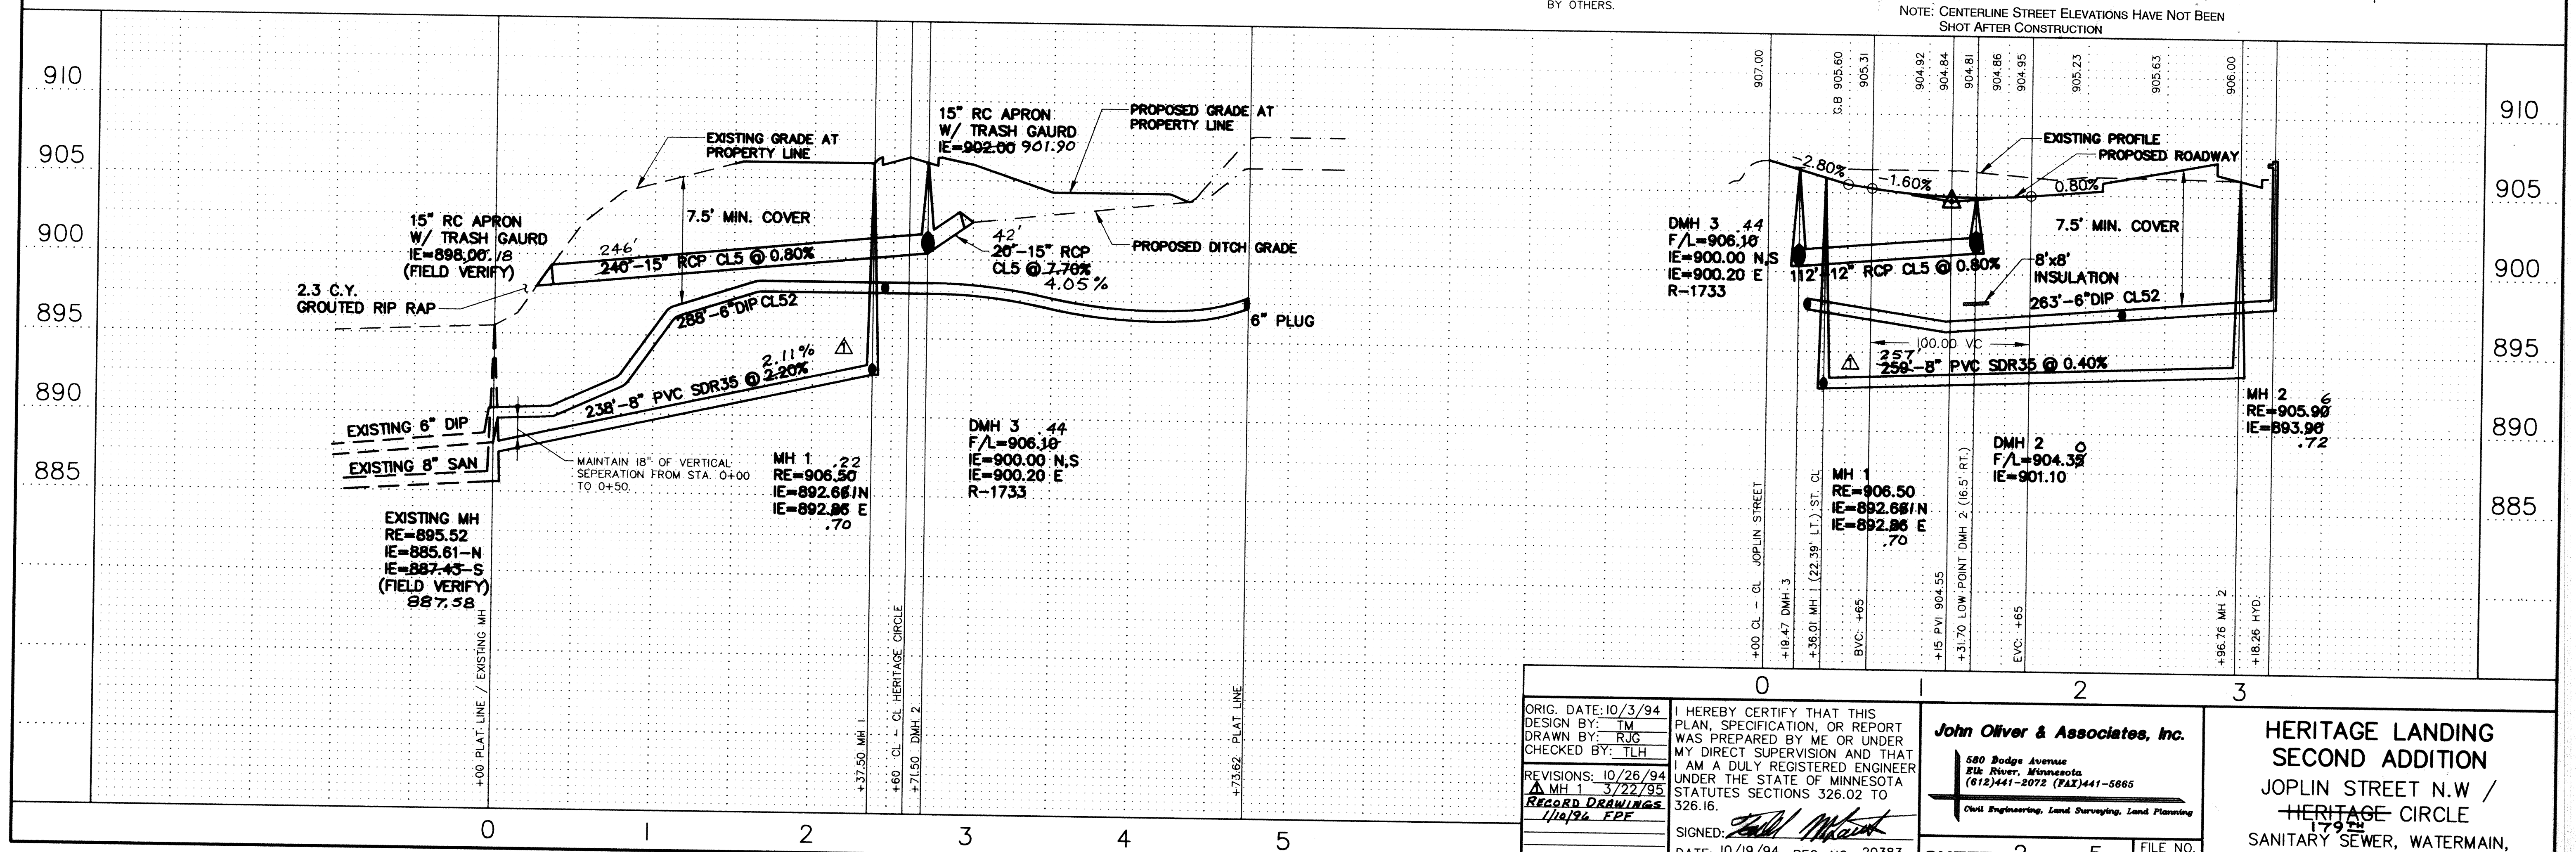

ORIG. DATE: 10/3/94
 DESIGN BY: TM
 DRAWN BY: RJG
 CHECKED BY: TLH
 REVISIONS: 10/26/94
 Δ MH 1 3/22/95
RECORD DRAWINGS
 1/10/96 FPF

4 I HEREBY CERTIFY THAT THIS
PLAN, SPECIFICATION, OR REPORT
WAS PREPARED BY ME OR UNDER
MY DIRECT SUPERVISION AND THAT
I AM A DULY REGISTERED ENGINEER
94 UNDER THE STATE OF MINNESOTA
5 STATUTES SECTIONS 326.02 TO
326.16.

SIGNED: [Signature]
DATE: 10/19/94 REG. NO. 20383

John Oliver & Associates, Inc.

580 Dodge Avenue
Elk River, Minnesota
(612)441-2072 (FAX)441-5665

Civil Engineering, Land Surveying, Land Planning

SHEET <u>2</u> OF <u>5</u>	FILE NO. <u>6197.10</u>
--	----------------------------

HERITAGE LANDING
SECOND ADDITION
JOPLIN STREET N.W. /
~~HERITAGE CIRCLE~~
179th
SANITARY SEWER, WATERMAIN,
STORM SEWER AND STREET