



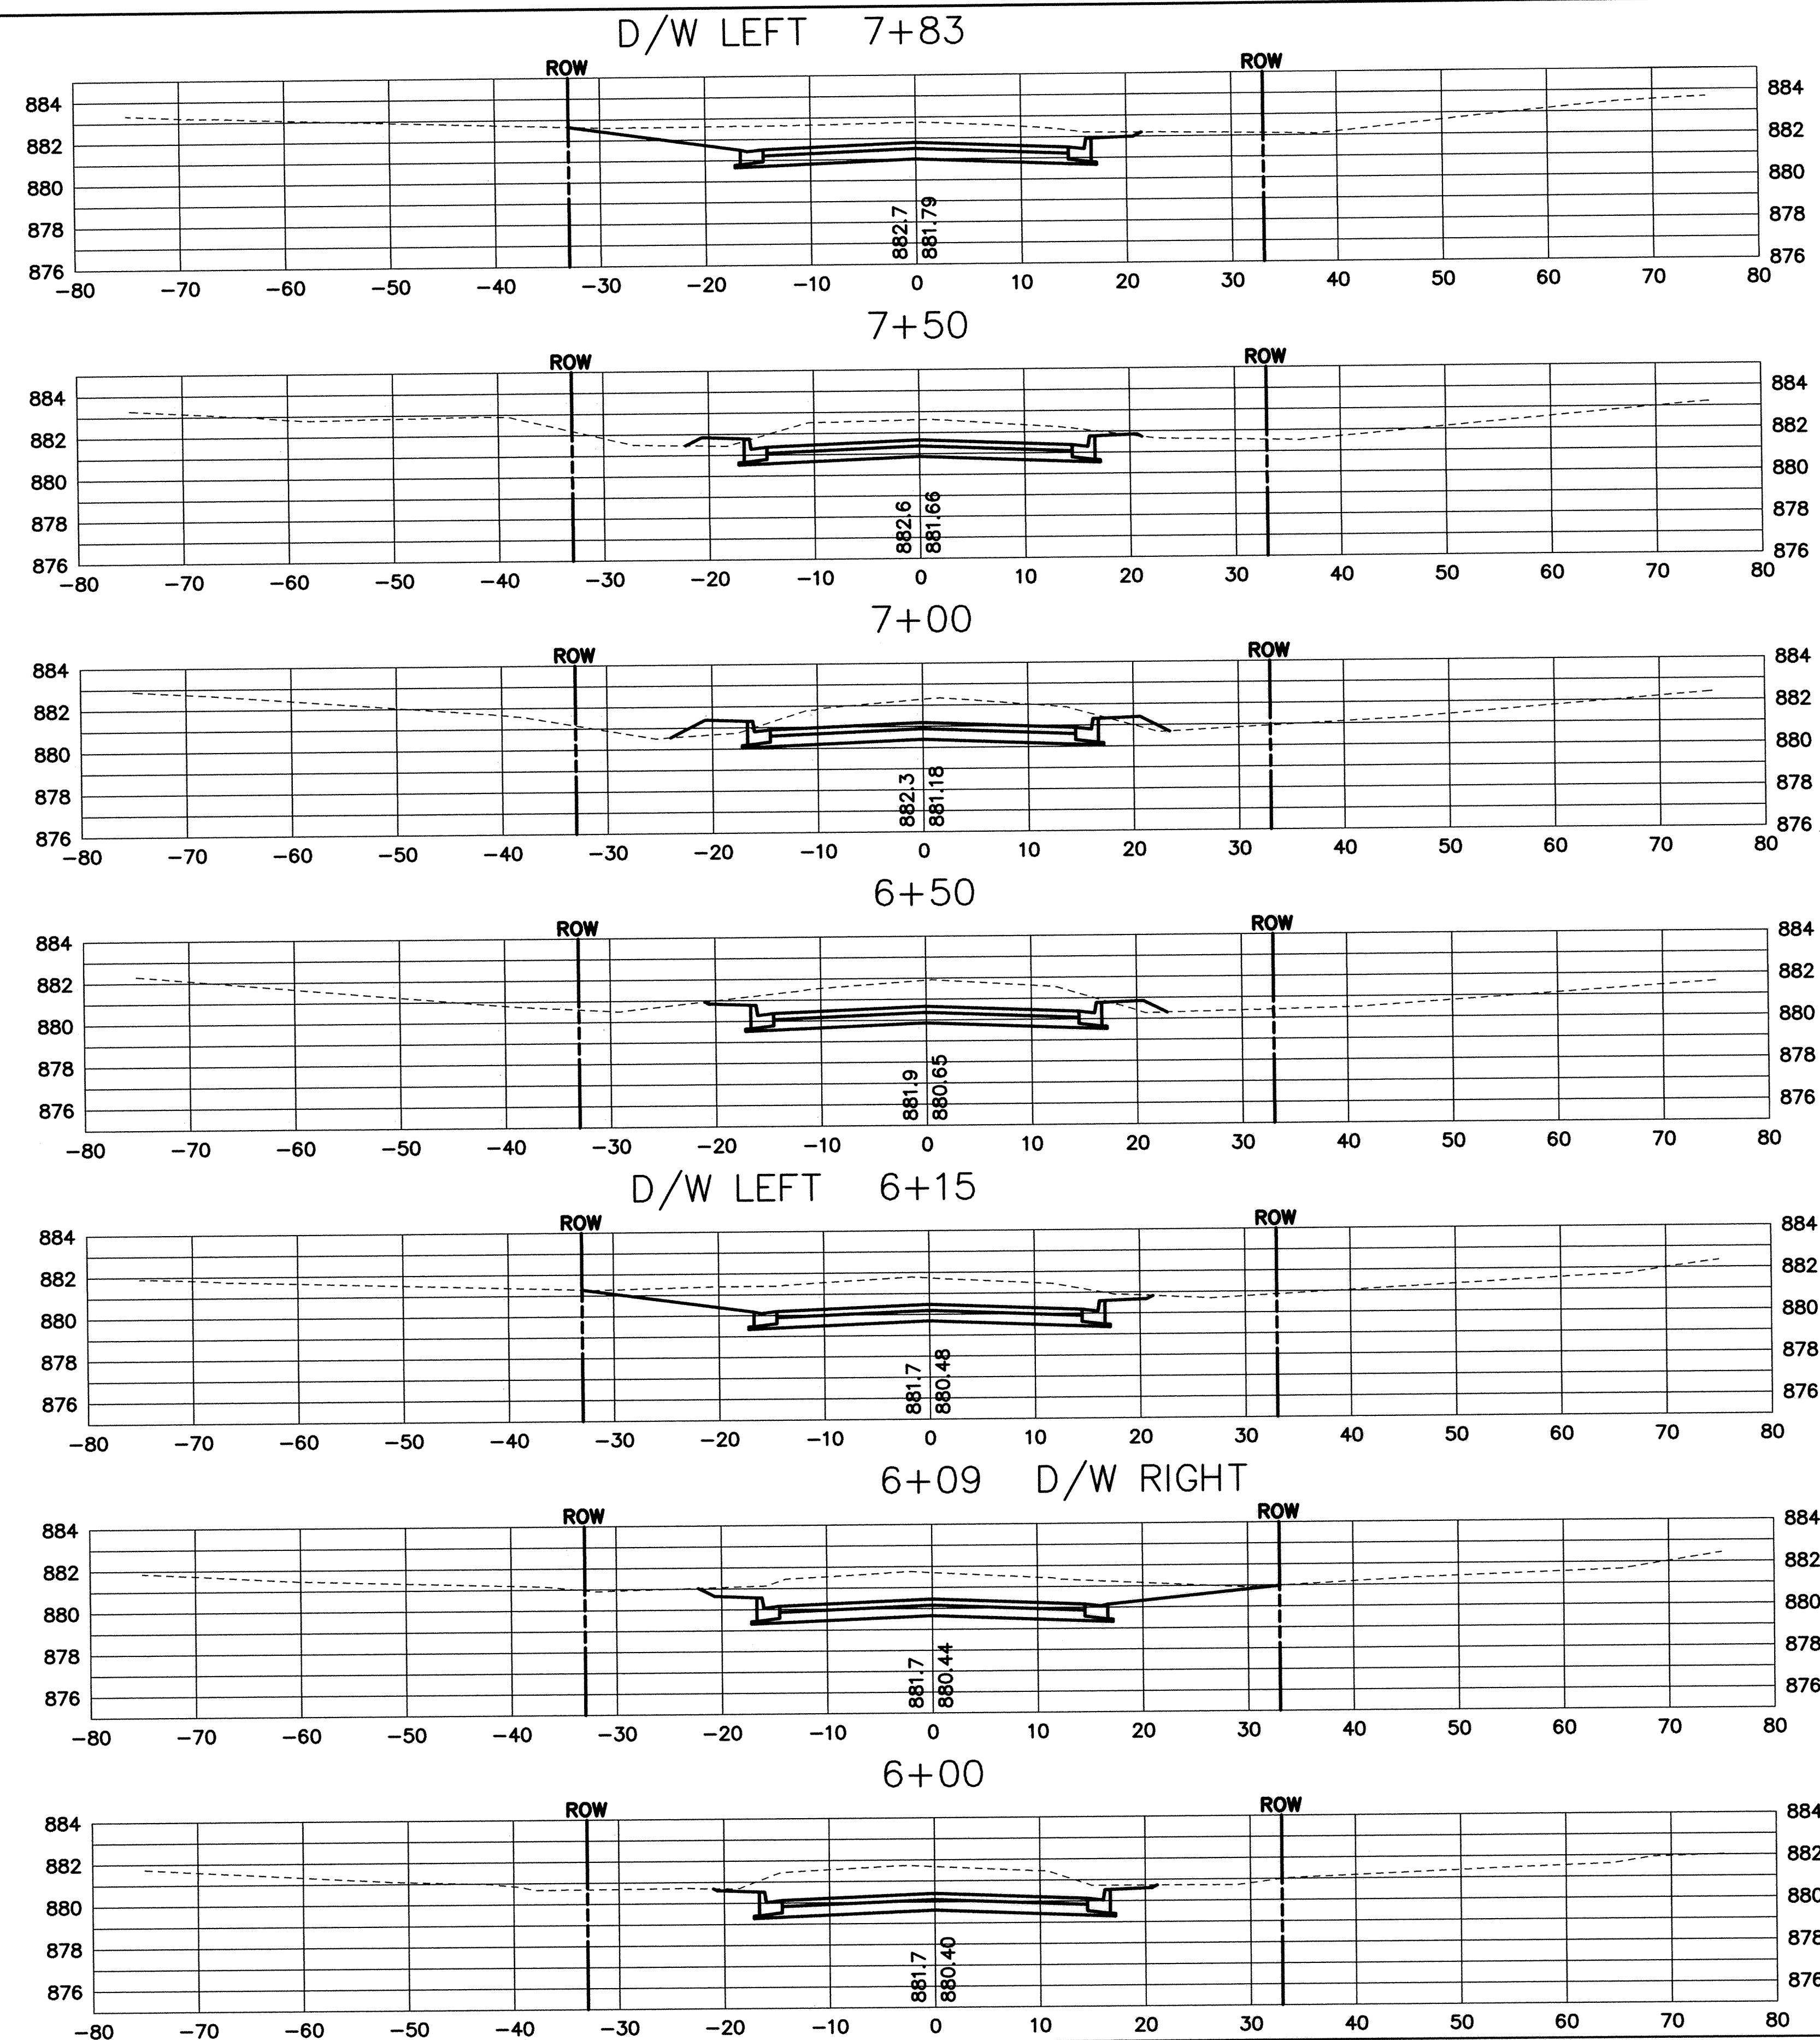

RECORD PLAN
APRIL 2004

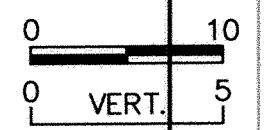


DESIGNED BY: DESIGNED BY: DRAWN BY: RKM
 APPROVED BY: APPROVED BY: JOB NUMBER 818980J
 CAD DATE: April 14, 2003 8:51:15 a.m.
 CAD FILE: 818860J\dwg\C\CT-X03A.DWG (RMONJEA)

I HEREBY CERTIFY THAT THIS PLAN, SPECIFICATION, OR REPORT
 WAS PREPARED BY ME OR UNDER MY DIRECT SUPERVISION AND
 THAT I AM A DULY LICENSED PROFESSIONAL ENGINEER UNDER
 THE LAWS OF THE STATE OF MINNESOTA.

SIGNATURE _____ DATE _____
 PRINTED NAME KRISTINA THOMPSON LIC. NO. 42350

NO.	DATE	BY	REVISION DESCRIPTION

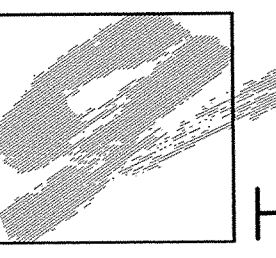

1326 ENERGY PARK DRIVE
 ST. PAUL, MINNESOTA 55108
 (651) 644-4389

Howard R. Green Company

CONCORD/BOSTON STREET IMPROVEMENTS
CITY OF ELK RIVER

CROSS SECTIONS
CONCORD STREET
6+00 TO 7+83

SHEET NO.
12