


CO. PRODUCTS • NEW HOPE, MINNESOTA
DESIGNED BY PART NUMBER 5552
PROJECT NUMBER 5552
PARTIAL SCALE OF PRINT ON THIS LINE

CO. PRODUCTS • NEW HOPE, MINNESOTA
DESIGNED BY PART NUMBER 5552
PROJECT NUMBER 5552
PARTIAL SCALE OF PRINT ON THIS LINE


CO. PRODUCTS • NEW HOPE, MINNESOTA
DESIGNED BY PART NUMBER 5552
PROJECT NUMBER 5552
PARTIAL SCALE OF PRINT ON THIS LINE

CO. PRODUCTS • NEW HOPE, MINNESOTA
DESIGNED BY PART NUMBER 5552
PROJECT NUMBER 5552
PARTIAL SCALE OF PRINT ON THIS LINE


9+05.78 ORONO ROAD

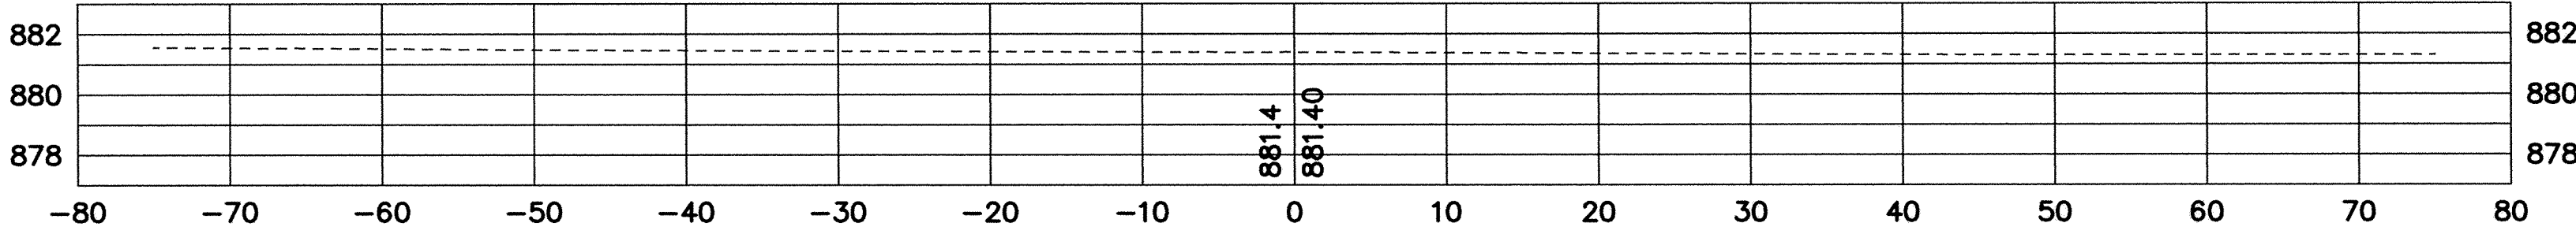


9+00

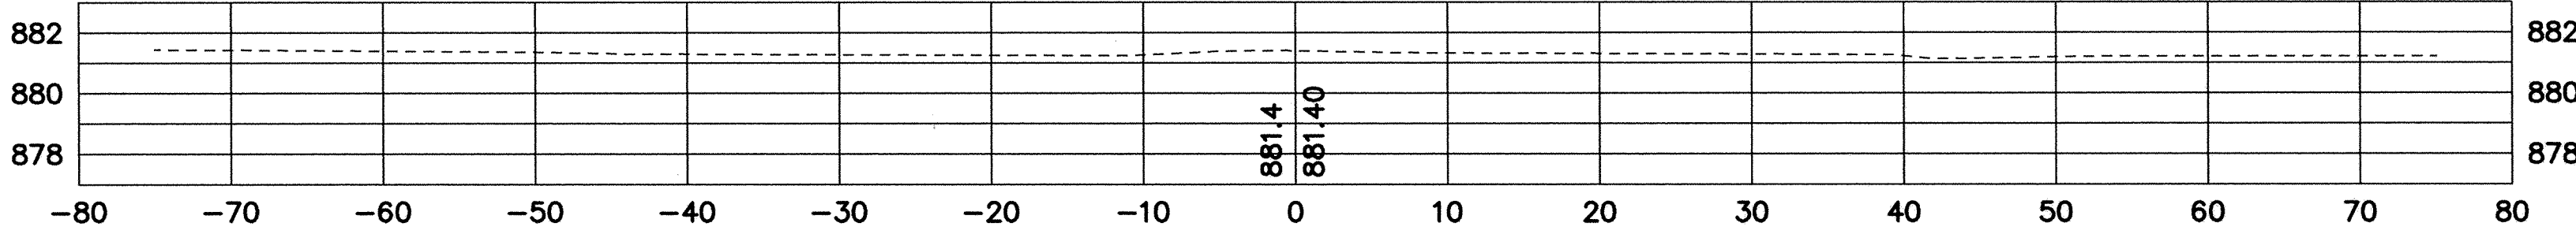


8+50

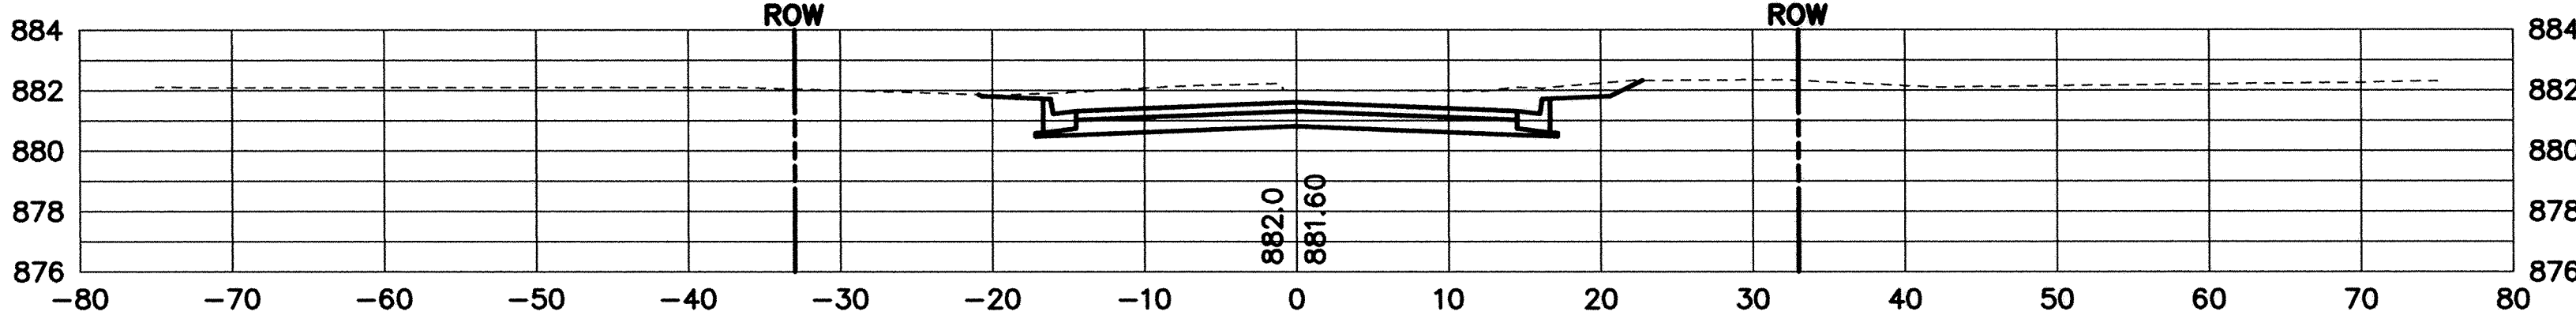


8+38 D/W RIGHT

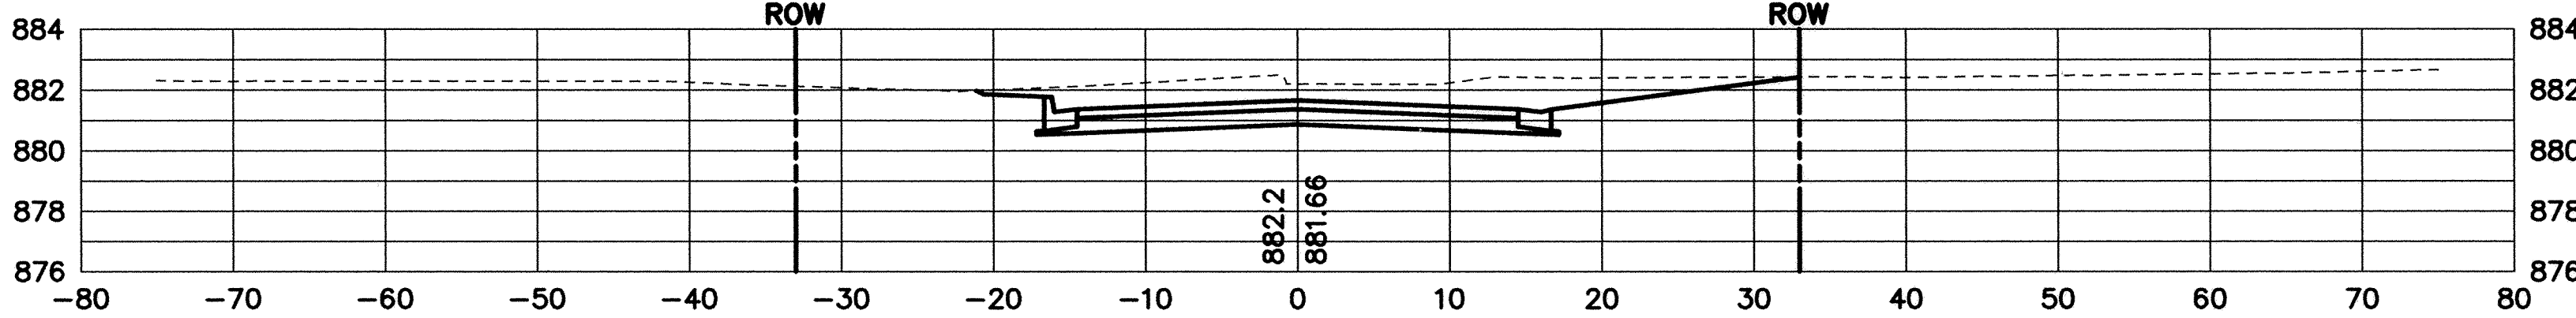

8+00

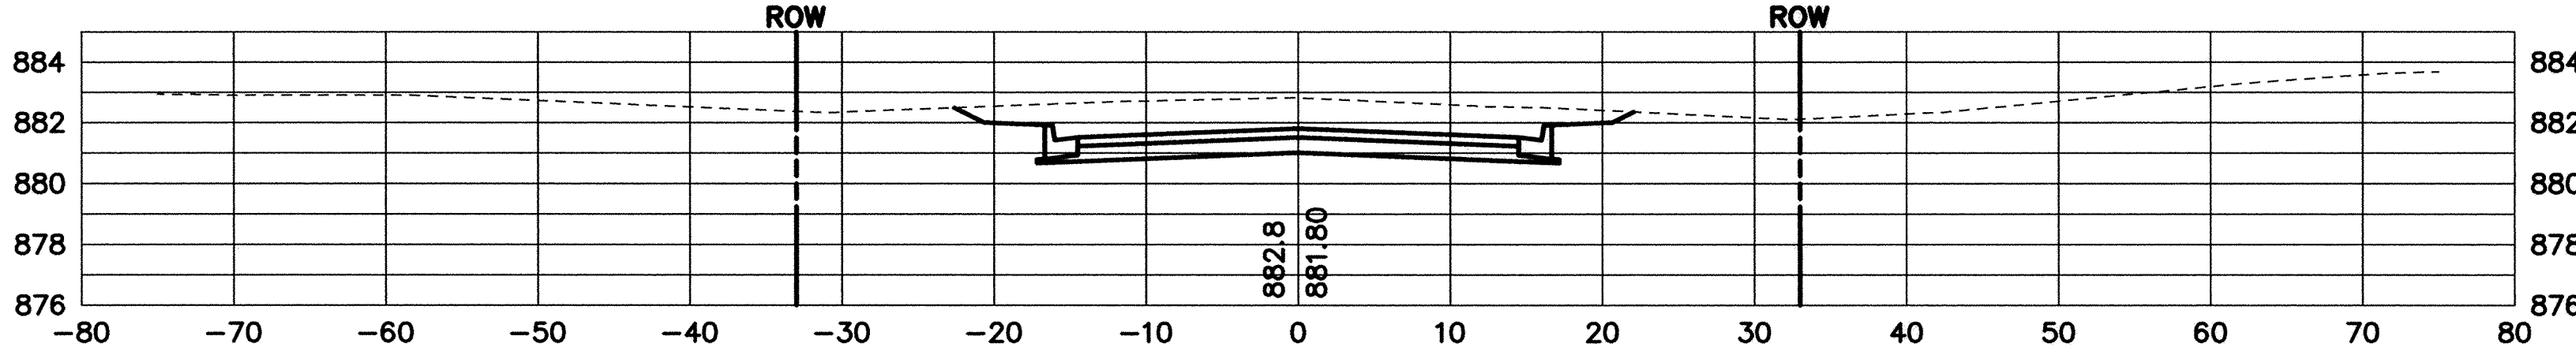

RECORD PLAN
APRIL 2004

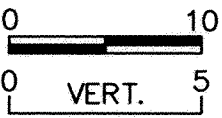


DESIGNED BY: DESIGNED BY DRAWN BY: RKM
APPROVED BY: APPROVED BY JOB NUMBER 818980J
CAD DATE: April 14, 2003 8:51:58 a.m.
CAD FILE: 818860J\dwg\CT-X03B.DWG (RMONJEA)

I HEREBY CERTIFY THAT THIS PLAN, SPECIFICATION, OR REPORT
WAS PREPARED BY ME OR UNDER MY DIRECT SUPERVISION AND
THAT I AM A DULY LICENSED PROFESSIONAL ENGINEER UNDER
THE LAWS OF THE STATE OF MINNESOTA.

SIGNATURE _____ DATE _____
PRINTED NAME KRISTINA THOMPSON LIC. NO. 42350

NO.	DATE	BY	REVISION DESCRIPTION

1326 ENERGY PARK DRIVE
ST. PAUL, MINNESOTA 55108
(651) 644-4389

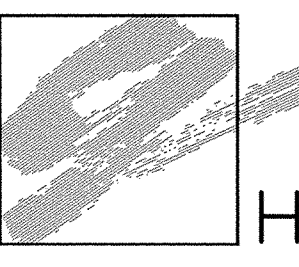 Howard R. Green Company

CONCORD/BOSTON STREET IMPROVEMENTS
CITY OF ELK RIVER

CROSS SECTIONS
CONCORD STREET
8+00 TO 9+05.78

SHEET NO.
13