




RECORD PLAN
APRIL 2004

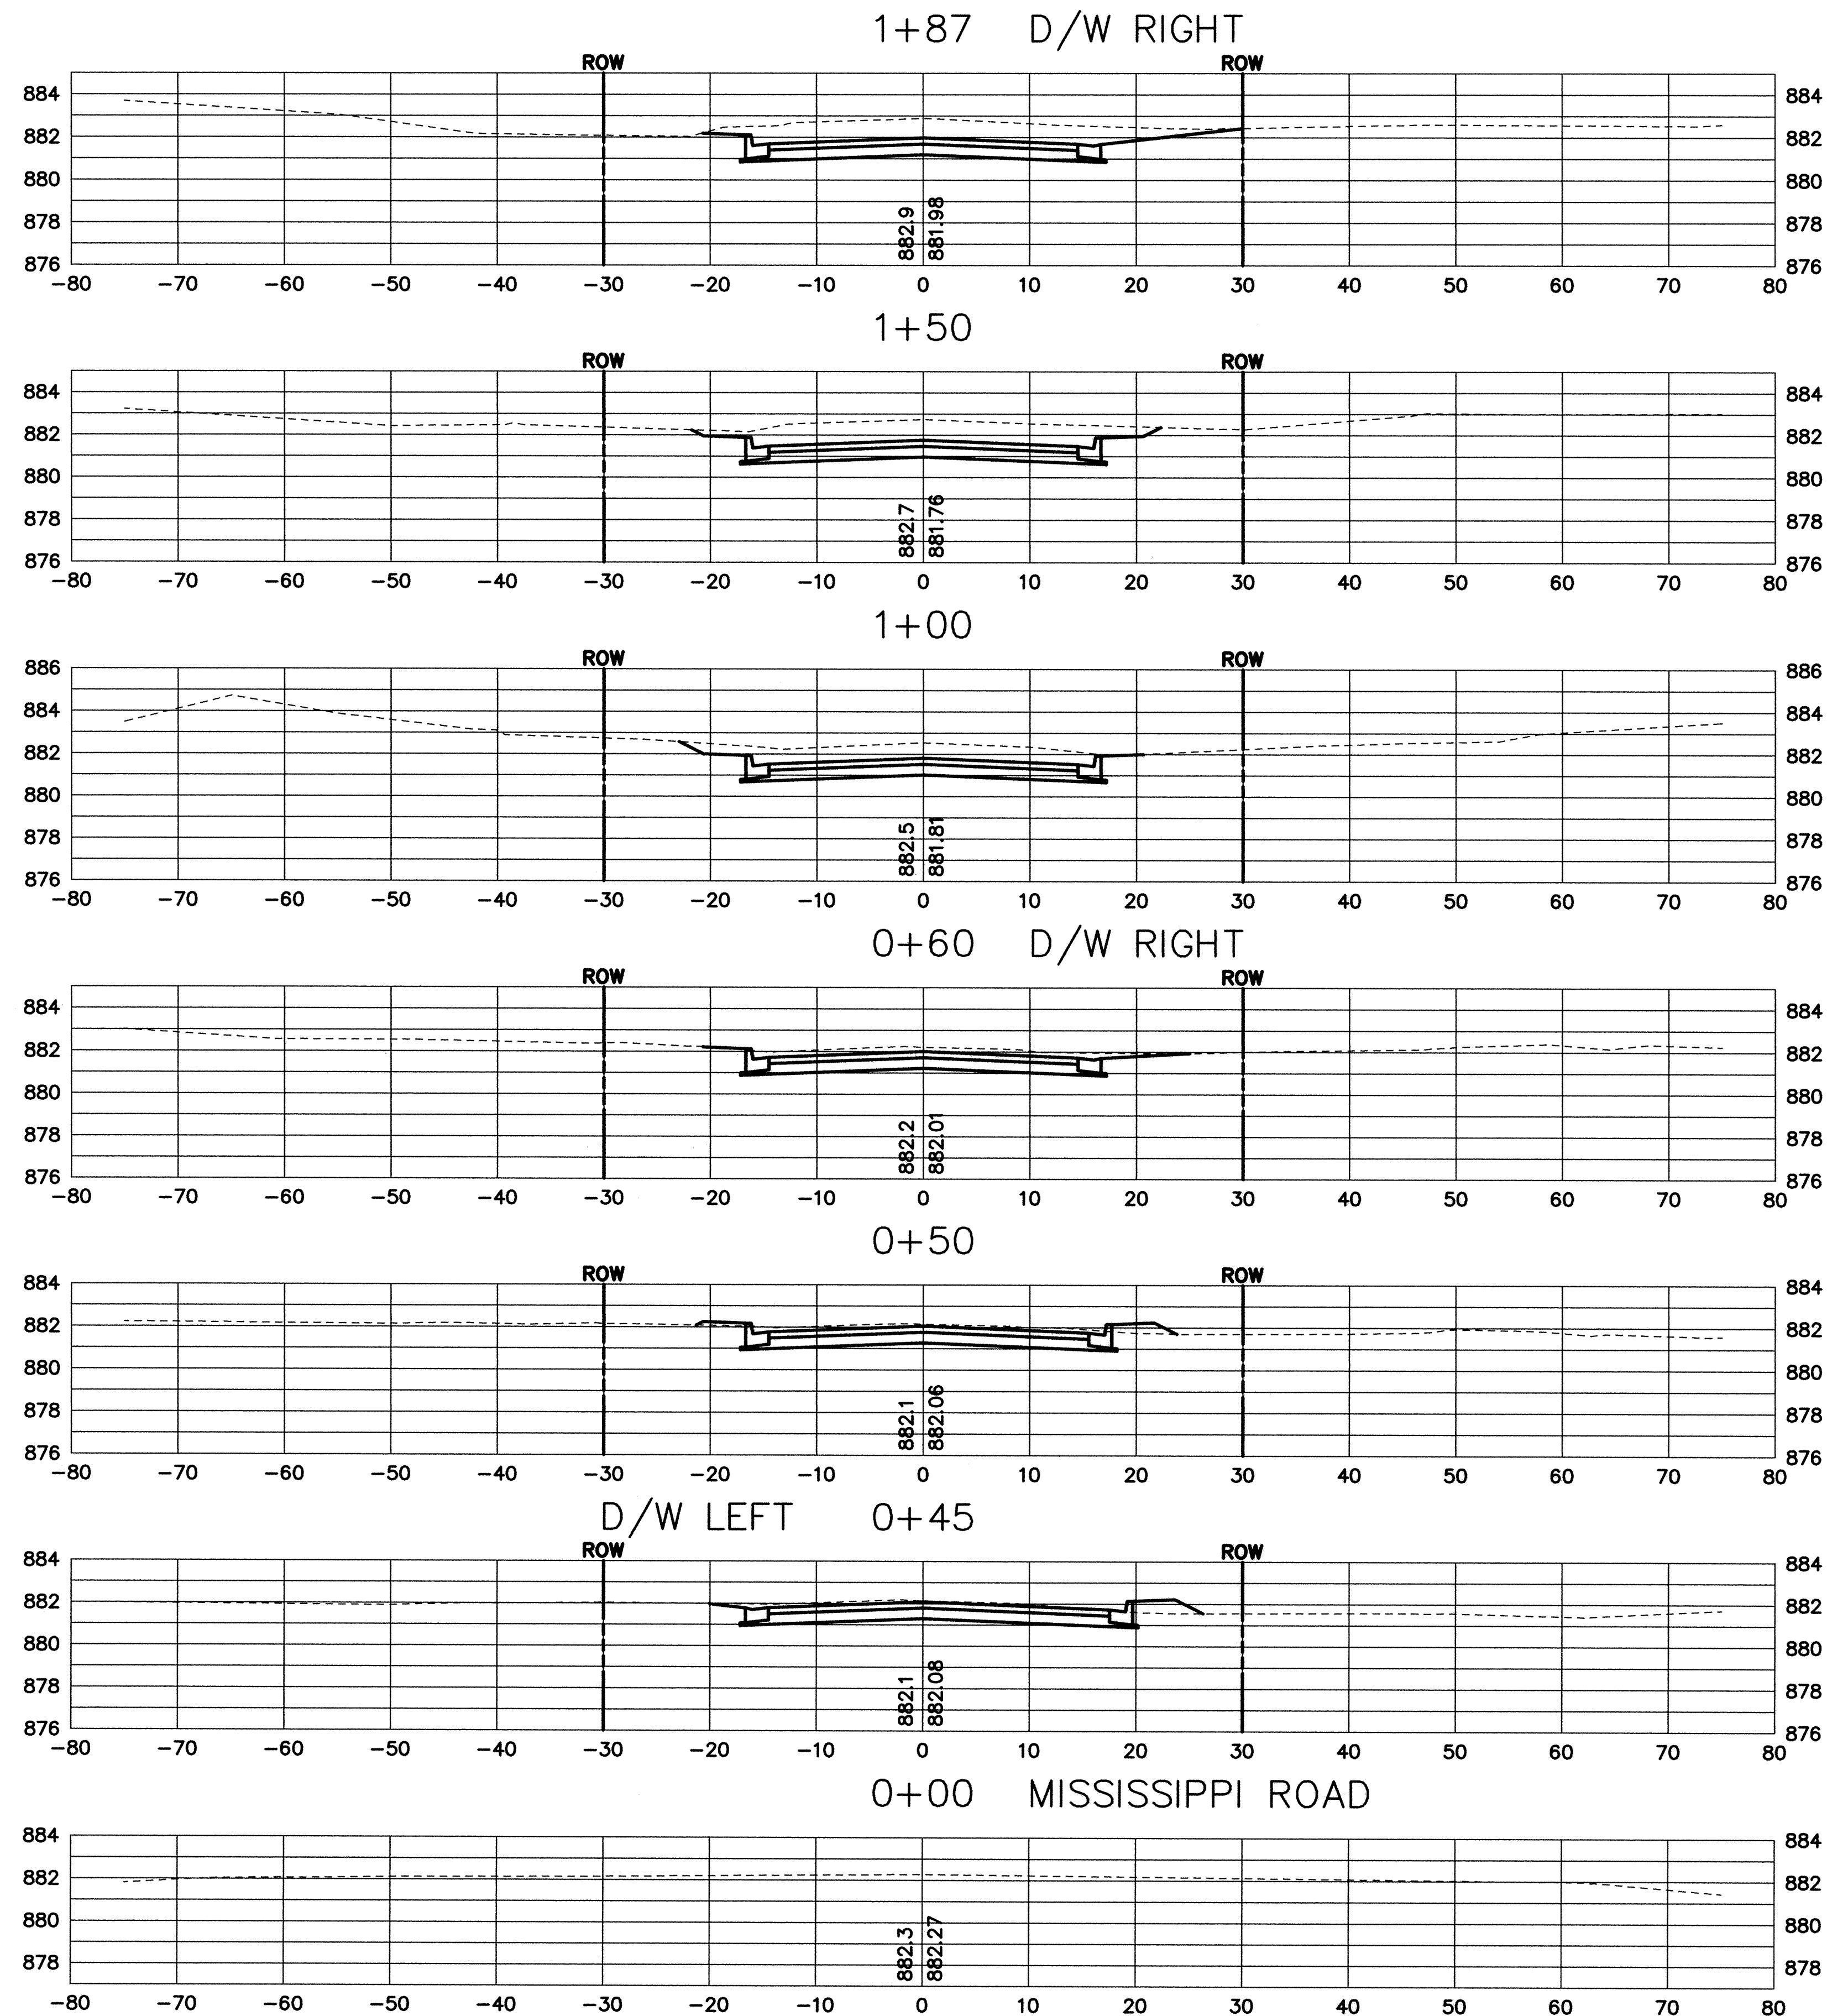


Xref: XSECT-BASE.DWG

DESIGNED BY: DESIGNED BY: DRAWN BY: RKM
APPROVED BY: APPROVED BY: JOB NUMBER 818980J
CAD DATE: April 14, 2003 8:53:15 a.m.
CAD FILE: 818860J\dwg\CT-X04.DWG (RMONJEA)

I HEREBY CERTIFY THAT THIS PLAN, SPECIFICATION, OR REPORT
WAS PREPARED BY ME OR UNDER MY DIRECT SUPERVISION AND
THAT I AM A DULY LICENSED PROFESSIONAL ENGINEER UNDER
THE LAWS OF THE STATE OF MINNESOTA.

SIGNATURE _____ DATE _____
PRINTED NAME KRISTINA THOMPSON LIC. NO. 42350

NO.	DATE	BY	REVISION DESCRIPTION

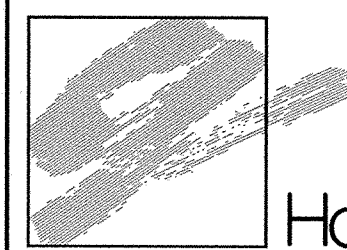

Howard R. Green Company

1326 ENERGY PARK DRIVE
ST. PAUL, MINNESOTA 55108
(651) 644-4389

CONCORD/BOSTON STREET IMPROVEMENTS
CITY OF ELK RIVER

CROSS SECTIONS
BOSTON STREET

0+00 TO 1+87

SHEET NO.

14