

CONCORD STREET

STATION	AREAS Square Feet		VOLUMES Cubic Yards		CUMULATIVE VOLUMES Cubic Yards	
	CUT	FILL	CUT	FILL	CUT	FILL
0+00	0.00	0.00				
0+50	38.38	2.02	35.54	1.87	35.54	1.87
0+72	60.06	0.00	40.10	0.82	75.64	2.69
1+00	68.96	0.00	66.90	0.00	142.54	2.69
1+18	89.06	0.00	52.67	0.00	195.21	2.69
1+50	86.89	0.00	105.38	0.00	300.59	2.69
2+00	90.37	0.00	164.69	0.00	465.28	2.69
2+50	95.03	0.00	172.02	0.00	637.30	2.69
2+89	125.06	0.00	160.33	0.00	797.63	2.69
3+00	100.02	0.00	46.29	0.00	843.92	2.69
3+50	101.28	0.00	186.68	0.00	1030.60	2.69
3+68	130.80	0.00	77.99	0.00	1108.59	2.69
4+00	97.50	0.00	136.06	0.00	1244.65	2.69
4+14	133.69	0.00	59.94	0.00	1304.59	2.69
4+50	101.53	0.17	156.81	0.11	1461.40	2.80
5+00	121.70	0.01	206.29	0.15	1667.69	2.95
5+04	142.93	0.00	19.43	0.00	1687.13	2.96
5+21	152.88	0.00	93.08	0.00	1780.20	2.96
5+50	110.67	0.00	142.10	0.00	1922.30	2.96
6+00	102.51	0.00	197.06	0.00	2119.36	2.96
6+09	115.73	0.00	36.43	0.00	2155.79	2.96
6+15	122.77	0.02	26.54	0.00	2182.33	2.96
6+50	84.88	0.02	134.94	0.03	2317.27	2.98
7+00	67.61	1.91	141.18	1.78	2458.44	4.77
7+50	60.66	1.05	118.71	2.78	2577.16	7.54
7+83	70.83	0.00	80.44	0.64	2657.60	8.19
8+00	66.93	0.00	43.43	0.00	2701.03	8.19
8+38	61.78	0.00	90.57	0.00	2791.60	8.19
8+50	49.33	0.00	24.69	0.00	2816.29	8.19
9+00	0.00	0.00	45.68	0.00	2861.96	8.19
9+05.78	0.00	0.00	0.00	0.00	2861.96	8.19
			0.00	0.00	2861.96	8.19

BOSTON STREET

STATION	AREAS Square Feet		VOLUMES Cubic Yards		CUMULATIVE VOLUMES Cubic Yards	
	CUT	FILL	CUT	FILL	CUT	FILL
0+00	0.00	0.00				
0+45	32.64	3.26	27.20	2.72	27.20	2.72
0+50	32.91	2.95	6.07	0.58	33.27	3.30
0+60	35.97	0.12	12.76	0.57	46.03	3.86
1+00	52.68	0.03	65.67	0.11	111.70	3.98
1+50	62.55	0.00	106.69	0.03	218.39	4.01
1+87	62.20	0.00	85.47	0.00	303.86	4.01
2+00	56.08	1.40	28.47	0.34	332.34	4.35
2+44	52.08	0.00	88.13	1.14	420.47	5.49
2+50	47.59	0.00	11.07	0.00	431.54	5.49
3+00	37.68	0.09	78.95	0.08	510.50	5.57
3+35	43.51	0.00	52.62	0.06	563.12	5.63
3+50	48.57	0.00	25.58	0.00	588.69	5.63
4+00	77.69	0.00	116.91	0.00	705.60	5.63
4+23	104.94	0.00	77.79	0.00	783.39	5.63
4+50	81.54	0.00	93.24	0.00	876.63	5.63
5+00	83.24	0.00	152.57	0.00	1029.20	5.63
5+50	60.09	0.00	132.71	0.00	1161.92	5.63
5+90	51.36	0.00	82.56	0.00	1244.48	5.63
6+00	57.25	0.00	20.11	0.00	1264.59	5.63
6+49.18	0.00	0.00	52.14	0.00	1316.73	5.63
			0.00	0.00	1316.73	5.63




RECORD PLAN
APRIL 2004

DESIGNED BY: DESIGNED BY DRAWN BY: RKM
APPROVED BY: APPROVED BY JOB NUMBER 818980J
CAD DATE: April 14, 2003 9:03:29 a.m.
CAD FILE: 818860J\dwg\C\CT-XVOL.DWG (RMONJEA)

I HEREBY CERTIFY THAT THIS PLAN, SPECIFICATION, OR REPORT
WAS PREPARED BY ME OR UNDER MY DIRECT SUPERVISION AND
THAT I AM A DULY LICENSED PROFESSIONAL ENGINEER UNDER
THE LAWS OF THE STATE OF MINNESOTA.
SIGNATURE _____ DATE _____
PRINTED NAME KRISTINA THOMPSON LIC. NO. 42350

NO.	DATE	BY	REVISION DESCRIPTION

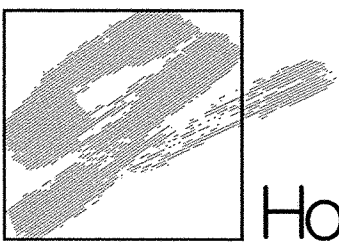

Howard R. Green Company

1326 ENERGY PARK DRIVE
ST. PAUL, MINNESOTA 55108
(651) 644-4389

CONCORD/BOSTON STREET IMPROVEMENTS
CITY OF ELK RIVER

CROSS SECTIONS
CONCORD STREET/BOSTON STREET

SHEET NO.
17