

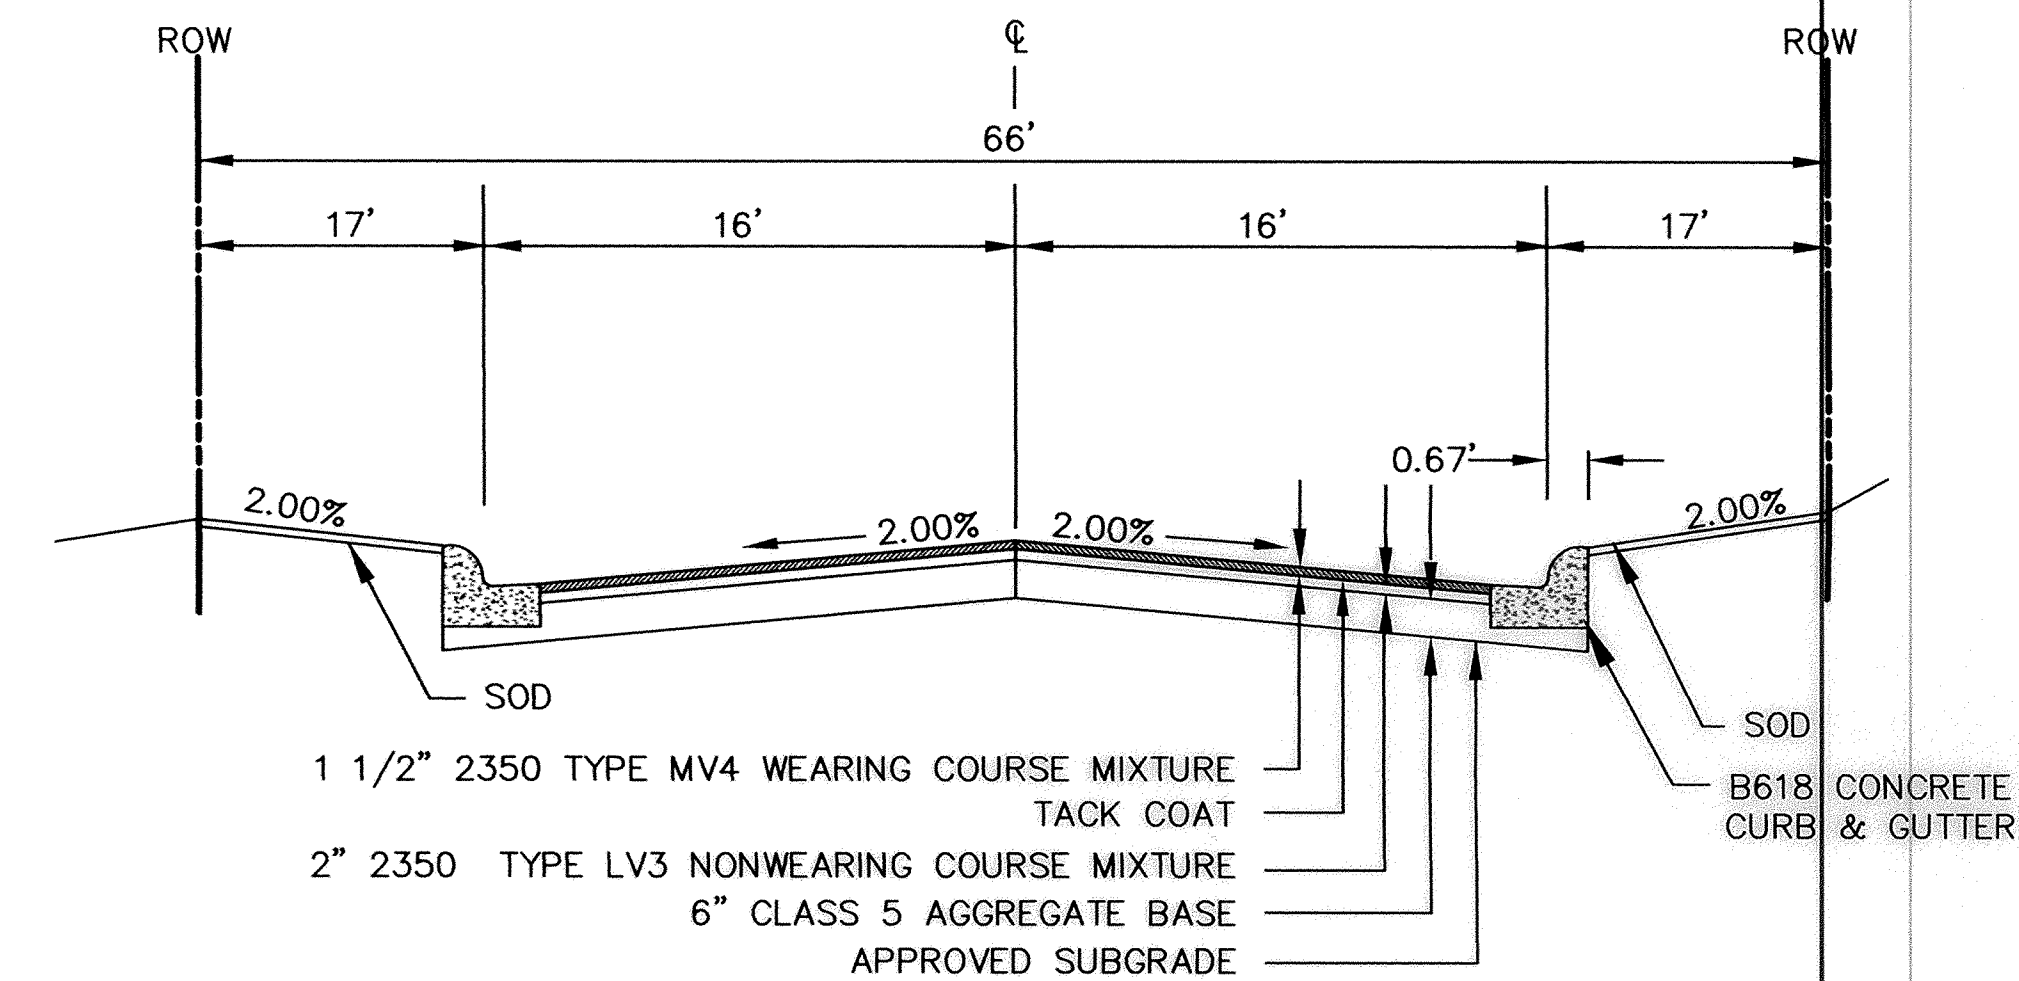


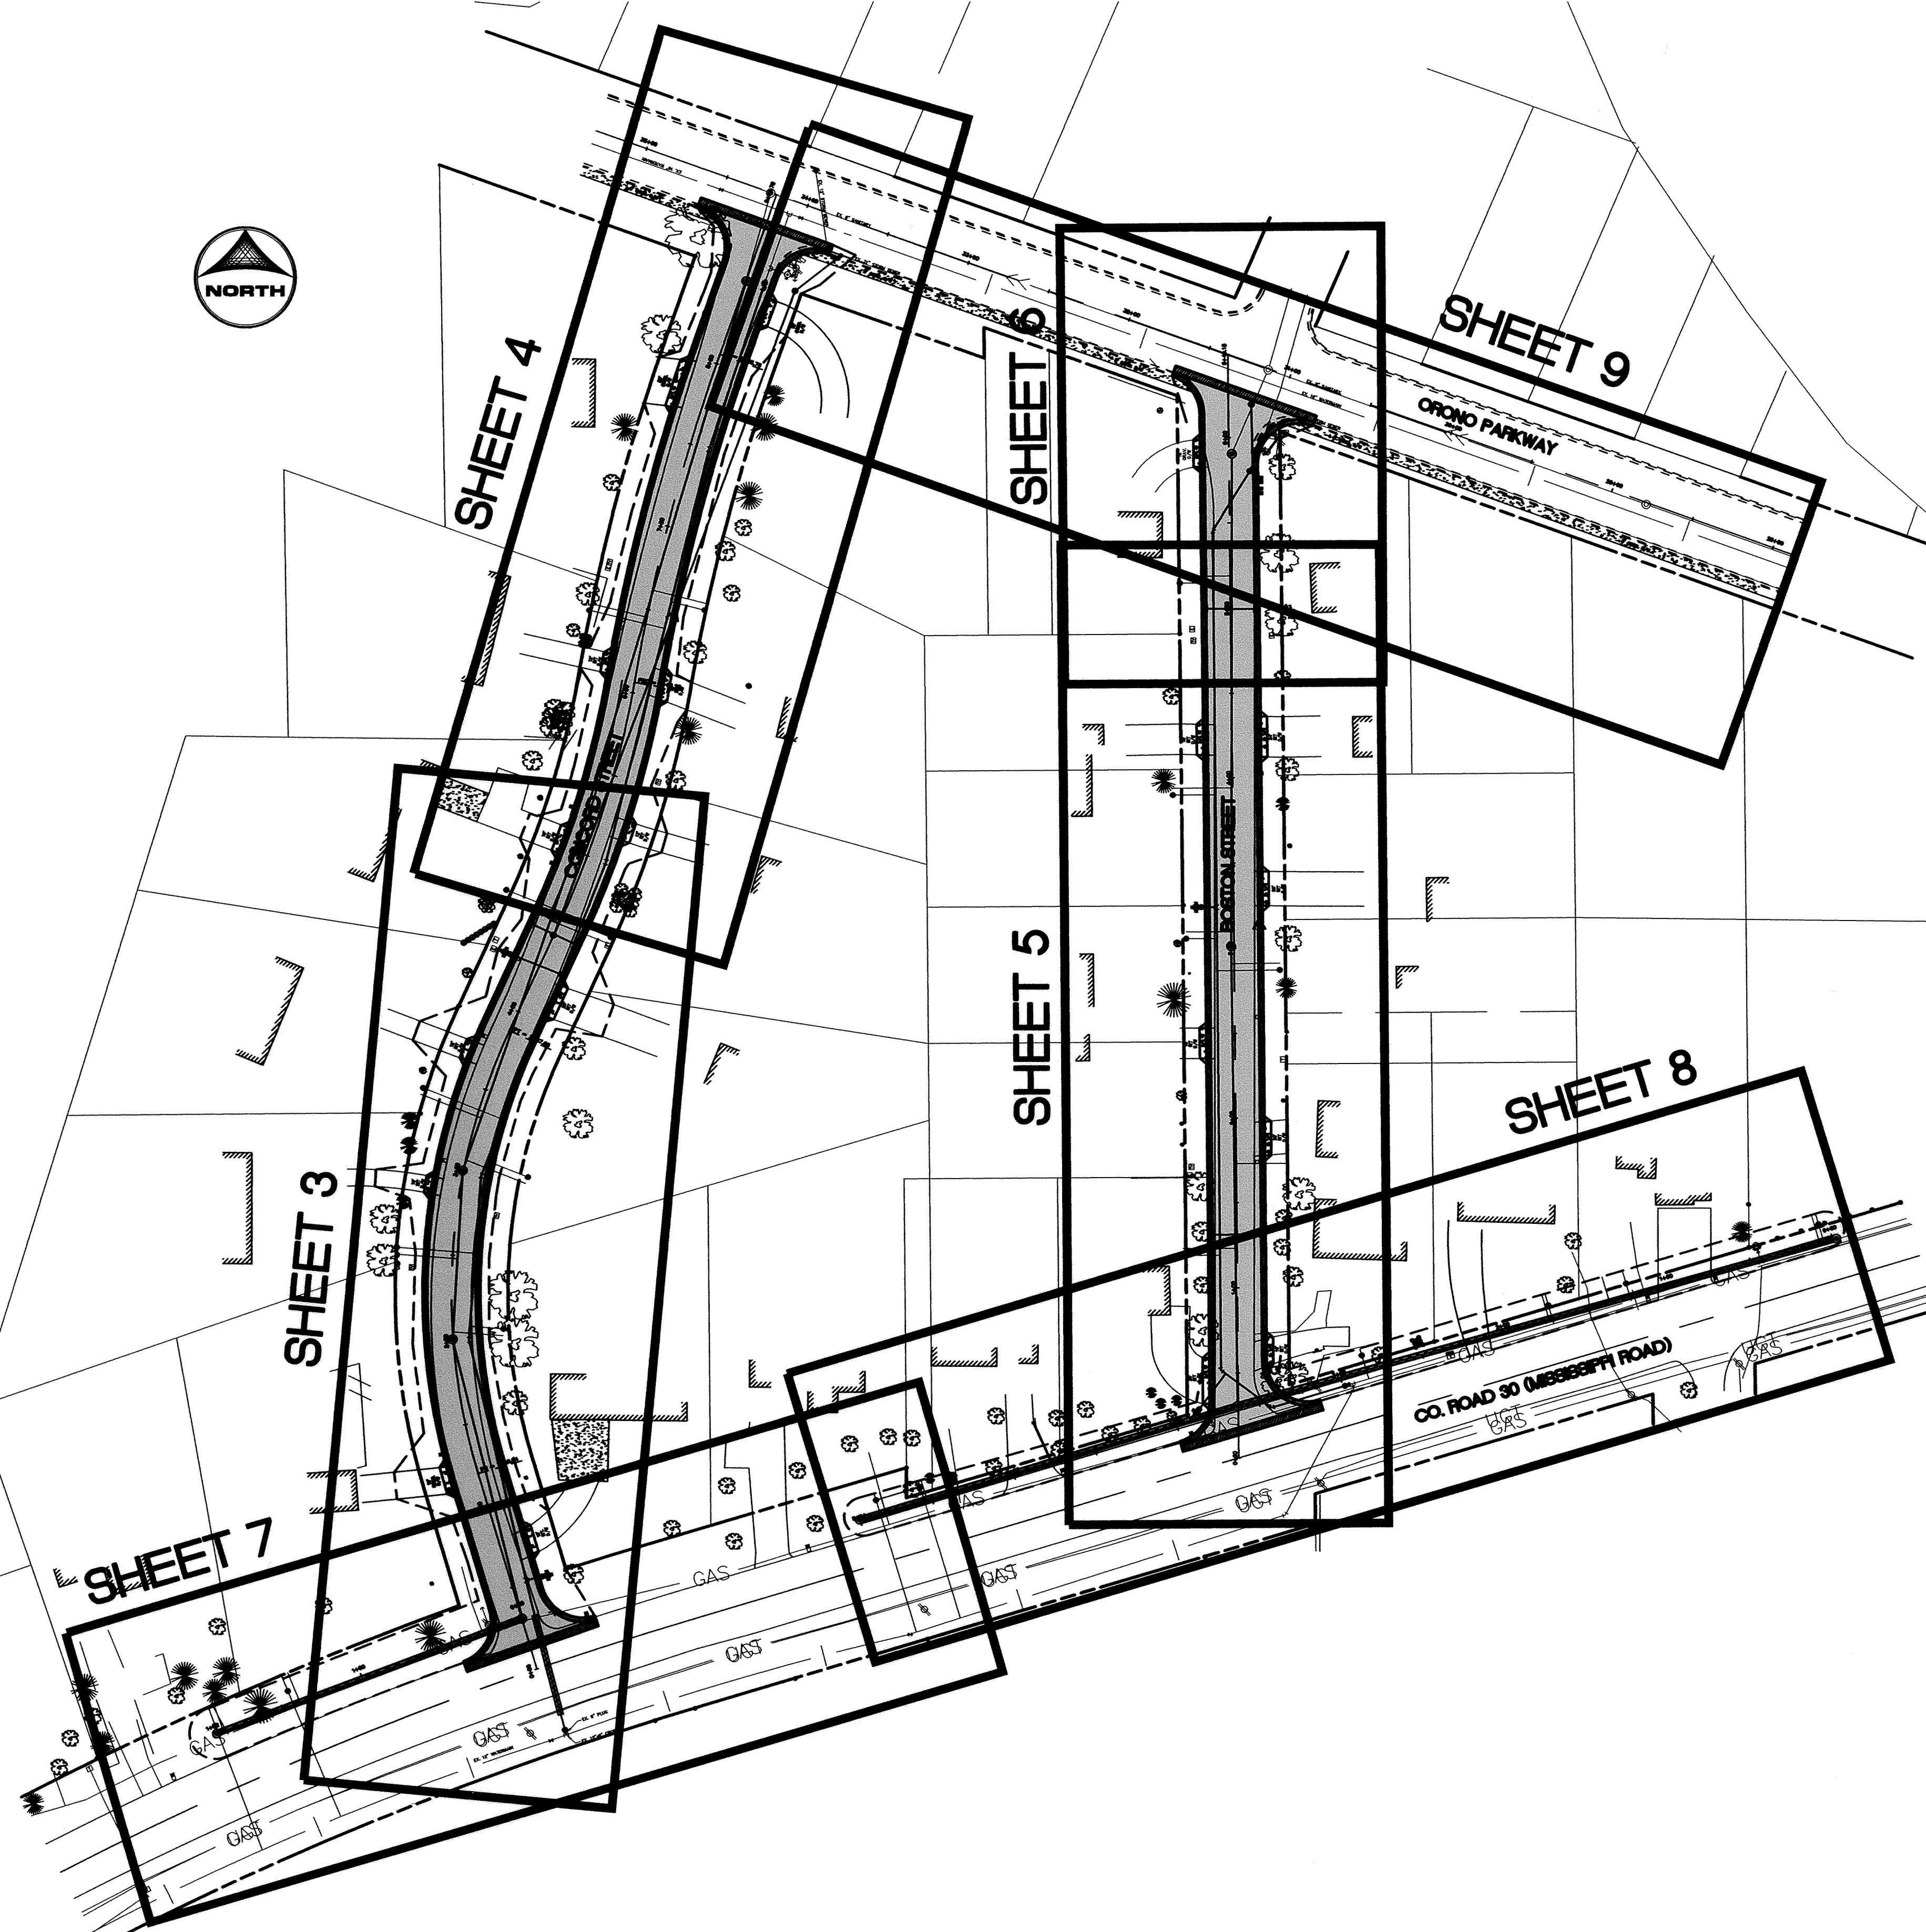

TYPICAL STREET SECTION ON CONCORD STREET

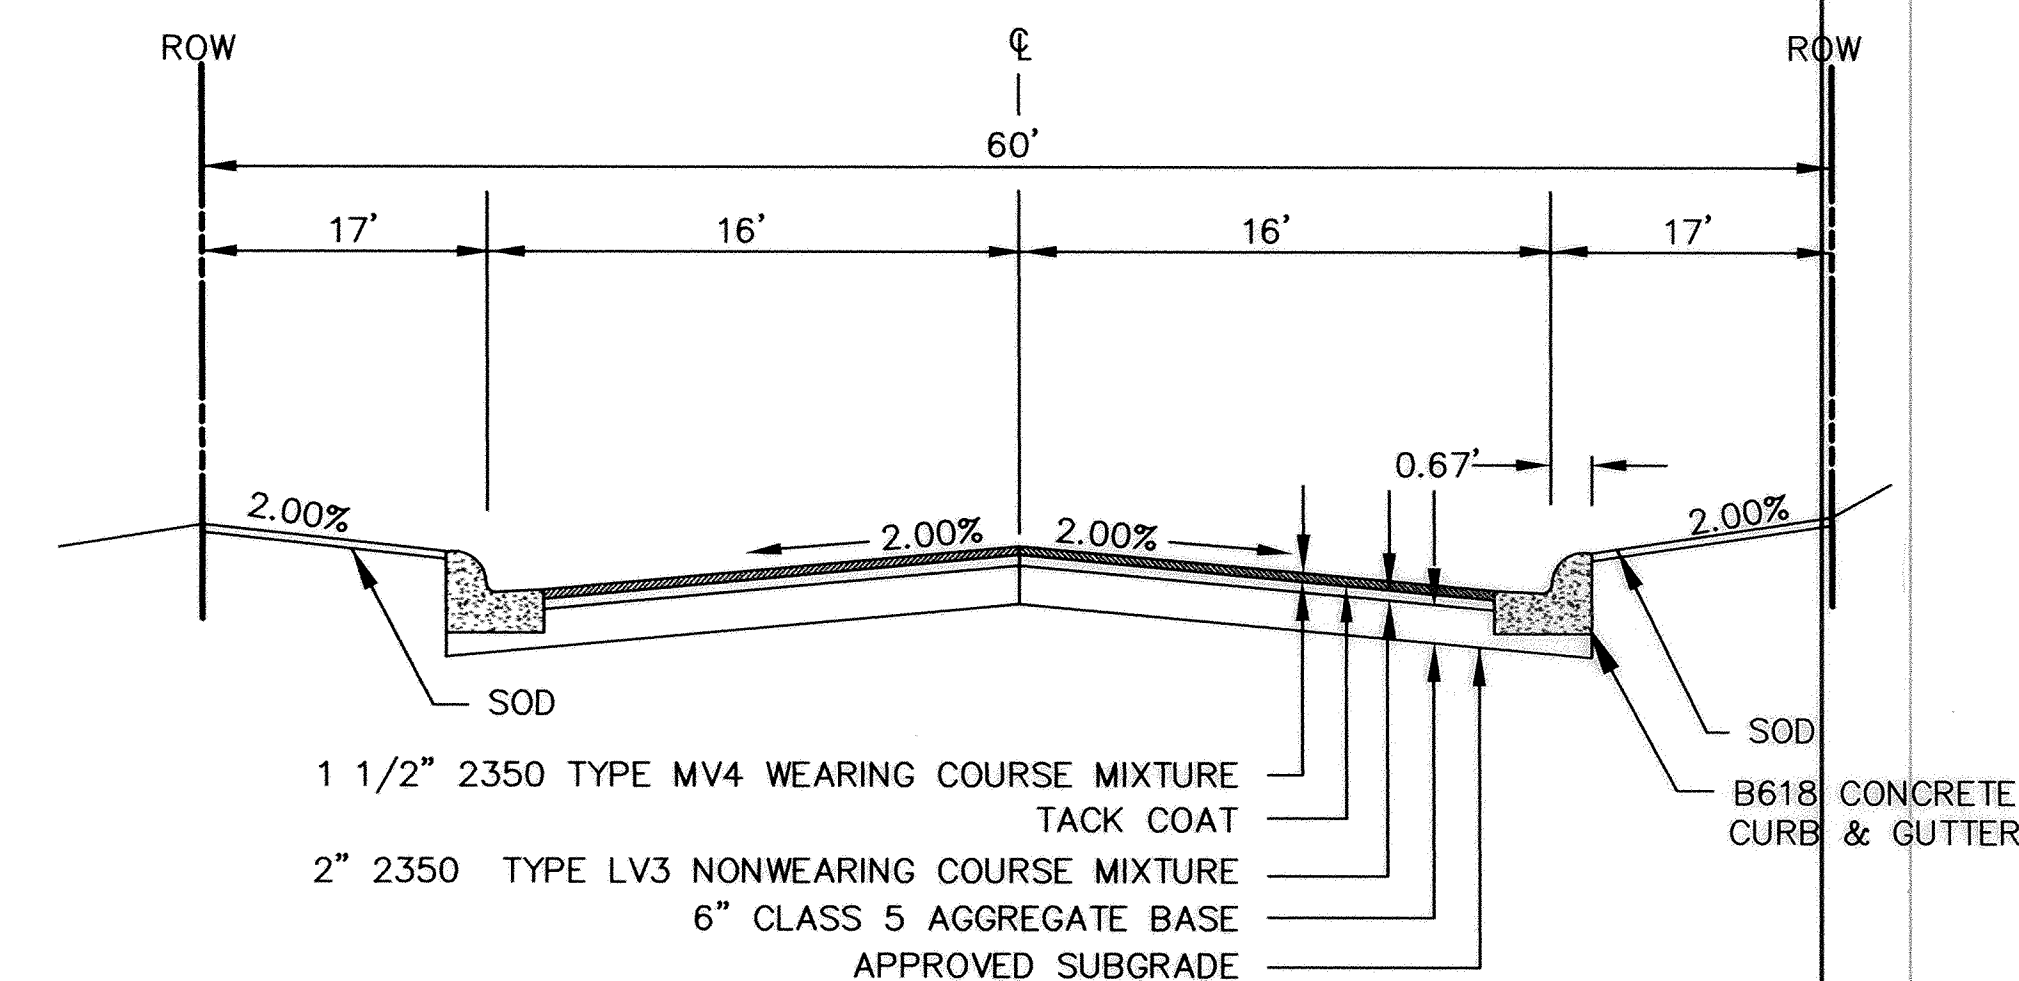


TYPICAL STREET SECTION ON BOSTON STREET

RECORD PLAN
APRIL 2004

DESIGNED BY: DESIGNED BY: DRAWN BY: RKM
APPROVED BY: APPROVED BY: JOB NUMBER 818980J
CAD DATE: January 15, 2004 3:46:38 p.m.
CAD FILE: 818860J\As-Built\C\818860J-TYP.DWG (RMONUEA)

I HEREBY CERTIFY THAT THIS PLAN, SPECIFICATION, OR REPORT
WAS PREPARED BY ME OR UNDER MY DIRECT SUPERVISION AND
THAT I AM A DULY LICENSED PROFESSIONAL ENGINEER UNDER
THE LAWS OF THE STATE OF MINNESOTA.
SIGNATURE: Kristina Thompson DATE: _____
PRINTED NAME: KRISTINA THOMPSON LIC. NO. 42350

NO.	DATE	BY	REVISION DESCRIPTION

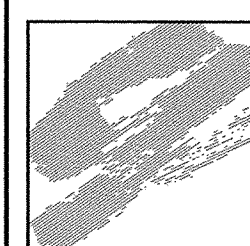

Howard R. Green Company

1326 ENERGY PARK DRIVE
ST. PAUL, MINNESOTA 55108
(651) 644-4389

CONCORD/BOSTON STREET IMPROVEMENTS
CITY OF ELK RIVER

TYPICAL SECTION AND LOCATION

SHEET NO.

2