


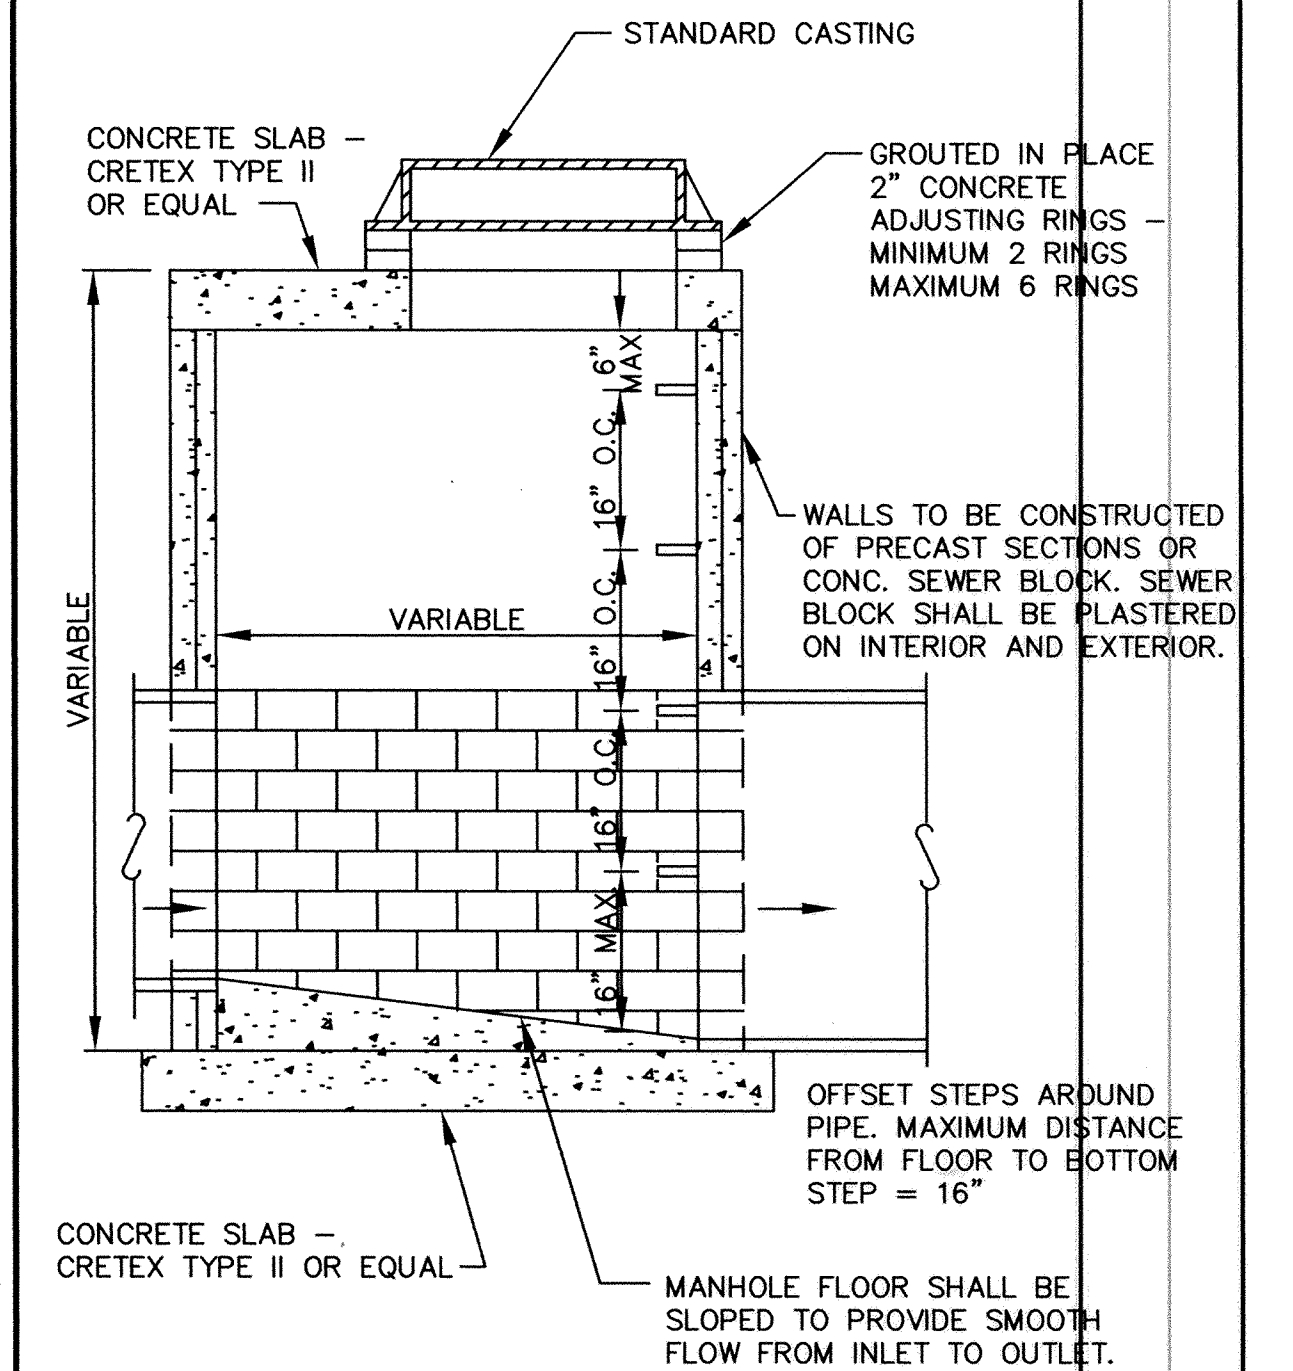
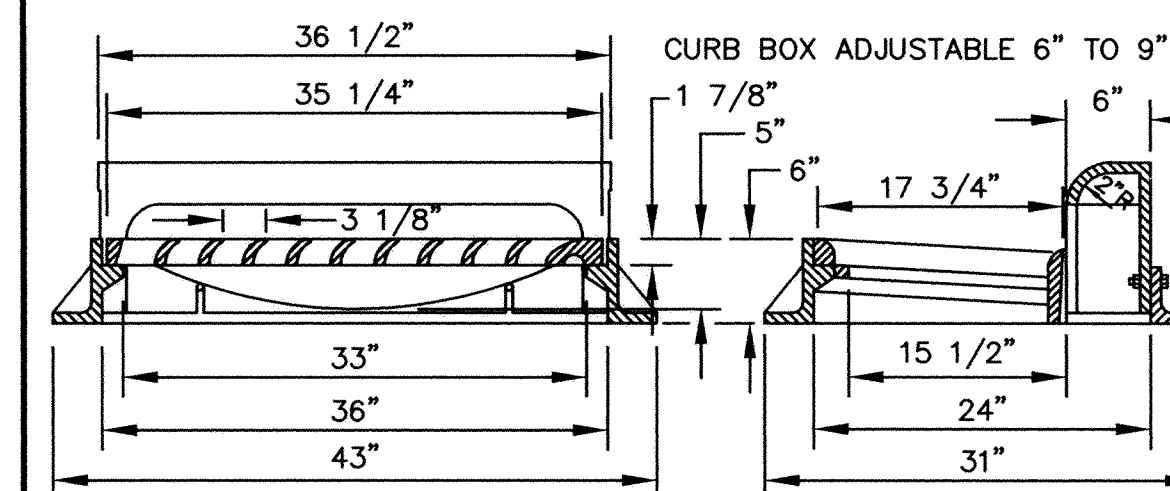
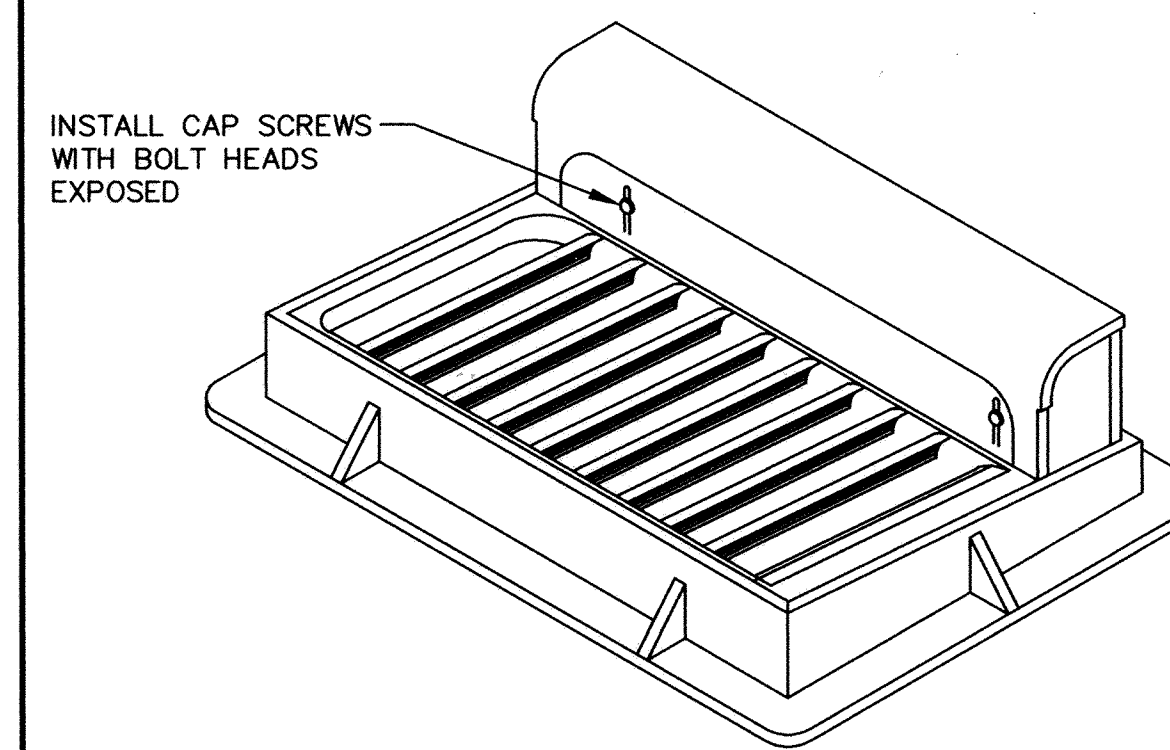
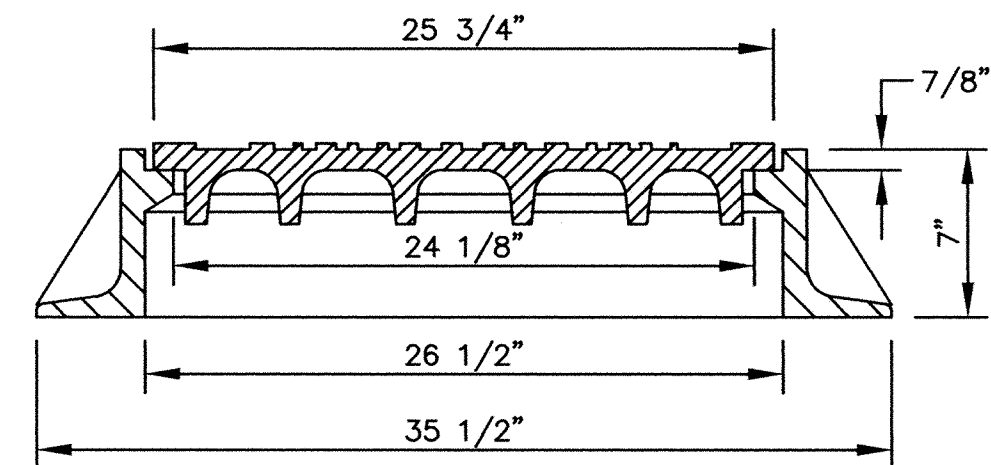
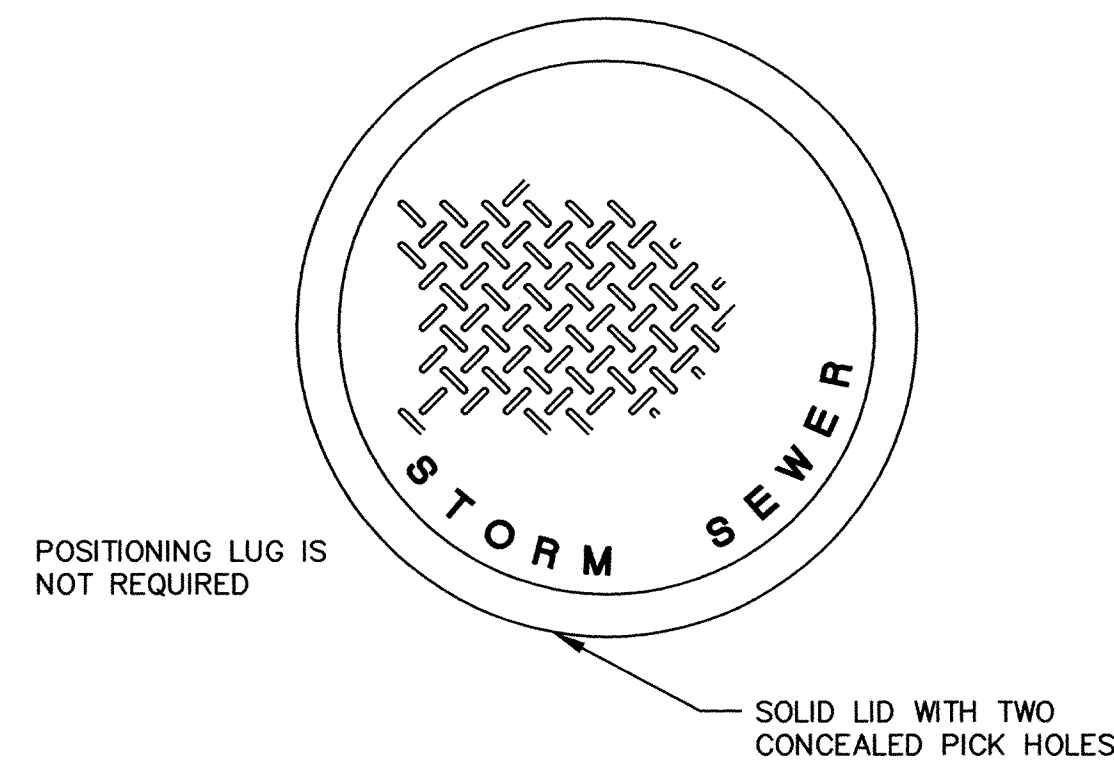


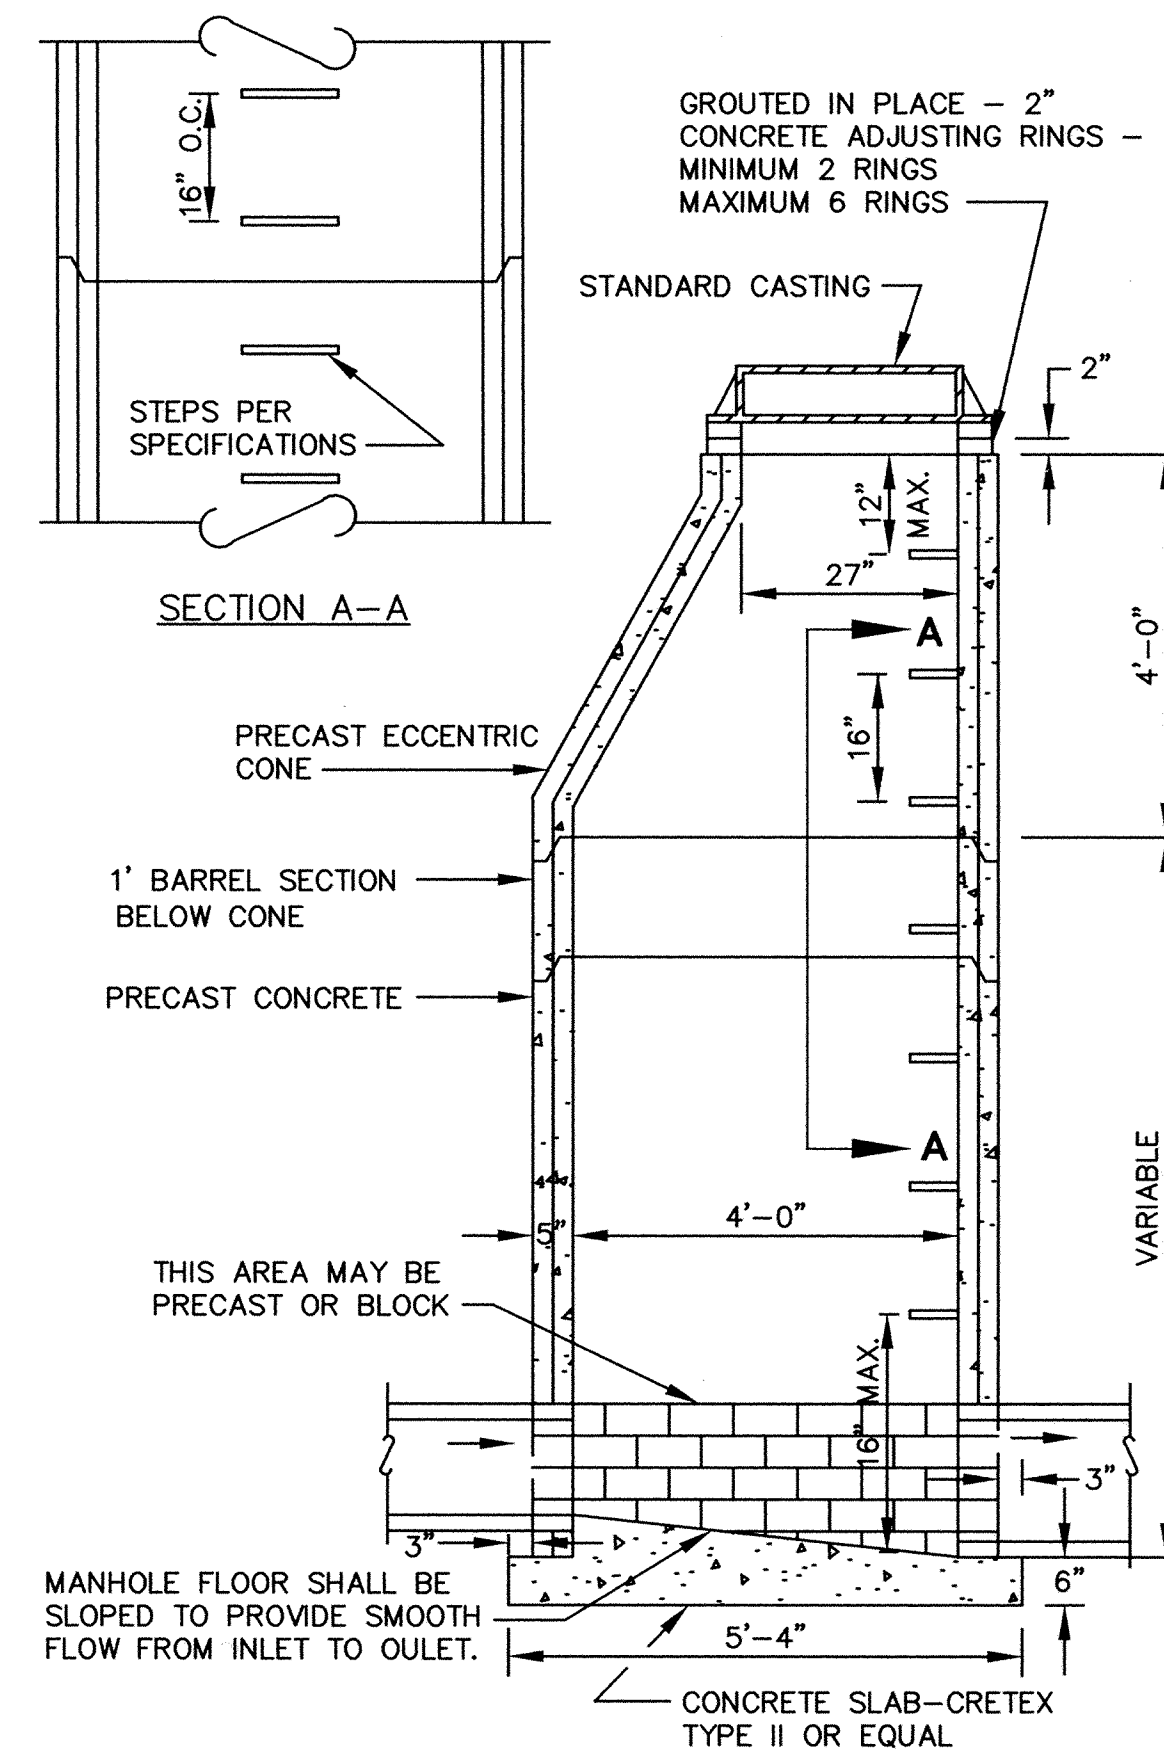

STANDARD MANHOLE CASTING

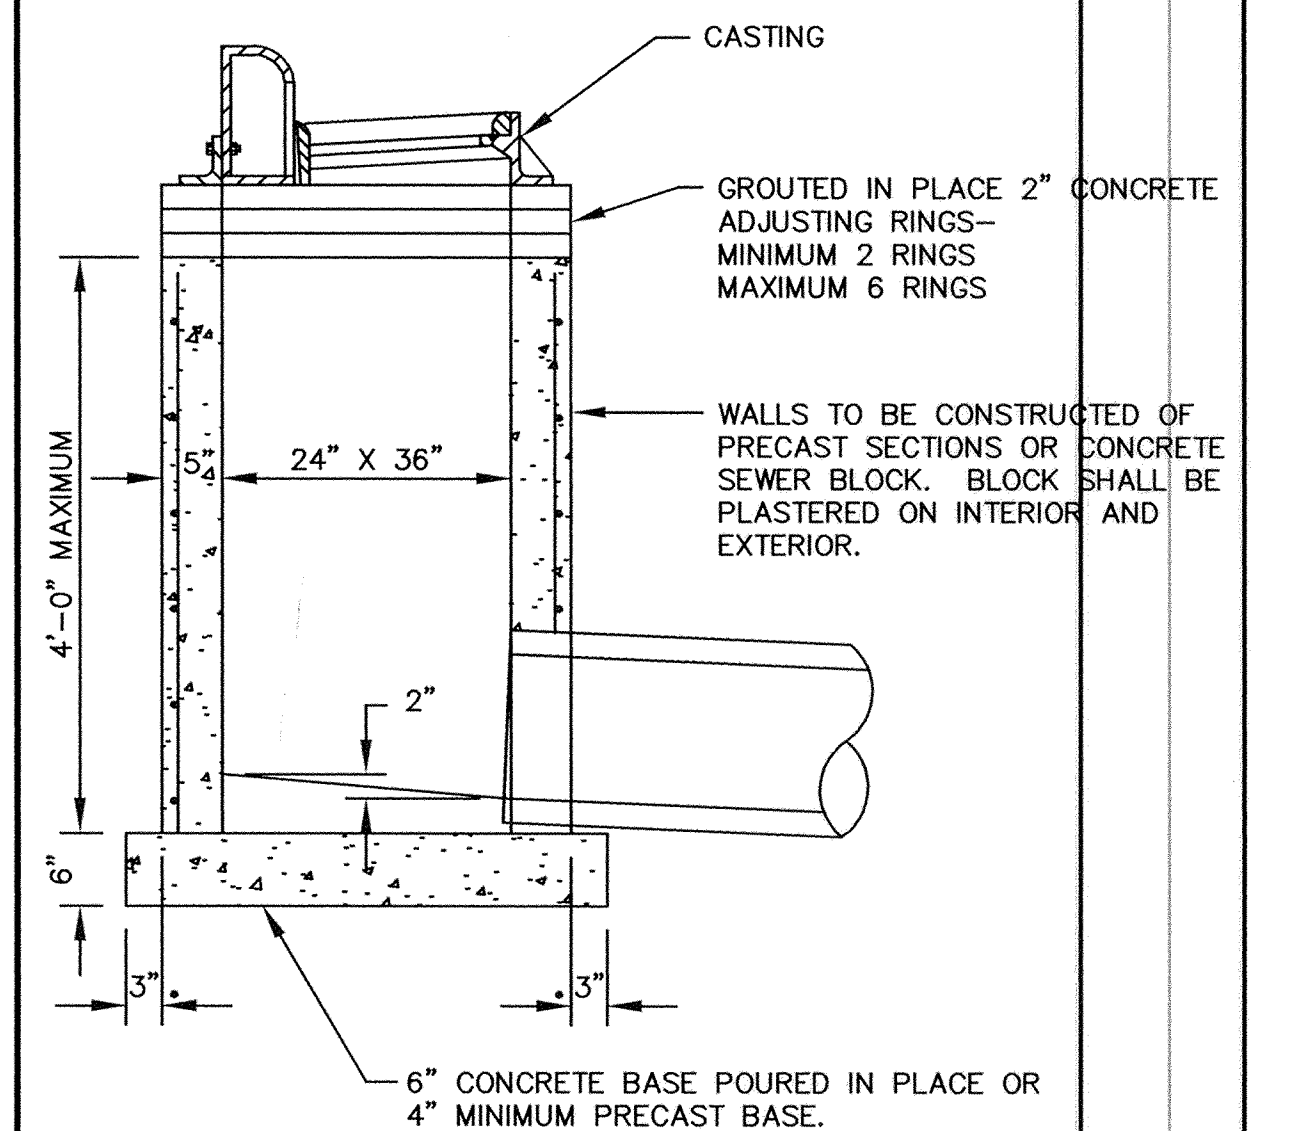


STANDARD INLET CASTING

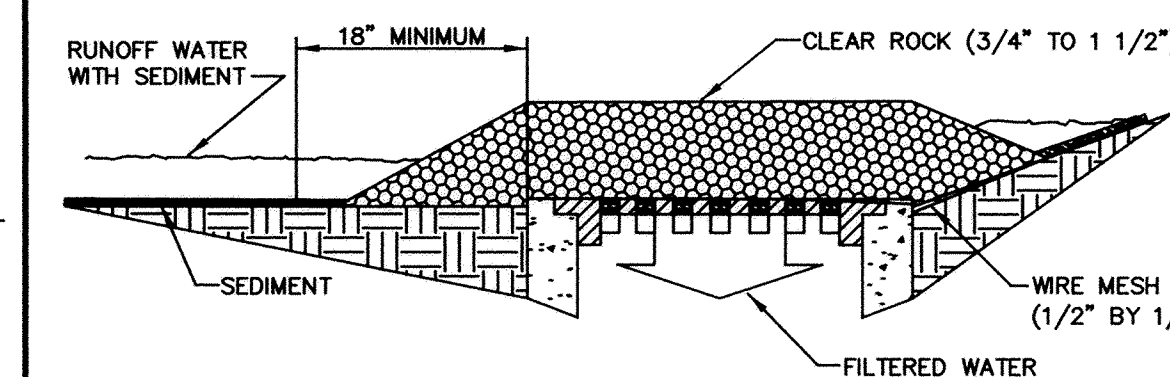


RECORD PLAN
APRIL 2004

SHALLOW CATCH BASIN

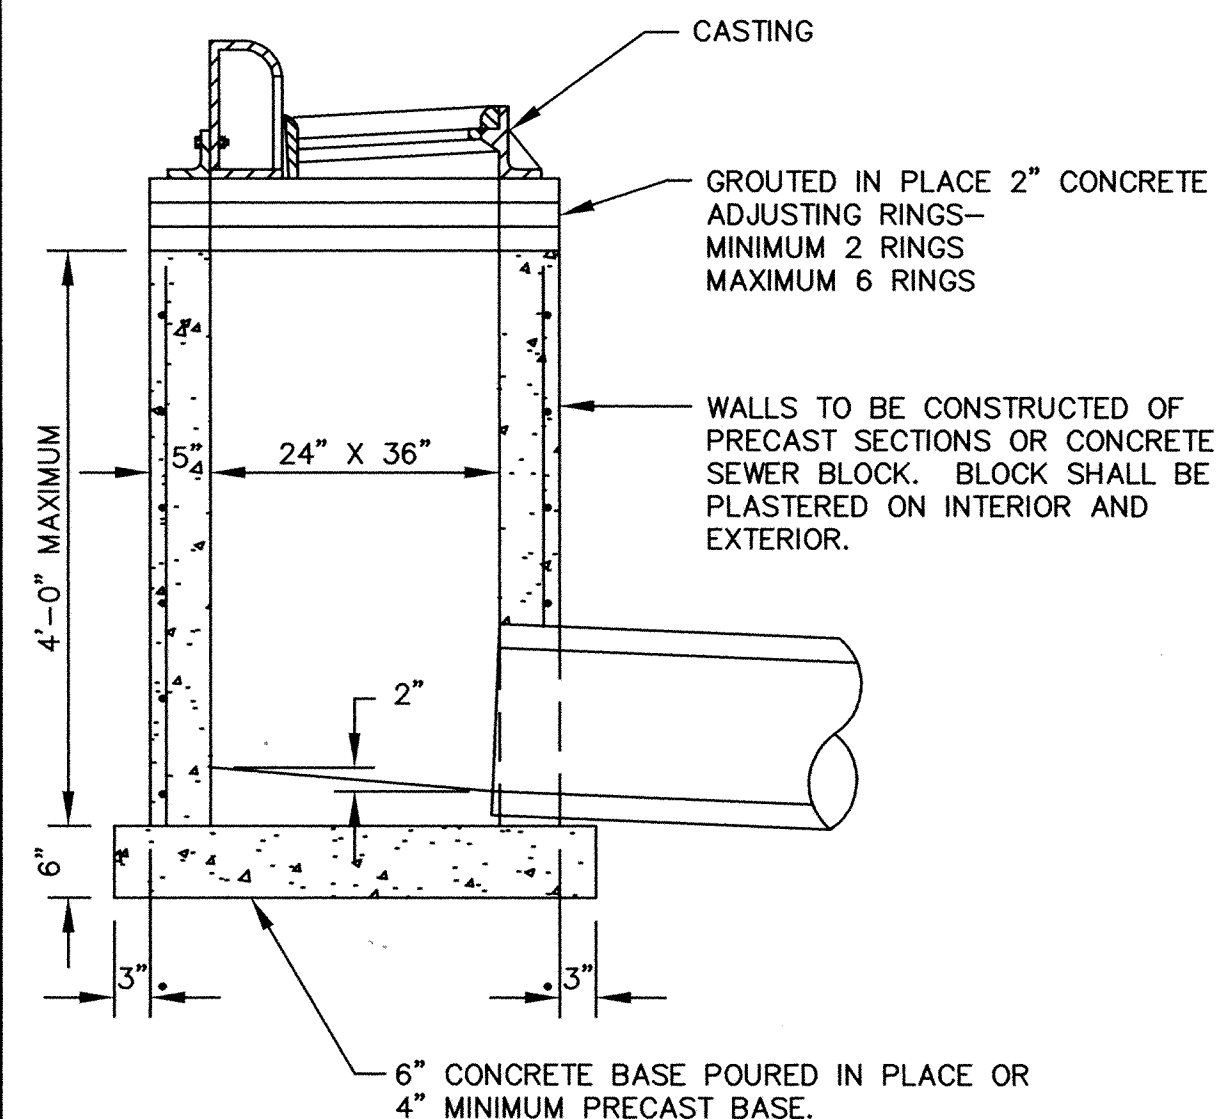


STANDARD MANHOLE

CATCH BASIN SEDIMENT BARRIER

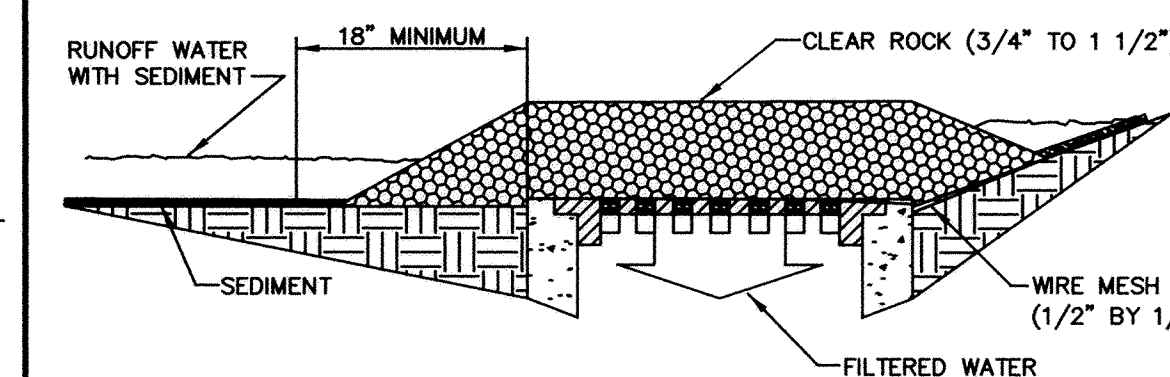


SHALLOW CATCH BASIN

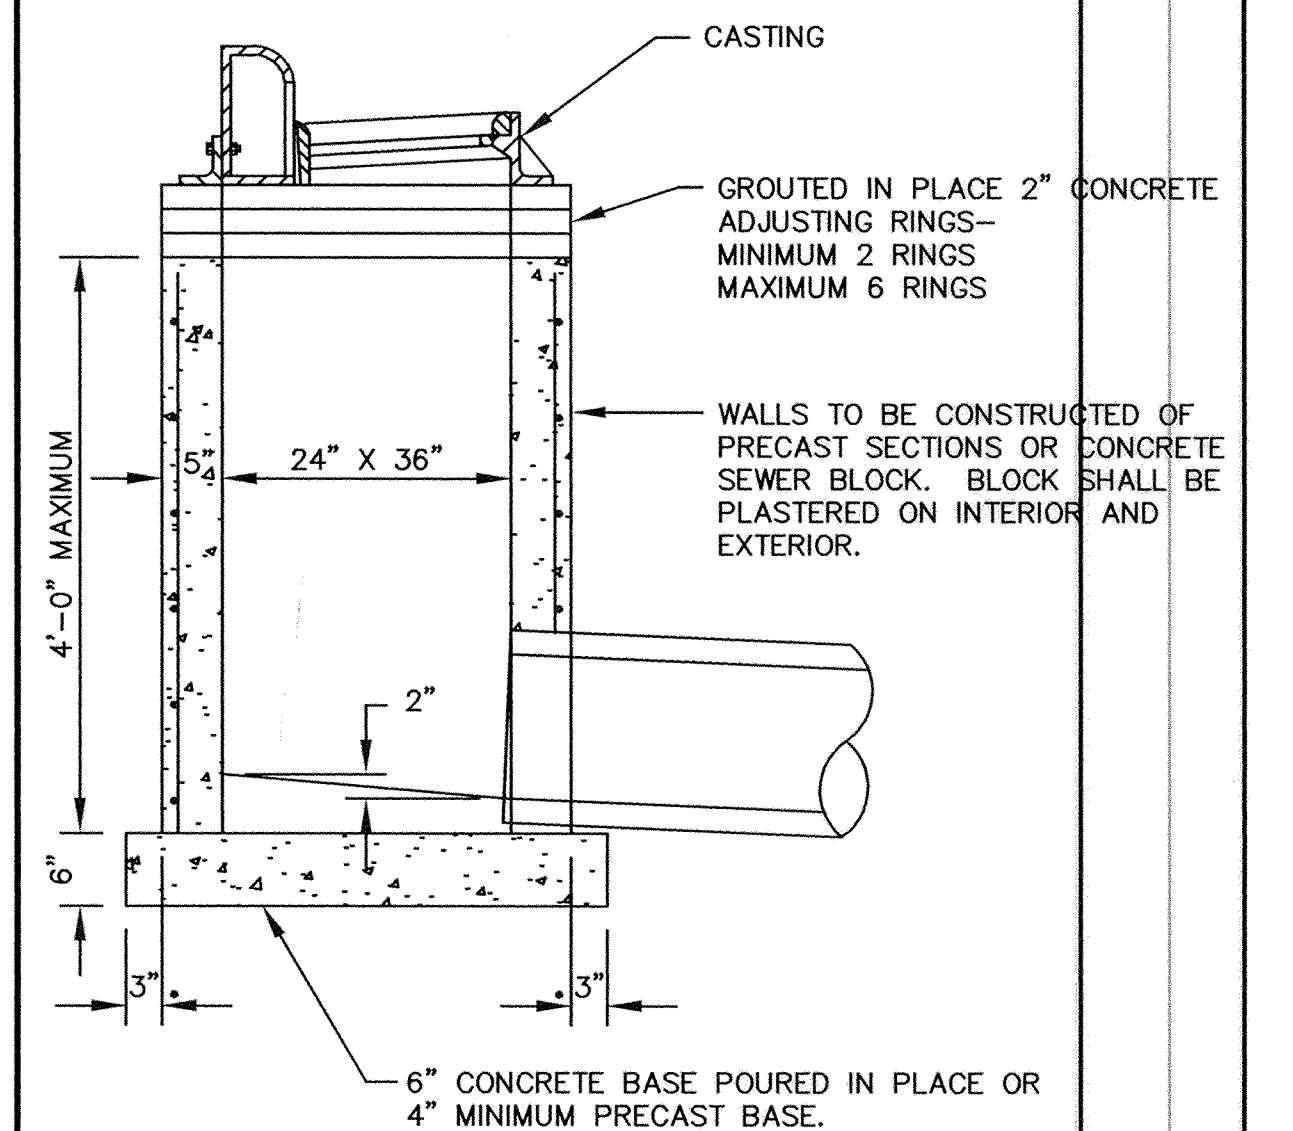

DESIGNED BY: DESIGNED BY DRAWN BY: RKM
APPROVED BY: APPROVED BY JOB NUMBER 818980J
CAD DATE: April 14, 2003 9:05:44 a.m.
CAD FILE: 818860J\dwg\C\818860J-D4.DWG (RMONJE

I HEREBY CERTIFY THAT THIS PLAN, SPECIFICATION, OR REPORT
WAS PREPARED BY ME OR UNDER MY DIRECT SUPERVISION AND
THAT I AM A DULY LICENSED PROFESSIONAL ENGINEER UNDER
THE LAWS OF THE STATE OF MINNESOTA.

NO.	DATE	BY	REVISION DESCRIPTION

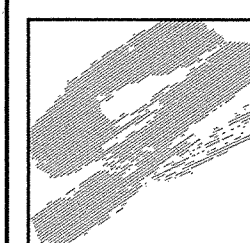

1326 ENERGY PARK DRIVE
ST. PAUL, MINNESOTA 55108
(651) 644-4389

Howard R. Green Company

CONCORD/BOSTON IMPROVEMENTS
CITY OF ELK RIVER

STORM SEWER DETAILS

SHEET NO.

21