
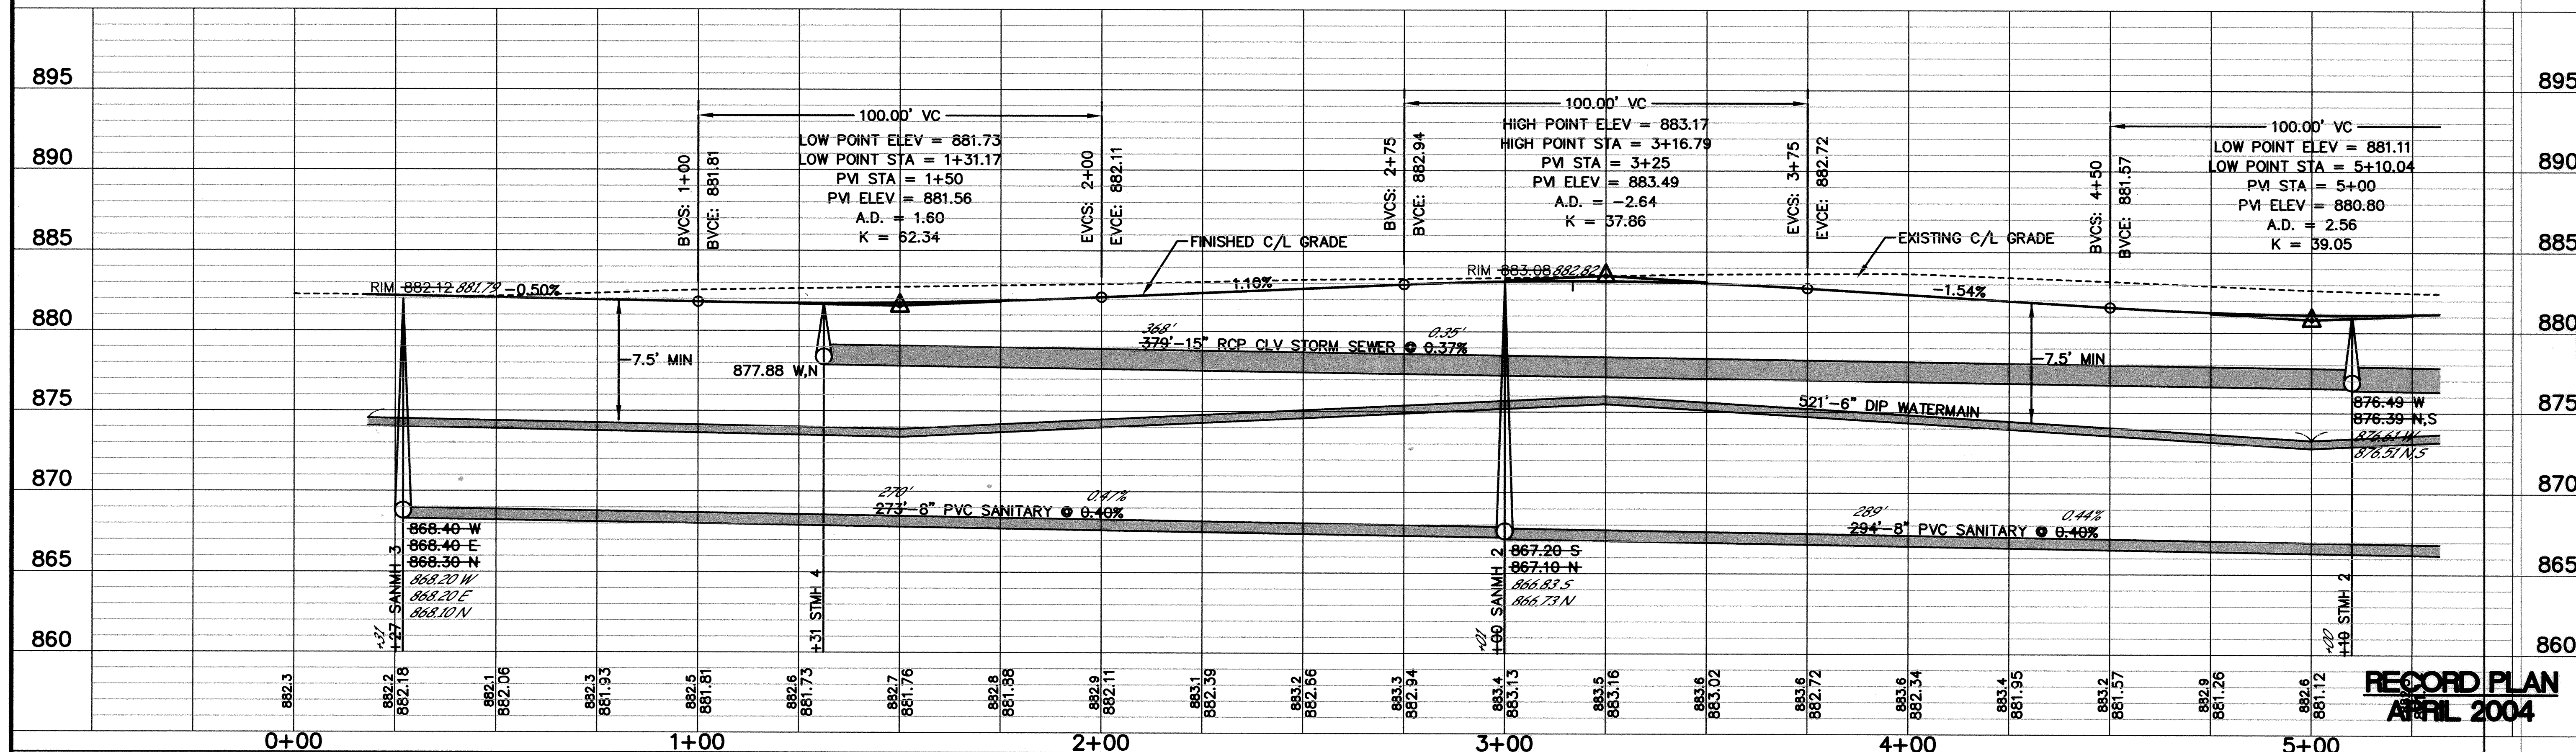
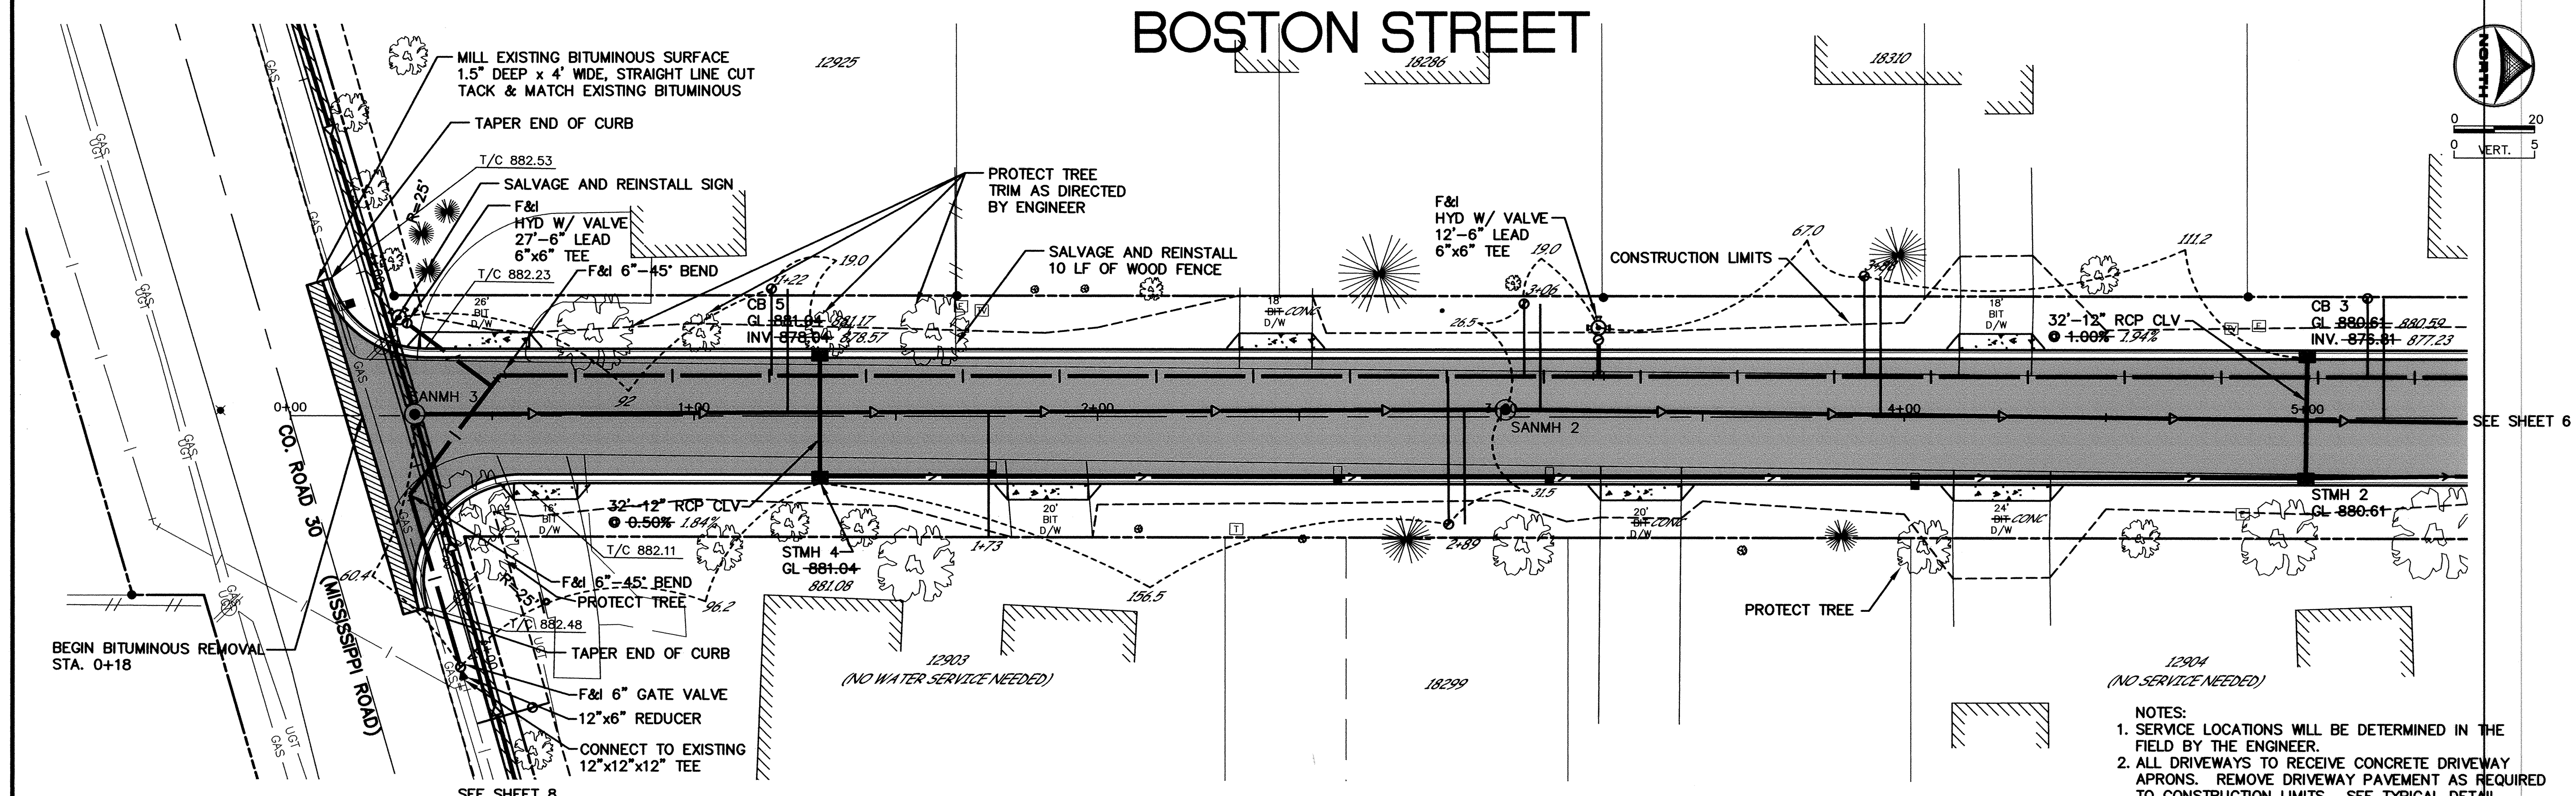


BOSTON STREET

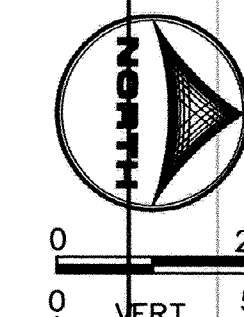

RECORD PLAN
APRIL 2004

DESIGNED BY: DESIGNED BY: DRAWN BY: RKM
 APPROVED BY: APPROVED BY: JOB NUMBER 818860J
 CAD DATE: March 30, 2004 10:35:07 a.m.
 CAD FILE: 818860J\As-Built\CT-D03.DWG (RMONJEA)

I HEREBY CERTIFY THAT THIS PLAN, SPECIFICATION, OR REPORT WAS PREPARED BY ME OR UNDER MY DIRECT SUPERVISION AND THAT I AM A DULY LICENSED PROFESSIONAL ENGINEER UNDER THE LAWS OF THE STATE OF MINNESOTA.
 SIGNATURE: *Kristina Thompson* DATE: _____
 PRINTED NAME: KRISTINA THOMPSON LIC. NO.: 423350

NO.	DATE	BY	REVISION DESCRIPTION

1326 ENERGY PARK DRIVE
 ST. PAUL, MINNESOTA 55108
 (651) 644-4389
Howard R. Green Company

CONCORD/BOSTON STREET IMPROVEMENTS
 CITY OF ELK RIVER

PLAN AND PROFILE
BOSTON STREET
 0+00 TO 5+00

SHEET NO.
5