




SACD PRODUCTS • NEW HOPKINS, MINNESOTA
DESIGNED BY: PART NUMBER 8502
REVISIONS: 01/15/04
SACD PRODUCTS • NEW HOPKINS, MINNESOTA
DESIGNED BY: PART NUMBER 8502
REVISIONS: 01/15/04
SACD PRODUCTS • NEW HOPKINS, MINNESOTA
DESIGNED BY: PART NUMBER 8502
REVISIONS: 01/15/04

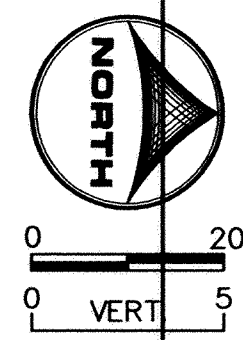

BOSTON STREET

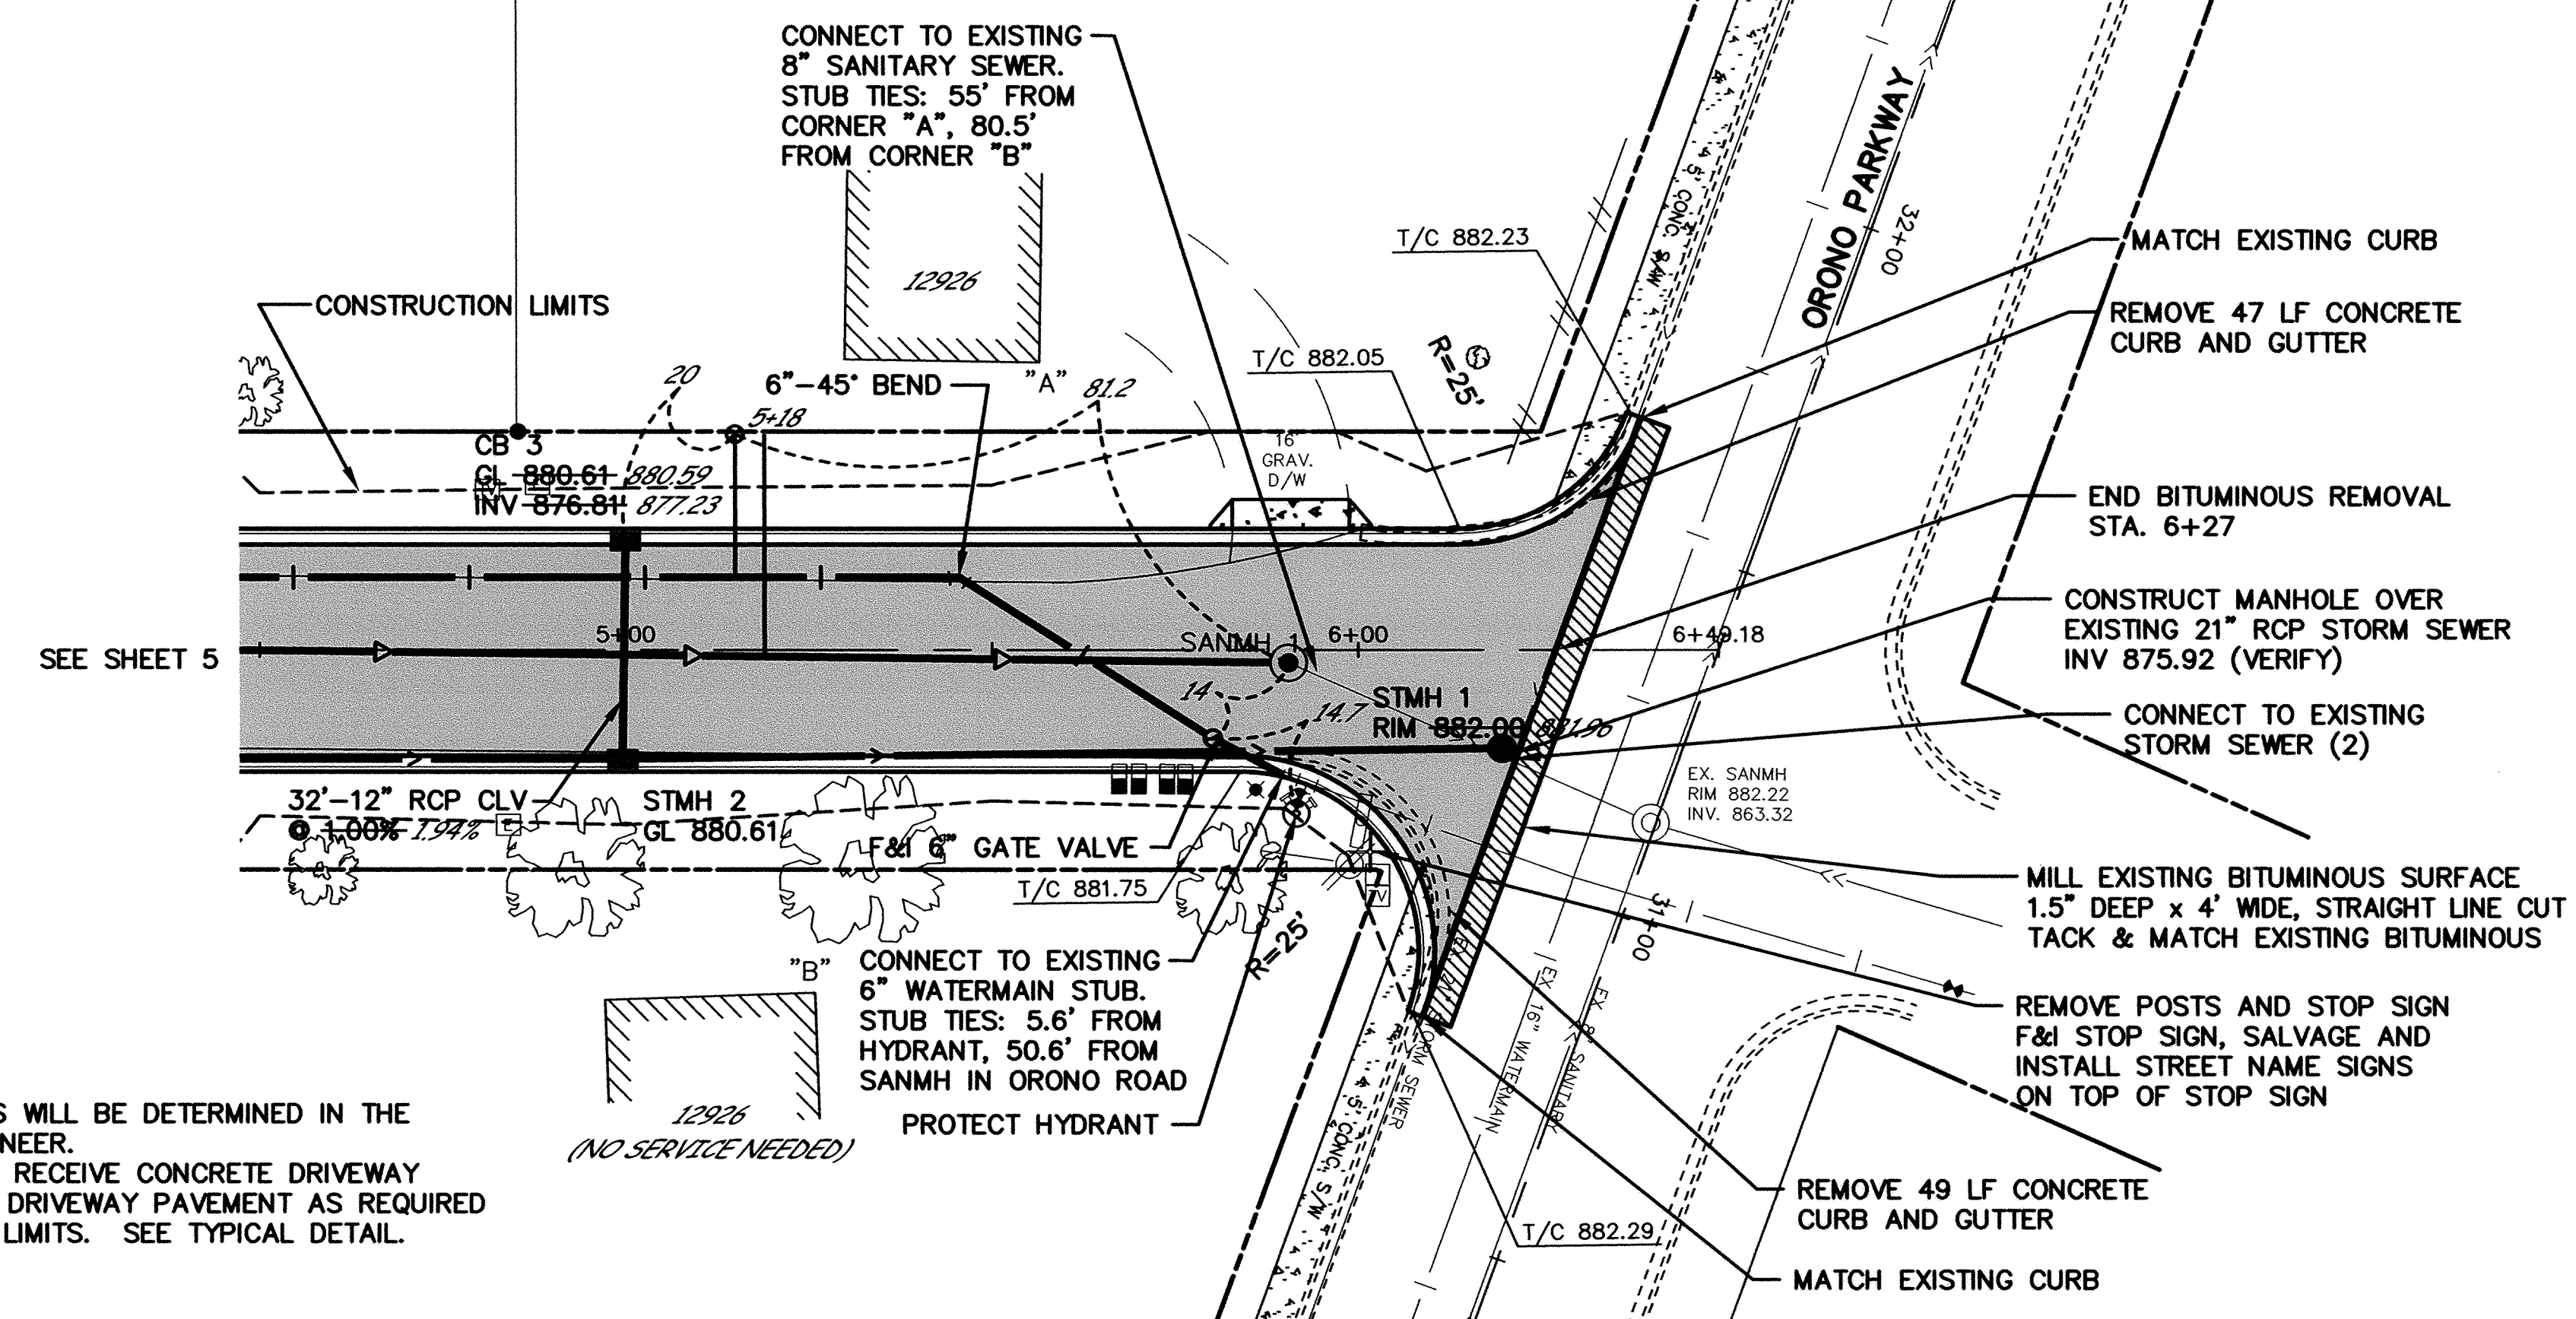

- NOTES:
1. SERVICE LOCATIONS WILL BE DETERMINED IN THE FIELD BY THE ENGINEER.
 2. ALL DRIVEWAYS TO RECEIVE CONCRETE DRIVEWAY APRONS. REMOVE DRIVEWAY PAVEMENT AS REQUIRED TO CONSTRUCTION LIMITS. SEE TYPICAL DETAIL.

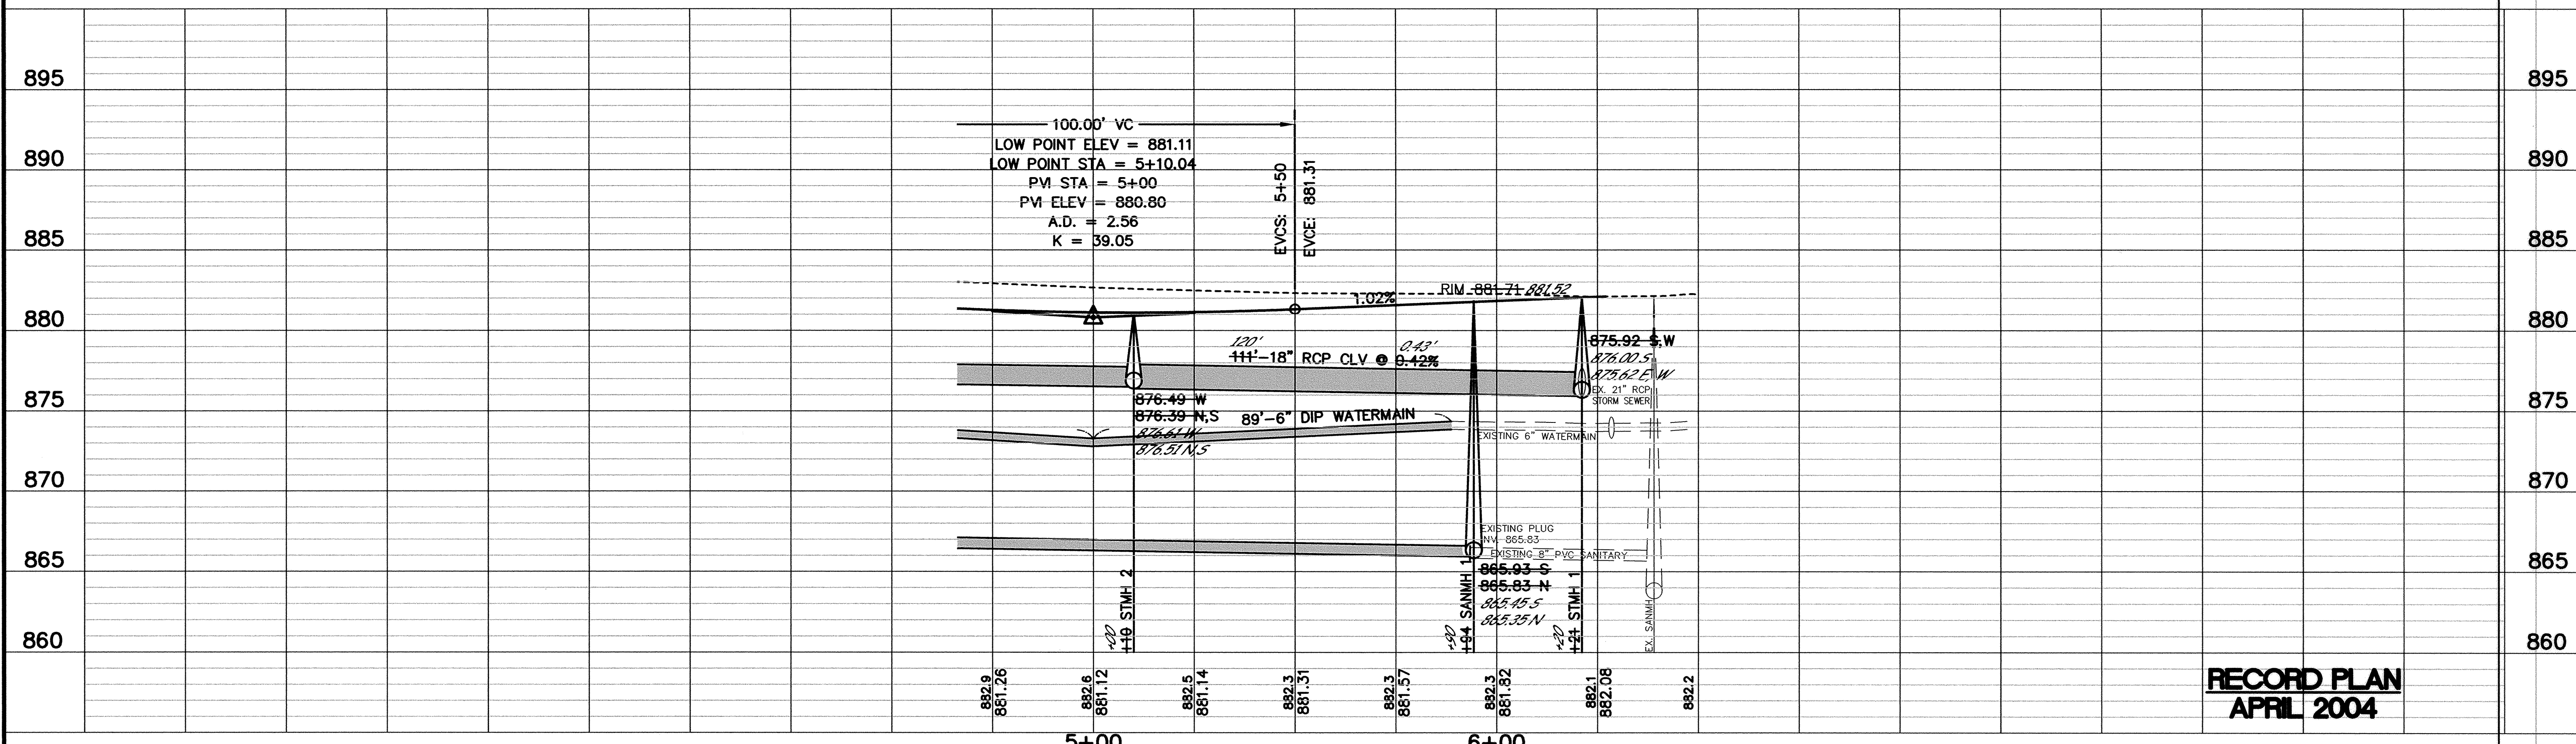

RECORD PLAN
APRIL 2004

Xref: X02-BASE.DWG		I HEREBY CERTIFY THAT THIS PLAN, SPECIFICATION, OR REPORT WAS PREPARED BY ME OR UNDER MY DIRECT SUPERVISION AND THAT I AM A DULY LICENSED PROFESSIONAL ENGINEER UNDER THE LAWS OF THE STATE OF MINNESOTA.		NO. DATE BY REVISION DESCRIPTION			1326 ENERGY PARK DRIVE ST. PAUL, MINNESOTA 55108 (651) 644-4389	CONCORD/BOSTON STREET IMPROVEMENTS CITY OF ELK RIVER	PLAN AND PROFILE BOSTON STREET 5+00 TO 6+49.18	SHEET NO. 6
DESIGNED BY: DESIGNED BY	DRAWN BY: RKM	SIGNATURE: <i>Kristina Thompson</i> DATE: _____								
APPROVED BY: APPROVED BY		PRINTED NAME: KRISTINA THOMPSON LIC. NO. 42350								
JOB NUMBER 818860J										
CAD DATE: January 15, 2004 1:47:18 p.m.										
CAD FILE: 818860J\As-Built\CT-D04.DWG (RMONJEAN)										