



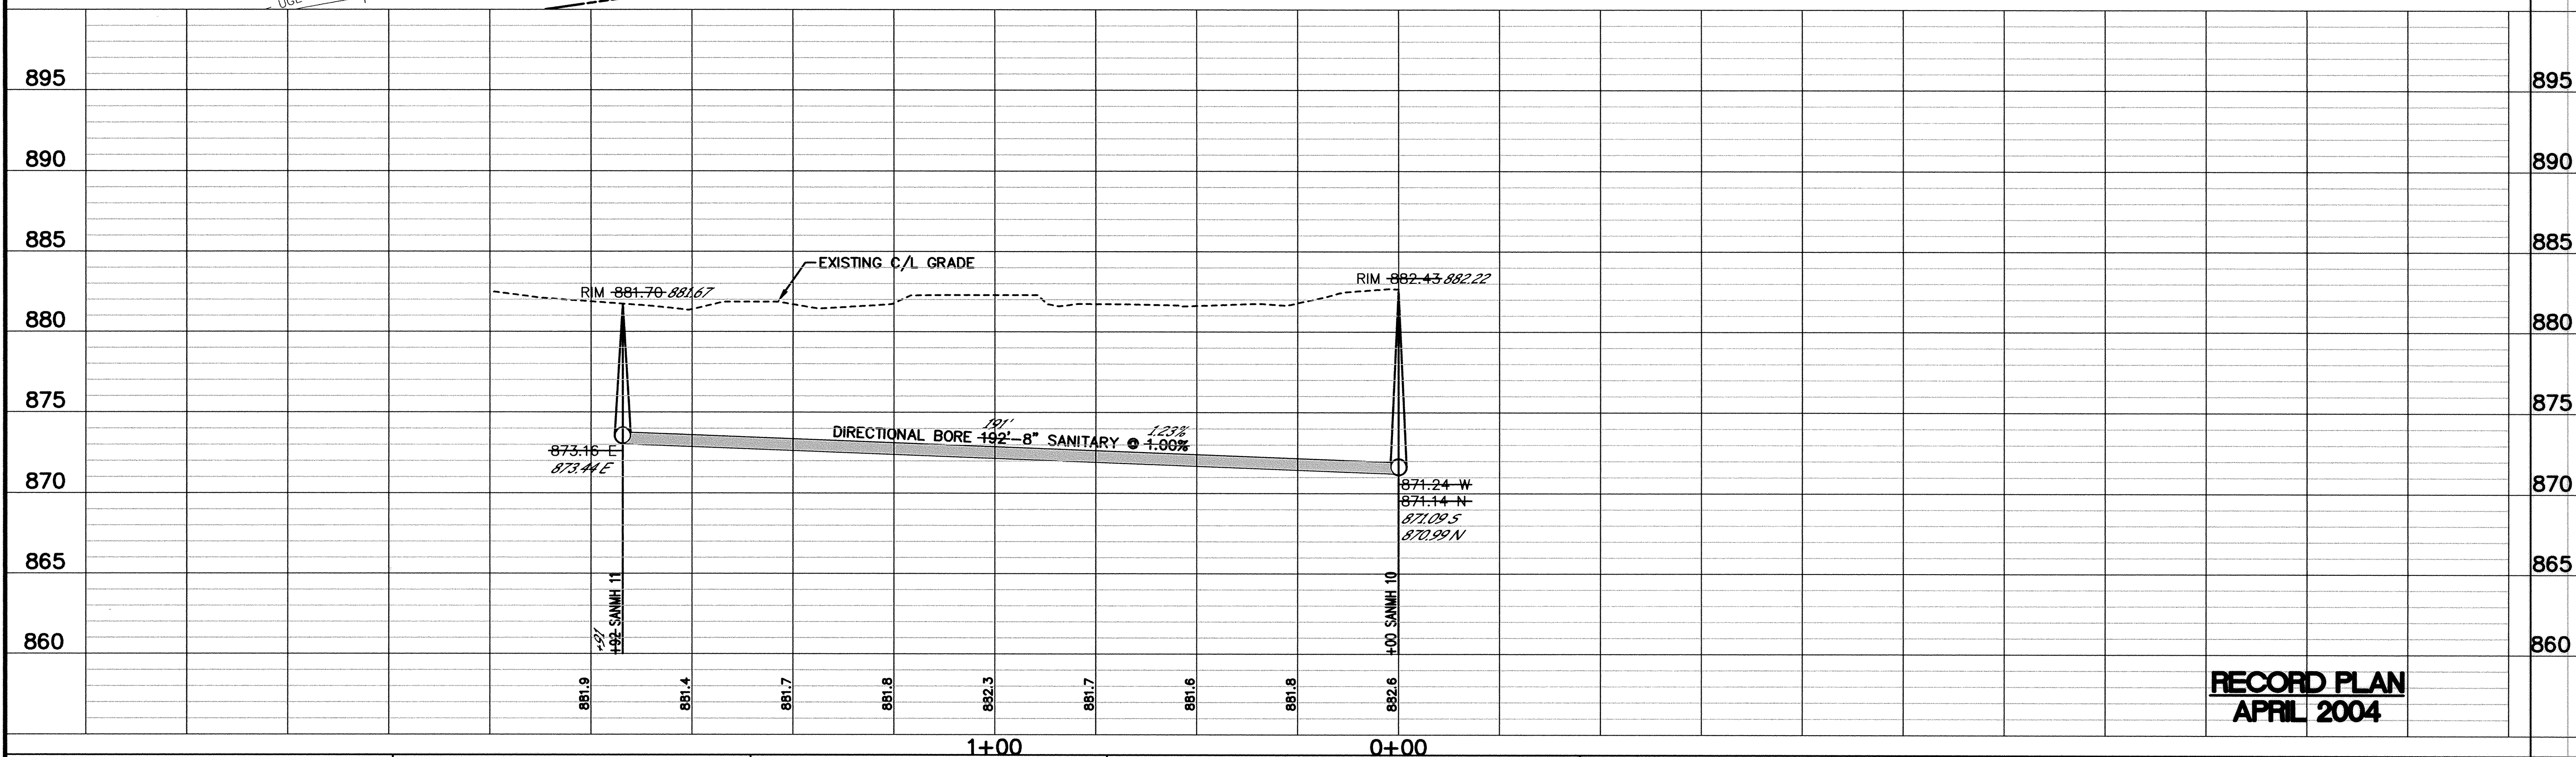

0 20
0 VERT. 5

MISSISSIPPI ROAD (CSAH 30)

- NOTES:
1. SERVICE LOCATIONS WILL BE DETERMINED IN THE FIELD BY THE ENGINEER.
 2. ALL DRIVEWAYS TO RECEIVE CONCRETE DRIVEWAY APRONS. REMOVE DRIVEWAY PAVEMENT AS REQUIRED TO CONSTRUCTION LIMITS. SEE TYPICAL DETAIL.
 3. RESTORATION ALONG MISSISSIPPI ROAD TO CONSIST OF SEEDING, FERTILIZER, MULCH AND DISK ANCHORING.

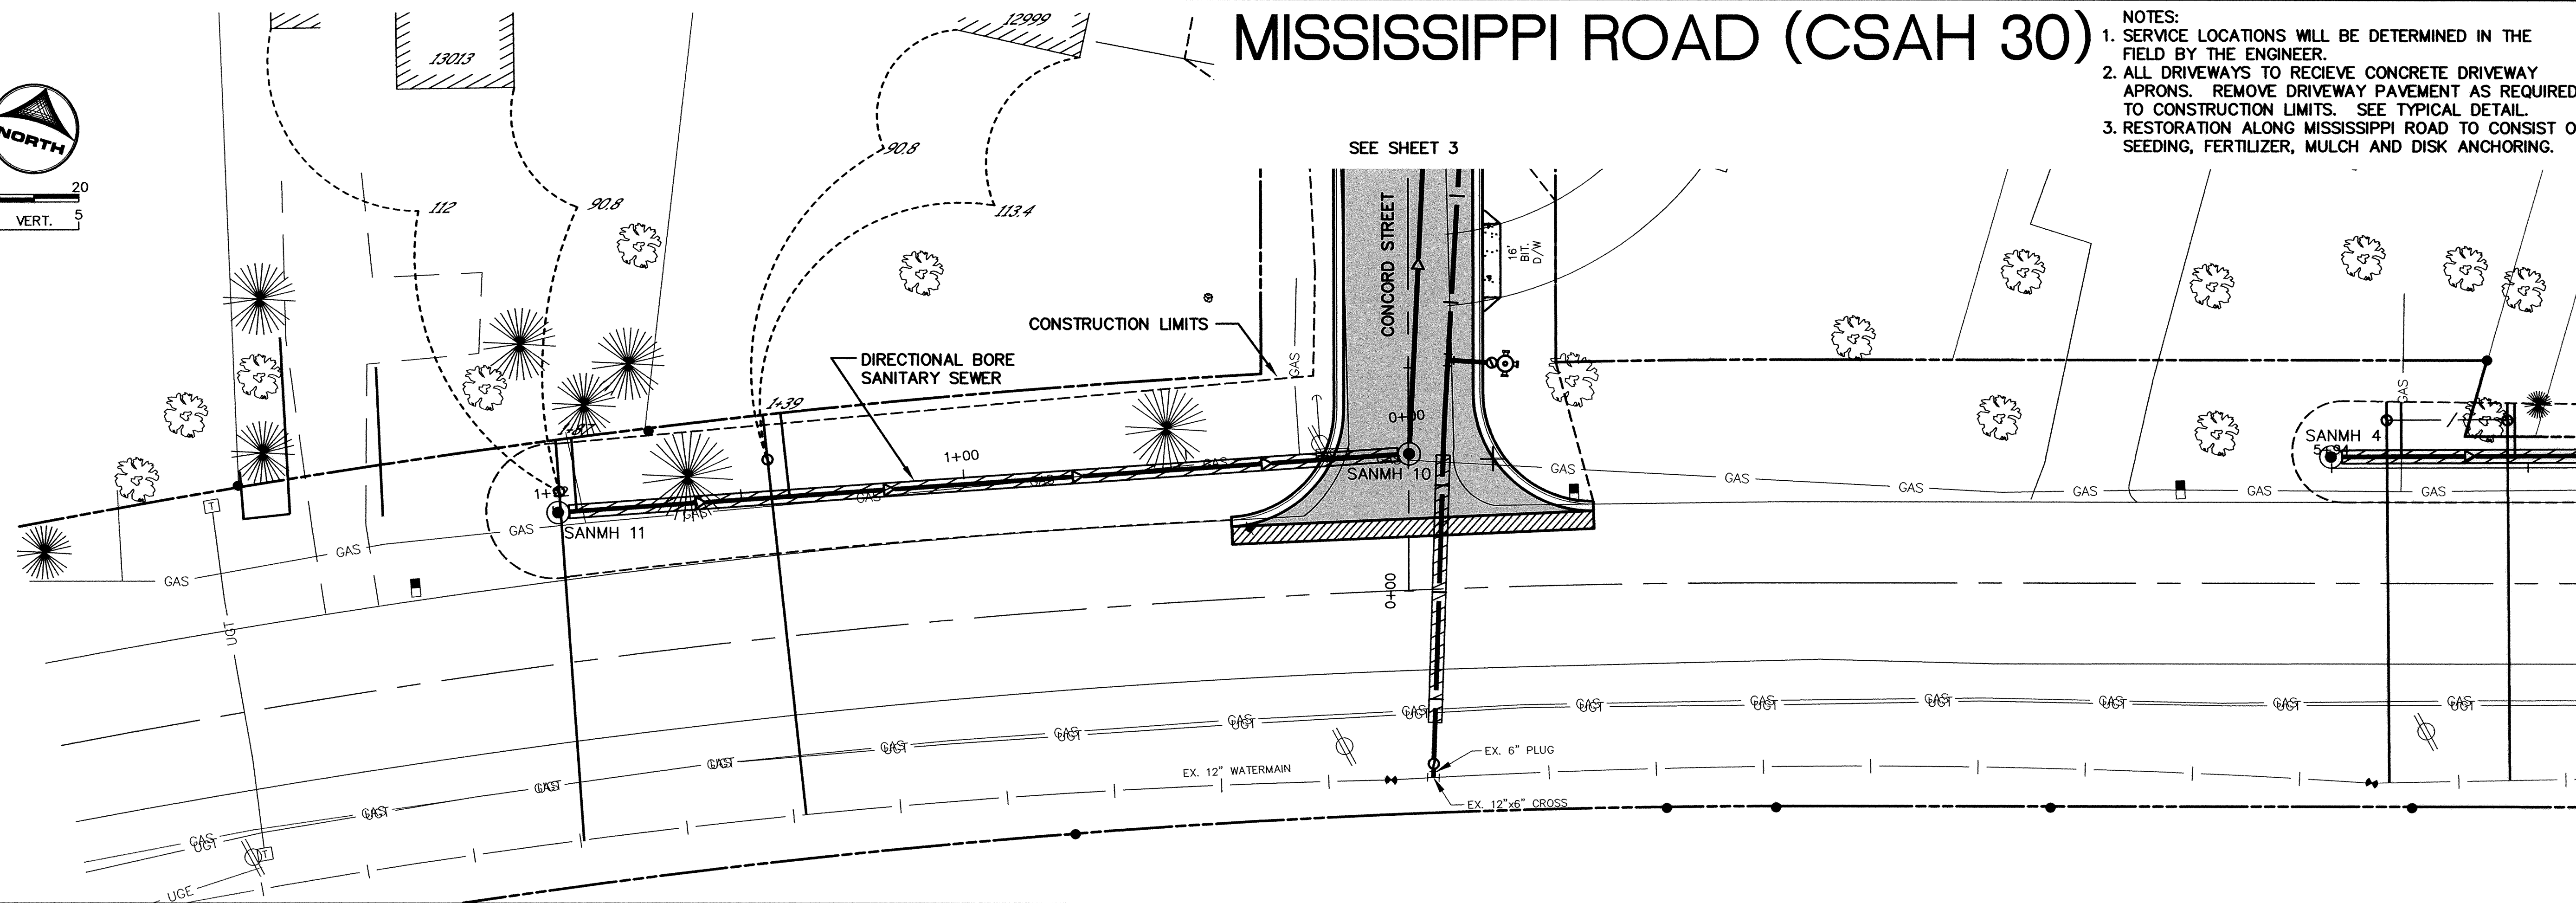

RECORD PLAN
APRIL 2004

DESIGNED BY: DESIGNED BY: RKM APPROVED BY: APPROVED BY: JOB NUMBER 818860J CAD DATE: March 30, 2004 10:45:45 a.m. CAD FILE: 818860J\As-Built\CT-D05.DWG (RMONJEA)		I HEREBY CERTIFY THAT THIS PLAN, SPECIFICATION, OR REPORT WAS PREPARED BY ME OR UNDER MY DIRECT SUPERVISION AND THAT I AM A DULY LICENSED PROFESSIONAL ENGINEER UNDER THE LAWS OF THE STATE OF MINNESOTA. SIGNATURE: <i>Kristina Thompson</i> DATE: _____ PRINTED NAME: KRISTINA THOMPSON LIC. NO. 42350		<table border="1"><thead><tr><th>NO.</th><th>DATE</th><th>BY</th><th>REVISION DESCRIPTION</th></tr></thead><tbody><tr><td> </td><td> </td><td> </td><td> </td></tr><tr><td> </td><td> </td><td> </td><td> </td></tr><tr><td> </td><td> </td><td> </td><td> </td></tr></tbody></table>		NO.	DATE	BY	REVISION DESCRIPTION													1326 ENERGY PARK DRIVE ST. PAUL, MINNESOTA 55108 (651) 644-4389 Howard R. Green Company		CONCORD/BOSTON STREET IMPROVEMENTS CITY OF ELK RIVER		PLAN AND PROFILE MISSISSIPPI ROAD (CSAH 30) 0+00 TO 1+92		SHEET NO. 7	
NO.	DATE	BY	REVISION DESCRIPTION																										