



# MISSISSIPPI ROAD (CSAH 30)

- NOTES:
1. SERVICE LOCATIONS WILL BE DETERMINED IN THE FIELD BY THE ENGINEER.
  2. ALL DRIVEWAYS TO RECEIVE CONCRETE DRIVEWAY APRONS. REMOVE DRIVEWAY PAVEMENT AS REQUIRED TO CONSTRUCTION LIMITS. SEE TYPICAL DETAIL.
  3. RESTORATION ALONG MISSISSIPPI ROAD TO CONSIST OF SEEDING, FERTILIZER, MULCH AND DISK ANCHORING.

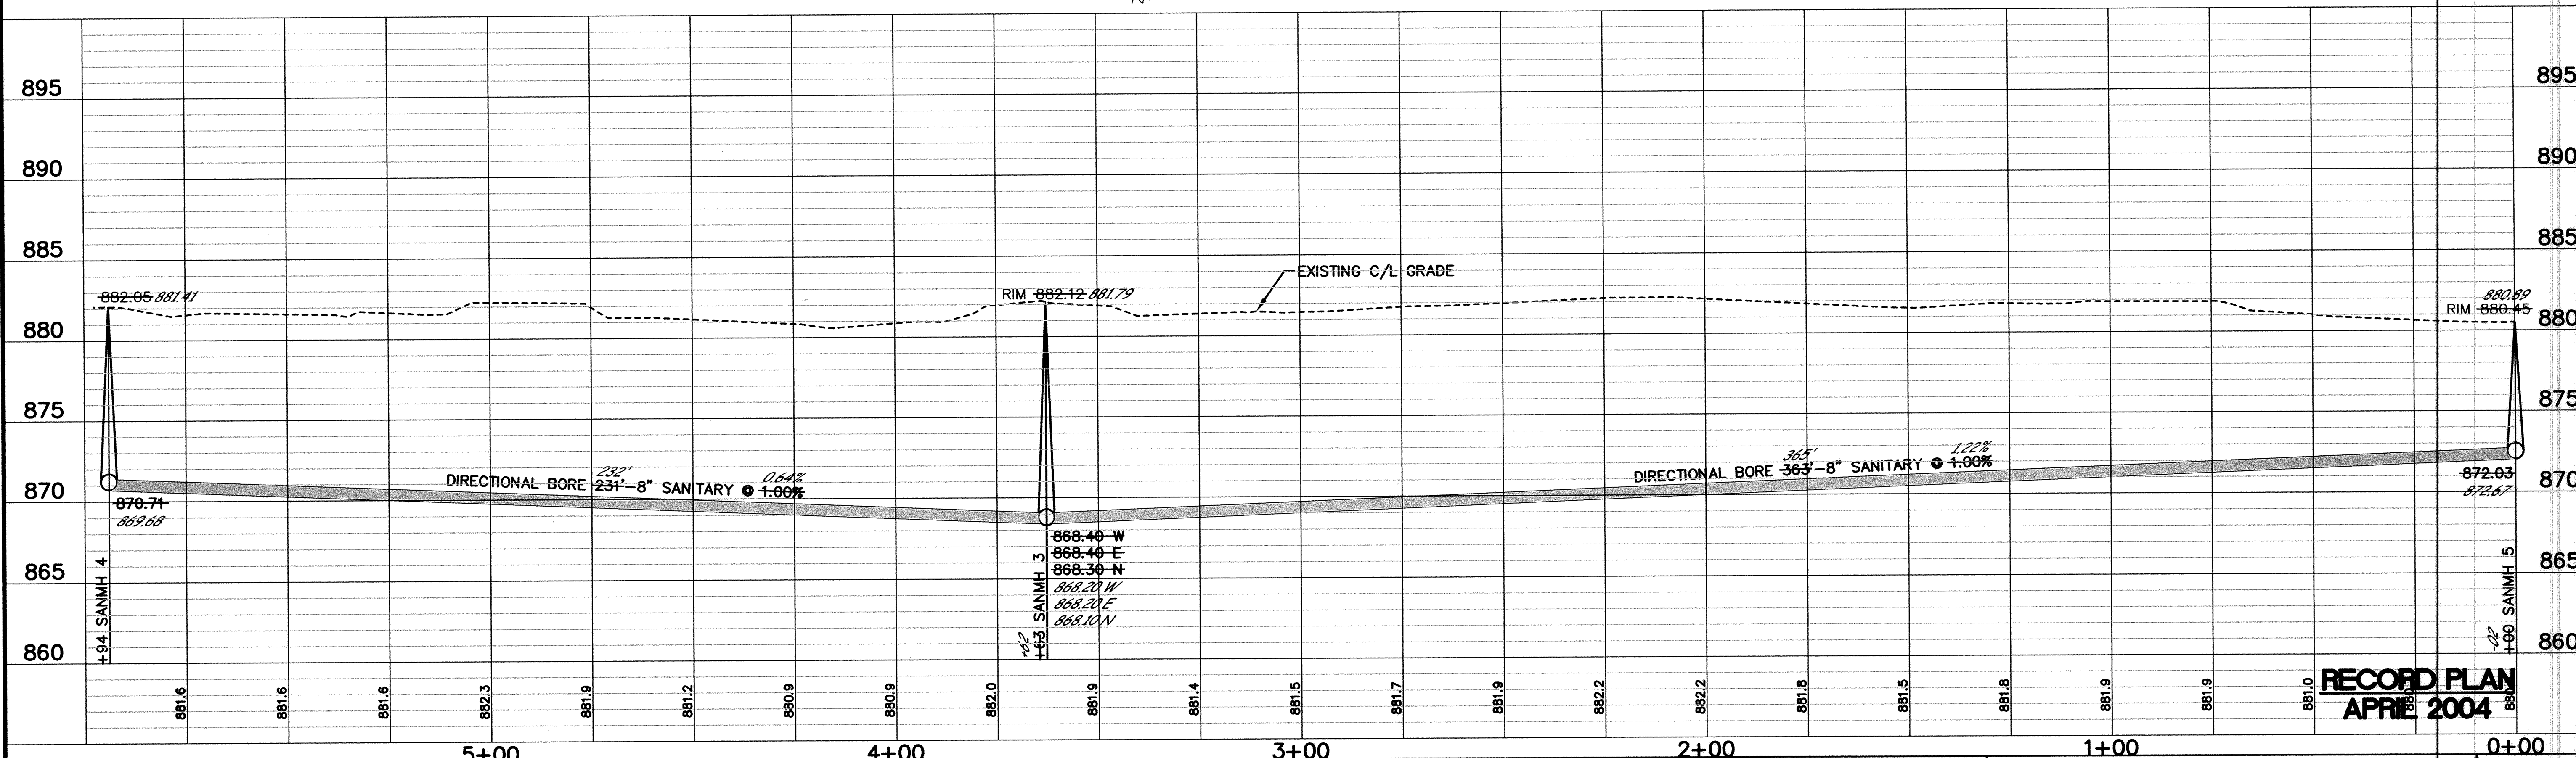

0 20  
0 VERT. 5

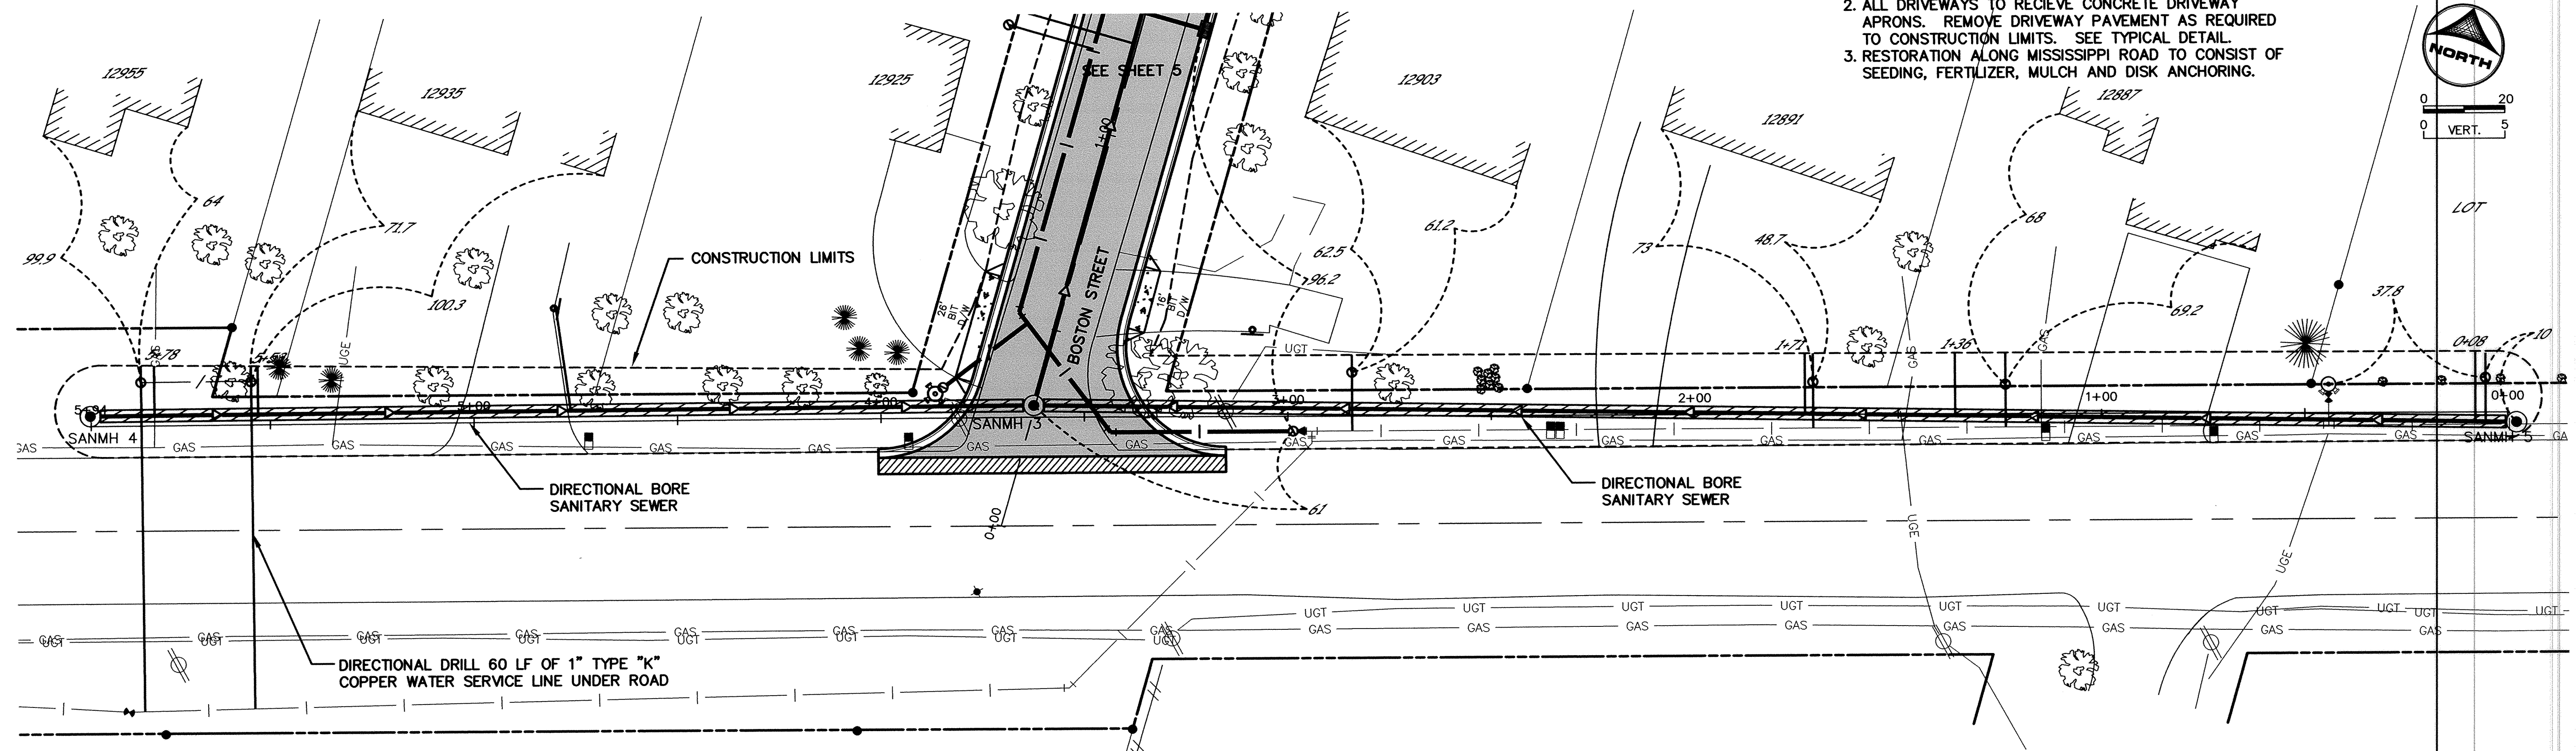

| DESIGNED BY: DESIGNED BY: RKM<br>APPROVED BY: APPROVED BY: JOB NUMBER 818860J<br>CAD DATE: January 15, 2004 3:57:13 p.m.<br>CAD FILE: 818860J\As-Built\C\CT-D06.DWG (RMONJEA) |      | I HEREBY CERTIFY THAT THIS PLAN, SPECIFICATION, OR REPORT WAS PREPARED BY ME OR UNDER MY DIRECT SUPERVISION AND THAT I AM A DULY LICENSED PROFESSIONAL ENGINEER UNDER THE LAWS OF THE STATE OF MINNESOTA.<br>SIGNATURE: Kristina Thompson DATE: _____<br>PRINTED NAME: KRISTINA THOMPSON LIC. NO. 42350 |                      | <table border="1"><thead><tr><th>NO.</th><th>DATE</th><th>BY</th><th>REVISION DESCRIPTION</th></tr></thead><tbody><tr><td> </td><td> </td><td> </td><td> </td></tr><tr><td> </td><td> </td><td> </td><td> </td></tr><tr><td> </td><td> </td><td> </td><td> </td></tr></tbody></table> |  | NO. | DATE | BY | REVISION DESCRIPTION |  |  |  |  |  |  |  |  |  |  |  |  | 1326 ENERGY PARK DRIVE<br>ST. PAUL, MINNESOTA 55108<br>(651) 644-4389<br>Howard R. Green Company |  | CONCORD/BOSTON STREET IMPROVEMENTS<br>CITY OF ELK RIVER |  | PLAN AND PROFILE<br>MISSISSIPPI ROAD (CSAH 30)<br>0+00 TO 5+94 |  | SHEET NO.<br>8 |  |
|-------------------------------------------------------------------------------------------------------------------------------------------------------------------------------|------|---------------------------------------------------------------------------------------------------------------------------------------------------------------------------------------------------------------------------------------------------------------------------------------------------------|----------------------|---------------------------------------------------------------------------------------------------------------------------------------------------------------------------------------------------------------------------------------------------------------------------------------|--|-----|------|----|----------------------|--|--|--|--|--|--|--|--|--|--|--|--|--------------------------------------------------------------------------------------------------|--|---------------------------------------------------------|--|----------------------------------------------------------------|--|----------------|--|
| NO.                                                                                                                                                                           | DATE | BY                                                                                                                                                                                                                                                                                                      | REVISION DESCRIPTION |                                                                                                                                                                                                                                                                                       |  |                                                                                                                                                                               |      |                                                                                                                                                                               |      |                                                                                                                                                                               |      