
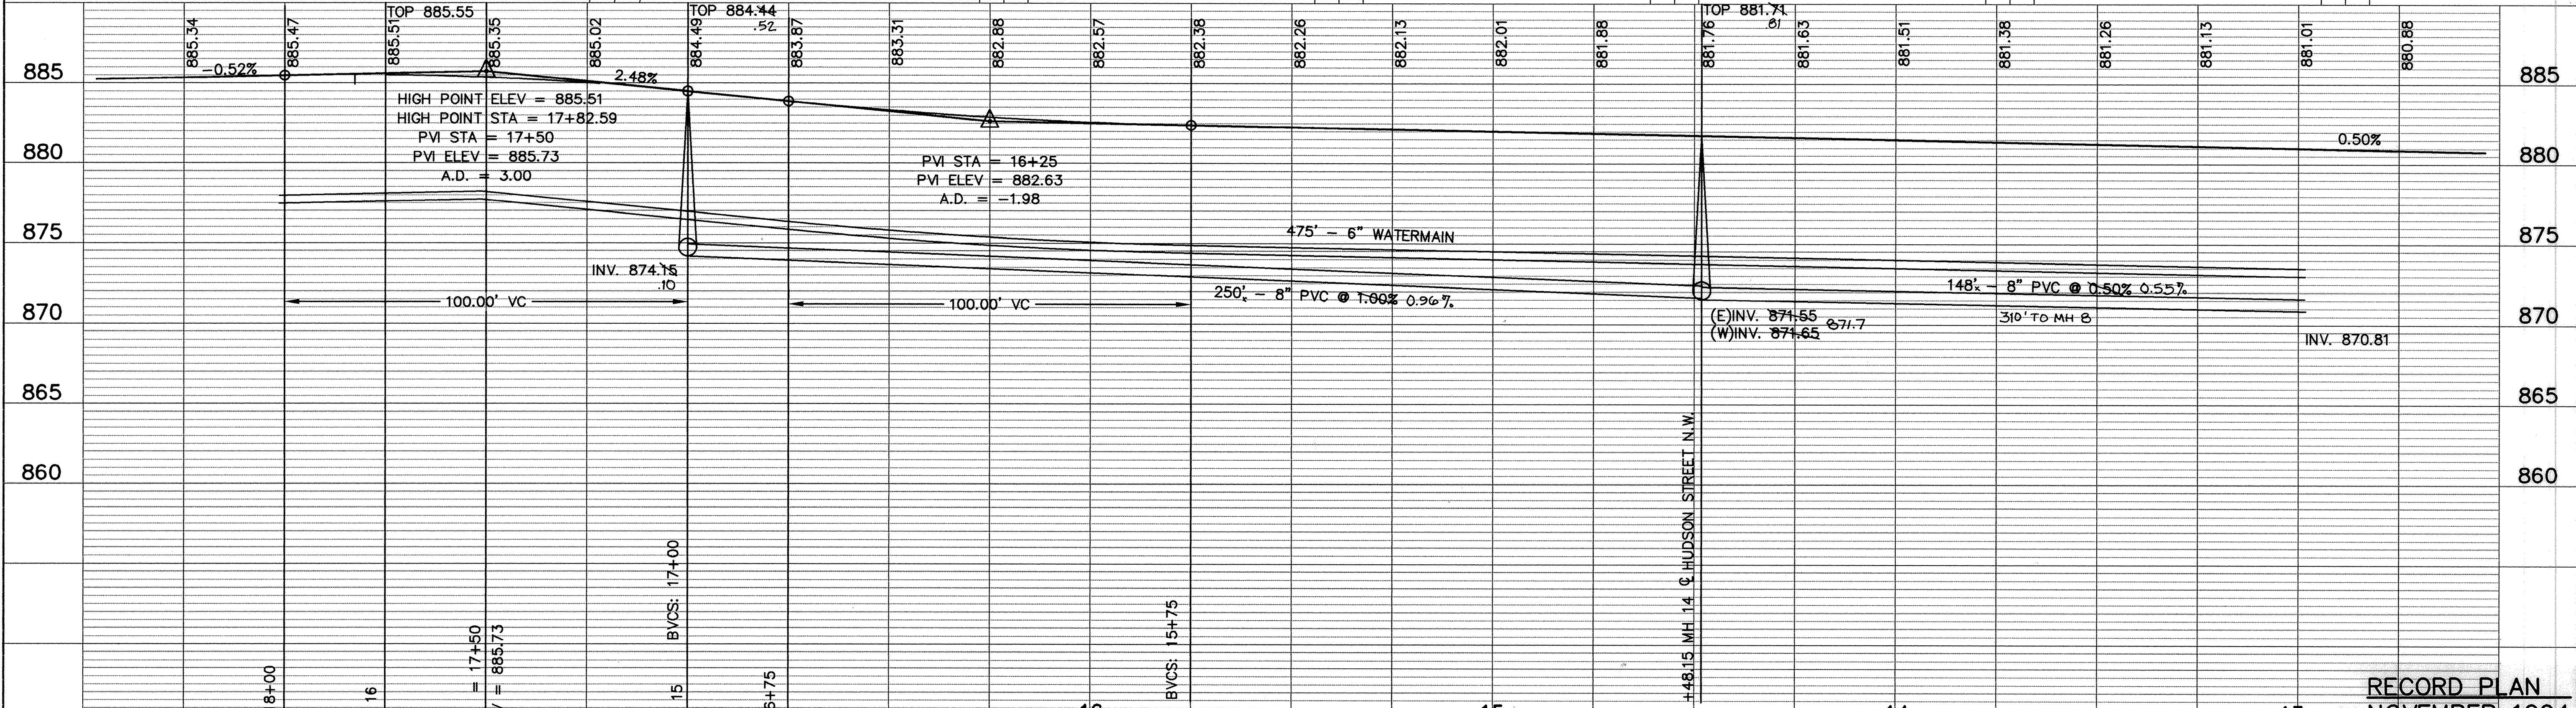


181st LANE N.W.

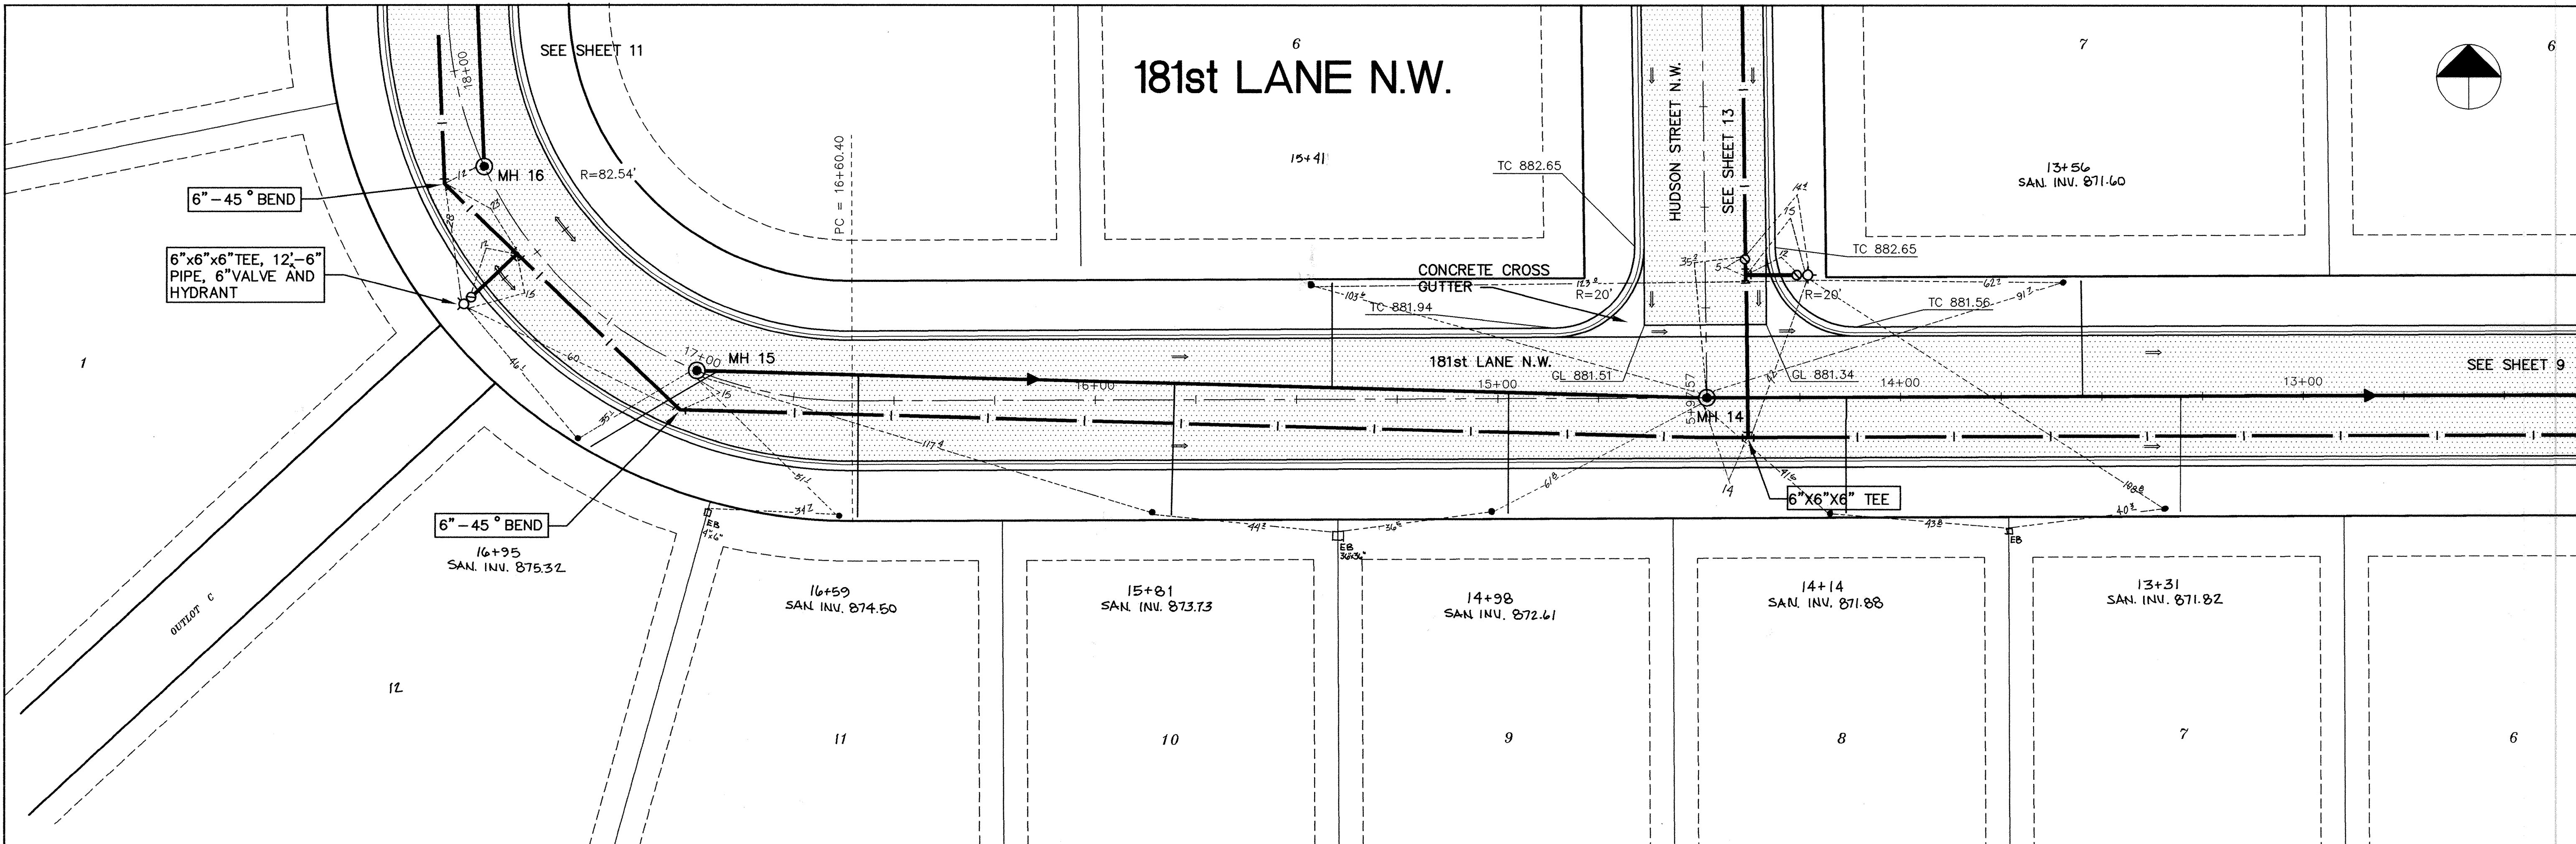

1. I HEREBY CERTIFY THAT THIS PLAN, SPECIFICATION, OR REPORT WAS PREPARED BY ME OR UNDER MY DIRECT SUPERVISION AND THAT I AM A DULY REGISTERED PROFESSIONAL ENGINEER UNDER THE LAWS OF THE STATE OF MINNESOTA.

*Mark V. Luukkonen*

DATE 7/27/94 REG. NO. 19130

**MSA**  
CONSULTING ENGINEERS

1326 ENERGY PARK DRIVE  
ST. PAUL, MINNESOTA 55108  
(612) 644-4389

9800 SHELARD PARKWAY  
MINNEAPOLIS, MINNESOTA 55441  
(612) 546-0432

| REVISIONS | DATE | DESCRIPTION |
|-----------|------|-------------|
|           |      |             |
|           |      |             |
|           |      |             |

|                                           |                                                                                                |                       |                     |
|-------------------------------------------|------------------------------------------------------------------------------------------------|-----------------------|---------------------|
| DESIGNED <i>MLG</i>                       | CITY OF ELK RIVER<br>SANITARY SEWER AND WATERMAIN<br>181st LANE N.W.<br>STA.<br>12+50 TO 18+50 |                       |                     |
| CHECKED <i>gfb</i>                        |                                                                                                |                       |                     |
| DRAWN <i>gfb</i>                          |                                                                                                |                       |                     |
| GRAPHIC SCALE<br>0 HORIZ. 20<br>0 VERT. 5 | DATE JUNE 1994                                                                                 | SHEET 10 OF 20 SHEETS | PROJECT NO. 230-194 |