



NOTE:
CENTERLINE GRADE ALONG IROTON STREET N.W.
THROUGH INTERSECTION OF 182BD AVENUE N.W.
SHALL MAINTAIN AN ELEVATION OF - 884.22

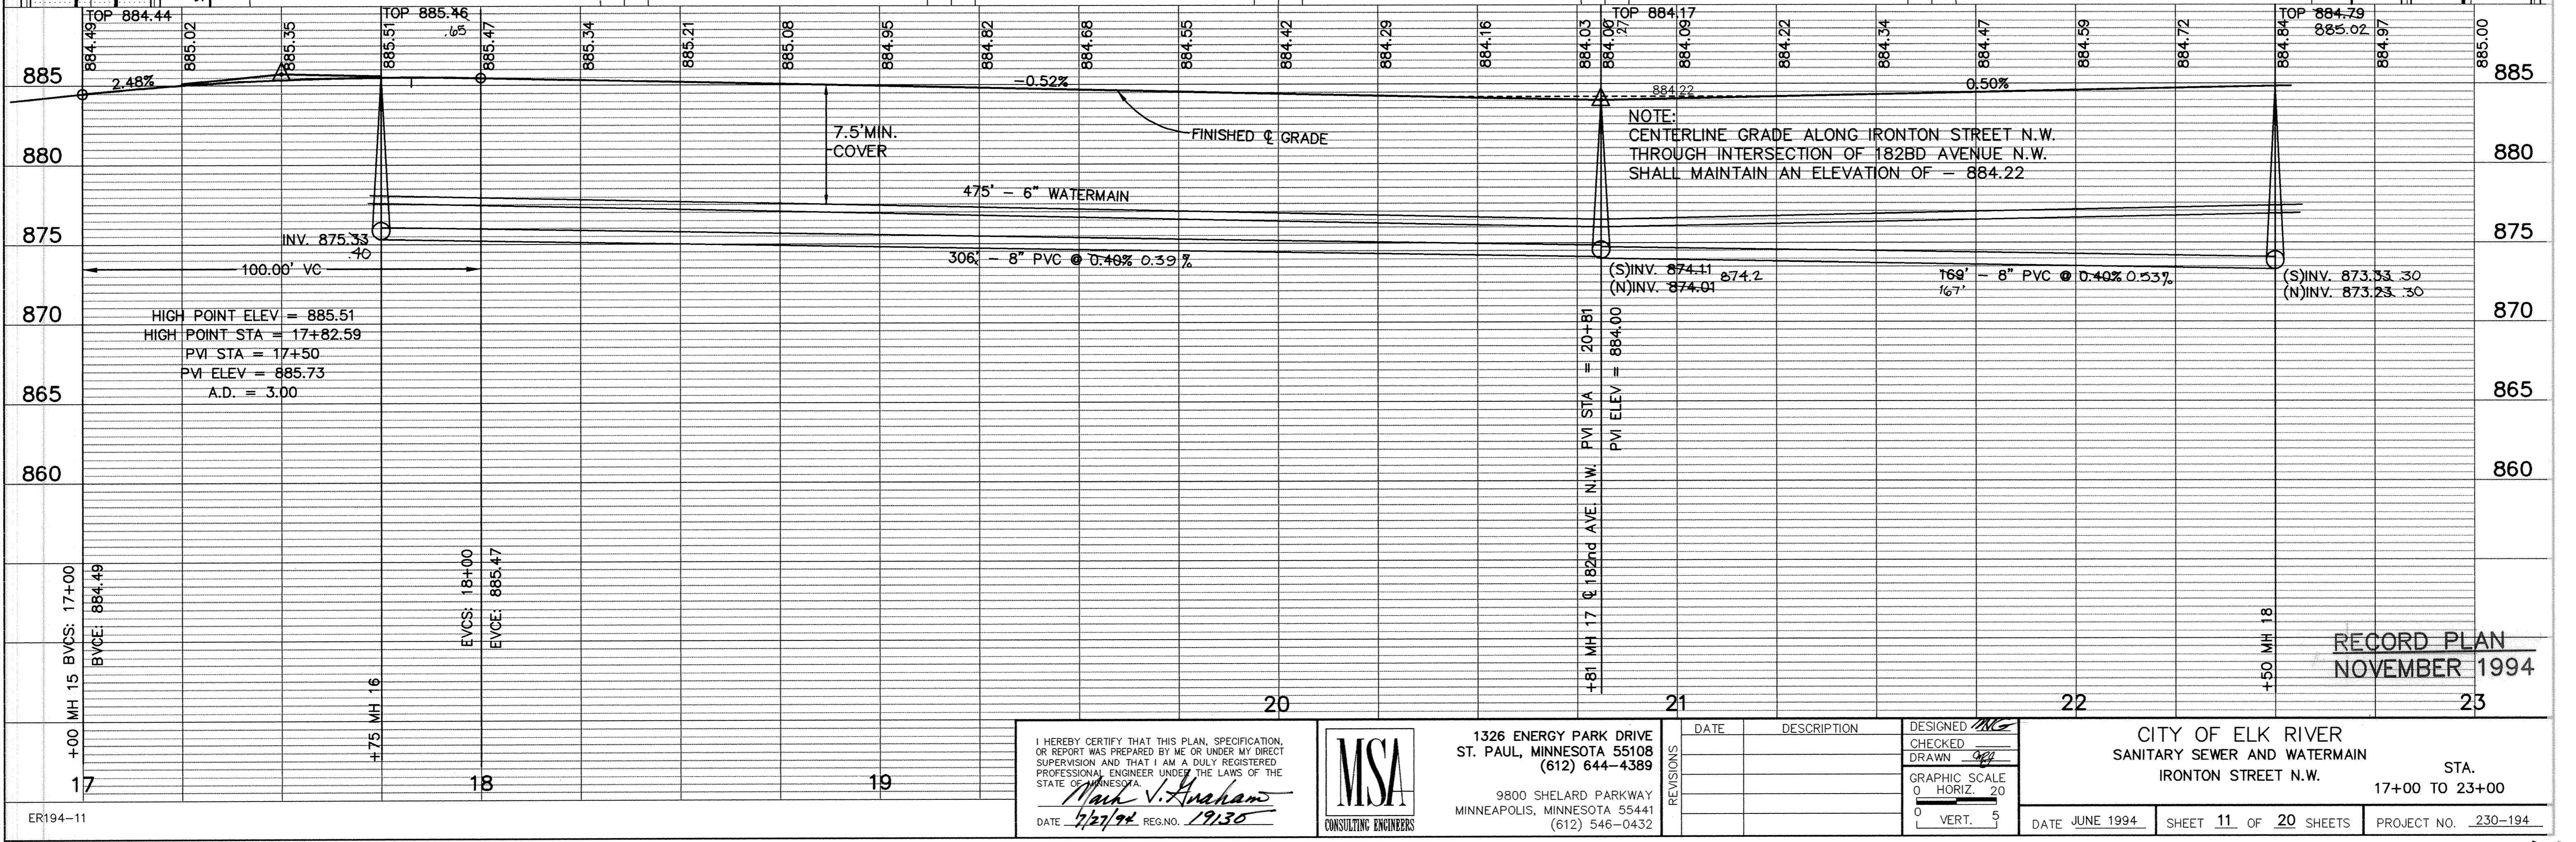

I HEREBY CERTIFY THAT THIS PLAN, SPECIFICATION
OR REPORT WAS PREPARED BY ME OR UNDER MY DIREC-
T SUPERVISION AND THAT I AM A DULY REGISTERED
PROFESSIONAL ENGINEER UNDER THE LAWS OF THE
STATE OF MINNESOTA.

Mark V. Graham

DATE 7/27/94 REG.NO. 19130

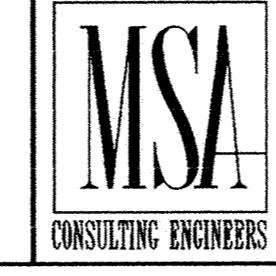

1326 ENERGY PARK DRIVE
ST. PAUL, MINNESOTA 55108
(612) 644-4389

9800 SHELARD PARKWAY
MINNEAPOLIS, MINNESOTA 55441
(612) 546-0432

REVISIONS	DATE	DESCRIPTION	DESIGNED <u>MCG</u>	CITY OF ELK RIVER SANITARY SEWER AND WATERMAIN Ironton Street N.W. STA. 17+00 TO 23+00	
			CHECKED _____		
			DRAWN <u>GRG</u>		
			GRAPHIC SCALE 0 HORIZ. 20 		
			0 VERT. 5		
			DATE JUNE 1994	SHEET <u>11</u> OF <u>20</u> SHEETS	PROJECT NO. <u>230-194</u>

CITY OF ELK RIVER
MUNICIPAL SEWER AND WATERMAIN
IRONTON STREET N.W.

STA.
+00 TO 23+00

COUNT 1.94