



SAECO PRODUCTS • NEW HOPKINS, MINNESOTA
REVISIONS BY PART NUMBER 1832
SAECO PRODUCTS • NEW HOPKINS, MINNESOTA
REVISIONS BY PART NUMBER 1832
SAECO PRODUCTS • NEW HOPKINS, MINNESOTA
REVISIONS BY PART NUMBER 1832
SAECO PRODUCTS • NEW HOPKINS, MINNESOTA
REVISIONS BY PART NUMBER 1832



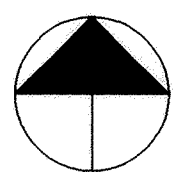


182nd AVENUE N.W.

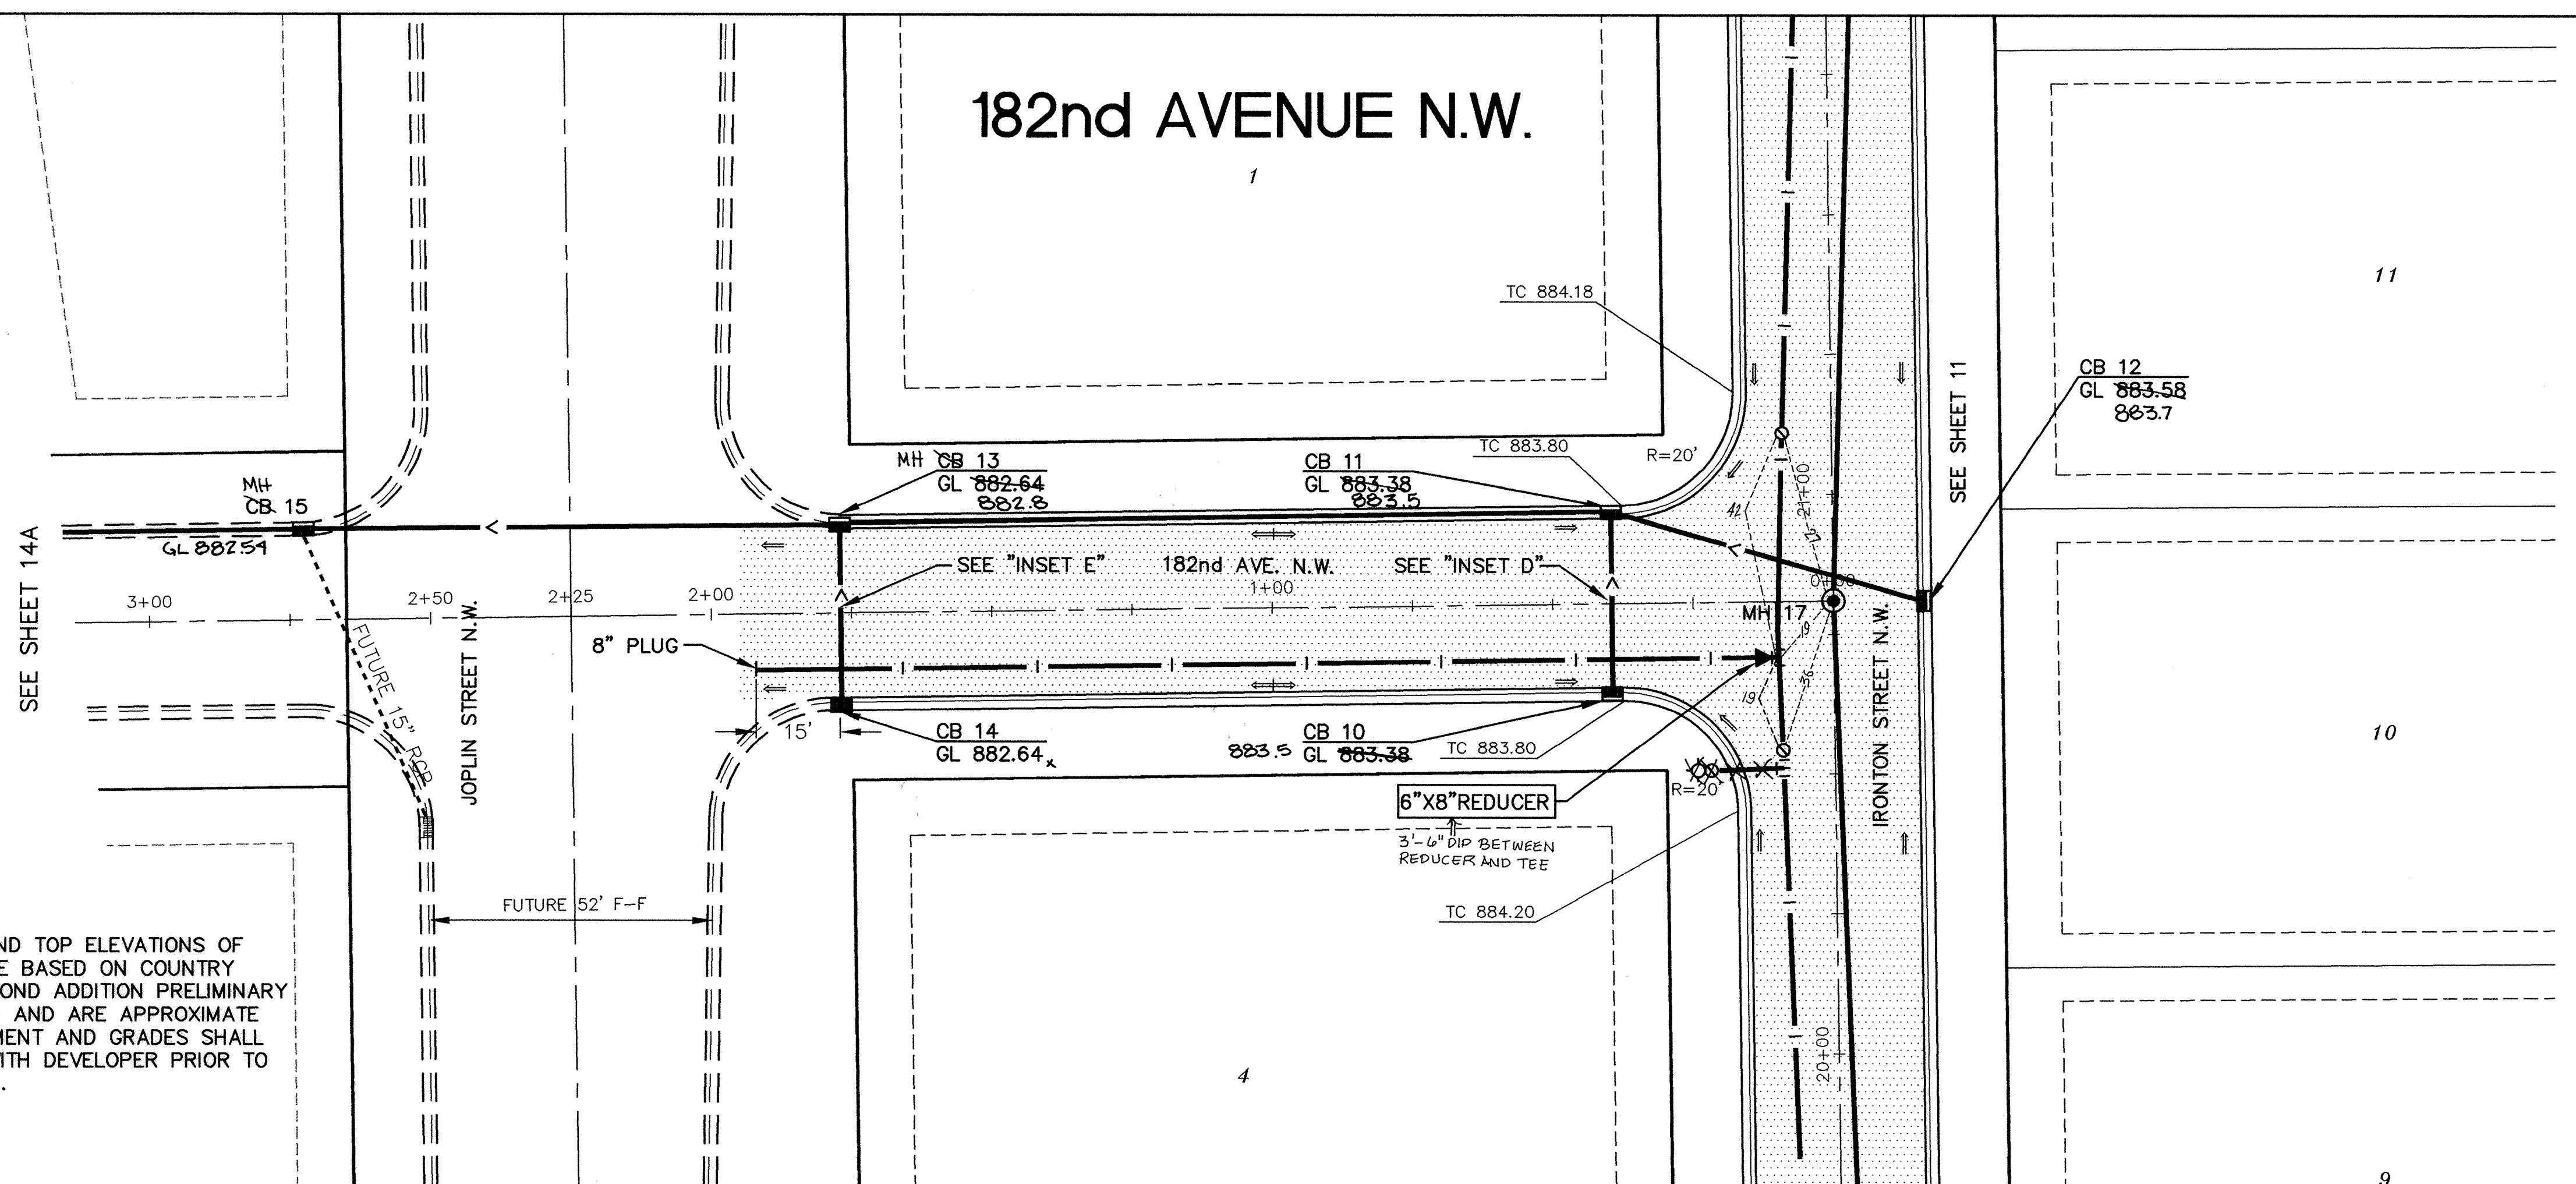


NOTE:
GUTTERLINE AND TOP ELEVATIONS OF
MANHOLES ARE BASED ON COUNTRY
CROSSING SECOND ADDITION PRELIMINARY
GRADING PLAN AND ARE APPROXIMATE
ONLY. ALIGNMENT AND GRADES SHALL
BE VERIFIED WITH DEVELOPER PRIOR TO
CONSTRUCTION.

NOTE:
CENTERLINE GRADE ALONG IRONTON STREET N.W.
THROUGH INTERSECTION OF 182ND AVENUE N.W.
SHALL MAINTAIN AN ELEVATION OF - 884.22

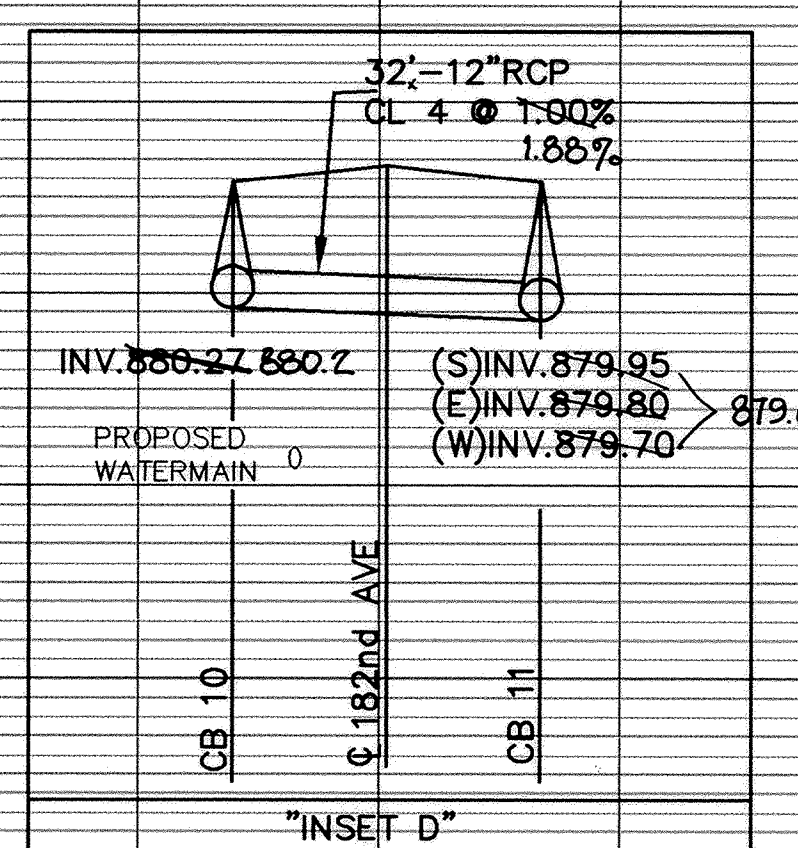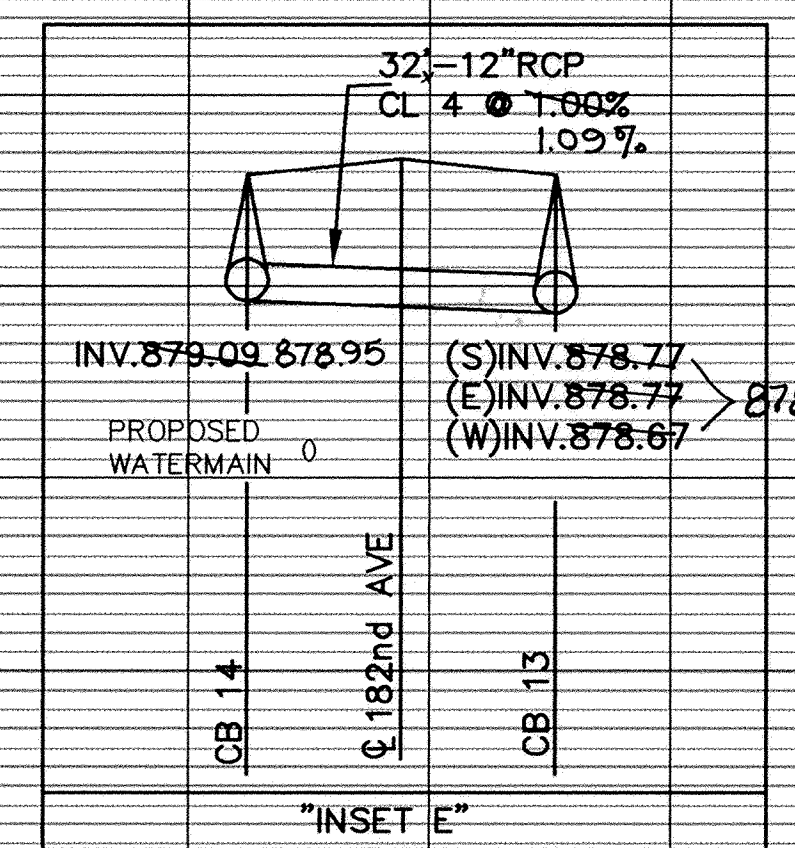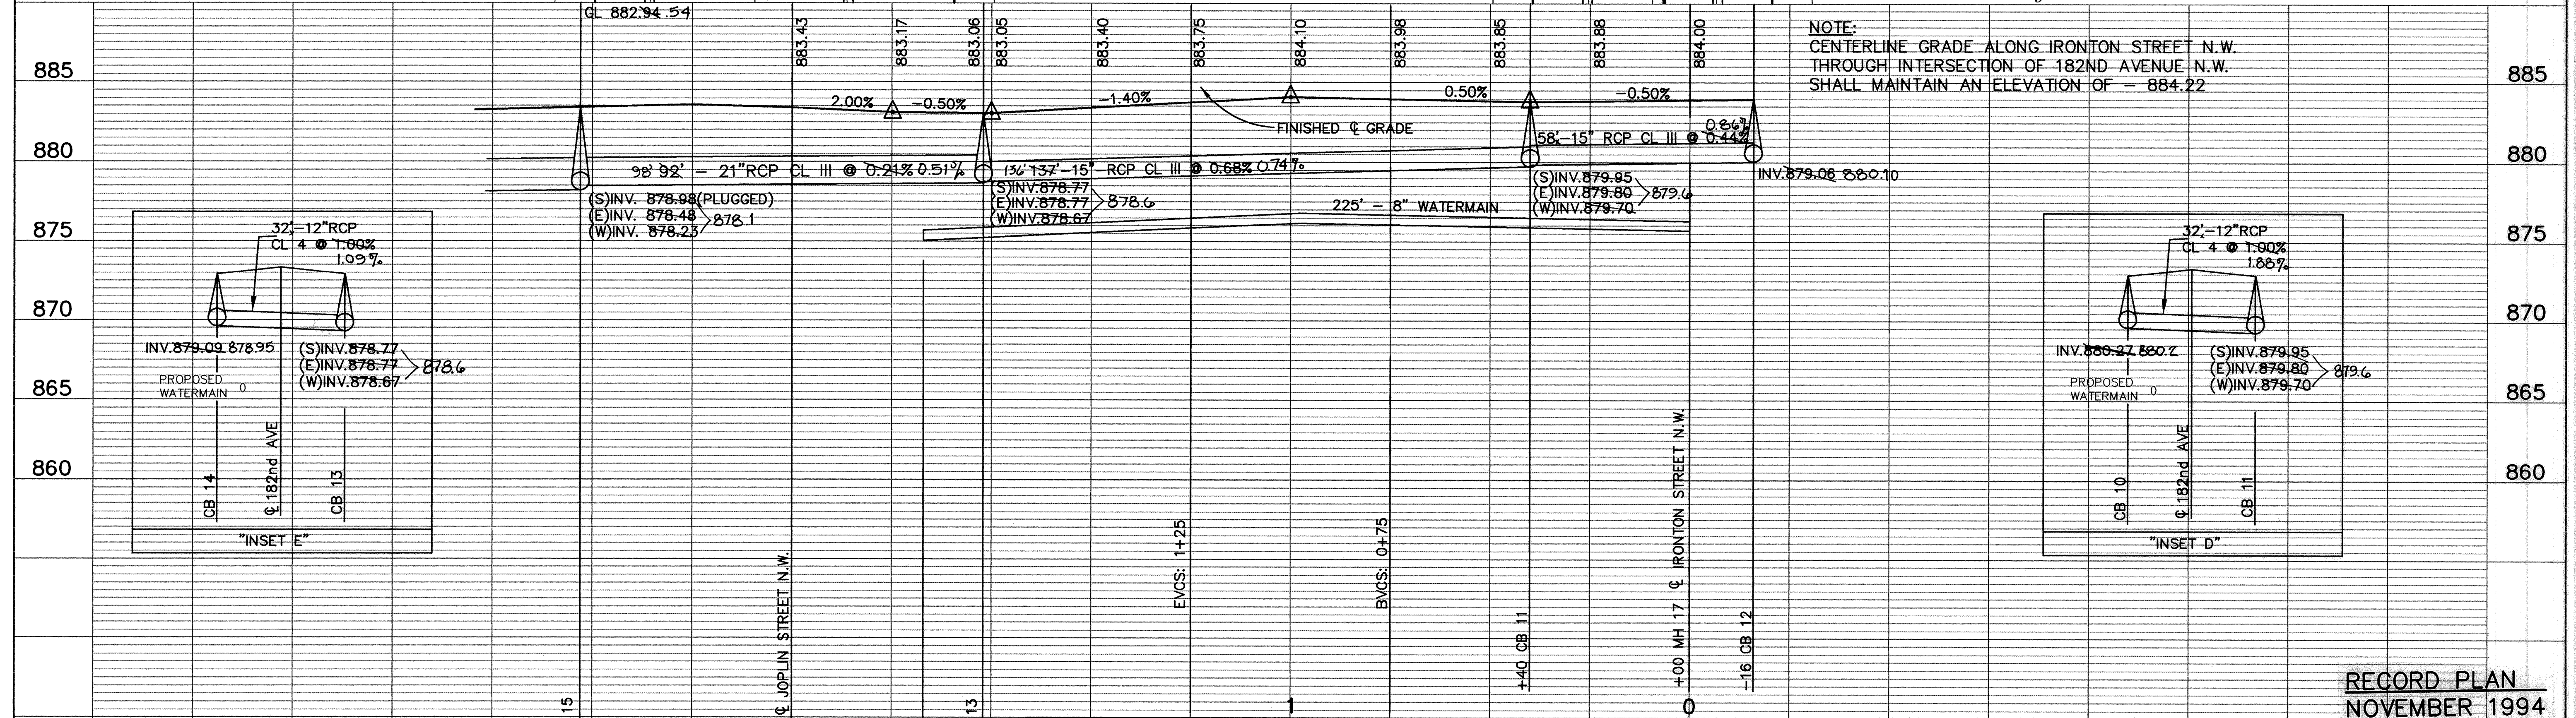

I HEREBY CERTIFY THAT THIS PLAN, SPECIFICATION,
OR REPORT WAS PREPARED BY ME OR UNDER MY DIRECT
SUPERVISION AND THAT I AM A DULY REGISTERED
PROFESSIONAL ENGINEER UNDER THE LAWS OF THE
STATE OF MINNESOTA.
Mark V. Graham
DATE 7/27/94 REG. NO. 19130

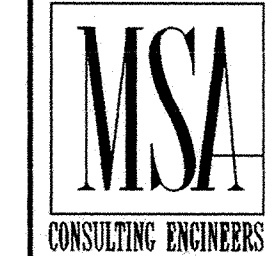

1326 ENERGY PARK DRIVE
ST. PAUL, MINNESOTA 55108
(612) 644-4389
9800 SHELARD PARKWAY
MINNEAPOLIS, MINNESOTA 55441
(612) 546-0432

DATE	DESCRIPTION	DESIGNED
		ME
		CHECKED
		DRAWN
		GRAPHIC SCALE
		0 HORIZ. 20
		0 VERT. 5

CITY OF ELK RIVER SANITARY SEWER AND WATERMAIN 182nd AVENUE N.W.		STA. 0+00 TO 2+75
DATE JUNE 1994	SHEET 14 OF 20 SHEETS	PROJECT NO. 230-194