
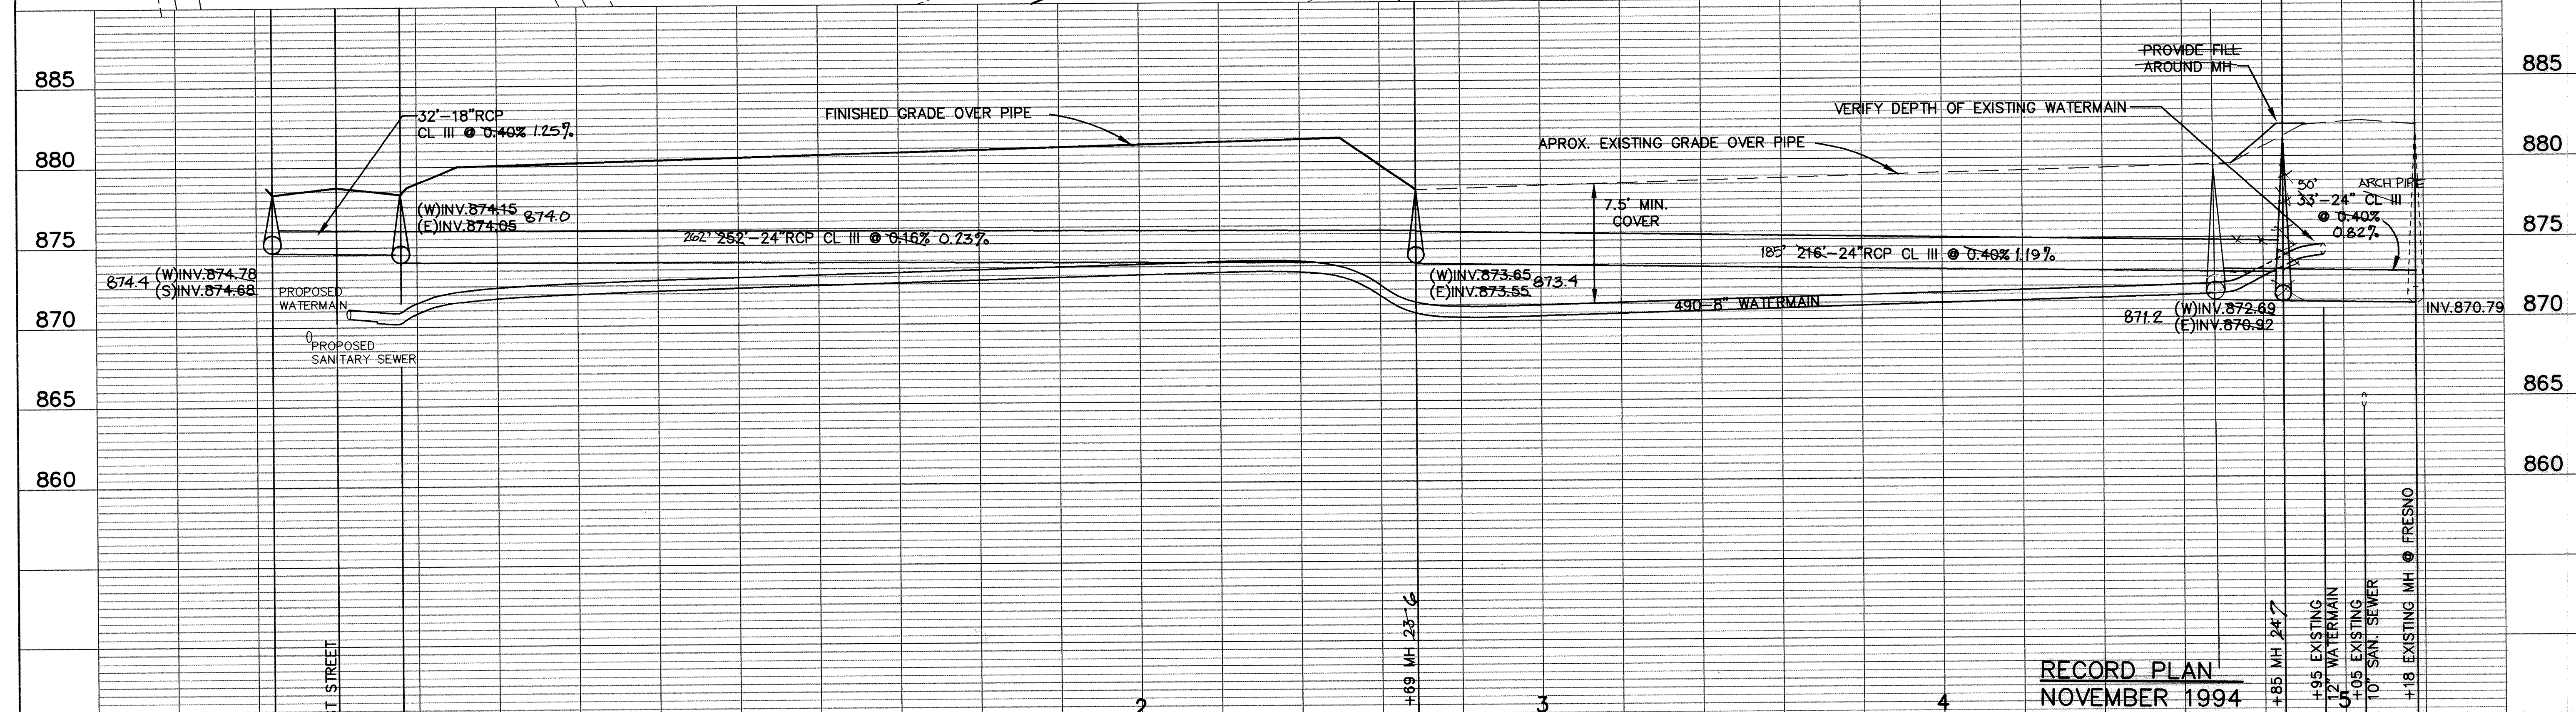


CO PRODUCTS • NEW HOPE, MINNESOTA
REVISION BY PART NUMBER 0002
SANDO PRODUCTS • NEW HOPE, MINNESOTA
REVISION BY PART NUMBER 0002
SANDO PRODUCTS • NEW HOPE, MINNESOTA
REVISION BY PART NUMBER 0002
CITY OF ELK RIVER
COUNT 1.94

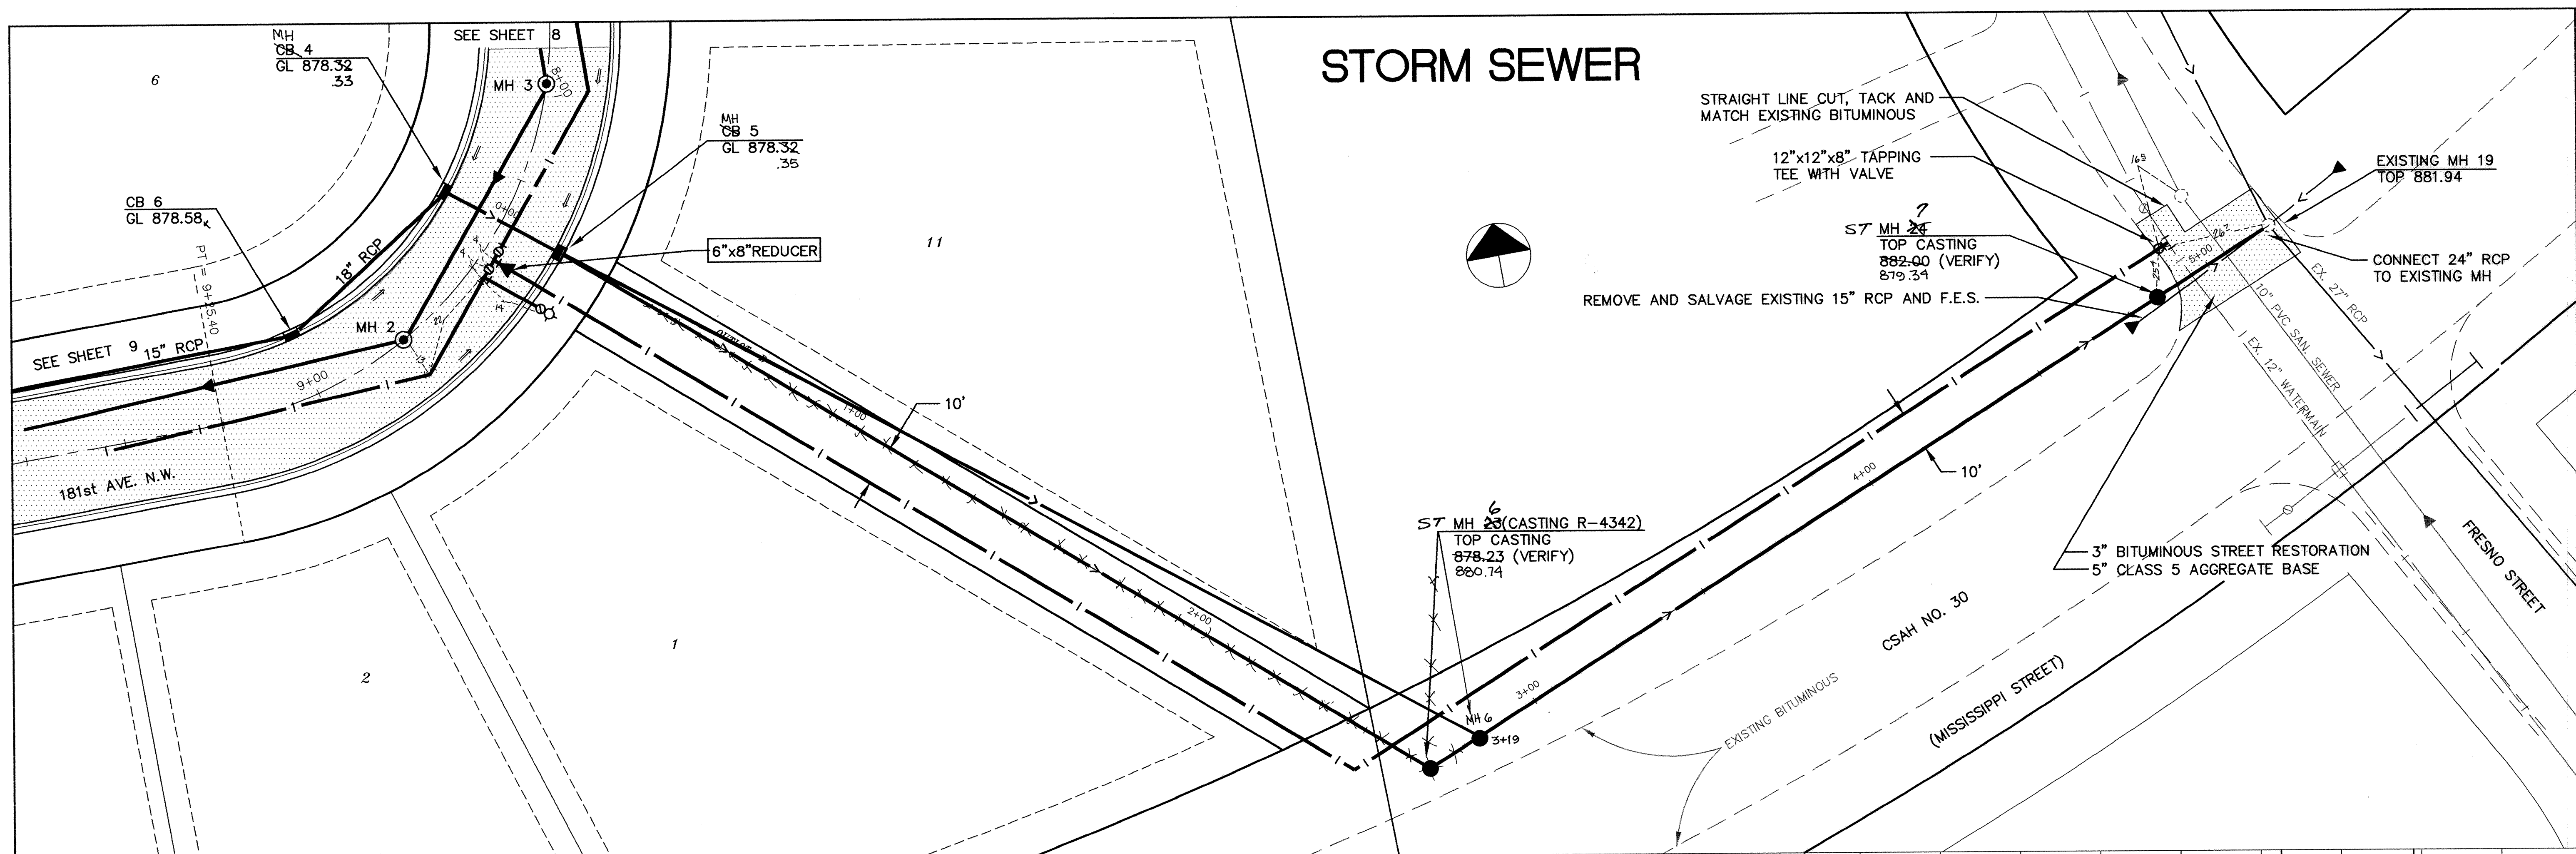

ER194-6		I HEREBY CERTIFY THAT THIS PLAN, SPECIFICATION, OR REPORT WAS PREPARED BY ME OR UNDER MY DIRECT SUPERVISION AND THAT I AM A DULY REGISTERED PROFESSIONAL ENGINEER UNDER THE LAWS OF THE STATE OF MINNESOTA. <i>[Signature]</i> DATE <u>7/27/94</u> REG. NO. <u>19130</u>		MSA CONSULTING ENGINEERS		1326 ENERGY PARK DRIVE ST. PAUL, MINNESOTA 55108 (612) 644-4389 9800 SHELARD PARKWAY MINNEAPOLIS, MINNESOTA 55441 (612) 546-0432		REVISIONS DATE DESCRIPTION DESIGNED <i>[Signature]</i> CHECKED <i>[Signature]</i> DRAWN <i>[Signature]</i> GRAPHIC SCALE 0' HORIZ. 20' 0' VERT. 5'		CITY OF ELK RIVER STORM SEWER RECORD PLAN NOVEMBER 1994		DATE JUNE 1994 SHEET 16 OF 20 SHEETS PROJECT NO. 230-194	
---------	--	--	--	-----------------------------	--	---	--	---	--	--	--	--	--