
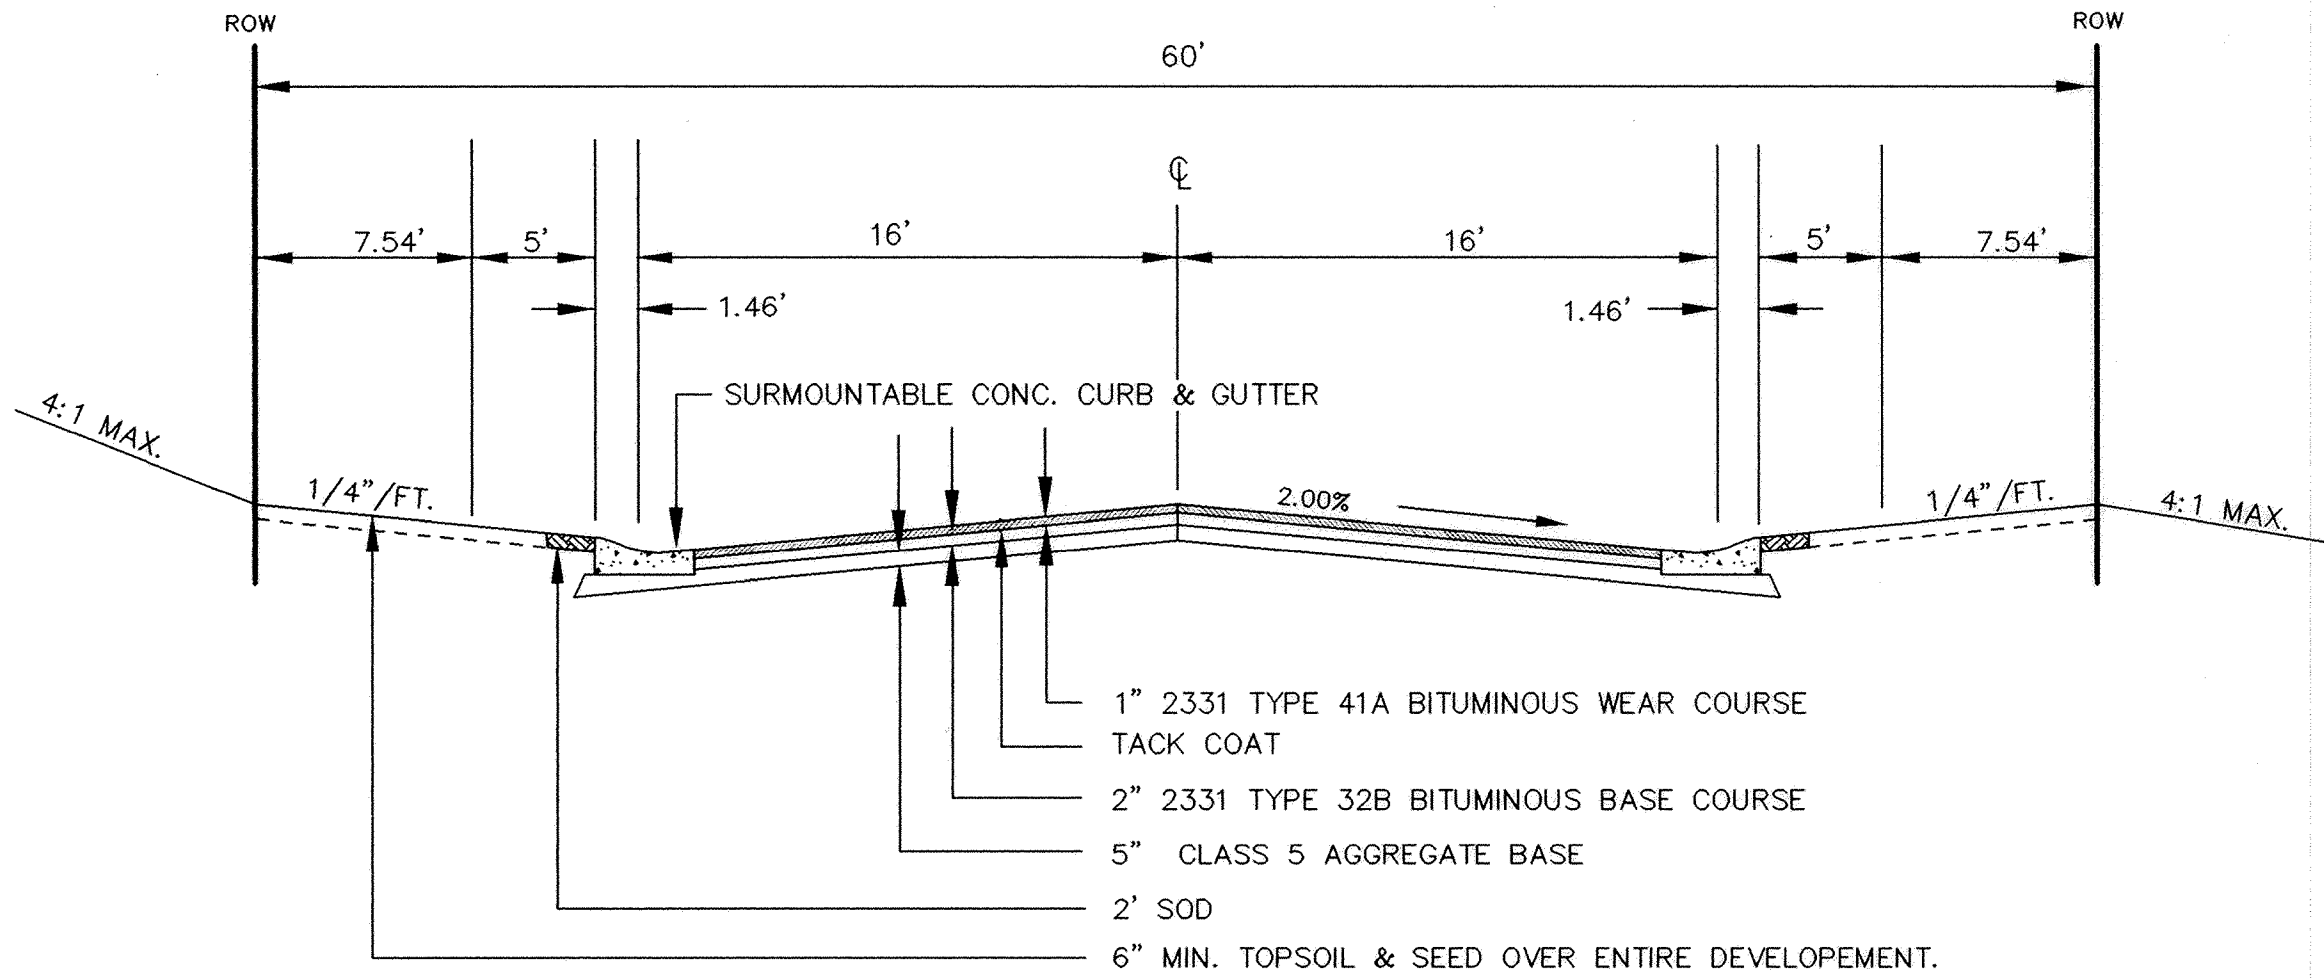
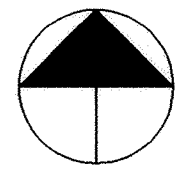


COUNTRY CROSSING

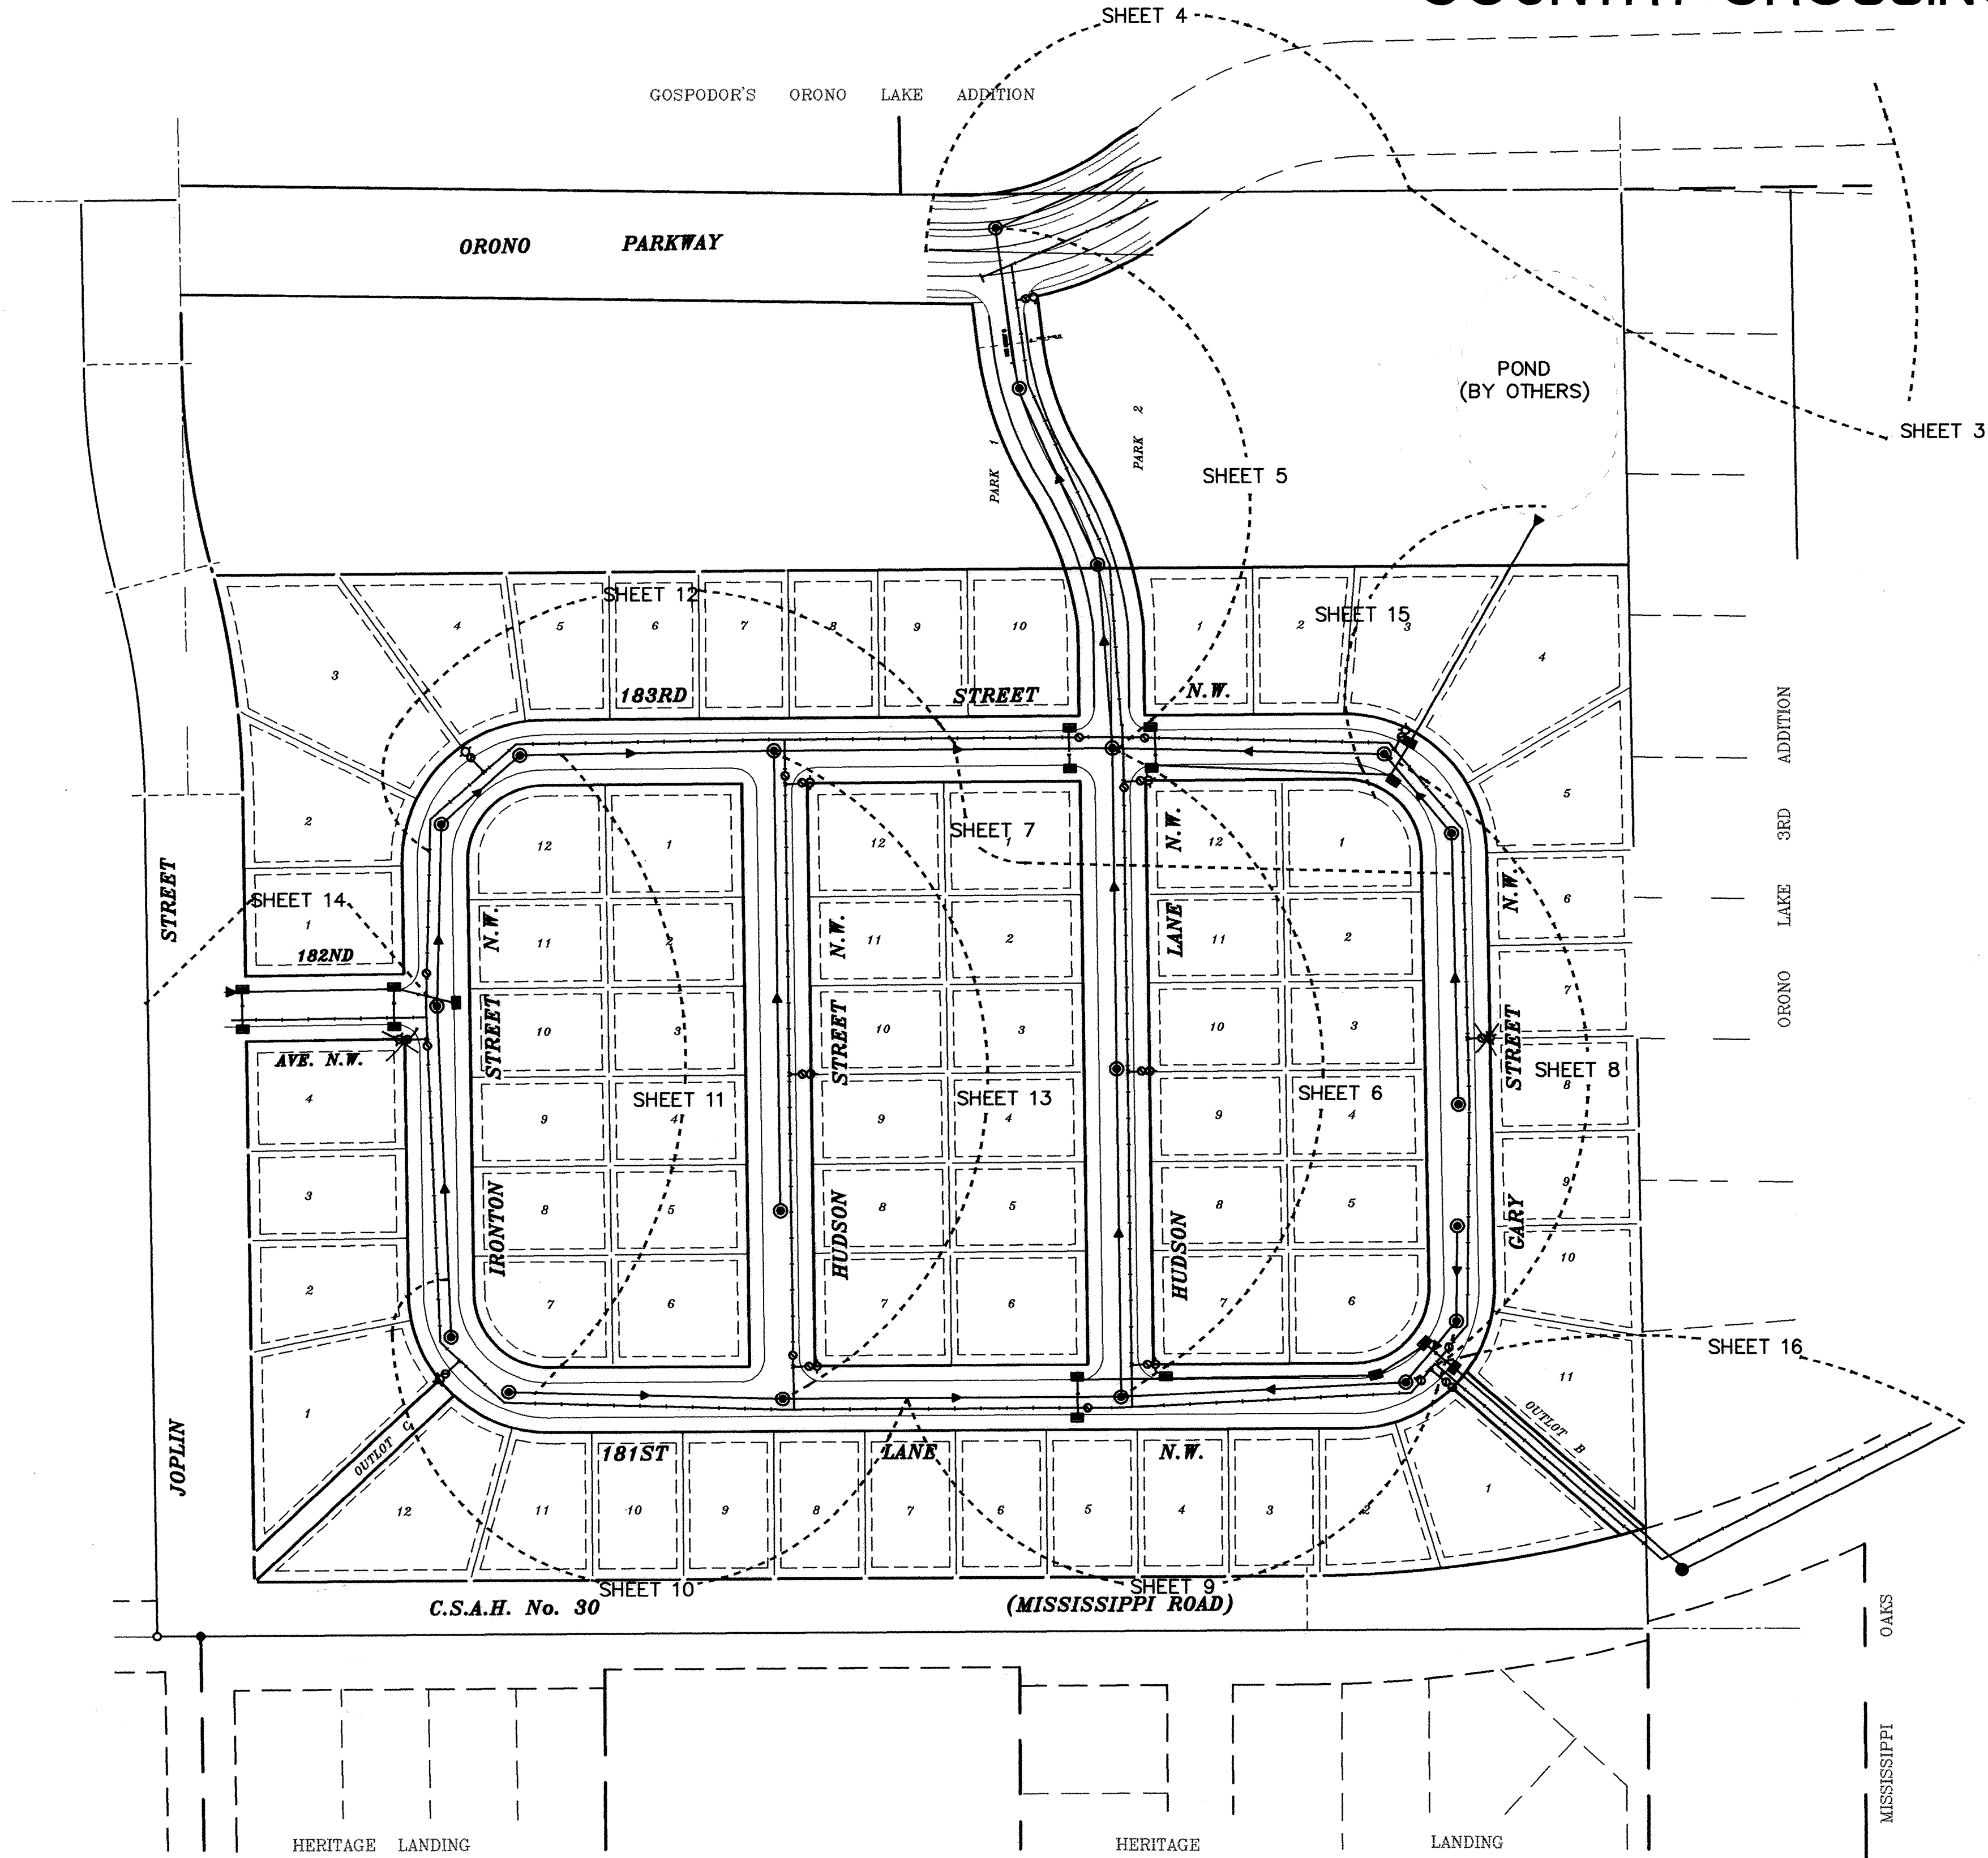

PROPOSED STREET SECTION

NOTE: CENTERLINE ELEVATION IS EQUAL TO TOP OF CURB ELEVATION.

NOTE: SITE GRADING TO BE COMPLETED BY OTHERS.

RECORD PLAN
NOVEMBER 1994

CITY OF ELK RIVER
LOCATION MAP & STREET SECTION
COUNTRY CROSSING

DATE JUNE, 1994 SHEET 2 OF 20 SHEETS PROJECT NO. 230-194

I HEREBY CERTIFY THAT THIS PLAN, SPECIFICATION, OR REPORT WAS PREPARED BY ME OR UNDER MY DIRECT SUPERVISION AND THAT I AM A DULY REGISTERED PROFESSIONAL ENGINEER UNDER THE LAWS OF THE STATE OF MINNESOTA.
Mark J. Guahano
DATE 7/27/94 REG. NO. 19130



1326 ENERGY PARK DRIVE
ST. PAUL, MINNESOTA 55108
(612) 644-4389
9800 SHELARD PARKWAY
MINNEAPOLIS, MINNESOTA 55441
(612) 546-0432

REVISIONS	DATE	DESCRIPTION	DESIGNED	CHECKED	DRAWN
			MG		

GRAPHIC SCALE
0 HORIZ. 100
0 VERT. 5