

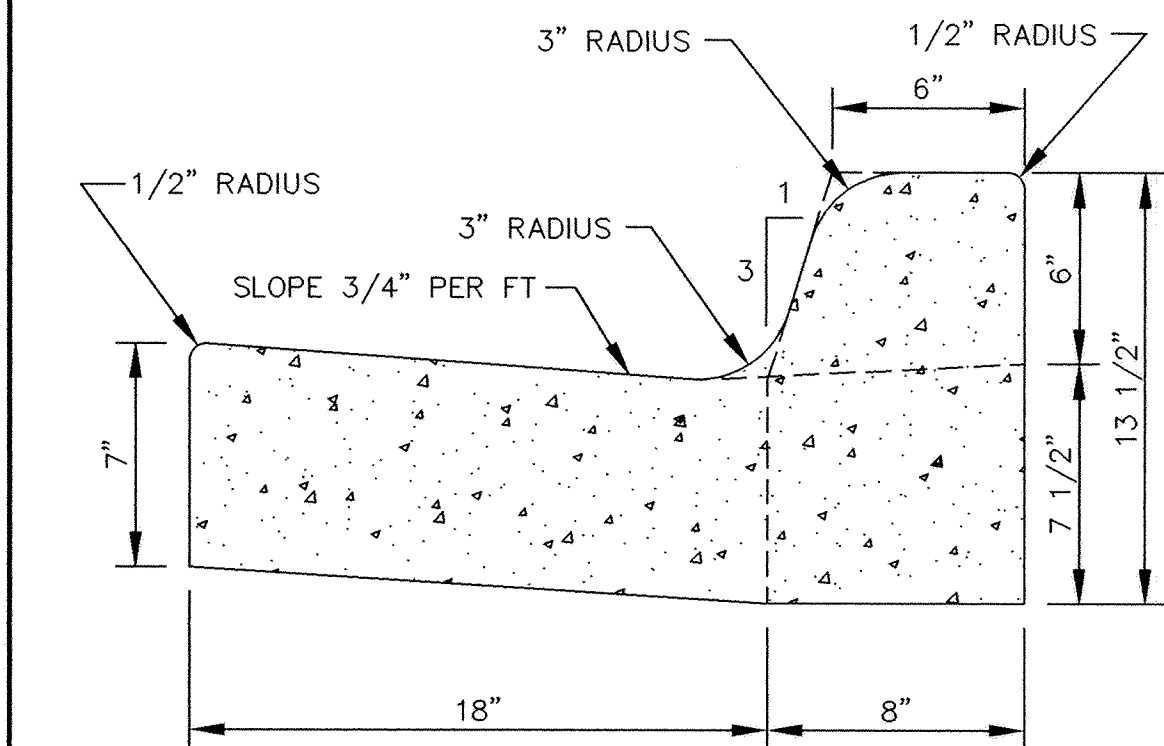


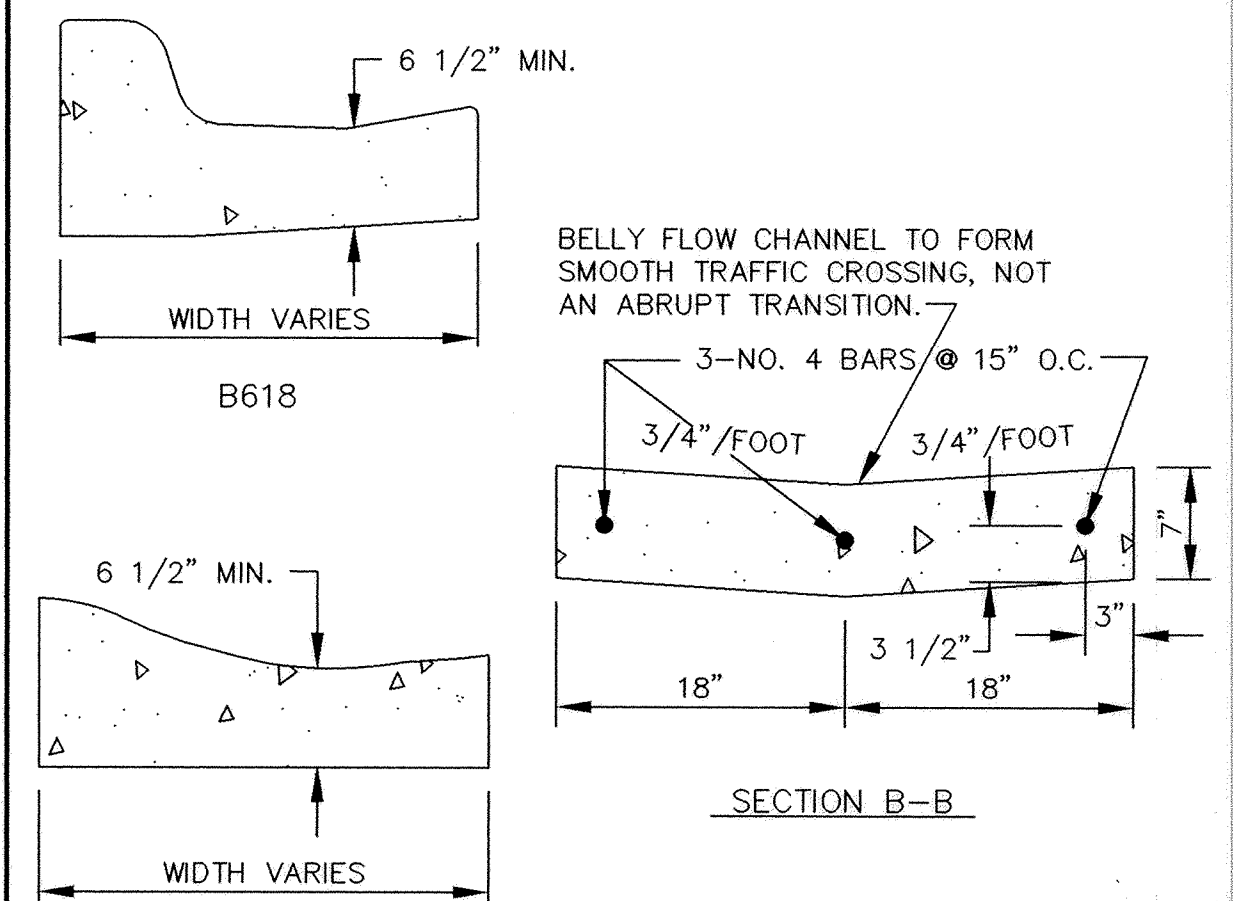


CONCRETE CURB AND GUTTER B618

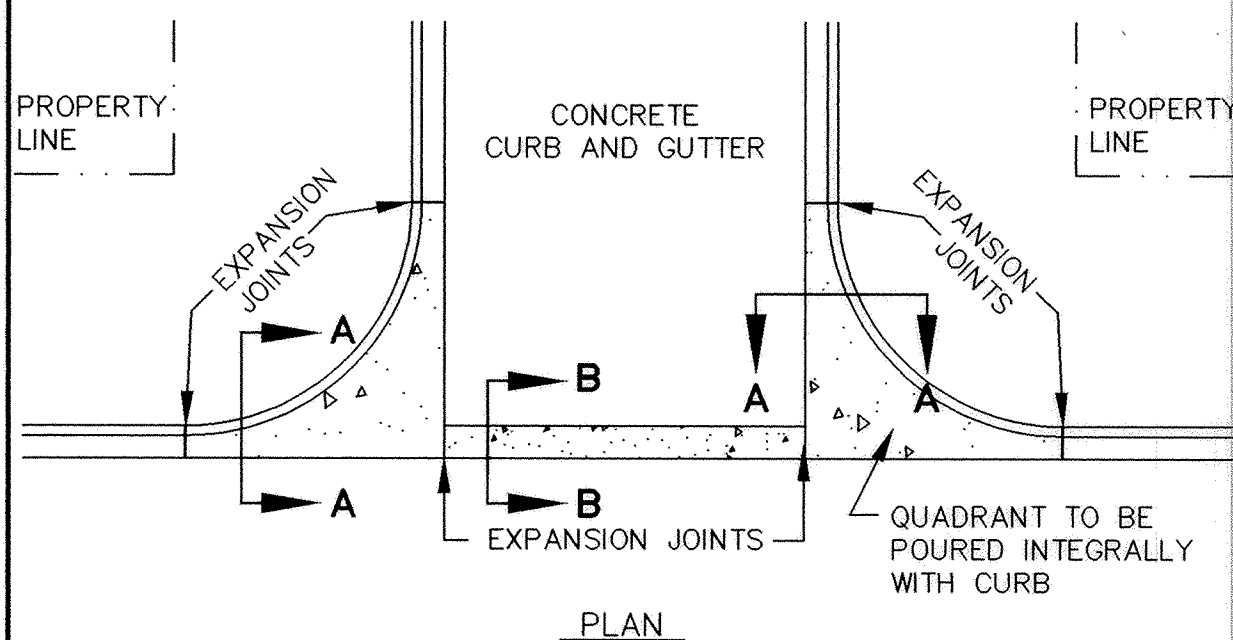


RECORD PLAN
NOVEMBER 1994


CONCRETE "V" GUTTER

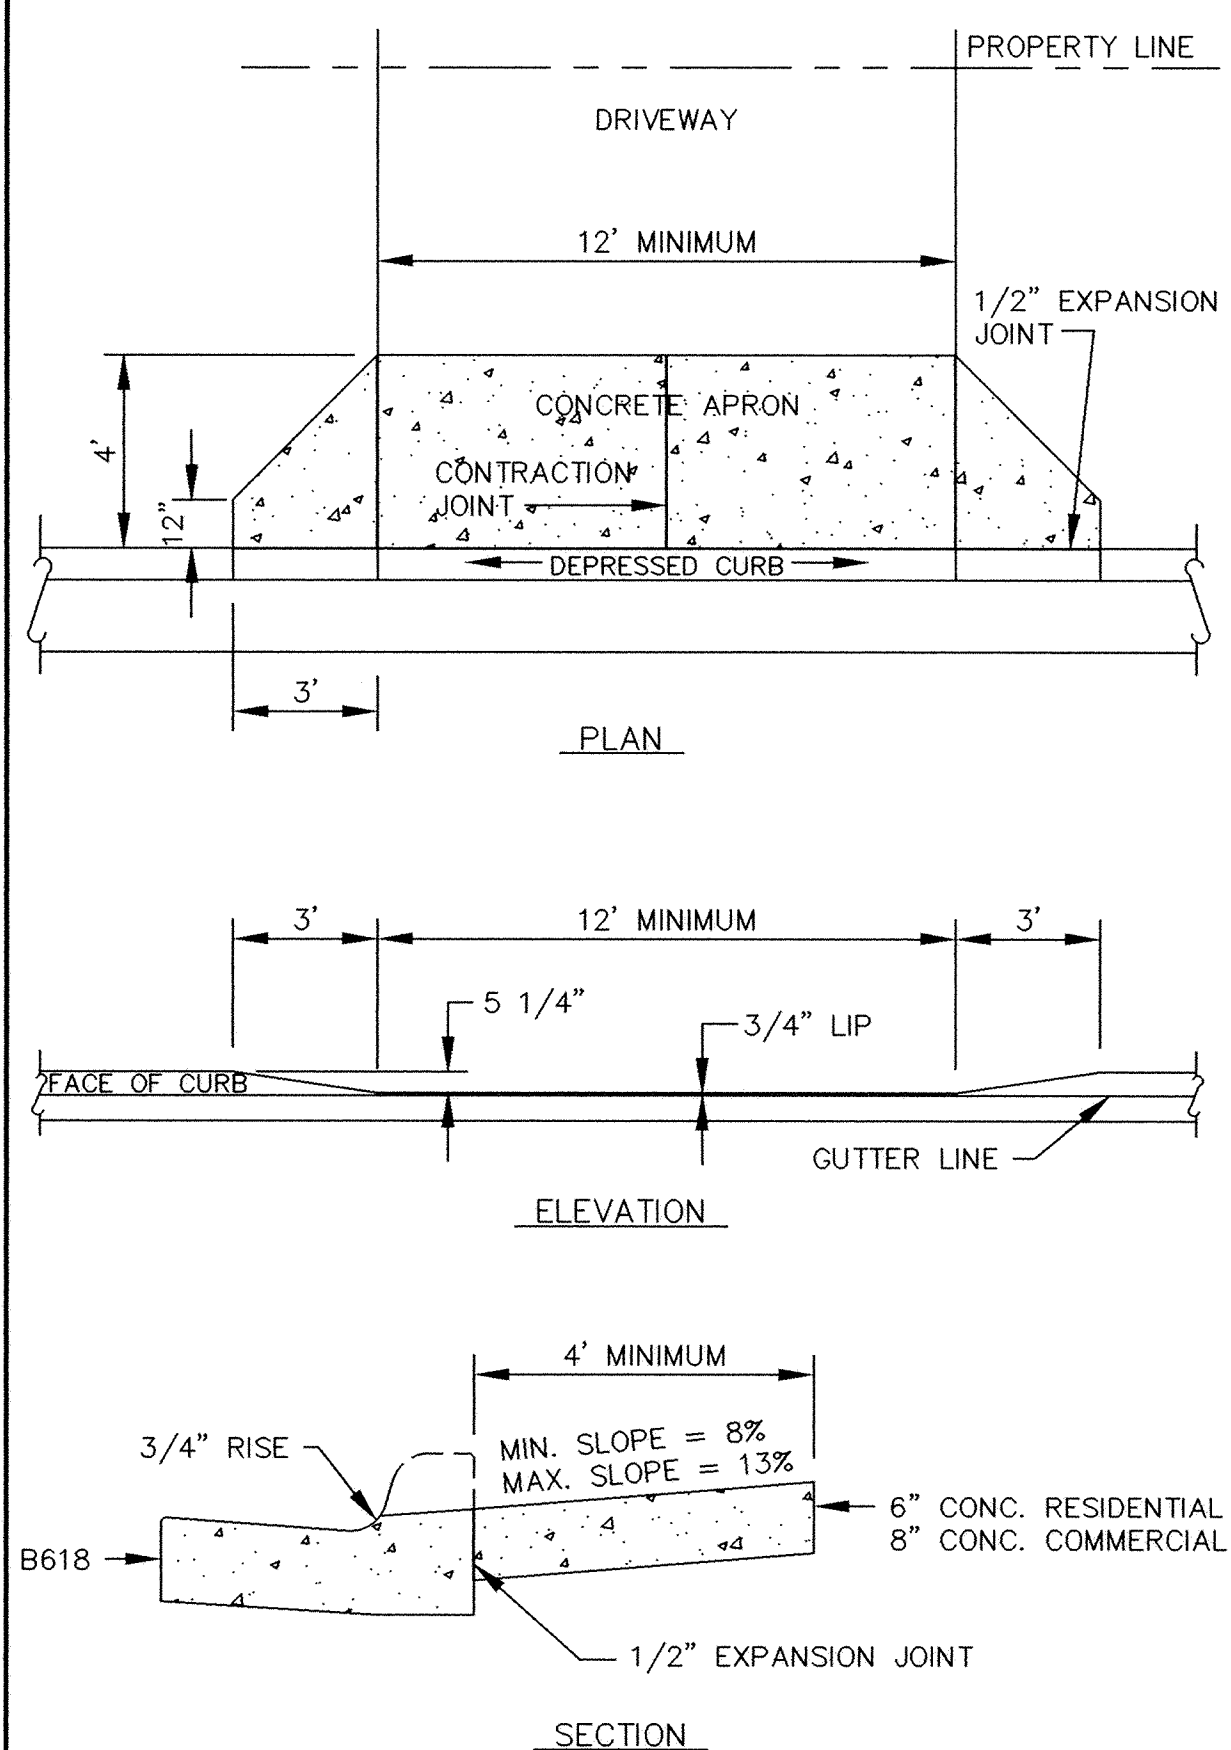


DEPRESSED CURB WITH DRIVEWAY APRON

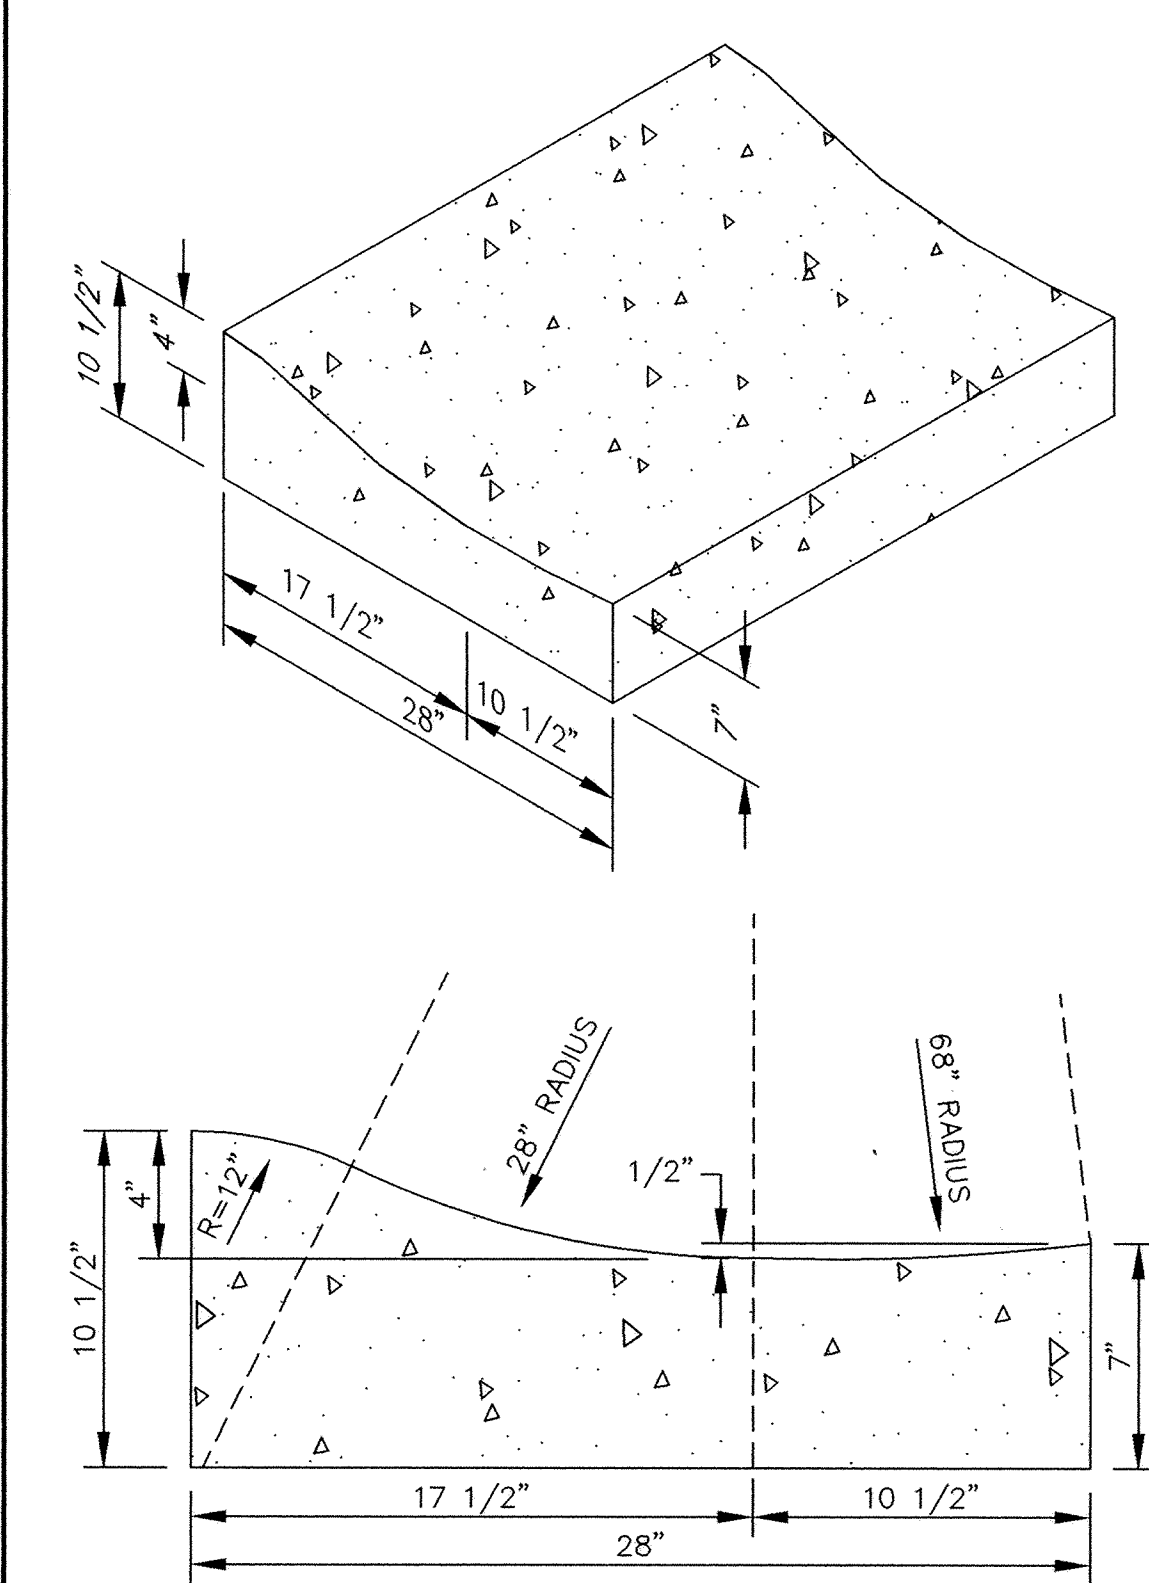


SURMOUNTABLE CONCRETE CURB AND GUTTER

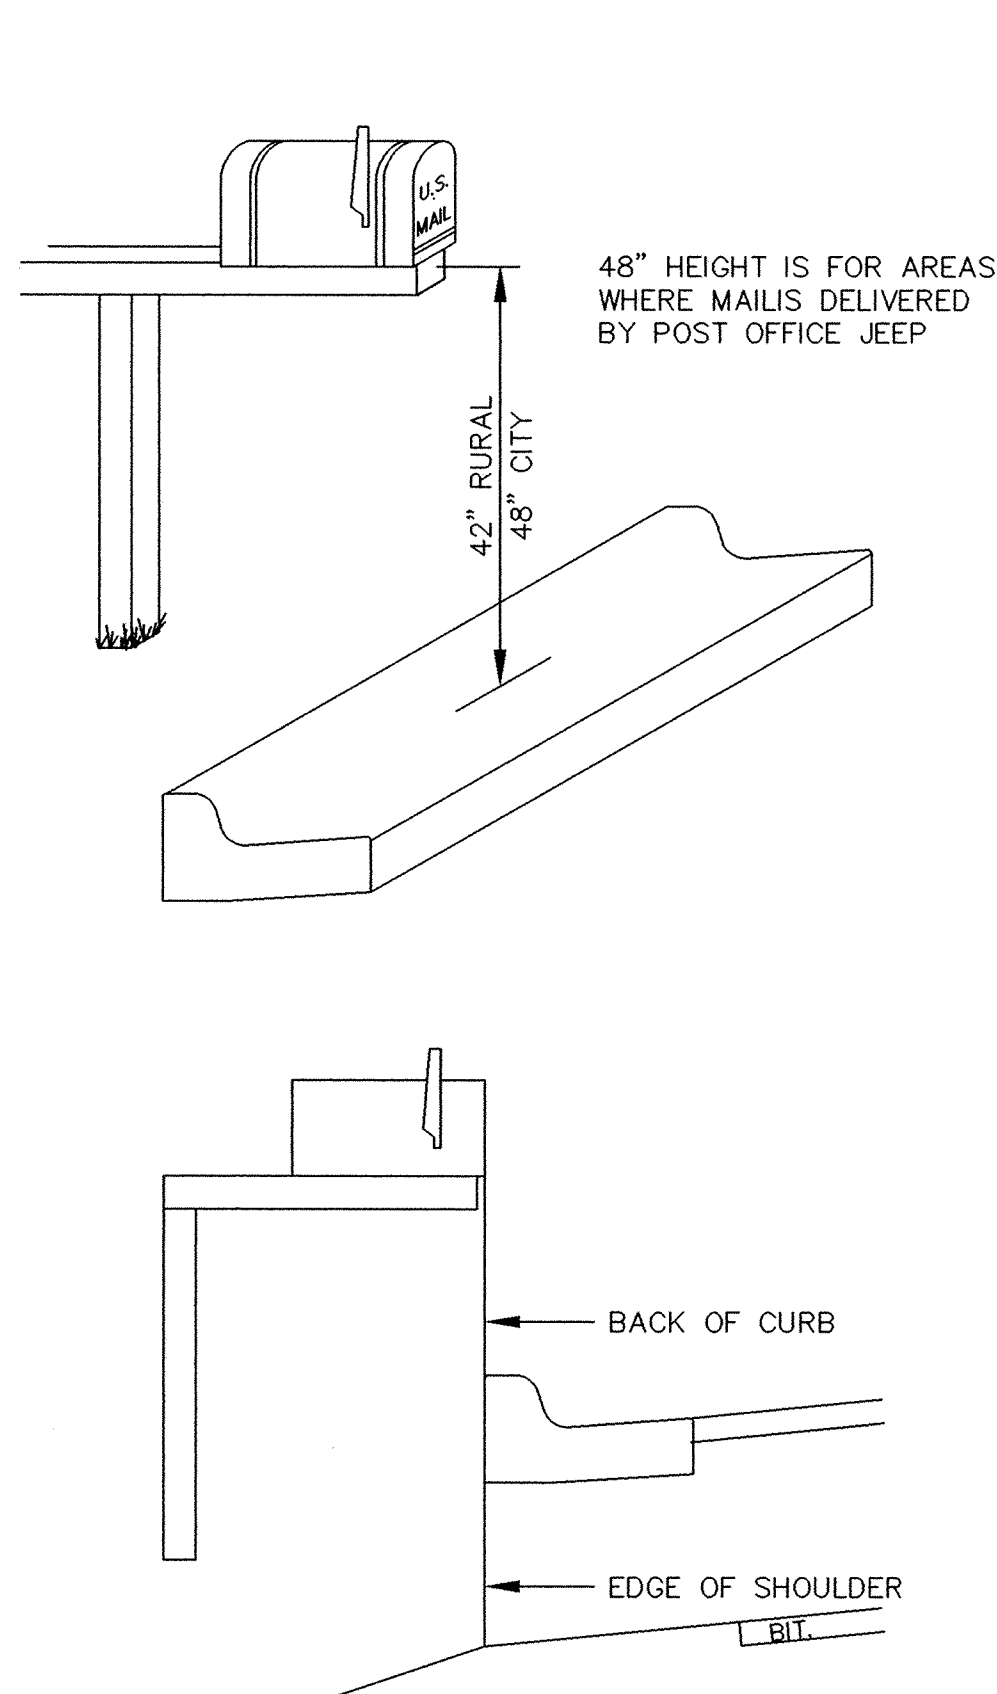


MAIL BOX

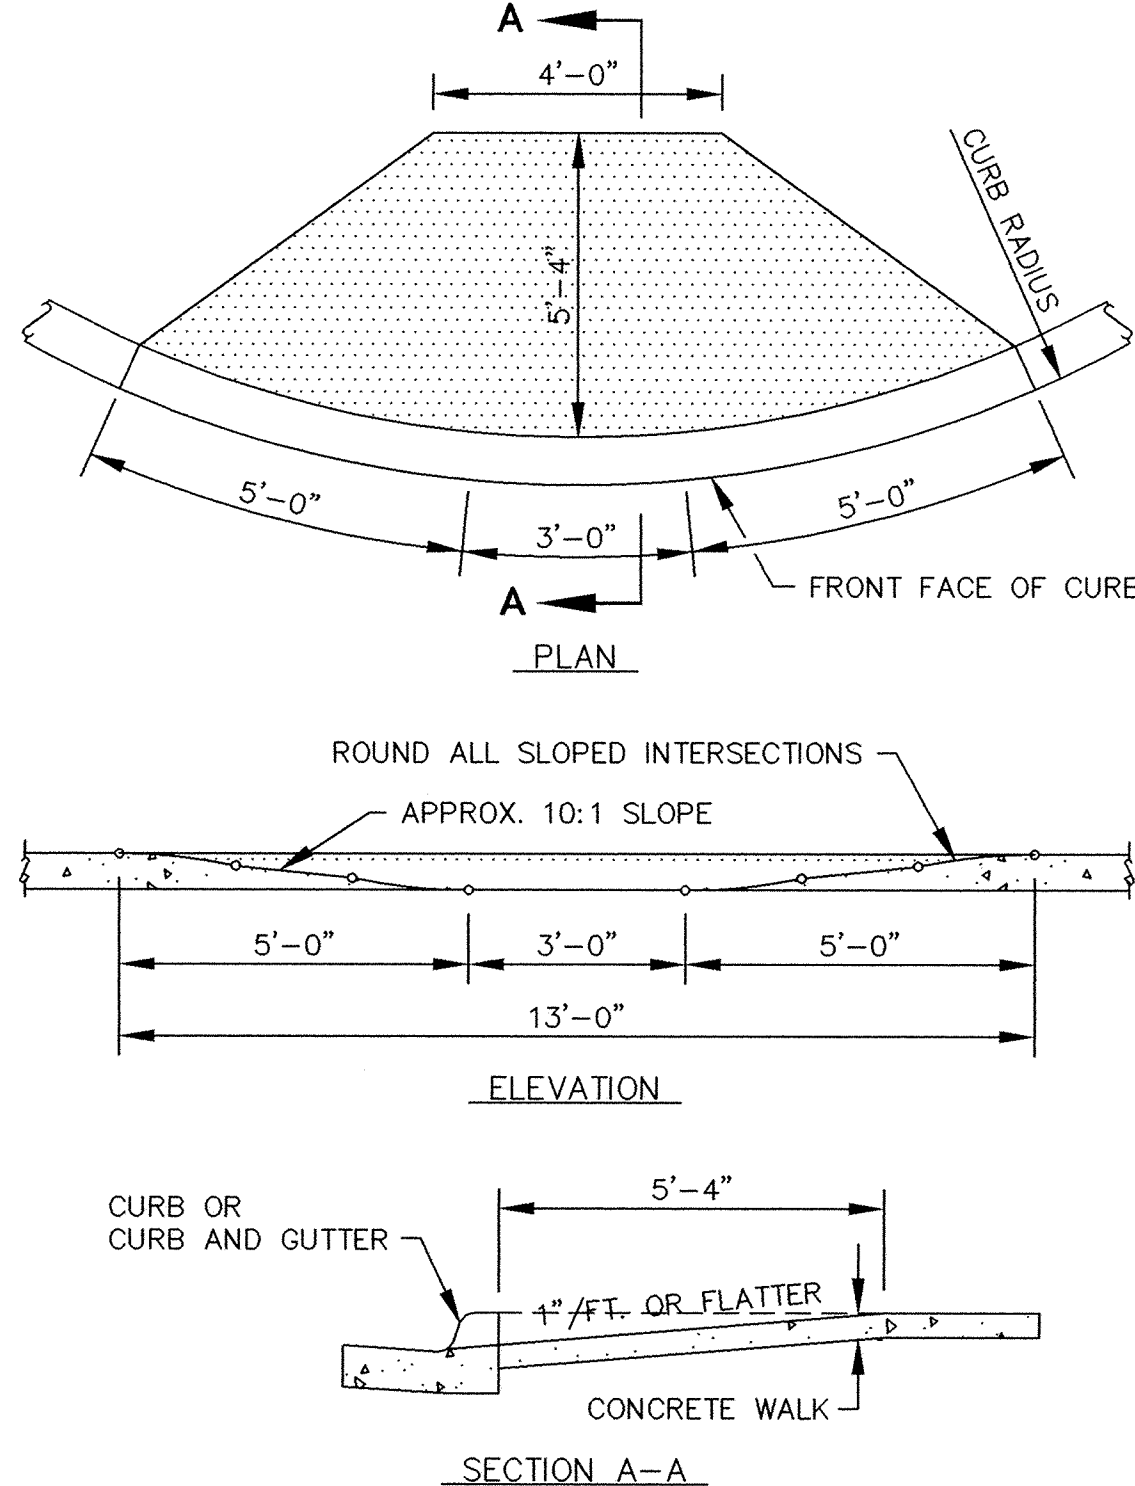


PEDESTRIAN CURB RAMPS

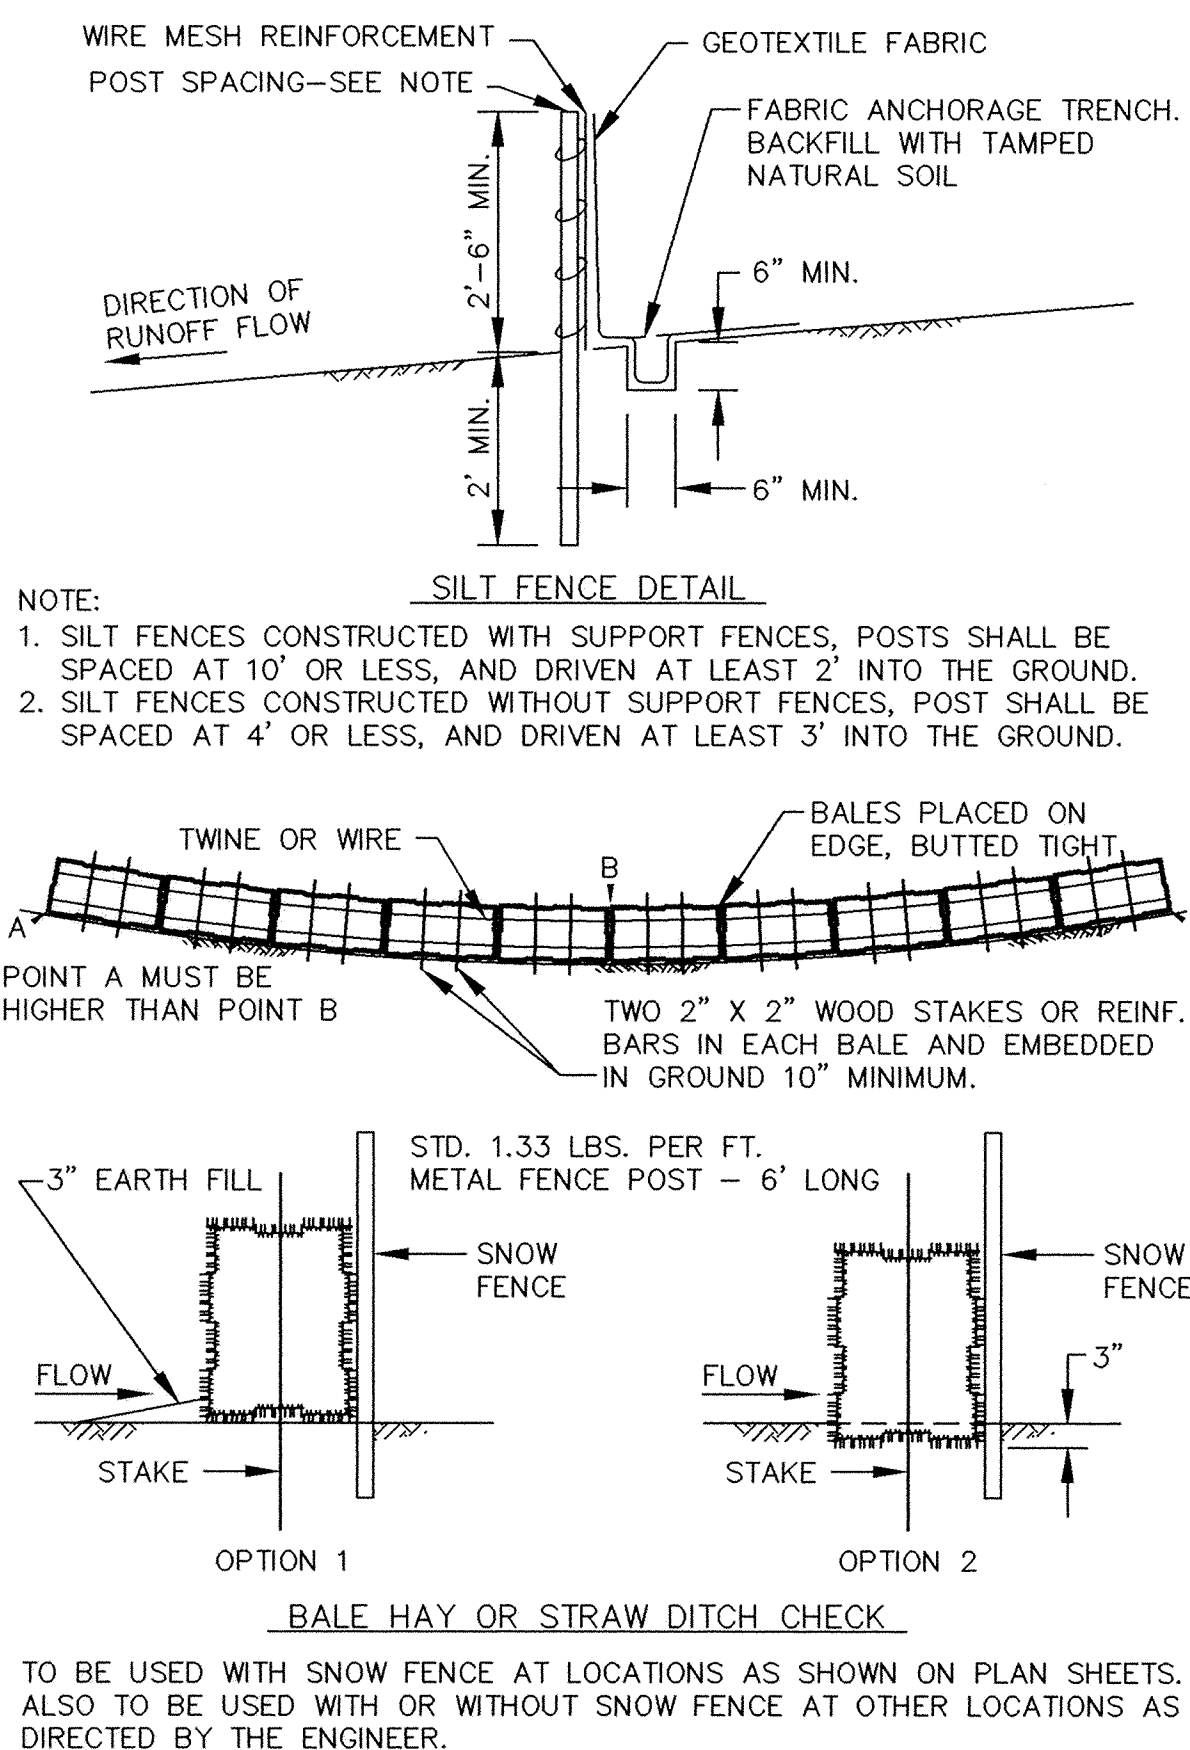


EROSION CONTROL DETAIL

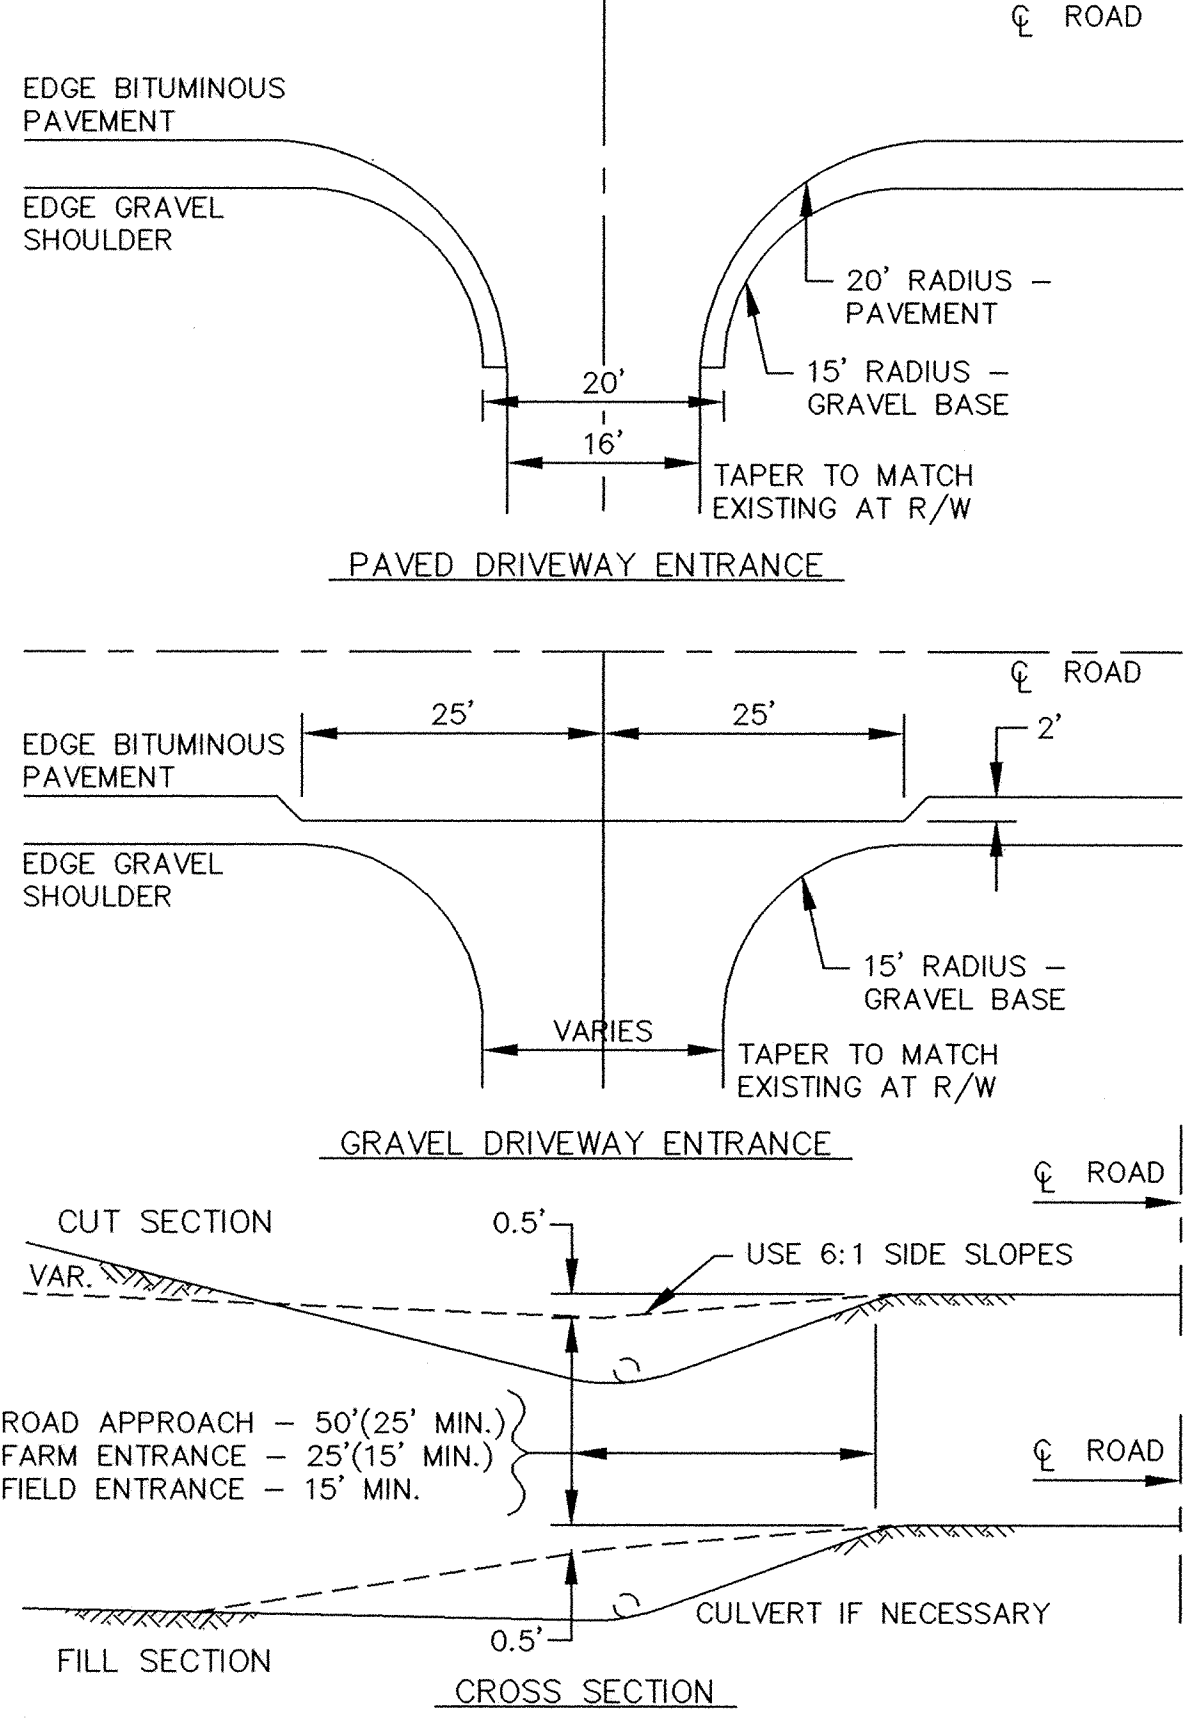

RURAL DRIVEWAY ENTRANCE

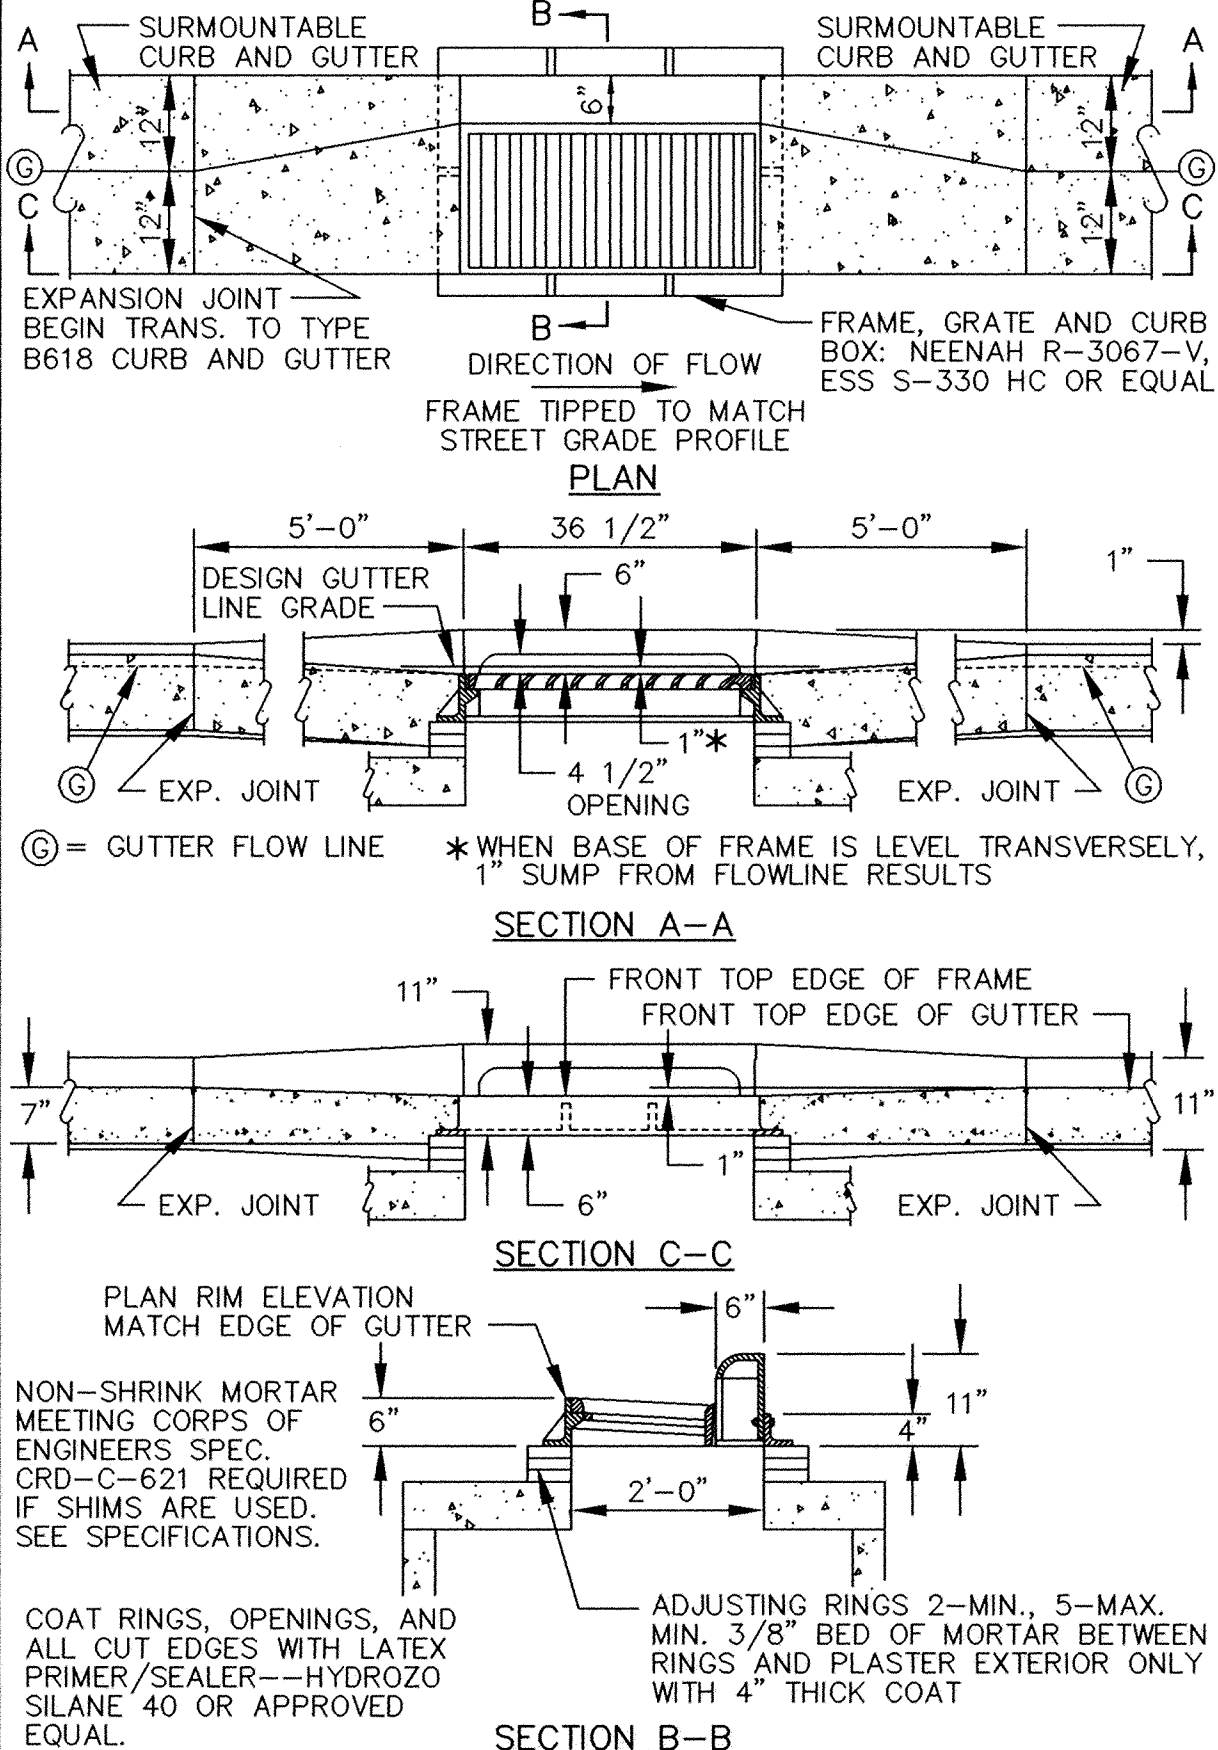

CATCH BASIN FRAME PLACEMENT
SURMOUNTABLE CURB AND GUTTER

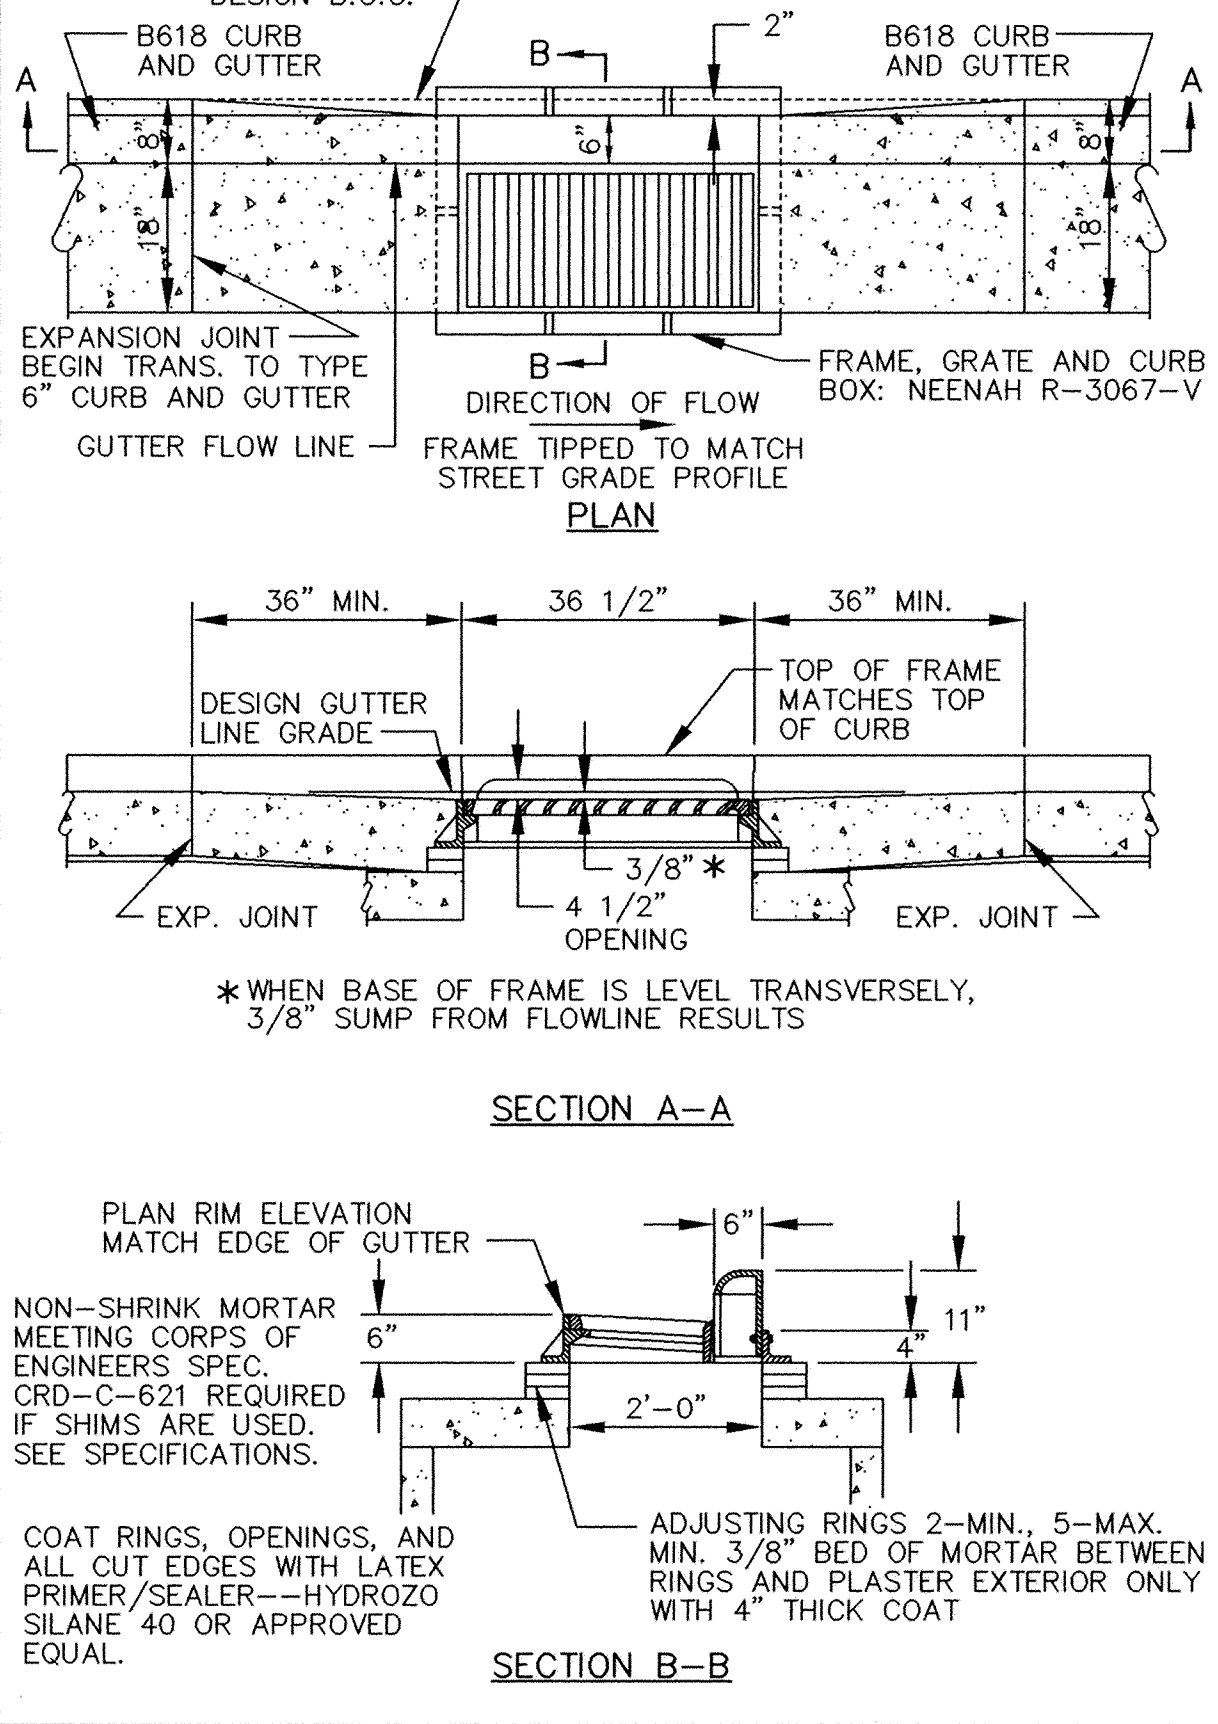

CATCH BASIN FRAME PLACEMENT
B618 CURB AND GUTTER

I HEREBY CERTIFY THAT THIS PLAN, SPECIFICATION, OR REPORT WAS PREPARED BY ME OR UNDER MY DIRECT SUPERVISION AND THAT I AM A DULY REGISTERED PROFESSIONAL ENGINEER UNDER THE LAWS OF THE STATE OF MINNESOTA.

MSA
CONSULTING ENGINEERS

1326 ENERGY PARK DRIVE
ST. PAUL, MINNESOTA 55108
(612) 644-4389

9800 SHELARD PARKWAY
MINNEAPOLIS, MINNESOTA 55441
(612) 546-0432

DATE	DESCRIPTION	DESIGNED	CHECKED

GRAPHIC SCALE
0 HORIZ. N/A
0 VERT. N/A

DATE	JUNE 1994
SHEET	20 OF 20 SHEETS
PROJECT NO.	230-194