
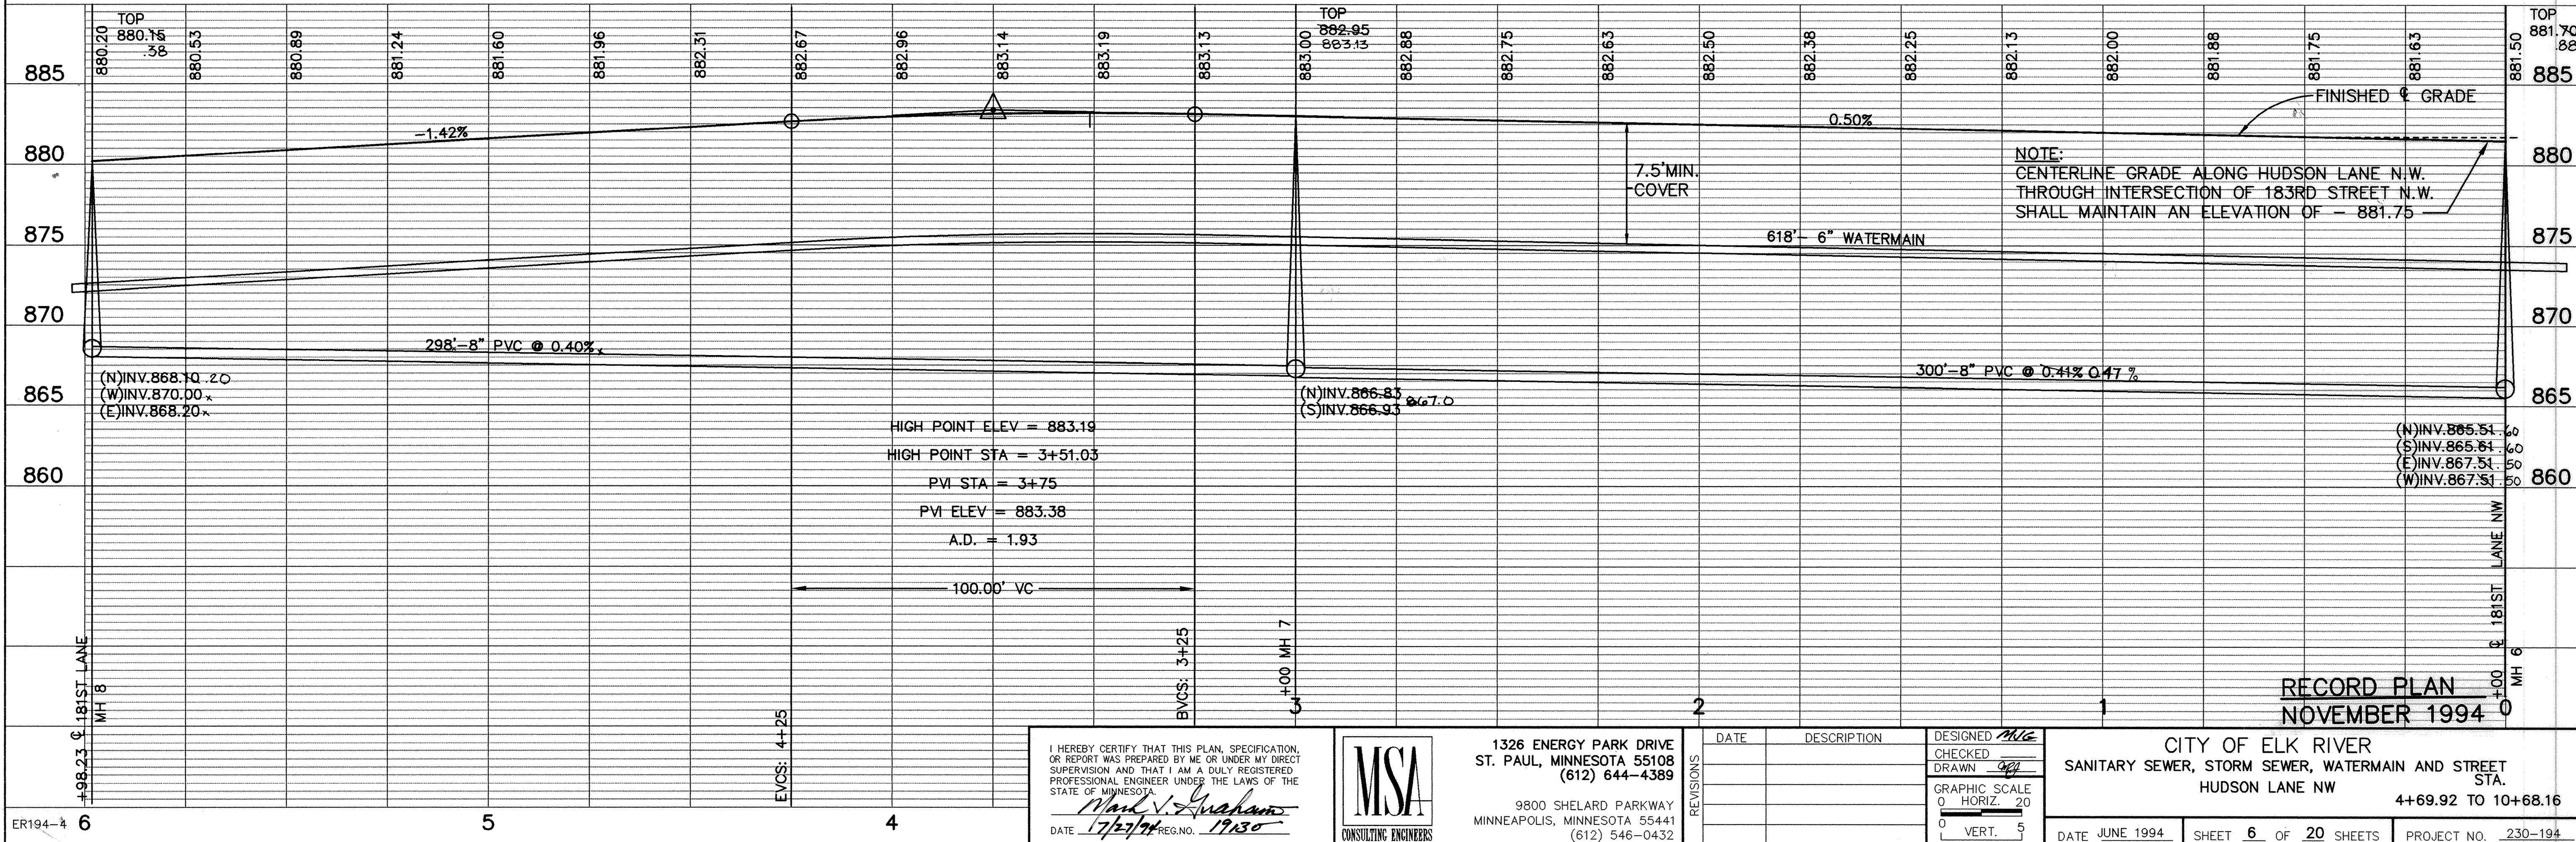


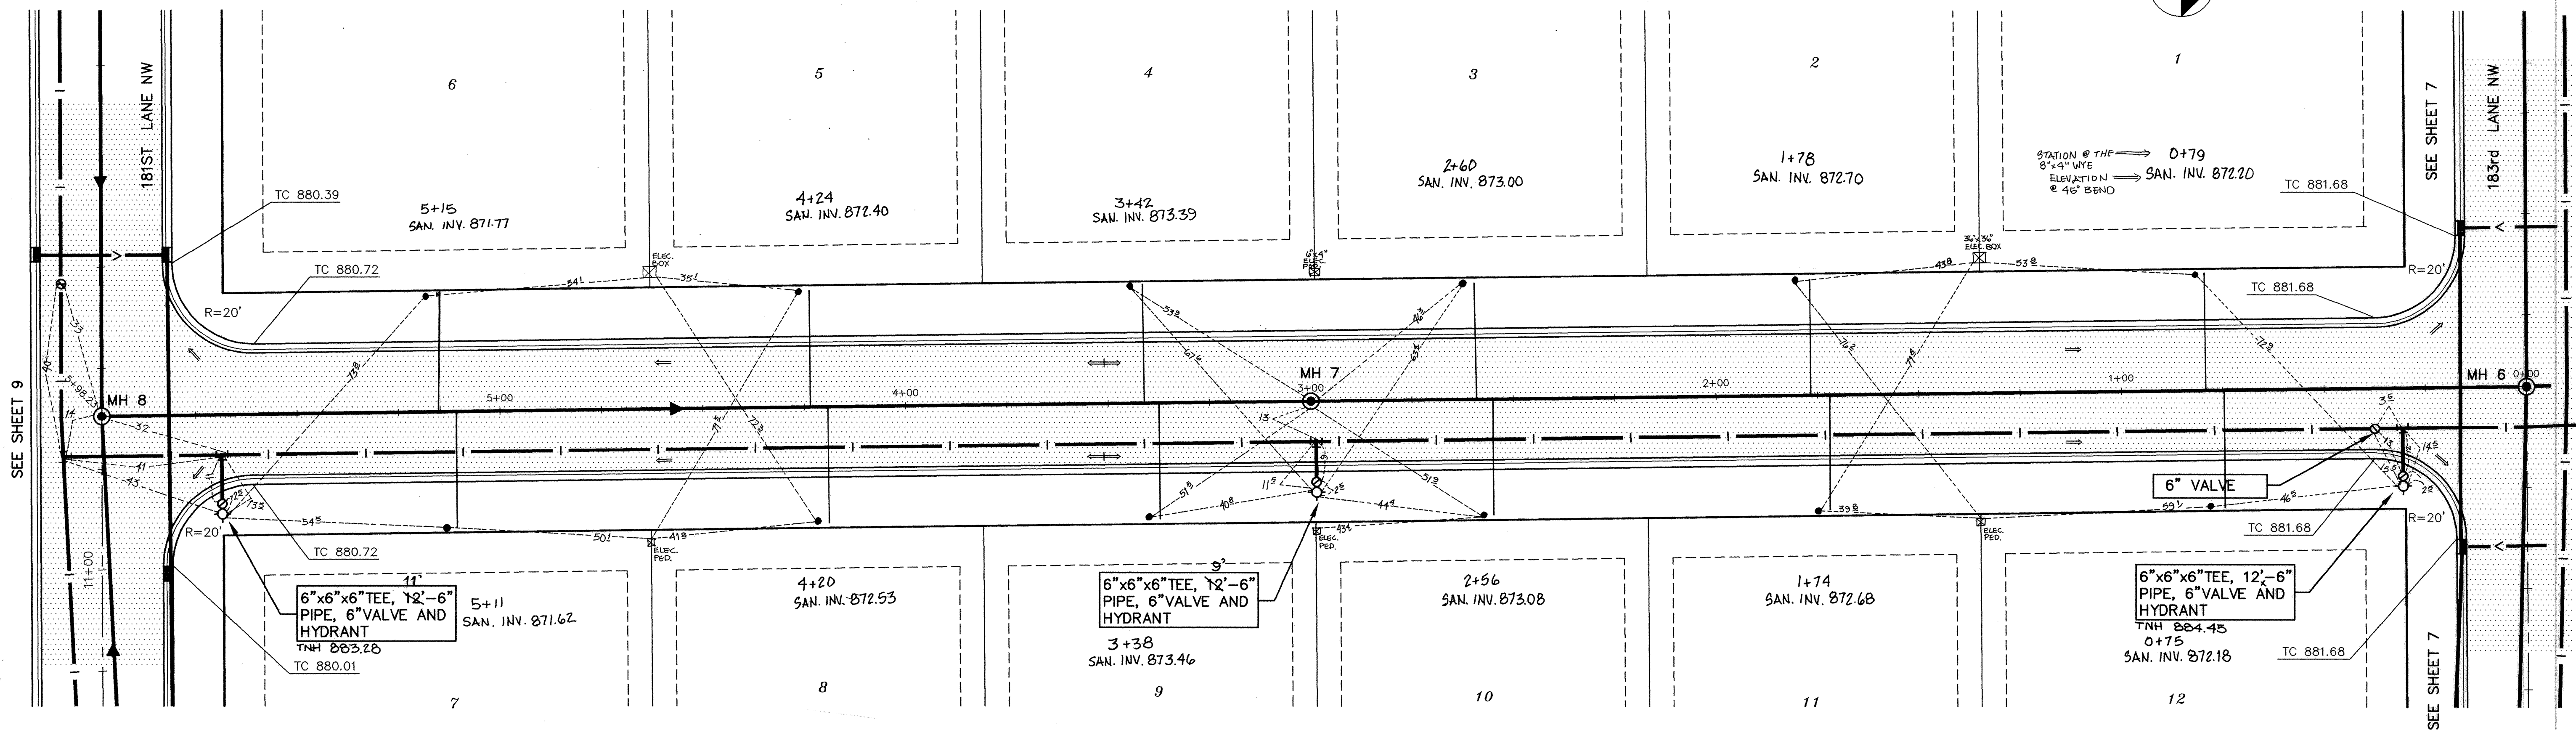

Wed Jul 27 19:07:35 1994