



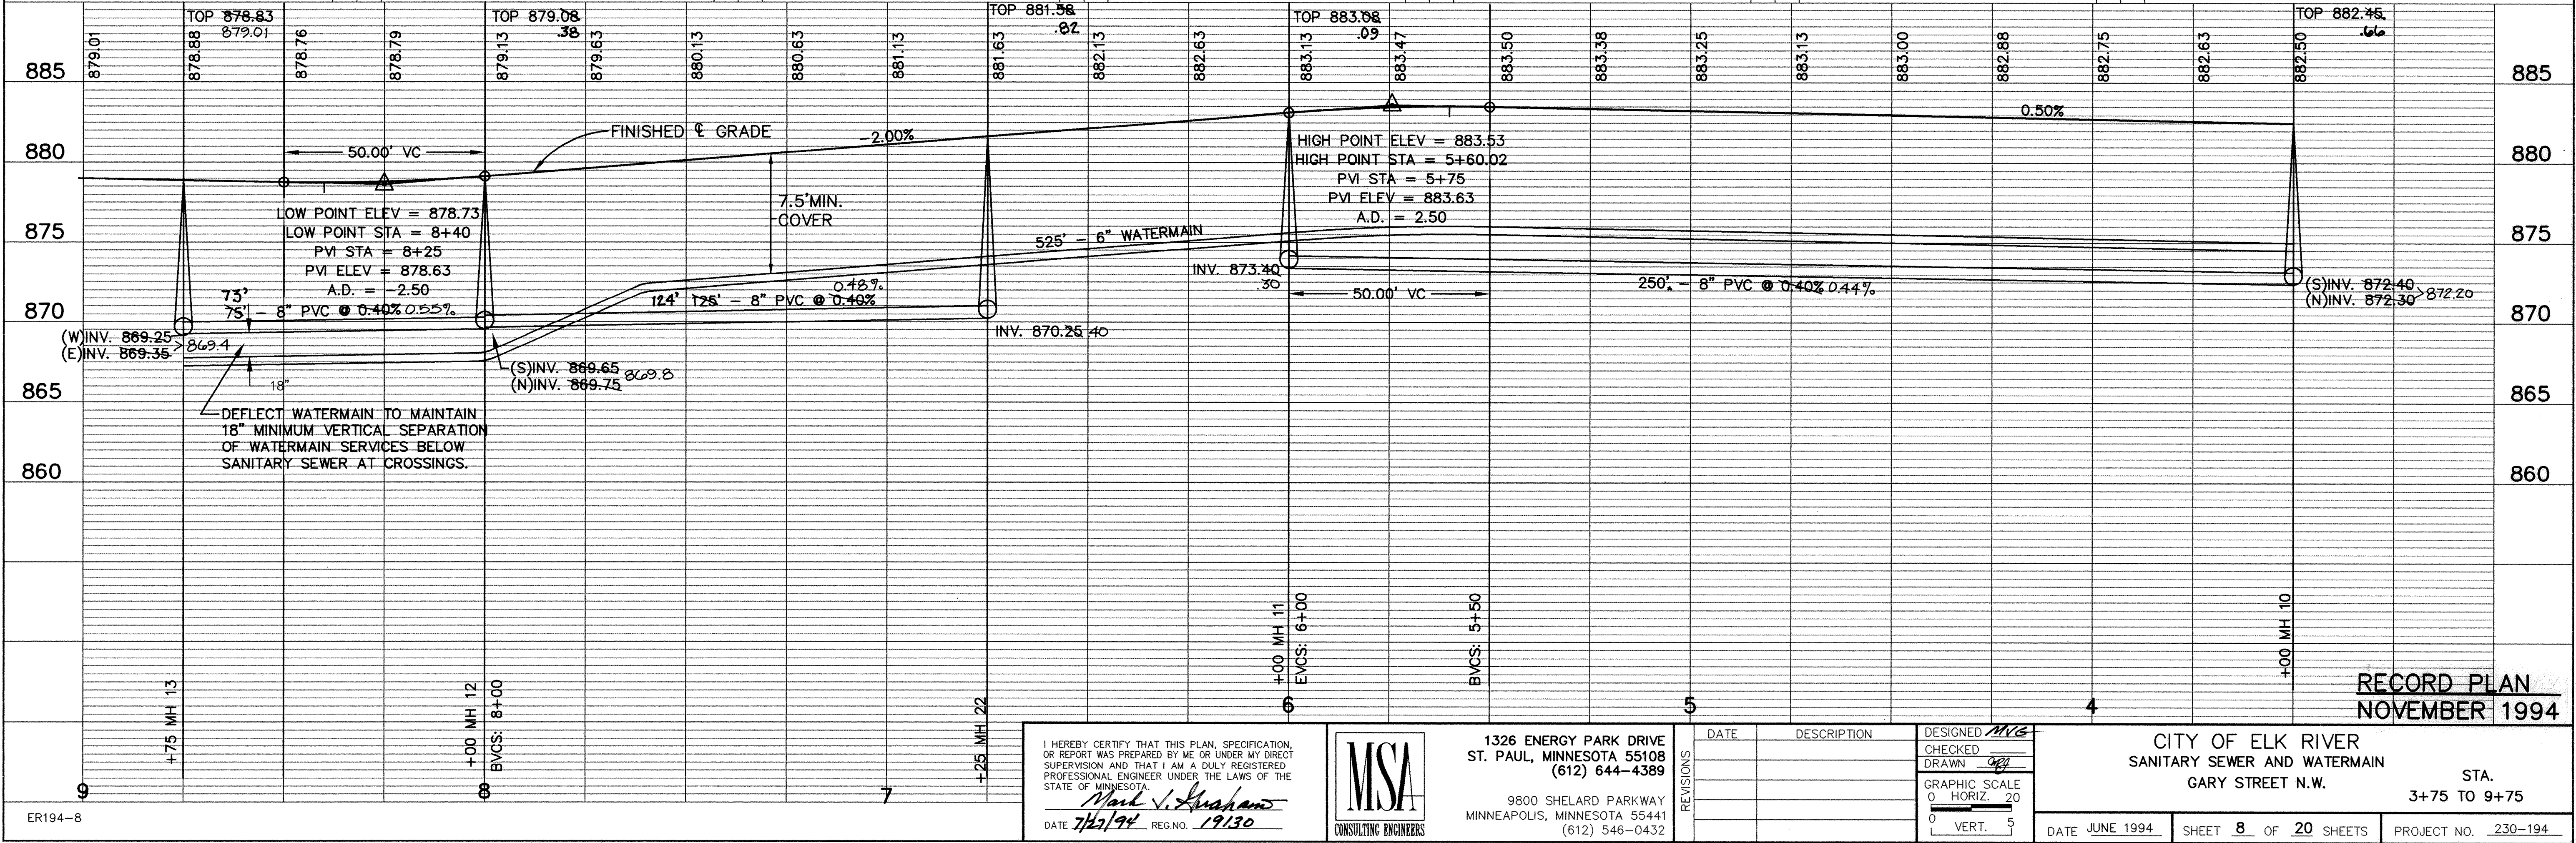

I HEREBY CERTIFY THAT THIS PLAN, SPECIFICATION, OR REPORT WAS PREPARED BY ME OR UNDER MY DIRECT SUPERVISION AND THAT I AM A DULY REGISTERED PROFESSIONAL ENGINEER UNDER THE LAWS OF THE STATE OF MINNESOTA.

Mark V. Graham
DATE 7/22/94 REG. NO. 19130

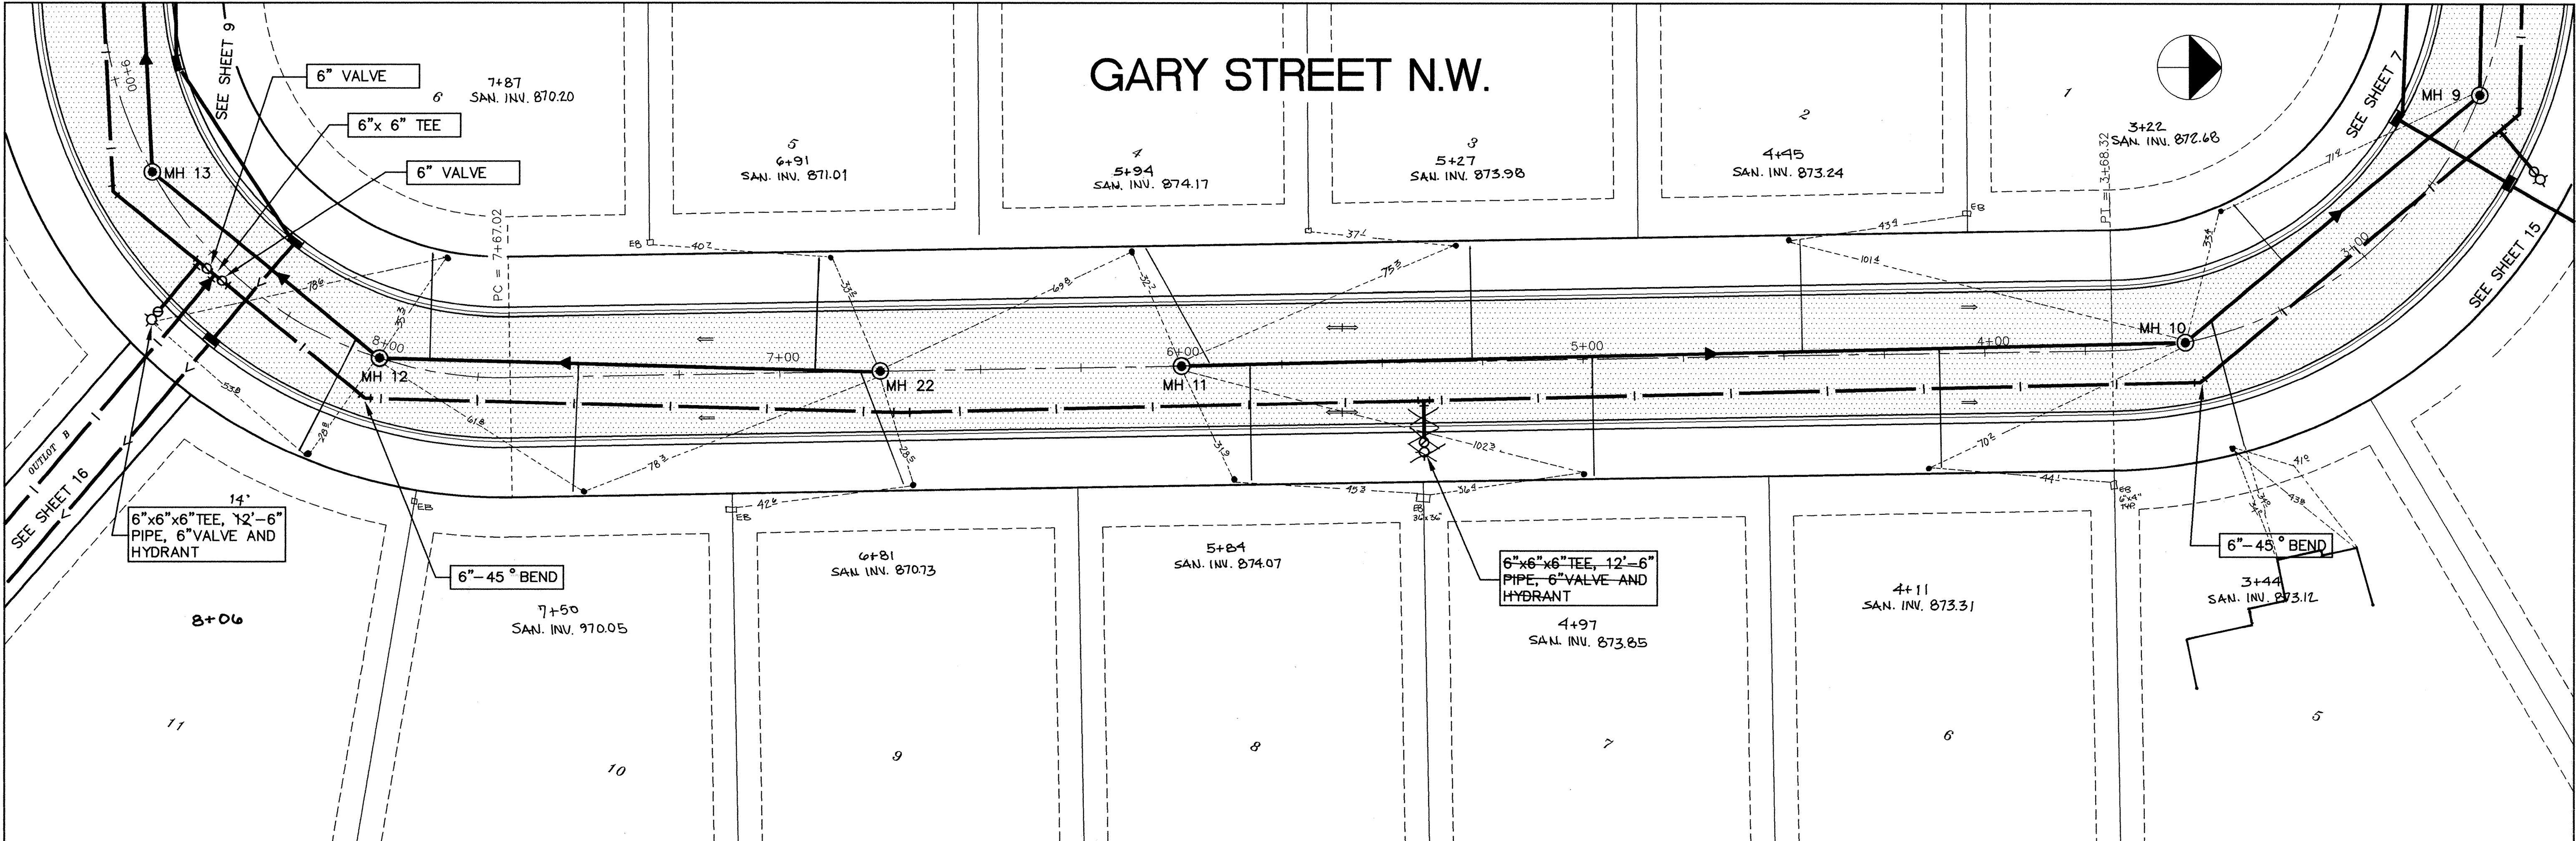

1326 ENERGY PARK DRIVE
ST. PAUL, MINNESOTA 55108
(612) 644-4389

9800 SHELARD PARKWAY
MINNEAPOLIS, MINNESOTA 55441
(612) 546-0432

REVISIONS	DATE	DESCRIPTION

DESIGNED <i>MVG</i>
CHECKED <i>gry</i>
DRAWN <i>gry</i>
GRAPHIC SCALE 0' HORIZ. 20'
0' VERT. 5'

CITY OF ELK RIVER SANITARY SEWER AND WATERMAIN GARY STREET N.W.		STA. 3+75 TO 9+75
DATE JUNE 1994	SHEET 8 OF 20 SHEETS	PROJECT NO. 230-194