

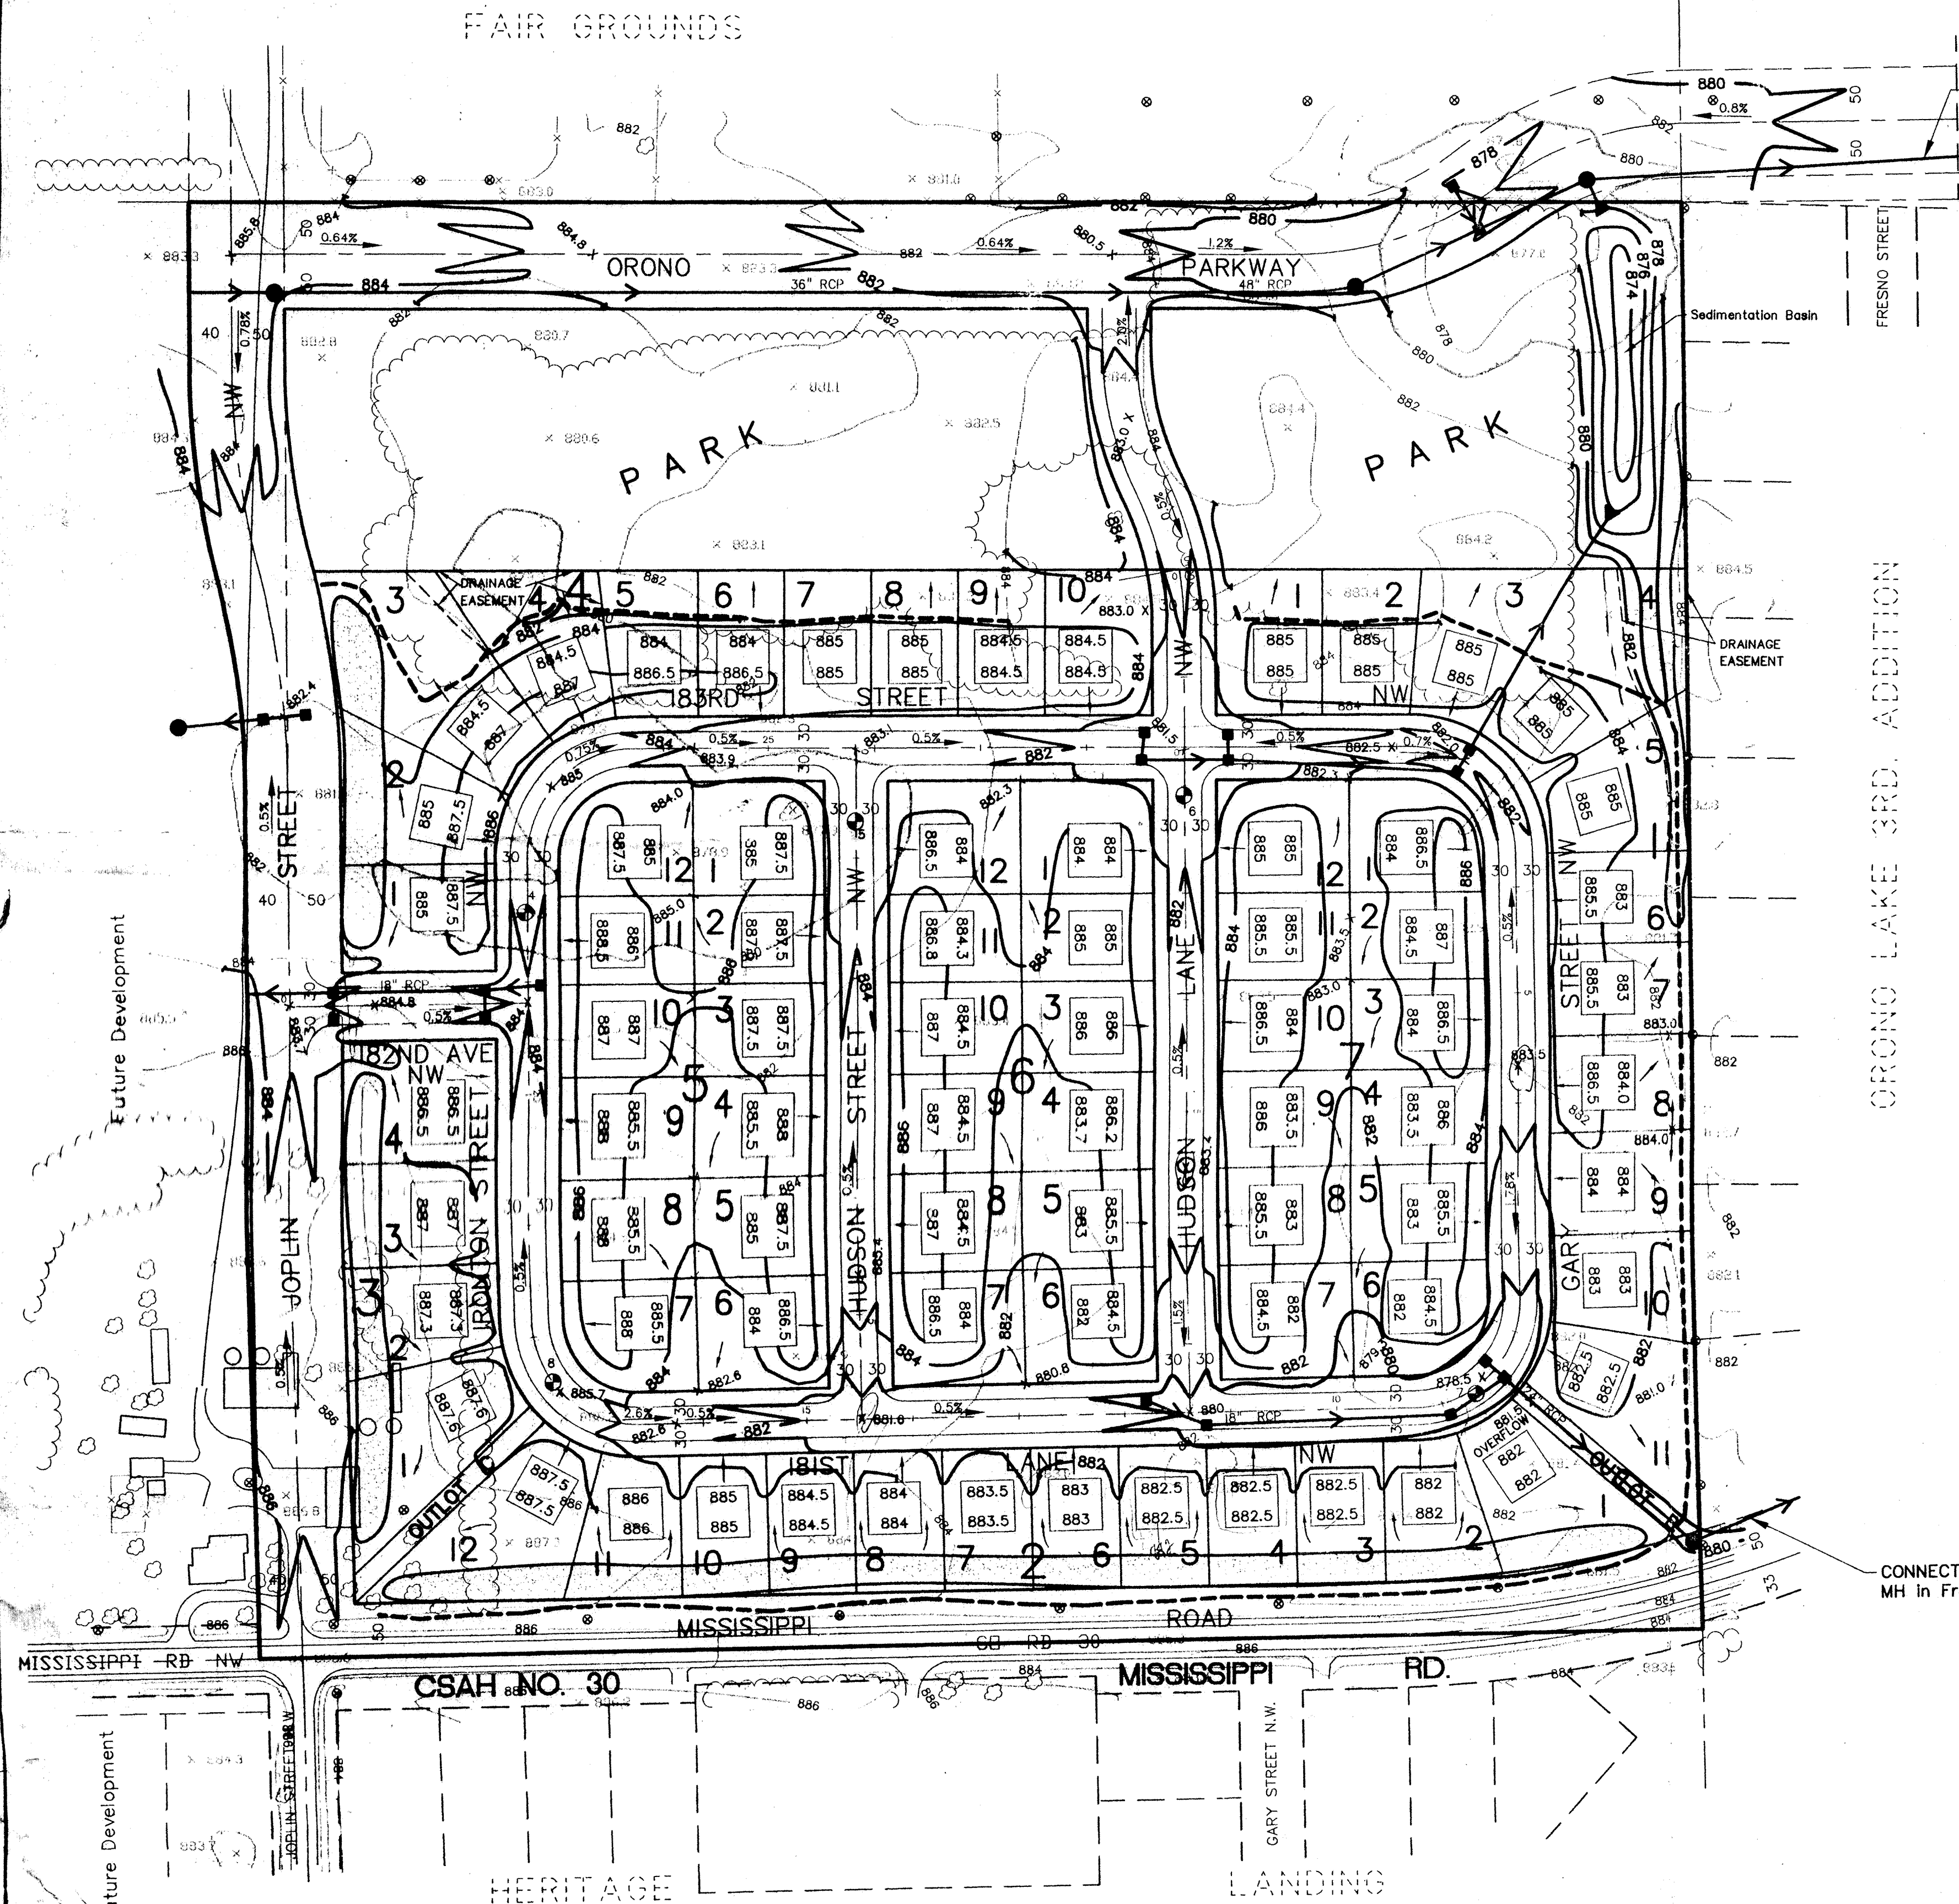


GOSPODORS ORONO LAKE ADD.

FAIR GROUNDS

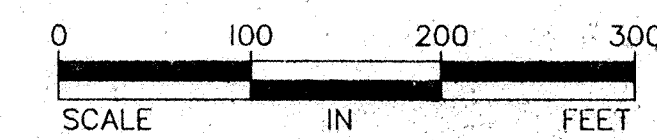


CONNECT TO EXISTING
88" RCPA storm sewer.

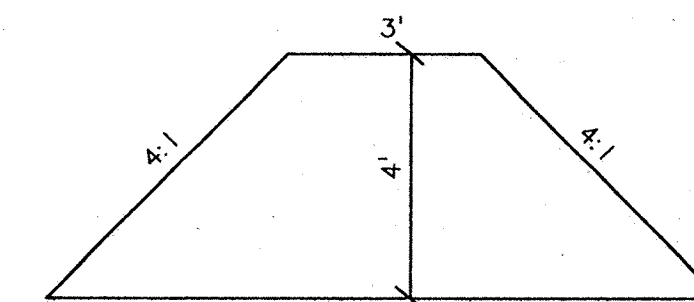

TYPICAL BERM DETAIL


LEGEND

- 882 Existing Contours
- 882 Proposed contours
- Silt fence
- 882 House Pad - grade Elev.
- Berm Area
- Proposed storm sewer (by others)
- 7 Proposed Soil Borings

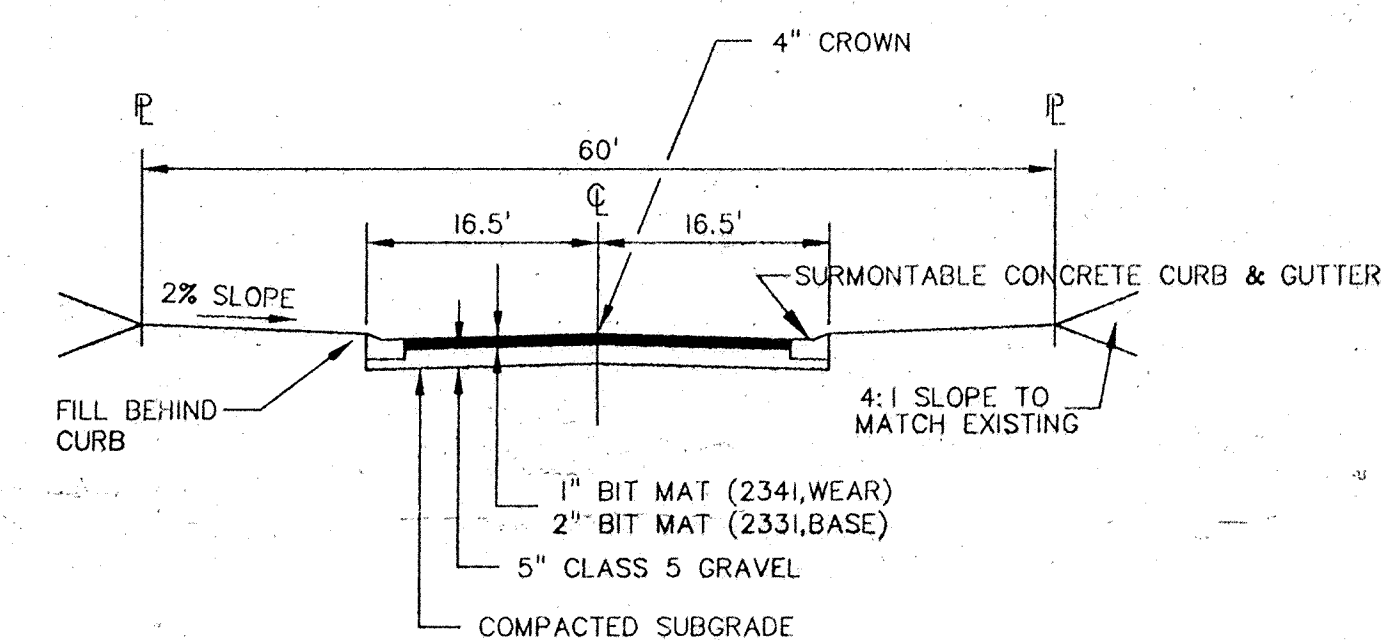

TYPICAL STREET SECTION

NOTE: Final storm sewer to be
Designed by others.

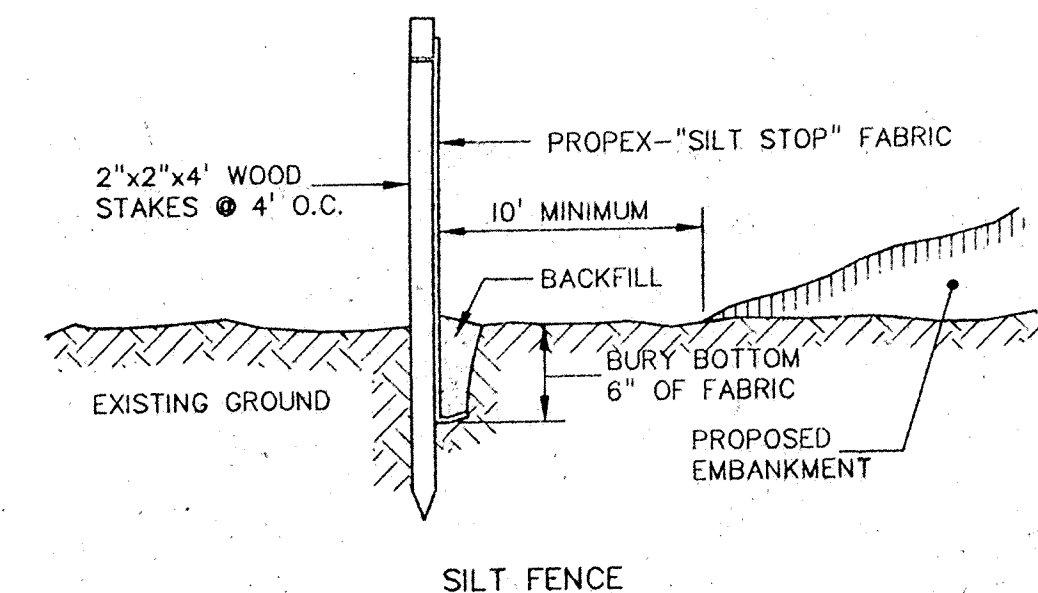

CONNECT TO EXISTING
MH in Fresno Street.

APPROVED
See MSA letter dated 6/15/94
(Not A DEVELOPMENT PLAN)

ORIGINAL DATE: 5/5/94 DESIGN BY: TS DRAWN BY: PG CHECKED BY: TLH Book/Page REVISIONS: 5/31/94 6/10/94	I HEREBY CERTIFY THAT THIS GRADING PLAN WAS PREPARED BY ME OR UNDER MY DIRECT SUPERVISION AND THAT I AM A DULY REGISTERED ENGINEER UNDER THE LAWS OF THE STATE OF MINNESOTA. SIGNED: <i>John Oliver</i> DATE: 5/5/94 LIC. NO. 12699	John Oliver & Associates, Inc. 680 Dodge Avenue Elk River, Minnesota (612) 441-2072 (FAX) 441-6886 Civil Engineering, Land Surveying, Land Planning	Grading, Drainage & Erosion Plan OF COUNTRY CROSSING CITY OF ELK RIVER SAP No. SHEET 1 OF 1 FILE NO. 8719.10
---	---	---	--