
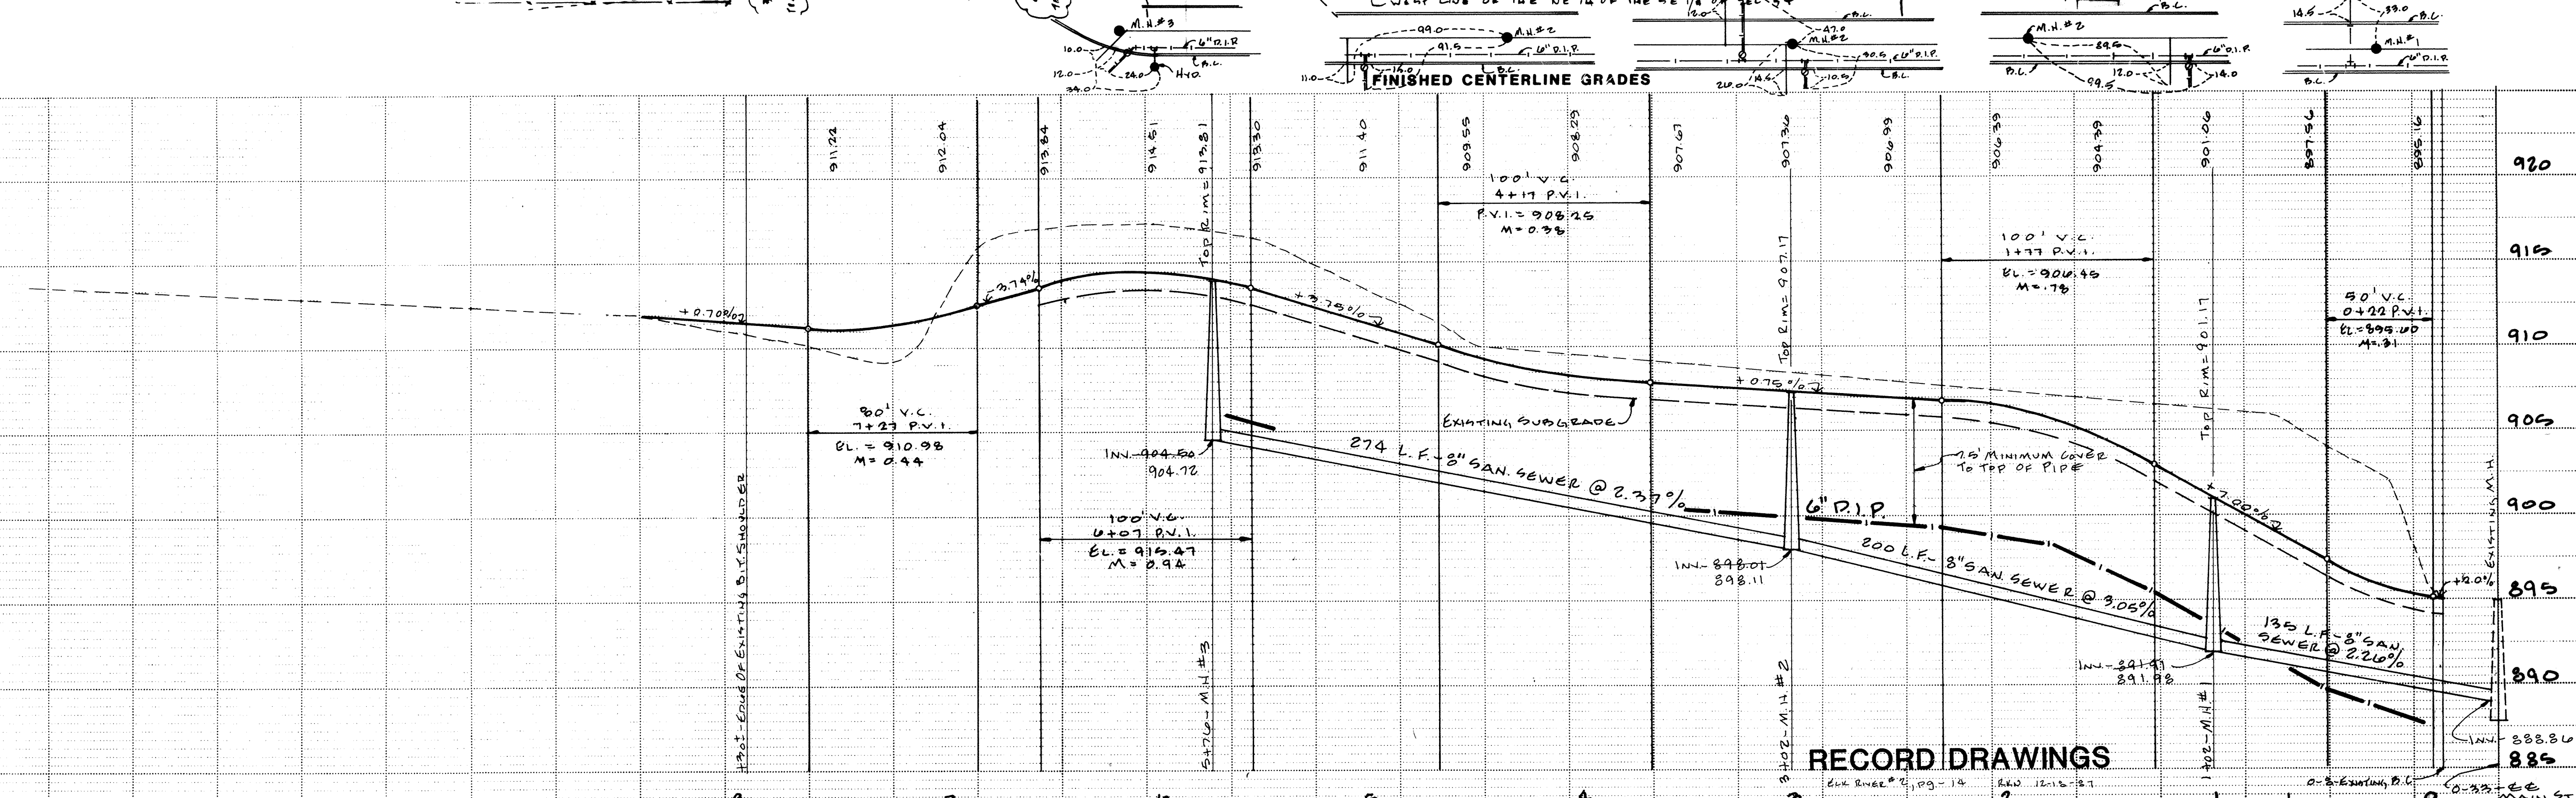


Fed. Proj. No.

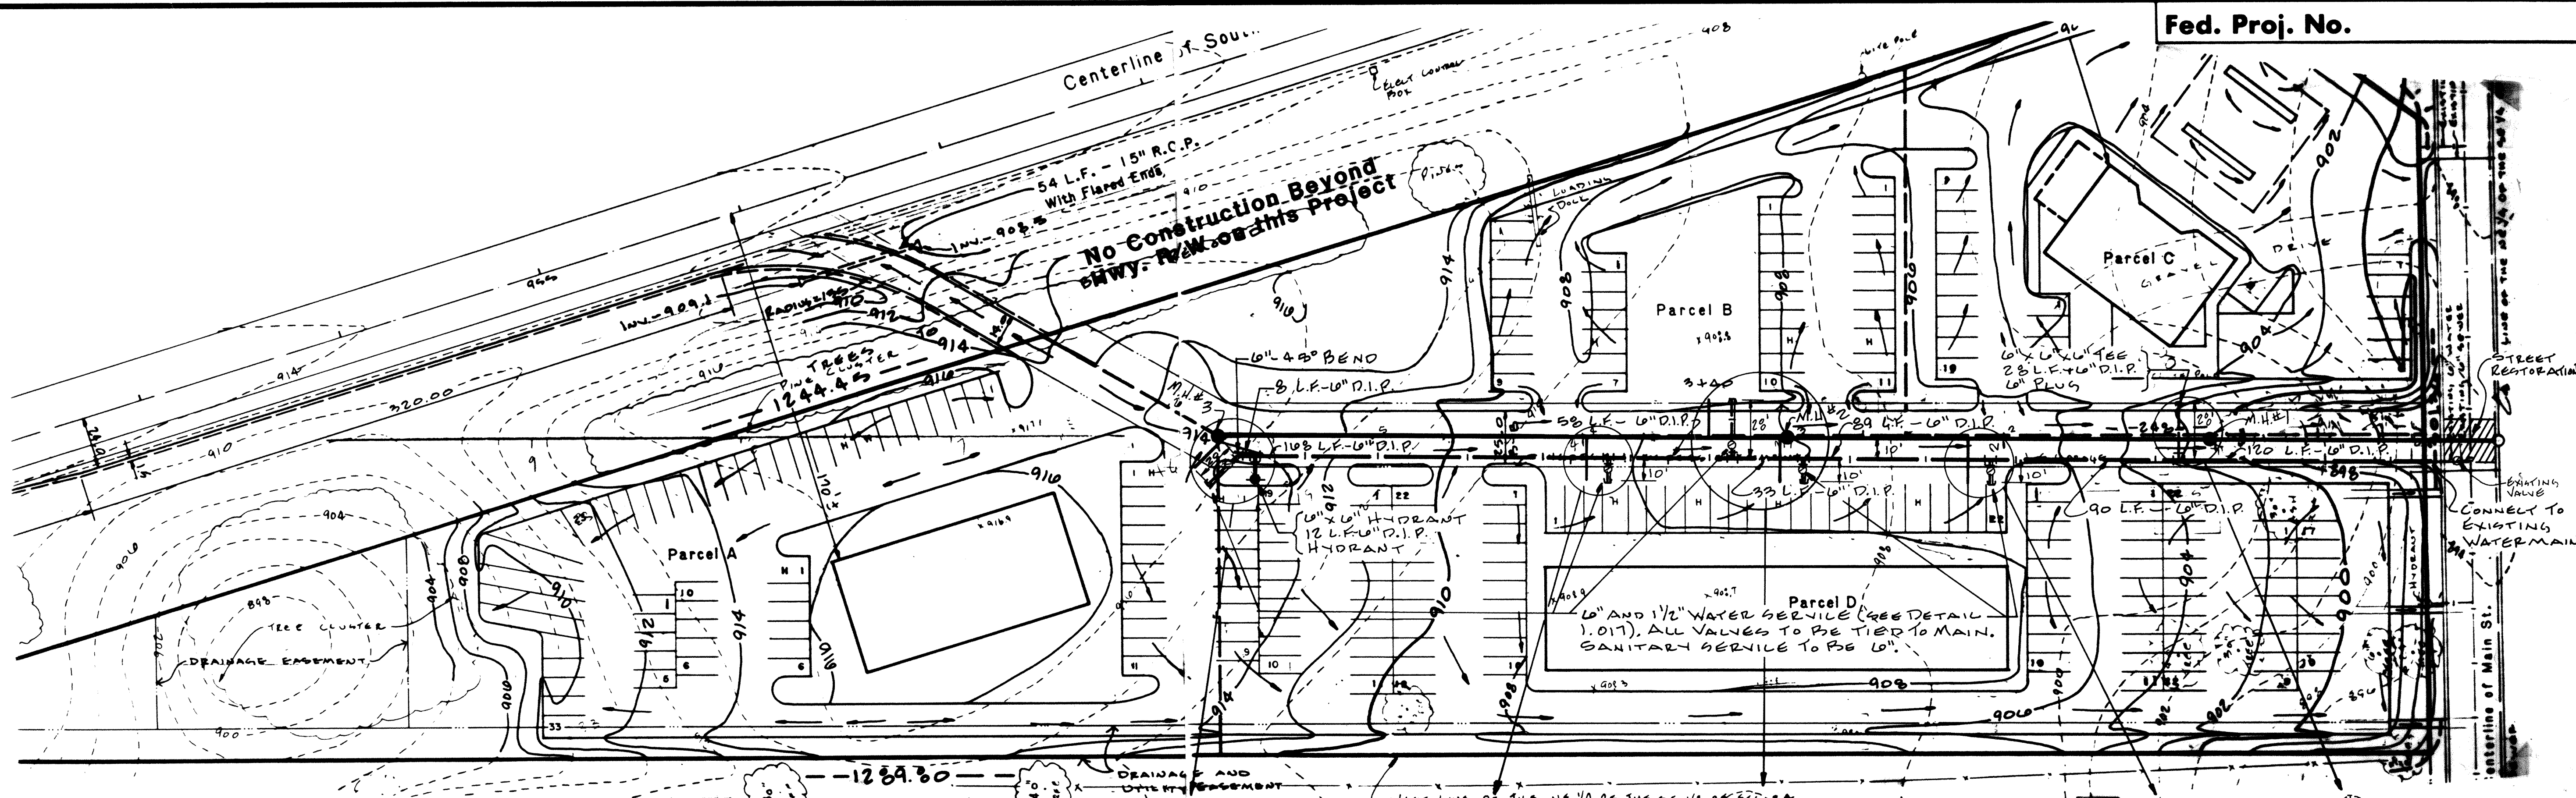

I hereby certify that this plan, specification, or report was prepared by me or under my direct supervision and that I am a duly Registered Professional Engineer under the laws of the State of Minnesota.

Date 8/28/87 Reg. No. 6218

| REVISIONS |             | 1987-2 UTILITIES IMPROVEMENT PROJECT |                    |
|-----------|-------------|--------------------------------------|--------------------|
| NO.       | DESCRIPTION | DATE                                 | BY                 |
| 1         | AS SHOWN    | 8/28/87                              | MEYER-ROHLIN, INC. |

|                    |                    |                    |                    |
|--------------------|--------------------|--------------------|--------------------|
| DESIGNED BY        | DRAWN BY           | CHECKED BY         | IN CHARGE          |
| MEYER-ROHLIN, INC. | MEYER-ROHLIN, INC. | MEYER-ROHLIN, INC. | MEYER-ROHLIN, INC. |

|                                      |  |                          |  |
|--------------------------------------|--|--------------------------|--|
| MEYER-ROHLIN, INC.                   |  | ENGINEERS-LAND SURVEYORS |  |
| 1111 HWY. 25N., BURLING, MINN. 55313 |  |                          |  |

|                 |  |                     |  |
|-----------------|--|---------------------|--|
| State Proj. No. |  | Sheet No. of Sheets |  |
|                 |  | 178                 |  |