
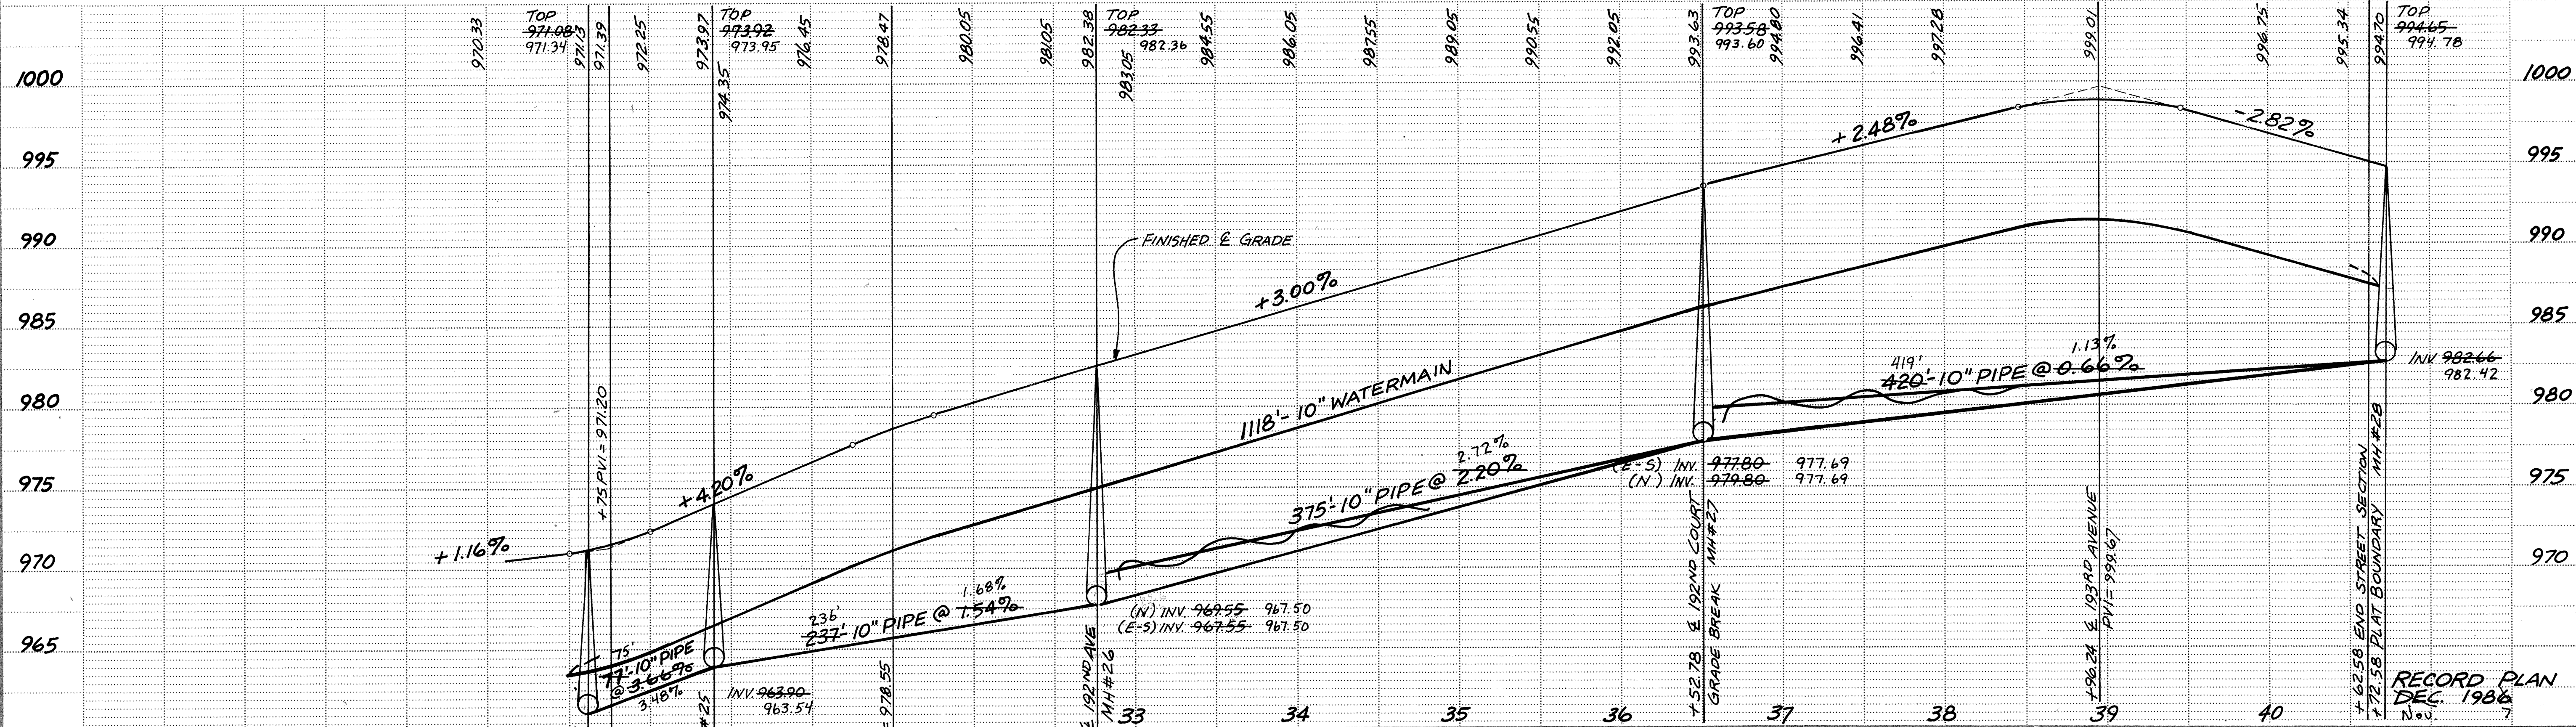


VANCE STREET

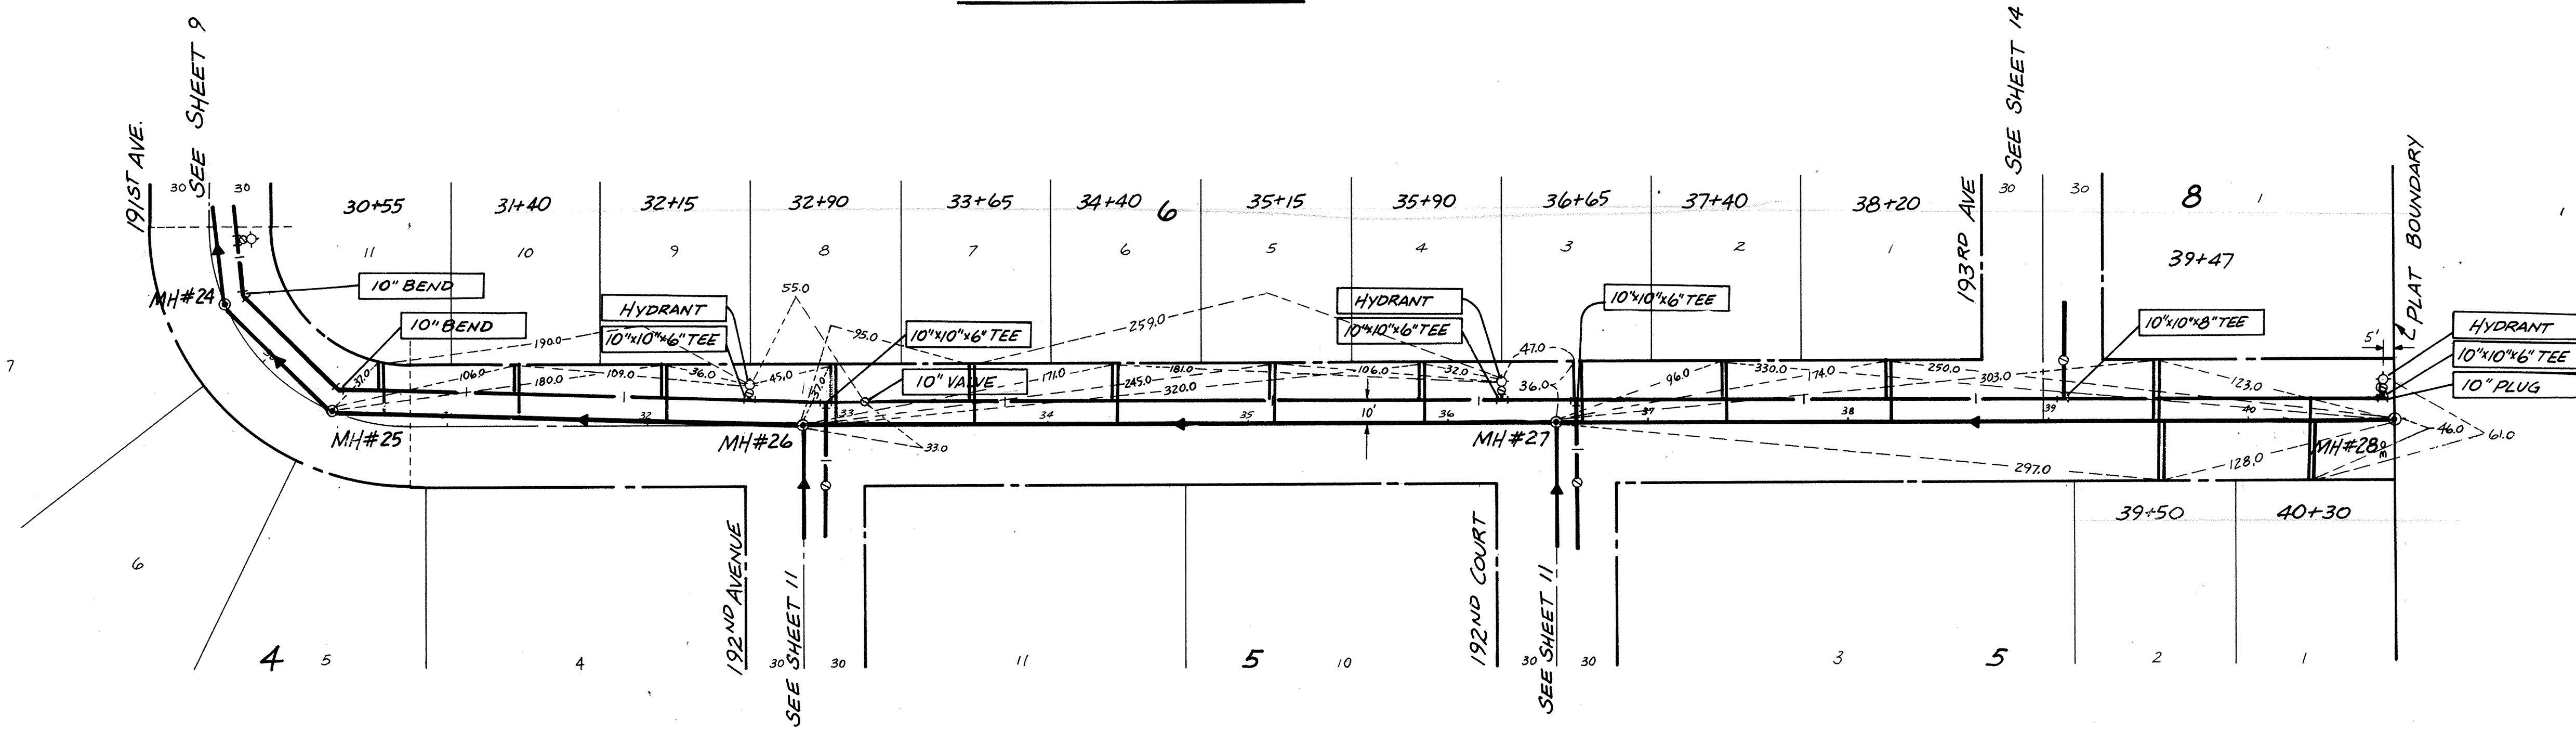

CONSULTING ENGINEERS
Maier Stewart & Associates Inc.
480 CEDAR STREET (612) 227-9475 ST. PAUL, MINNESOTA 55101

DATE	DESCRIPTION	DESIGNED
8/26/86	PROFILE	CHECKED
		DRAWN MJI
		GRAPHIC SCALE
		0' HORIZ. 50'
		0' VERT. 5'

CITY OF ELK RIVER
DEERFIELD 3RD ADDITION
SANITARY SEWER AND WATERMAIN
VANCE STREET

DATE MAY 1986 SHEET 10 OF 31 SHEETS PROJECT NO. 230-020

DRAWING NUMBER

DRAWING NUMBER

DRAWING NUMBER

DRAWING NUMBER
DEERFIELD 38
10