
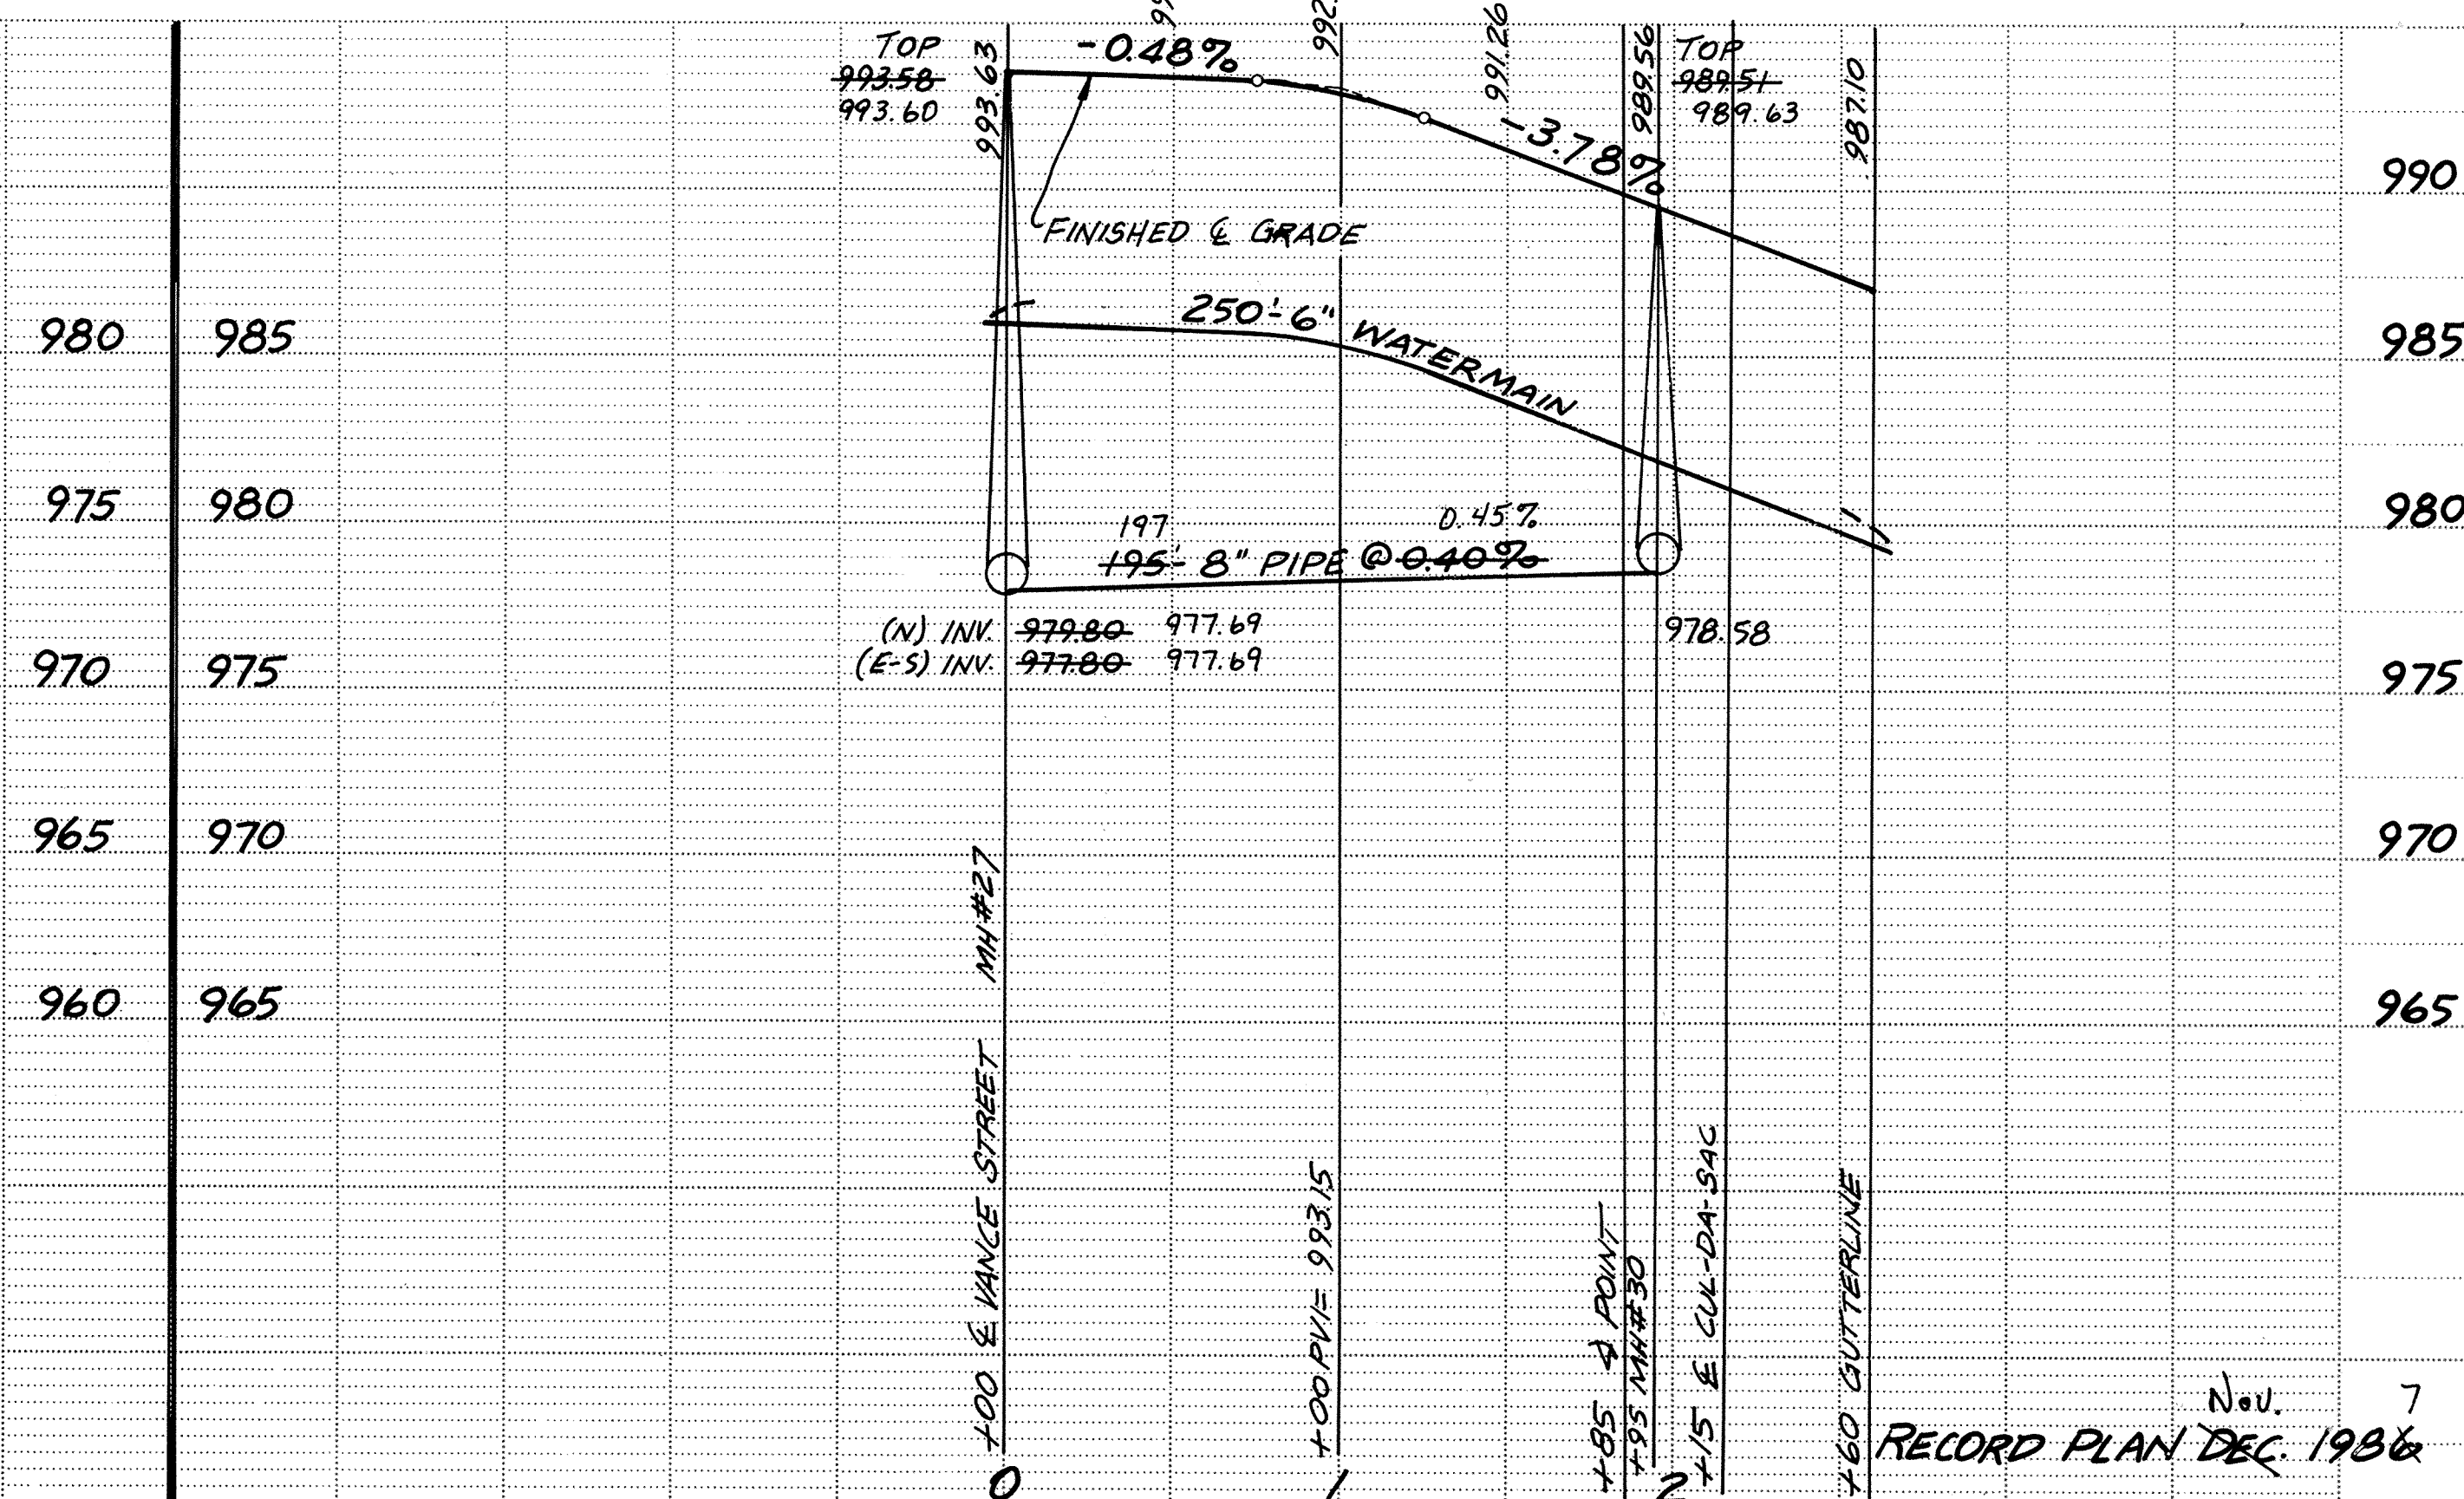
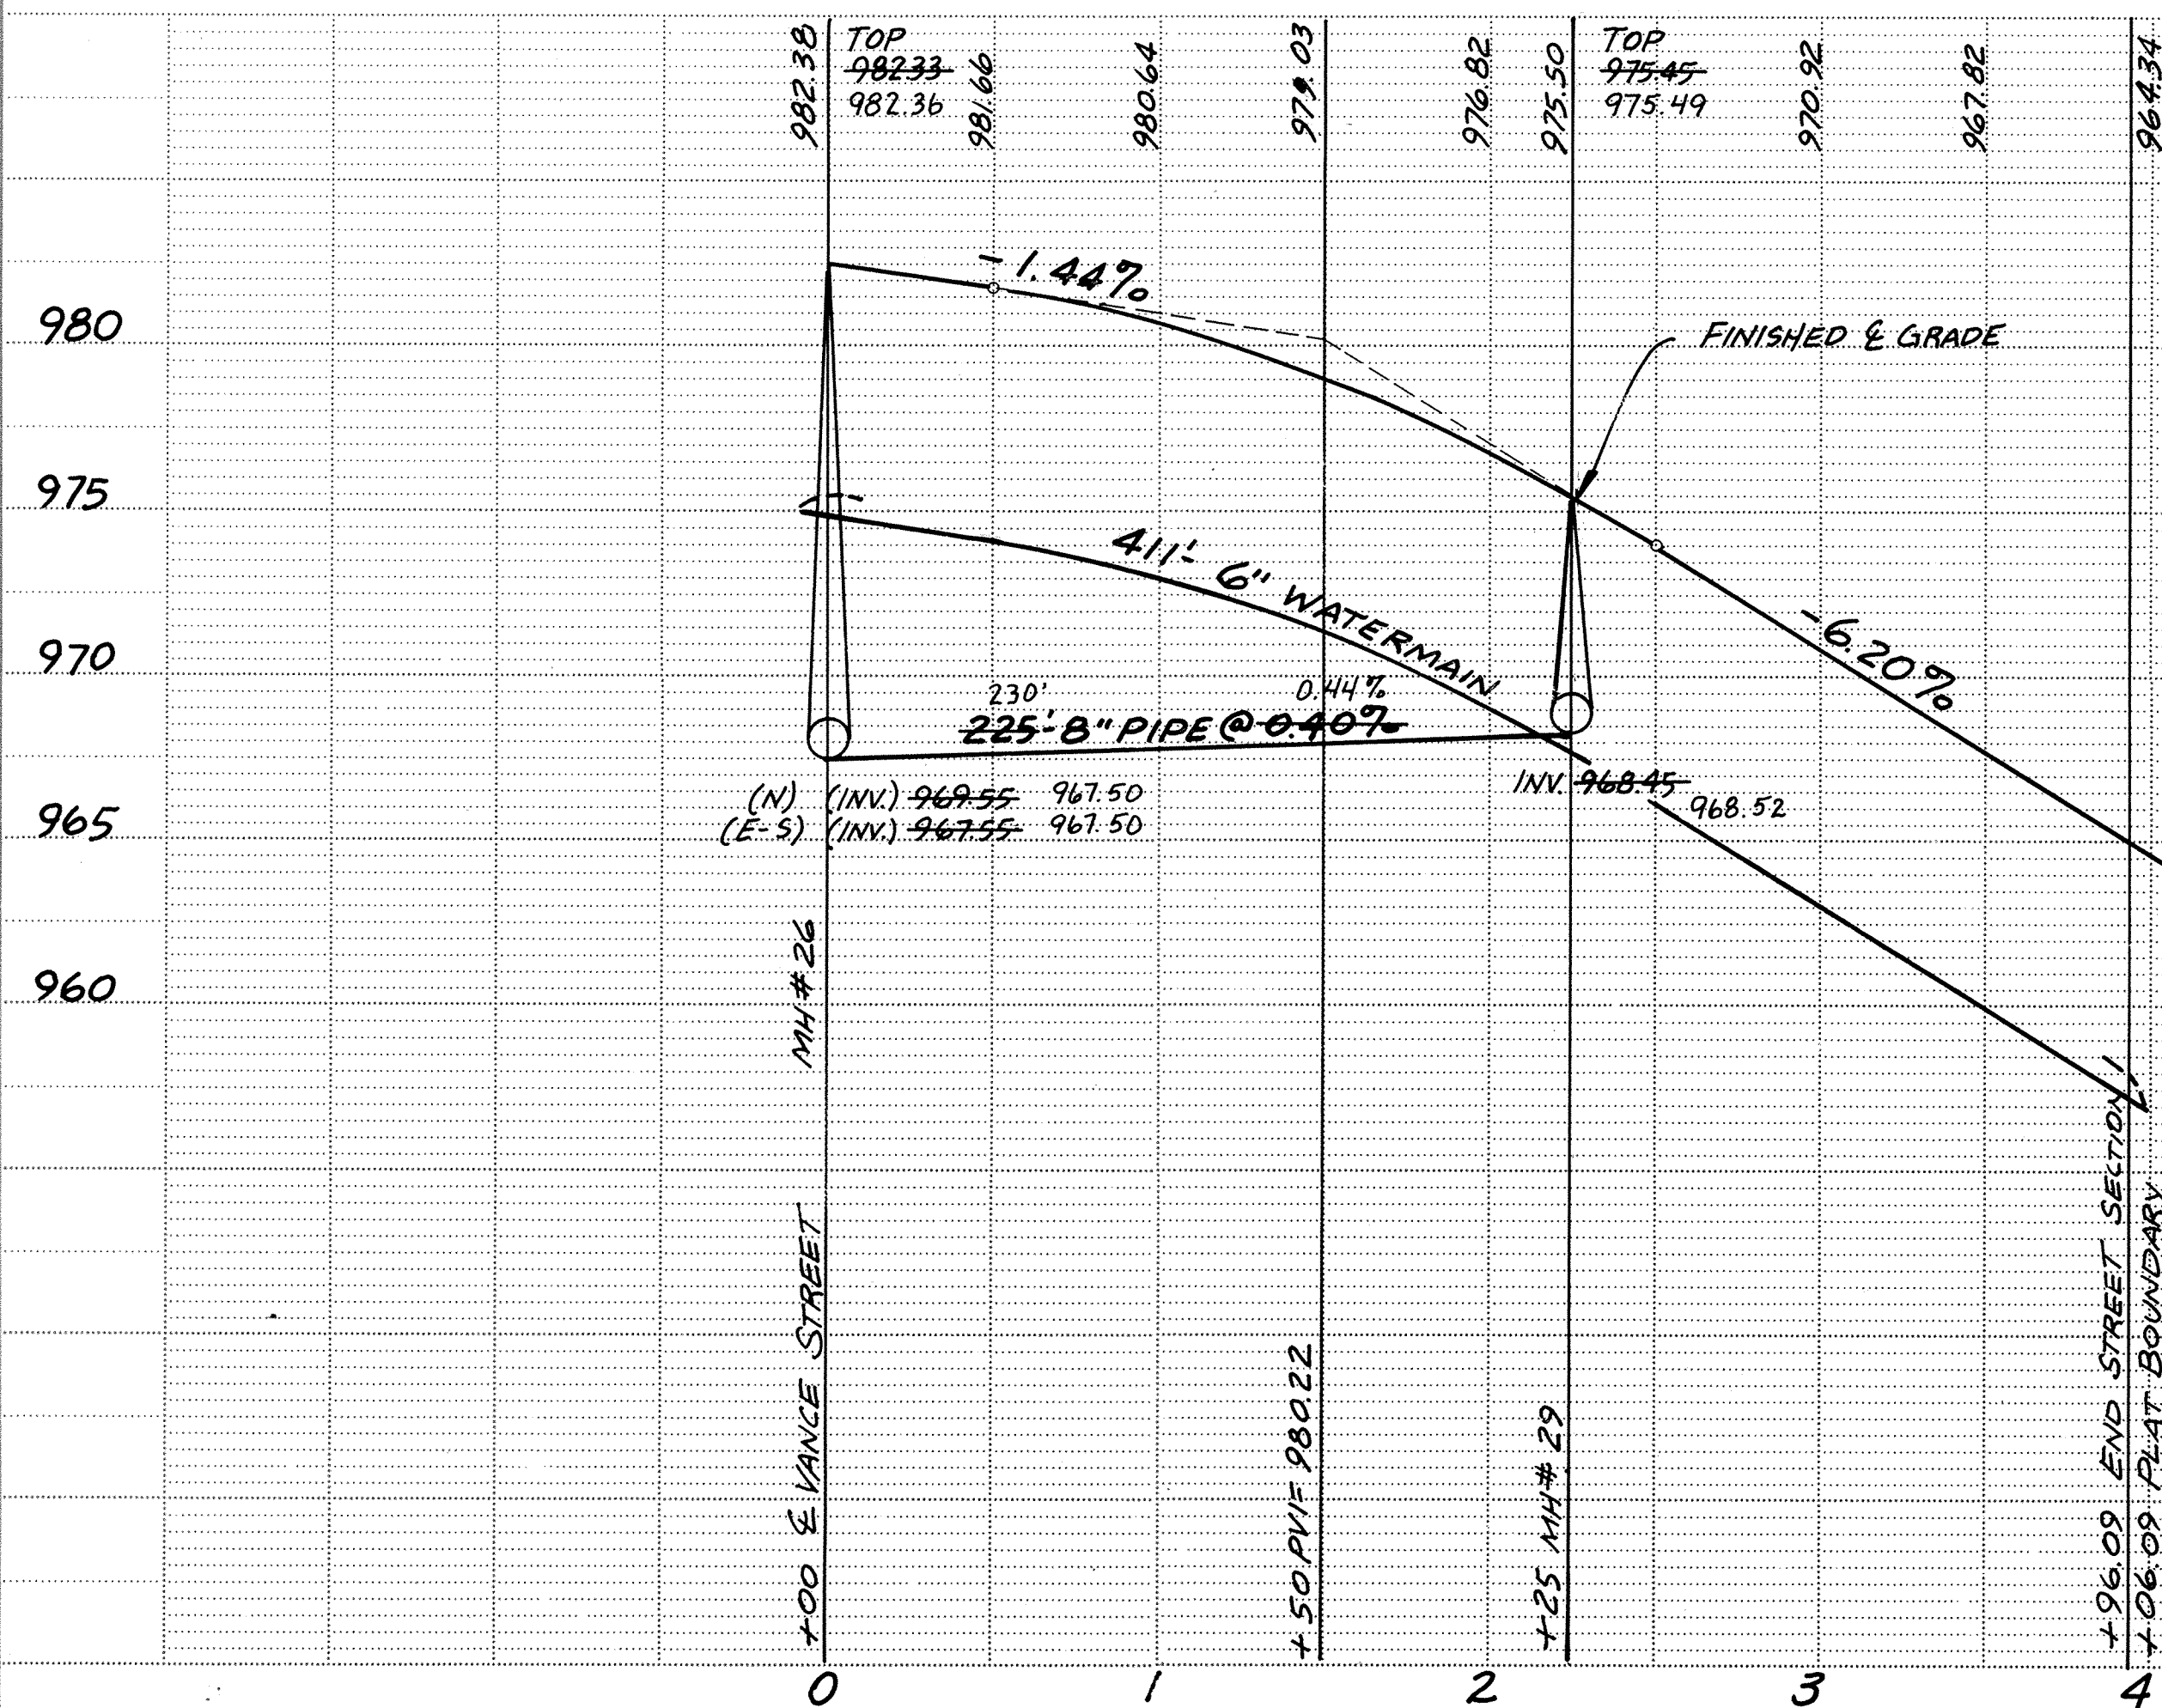
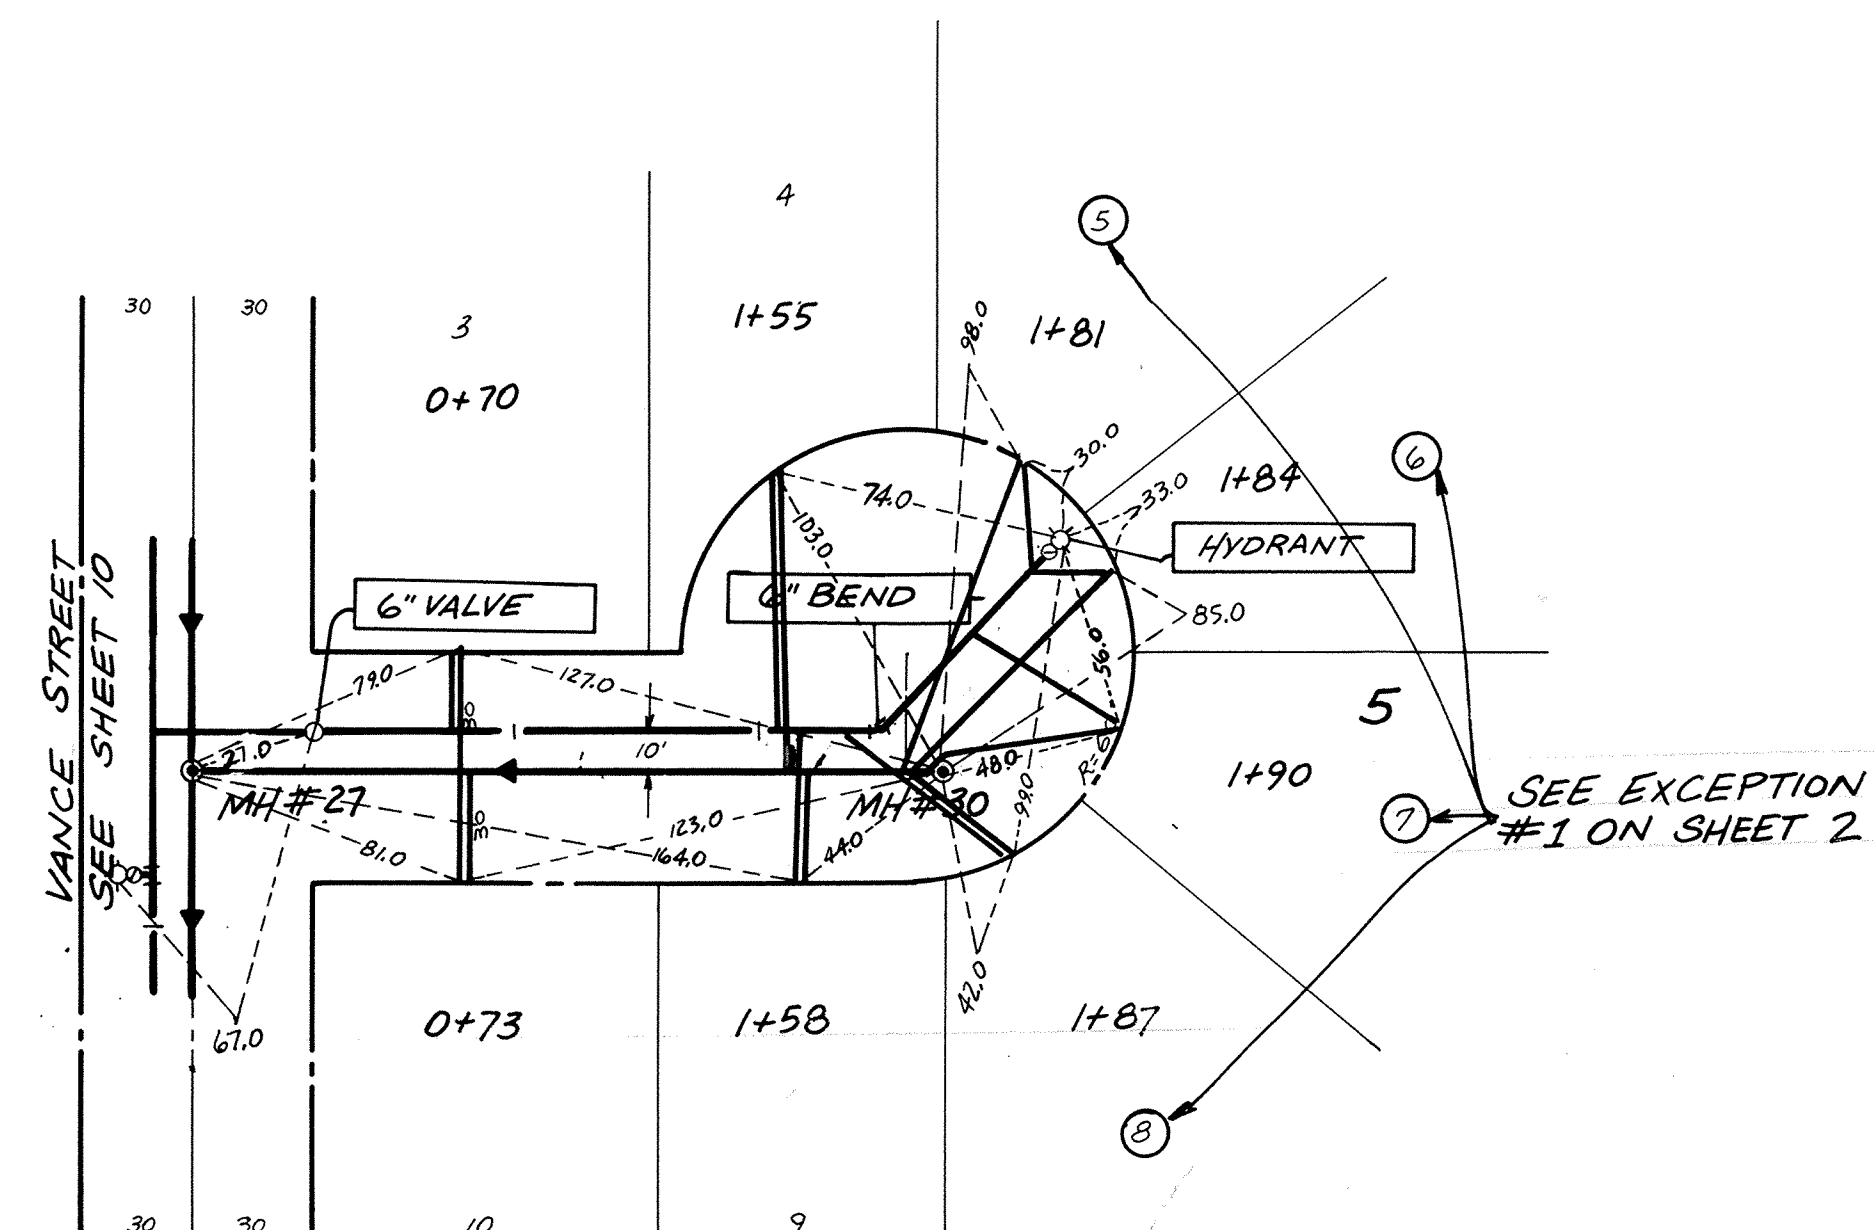


192ND AVENUE

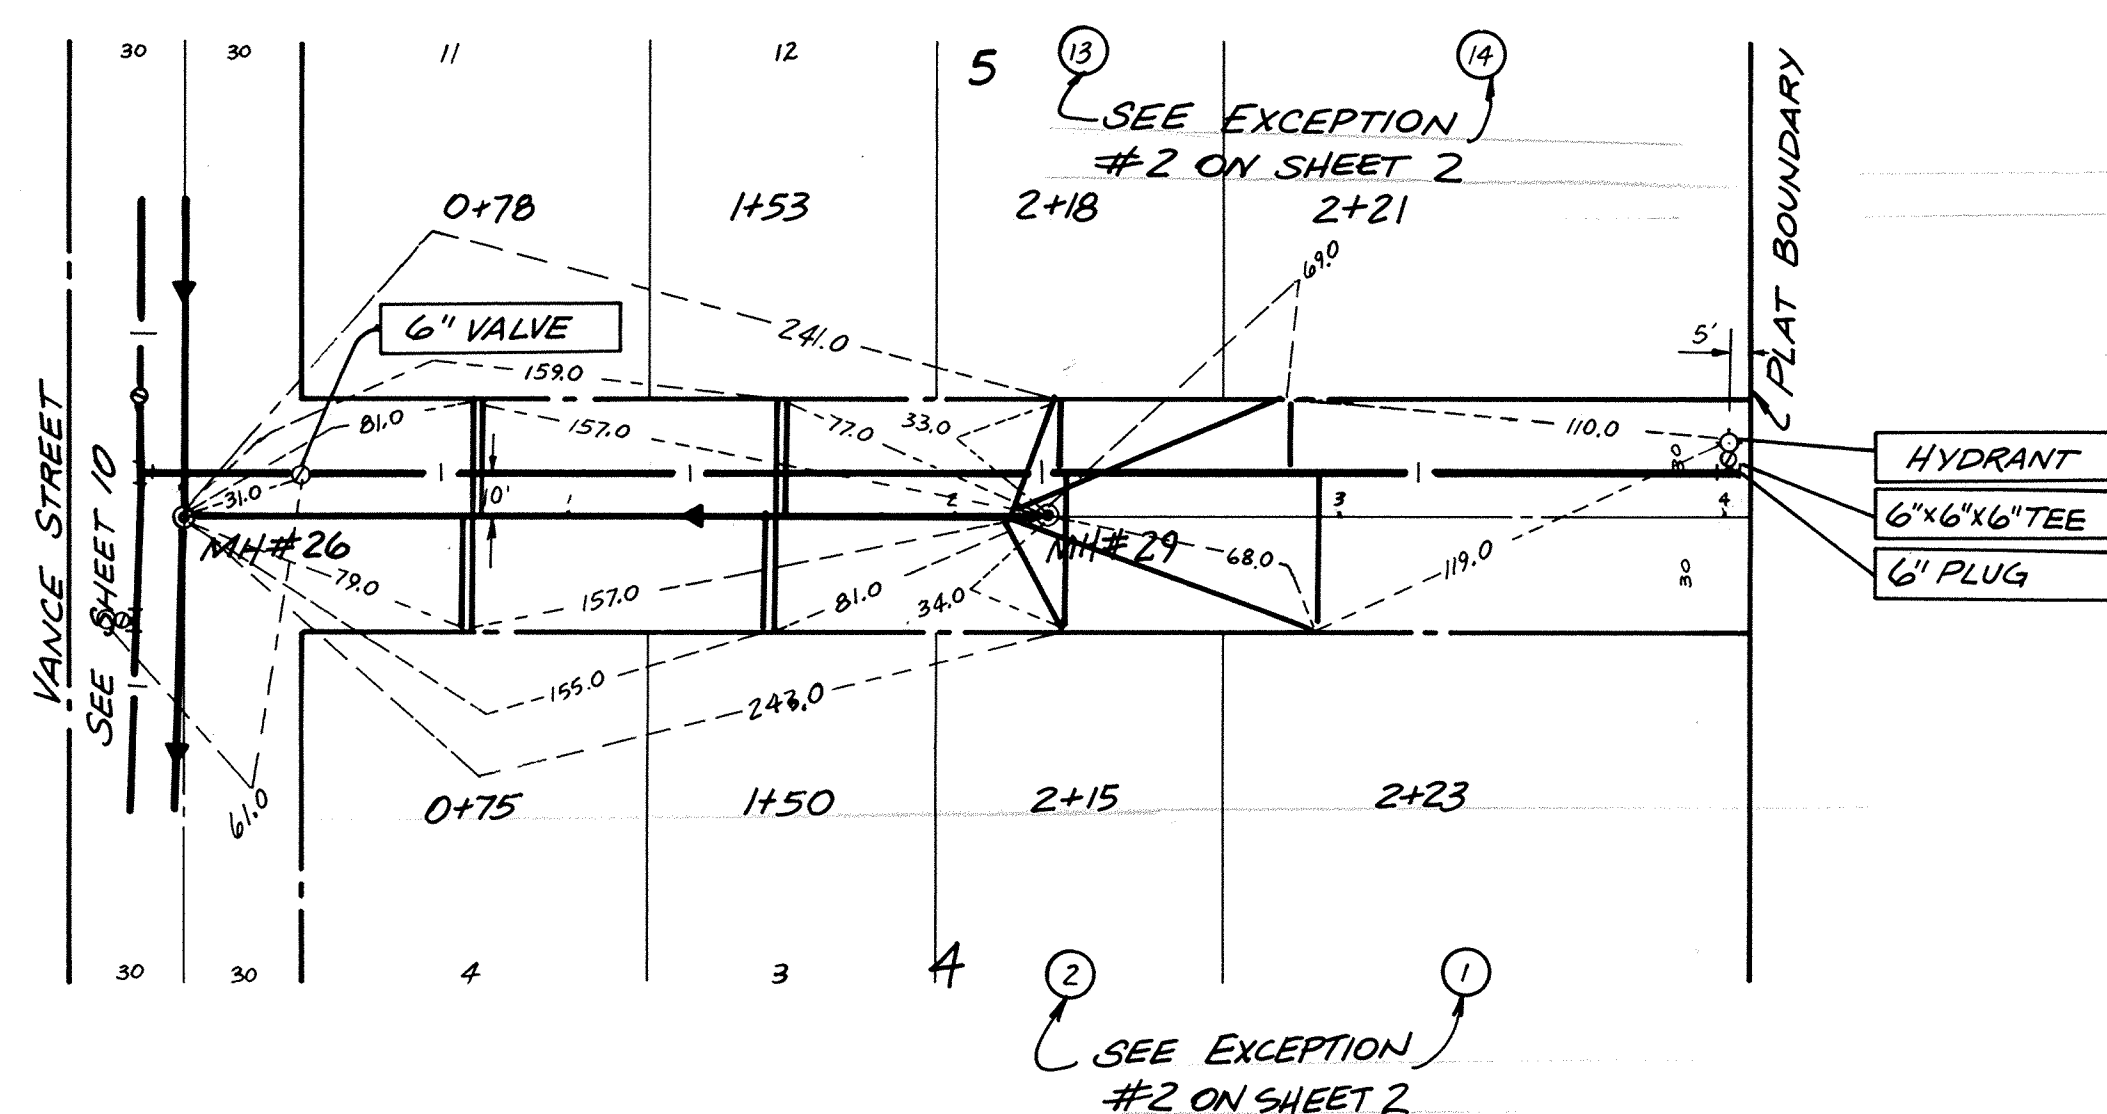

60 0 Nov. T
RECORD PLAN DEC. 1986

USA

480 CEDAR STREET

(612)227-9475

CONSULTING ENGINEERS
& Associates Inc.

ST. PAUL, MINNESOTA 55101

REVISIONS	DATE	DESCRIPTION	DESIGNED
	8/24/86	PROFILE	CHECKED
			DRAWN MRJ
			GRAPHIC SCALE
			0 HORIZ. 50
			0 VERT. 5

CITY OF ELK RIVER
DEERFIELD 3RD ADDITION
SANITARY SEWER AND WATERMAIN
192ND AVENUE ~ 192ND COURT

DATE MAY 1986 SHEET 11 OF 31 SHEETS PROJECT NO. 230-02