
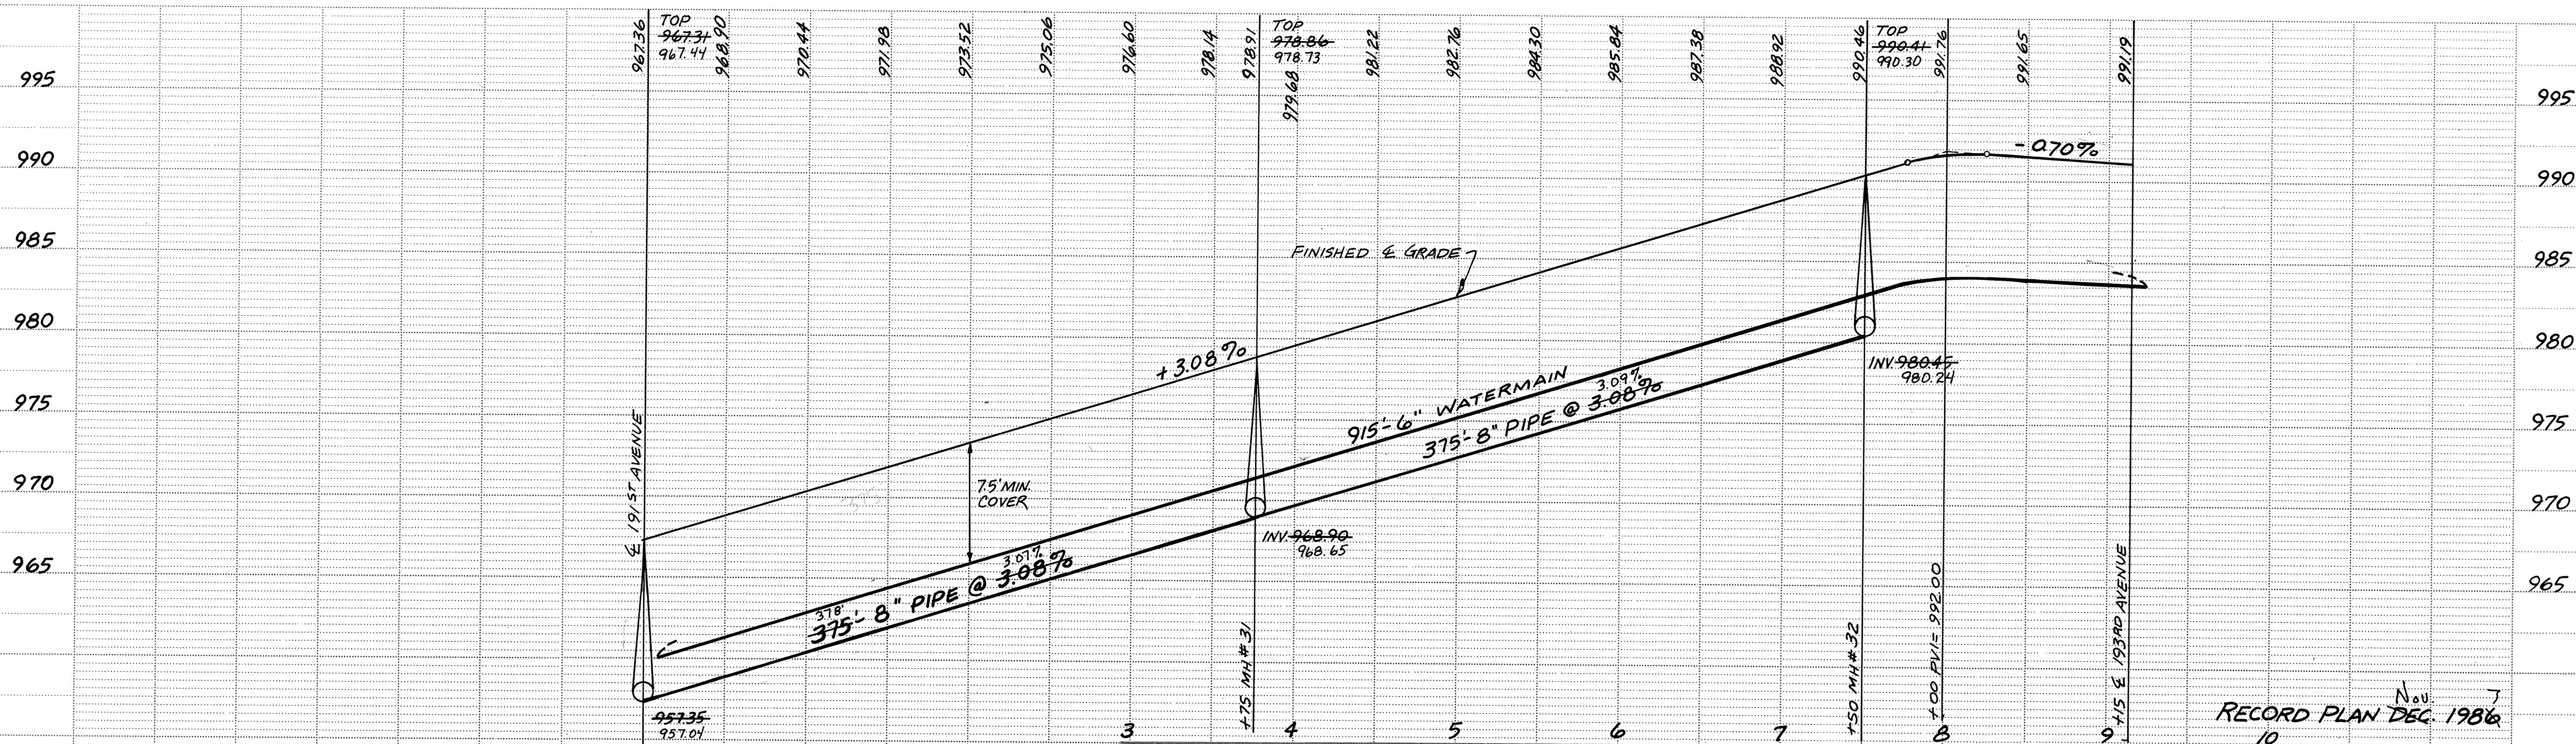
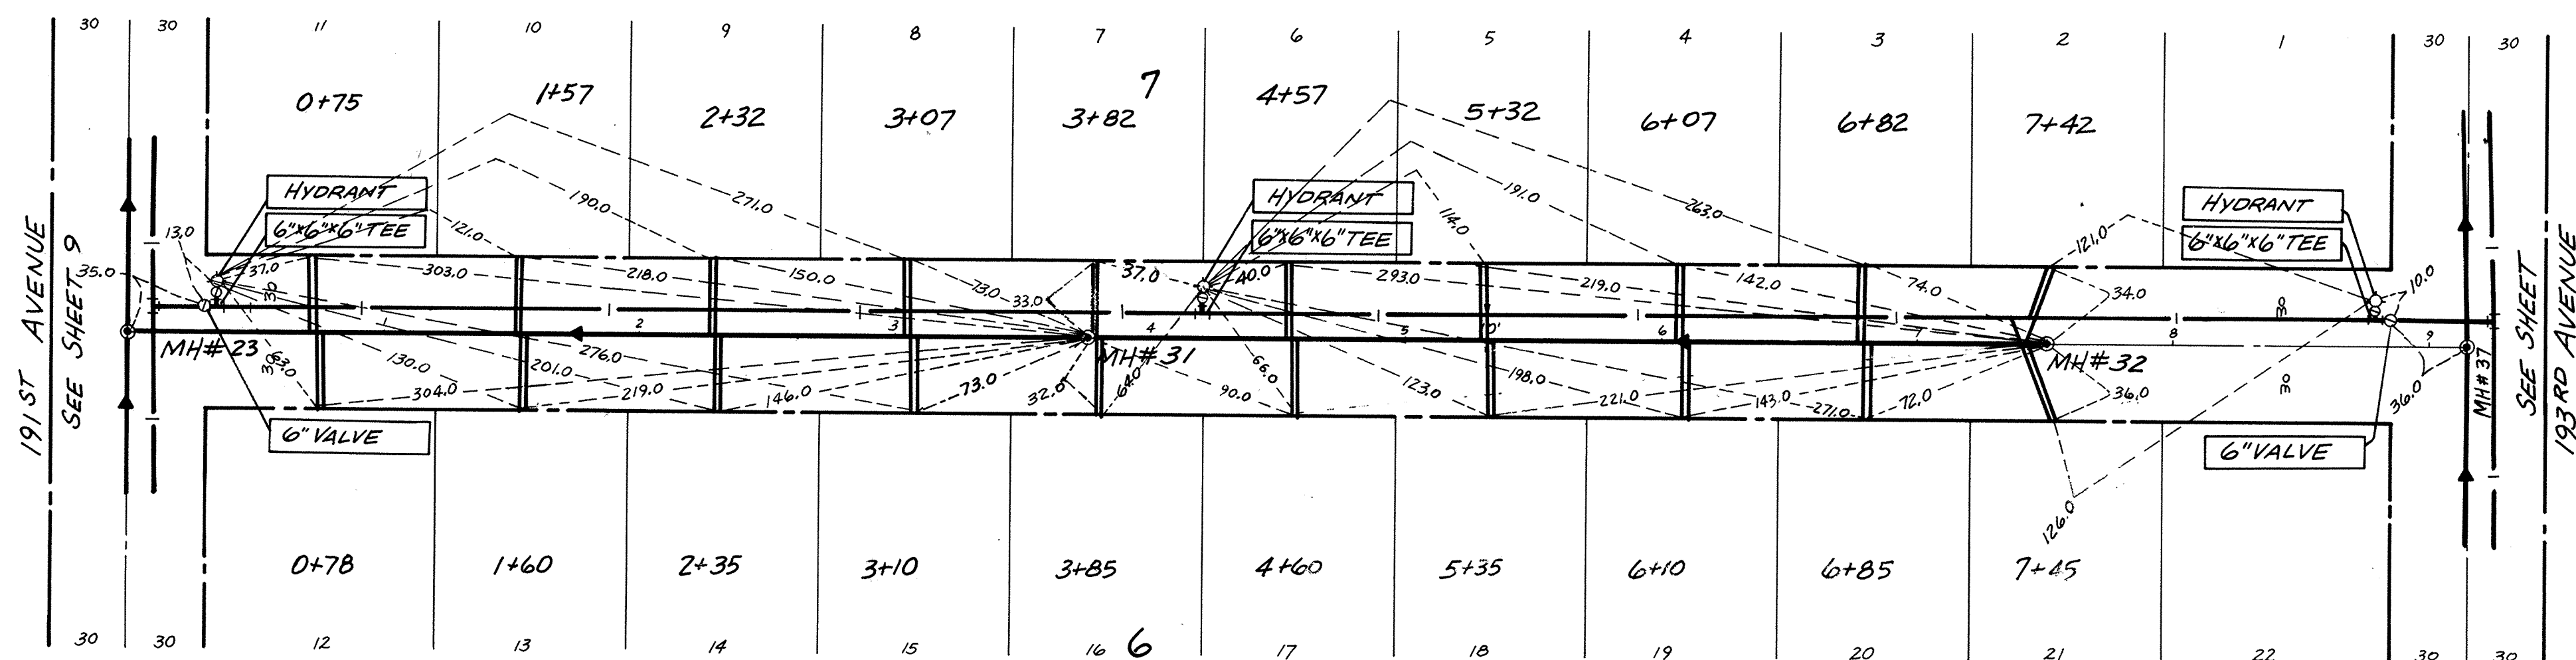


WILSON STREET

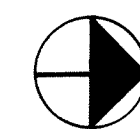

CONSULTING ENGINEERS
Maier Stewart & Associates Inc.
480 CEDAR STREET (612)227-9475 ST. PAUL, MINNESOTA 55101

REVISIONS	DATE	DESCRIPTION	DESIGNED
	8/27/86	PROFILE	CHECKED
			DRAWN M.R.
			GRAPHIC SCALE
			0 HORIZ. 50
			0 VERT. 5

CITY OF ELK RIVER
DEERFIELD 3RD ADDITION
SANITARY SEWER AND WATERMAIN
WILSON STREET

DATE MAY 1986 SHEET 12 OF 31 SHEETS PROJECT NO. 230-020