
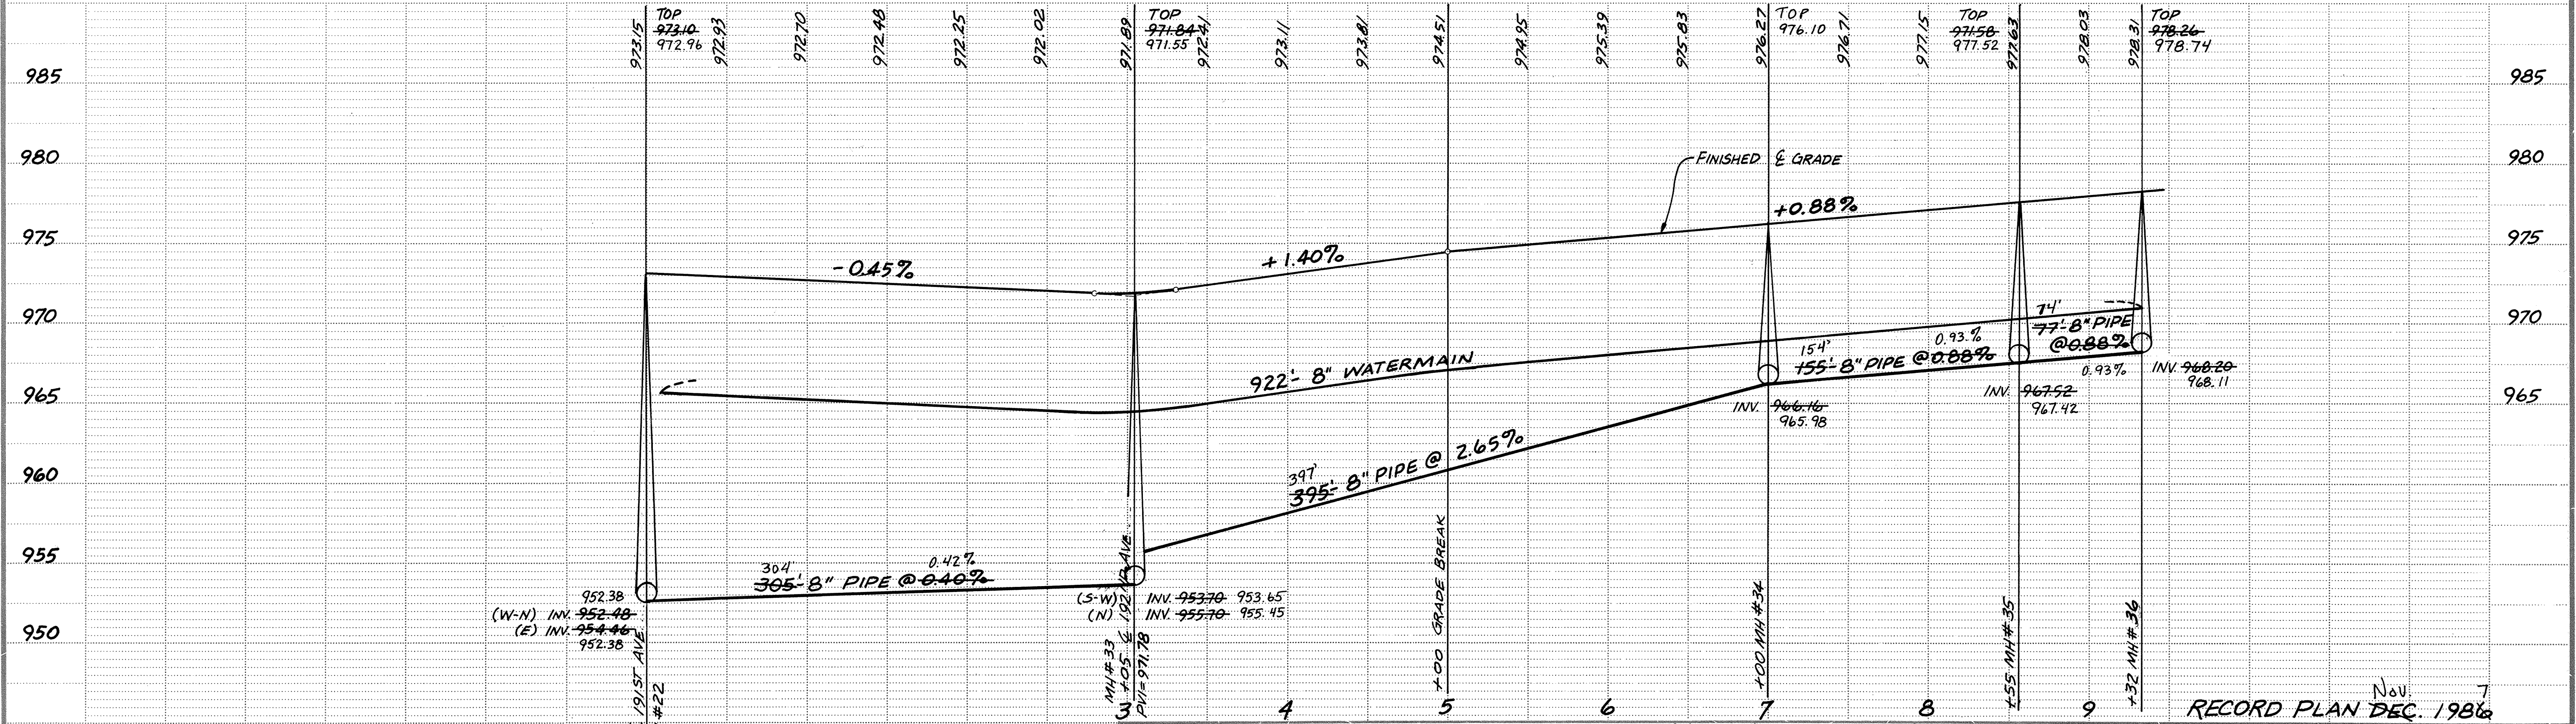


XAVIER STREET

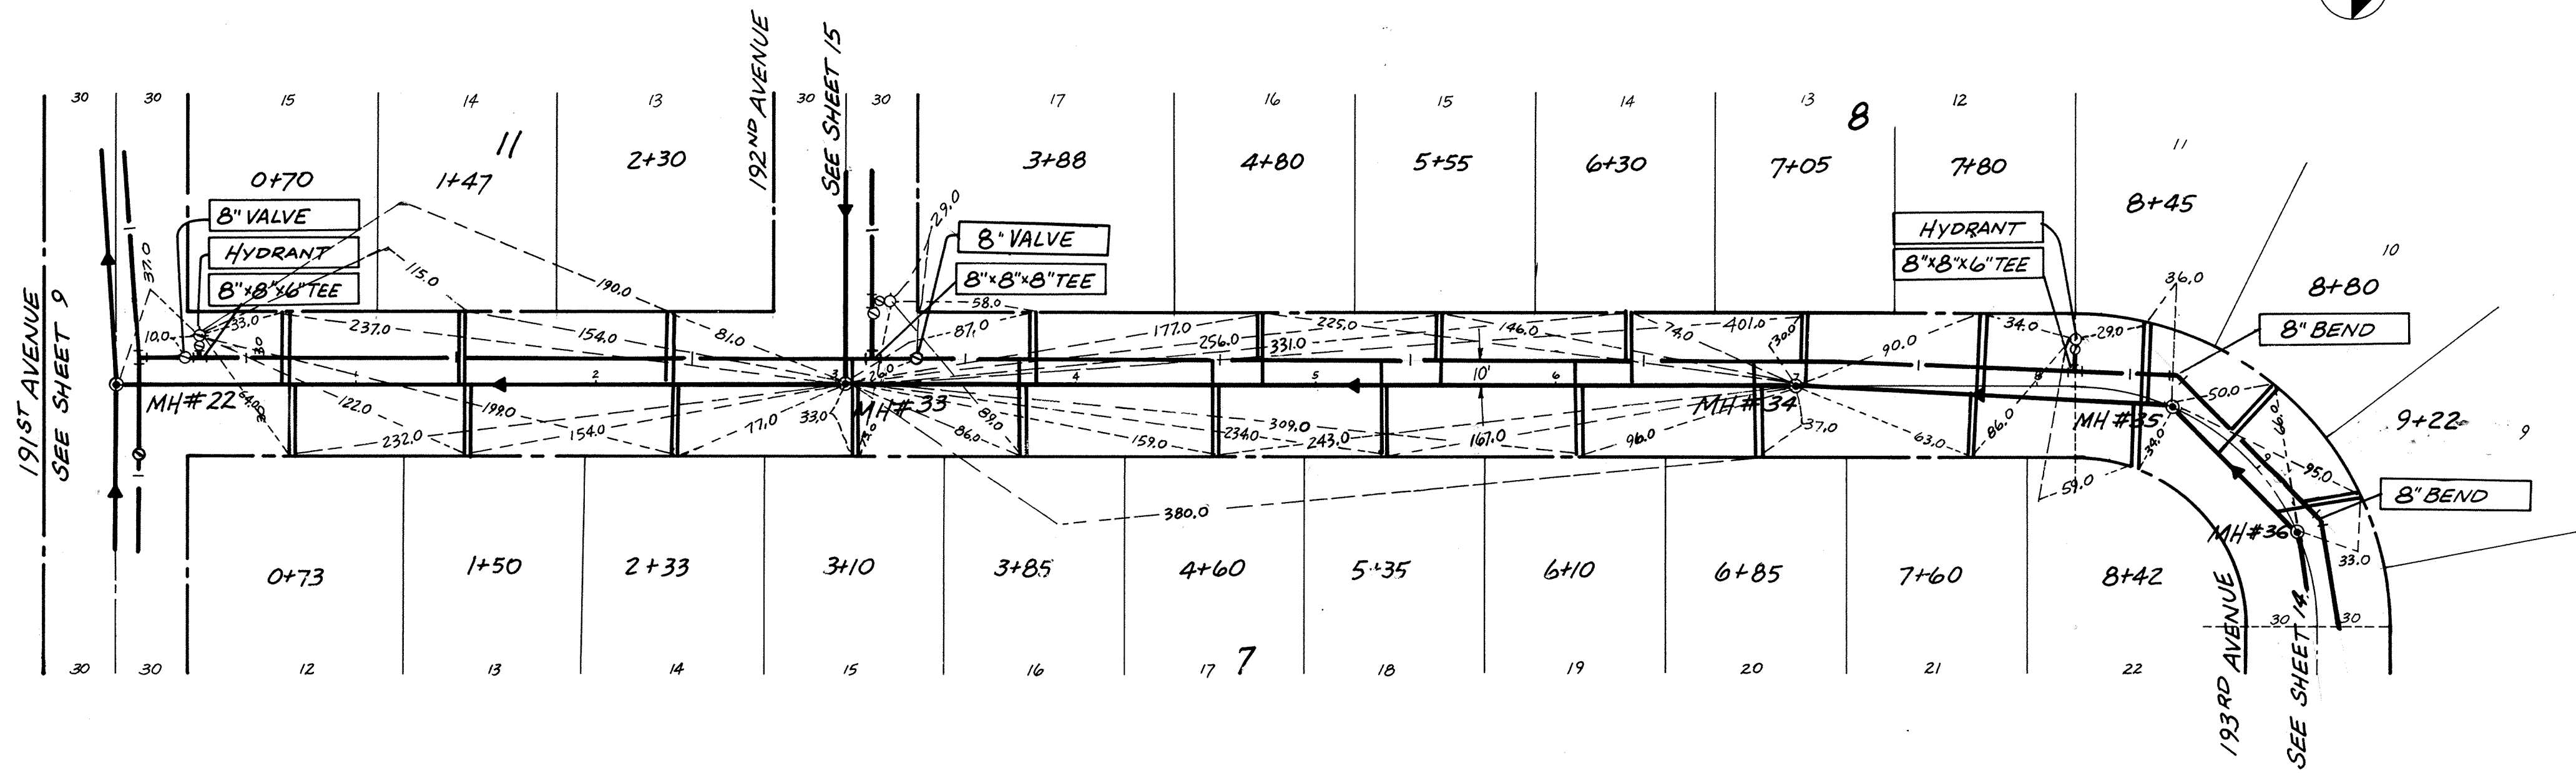

MSA CONSULTING ENGINEERS
Maier Stewart & Associates Inc.
480 CEDAR STREET (612) 227-9475 ST. PAUL, MINNESOTA 55101

REVISIONS	DATE	DESCRIPTION	DESIGNED	CHECKED	DRAWN
	8/26/86	PROFILE			MBI

GRAPHIC SCALE 0 HORIZ. 50 0 VERT. 5	
---	--

CITY OF ELK RIVER DEERFIELD 3RD ADDITION SANITARY SEWER AND WATERMAIN XAVIER STREET	
--	--

DATE MAY 1986	SHEET 13 OF 31 SHEETS	PROJECT NO. 230-020
---------------	-----------------------	---------------------