



193RD AVENUE

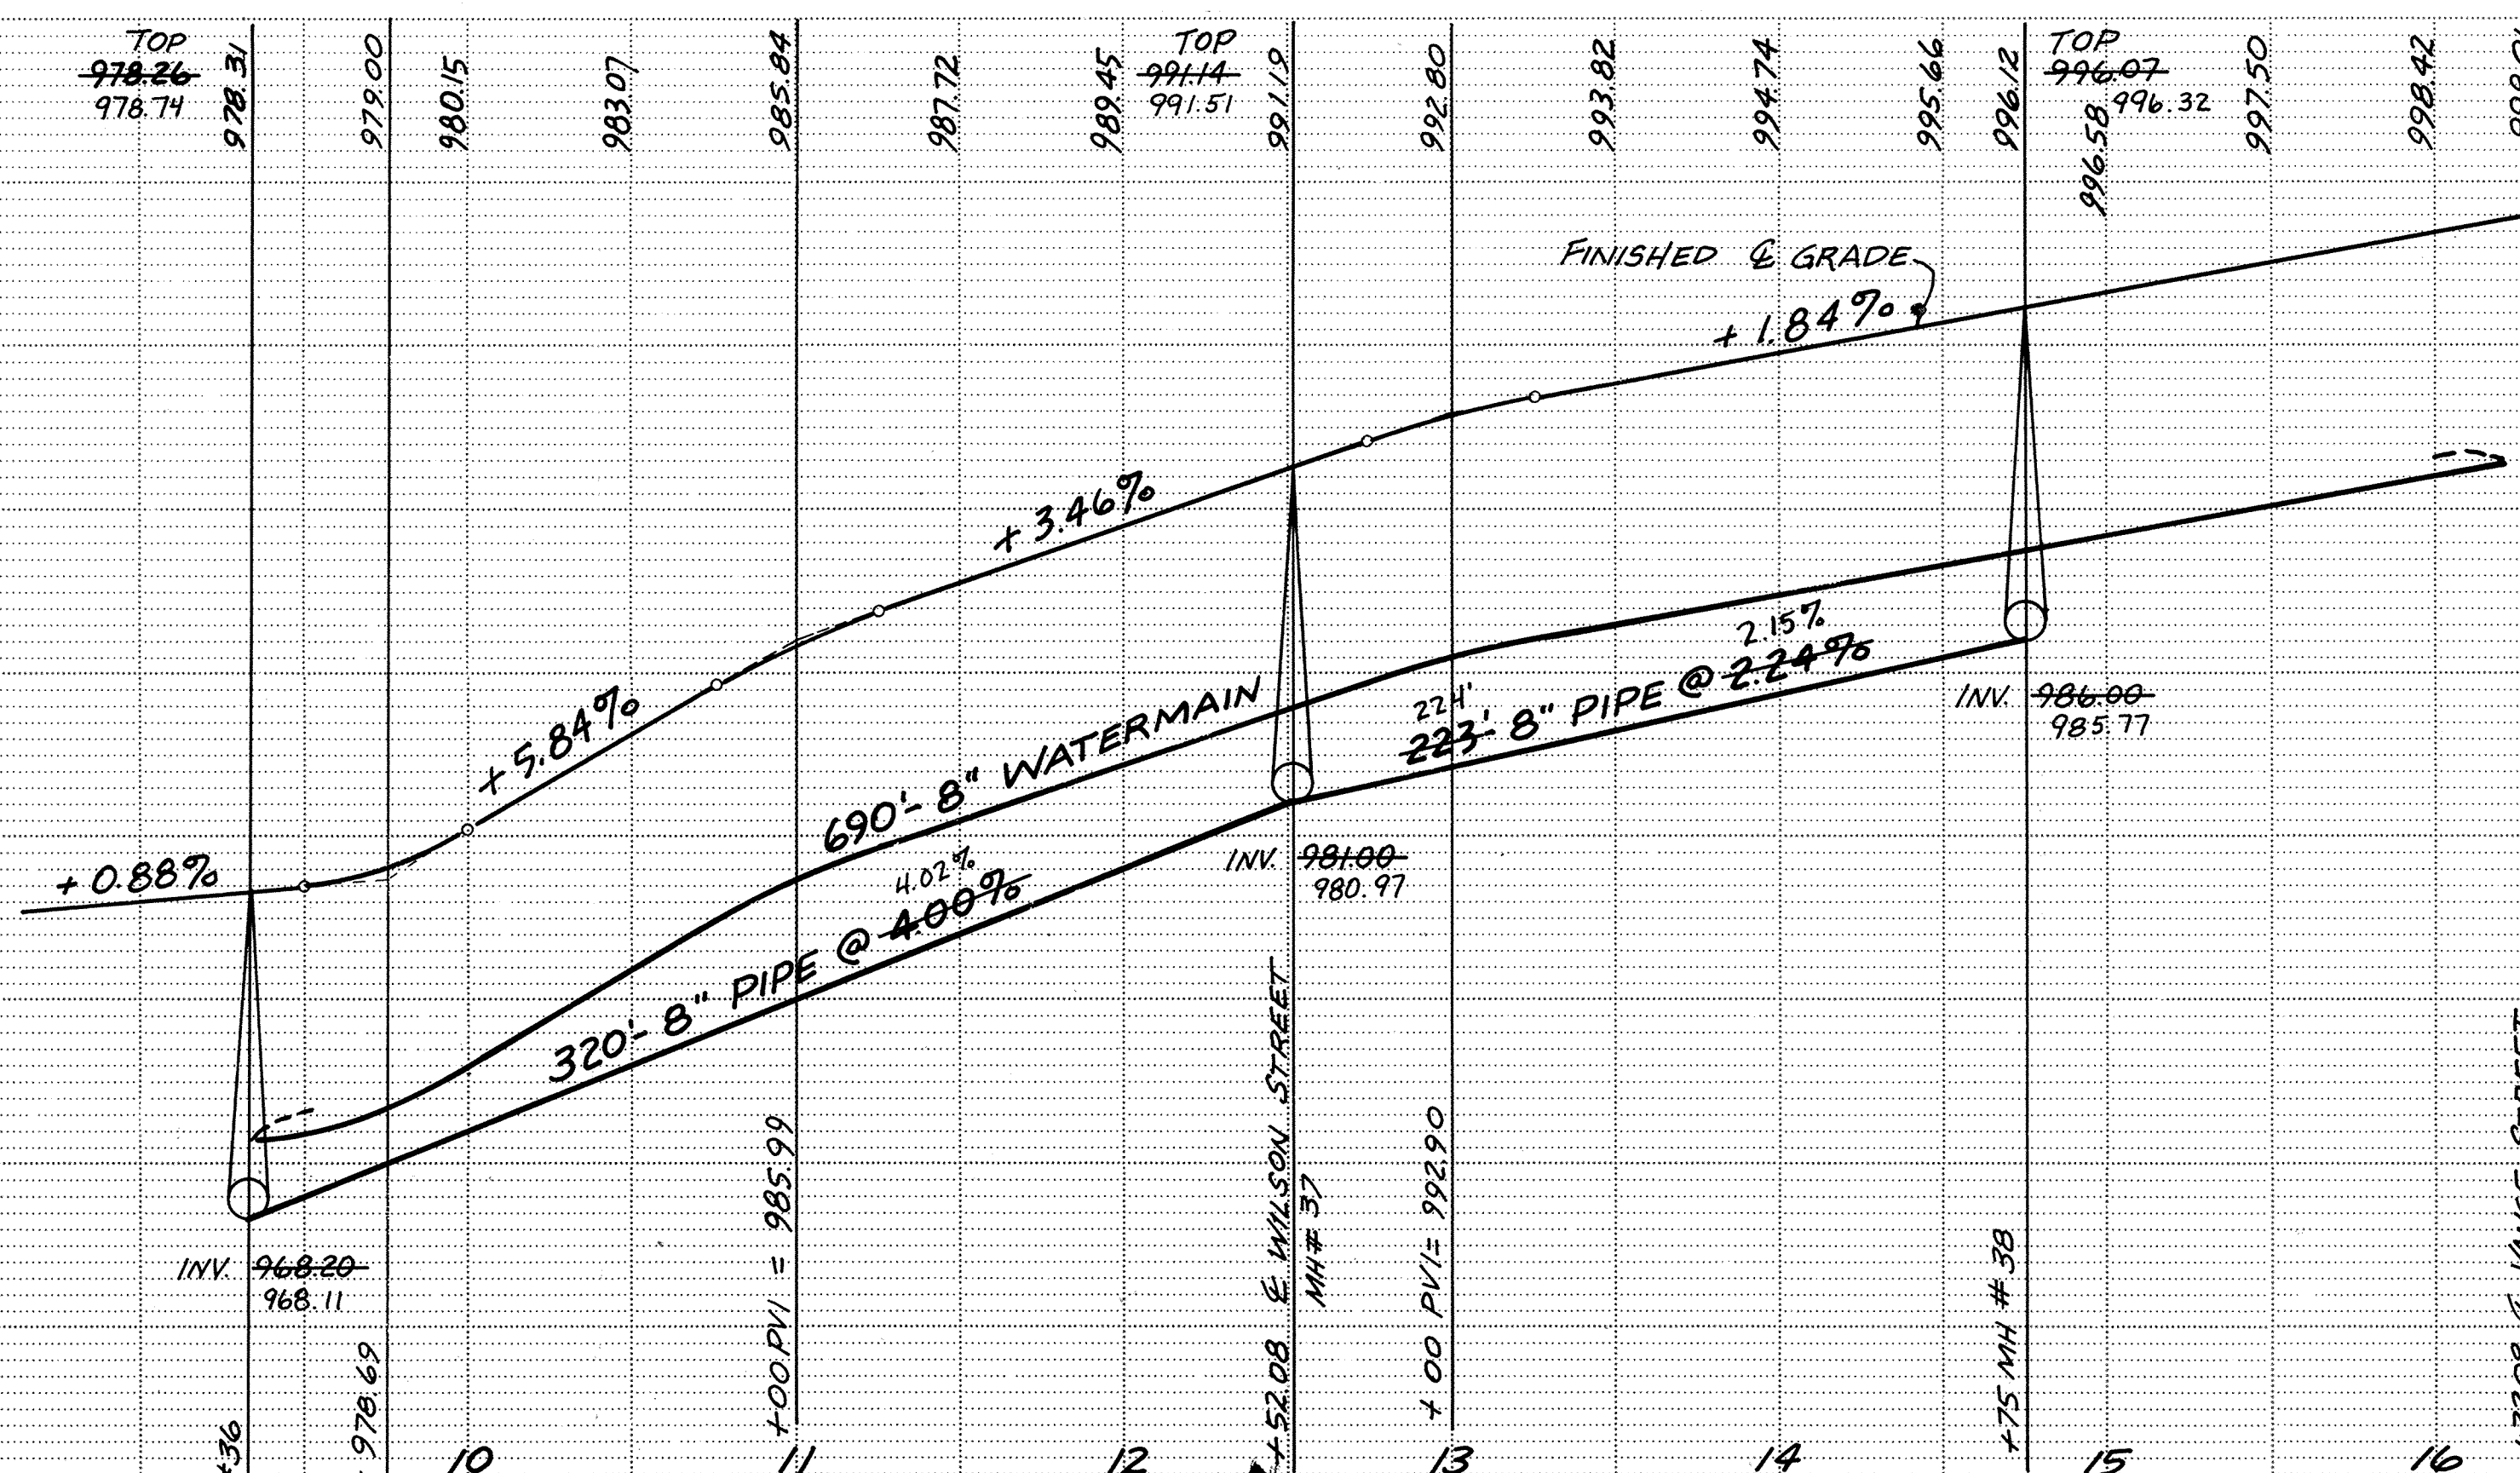

Nov. 7
RECORD PLAN DEC. 1986

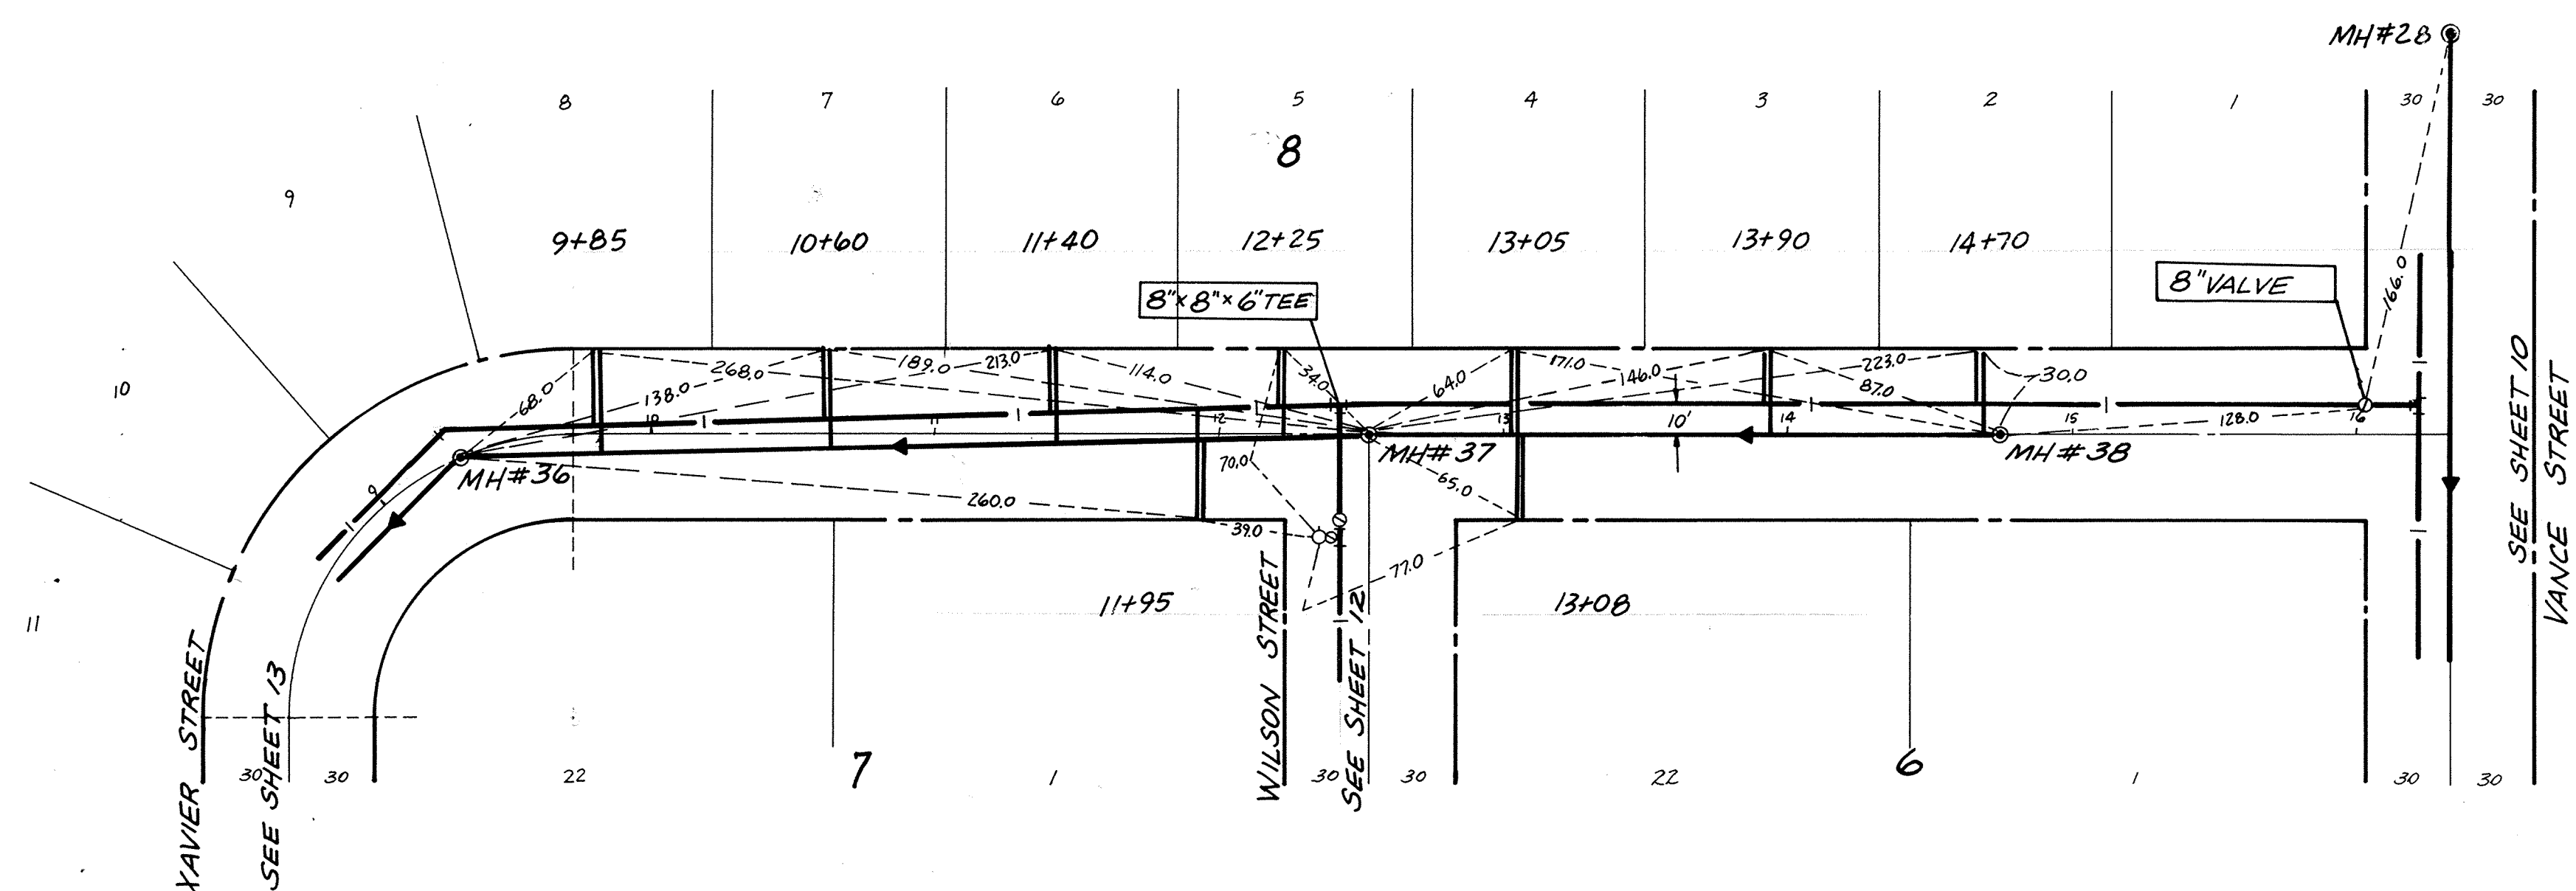

CONSULTING ENGINEERS

480 CEDAR STREET

(612)227-9475

ST. PAUL, MINNESOTA 55101

DATE
8/26/86

DESCRIPTION
<i>PROFILE</i>

CITY OF ELK RIVER
DEERFIELD 3RD ADDITION
SANITARY SEWER AND WATERMAIN
193RD AVENUE

DATE MAY 1986 SHEET 14 OF 31 SHEETS PROJECT NO. 230-020