
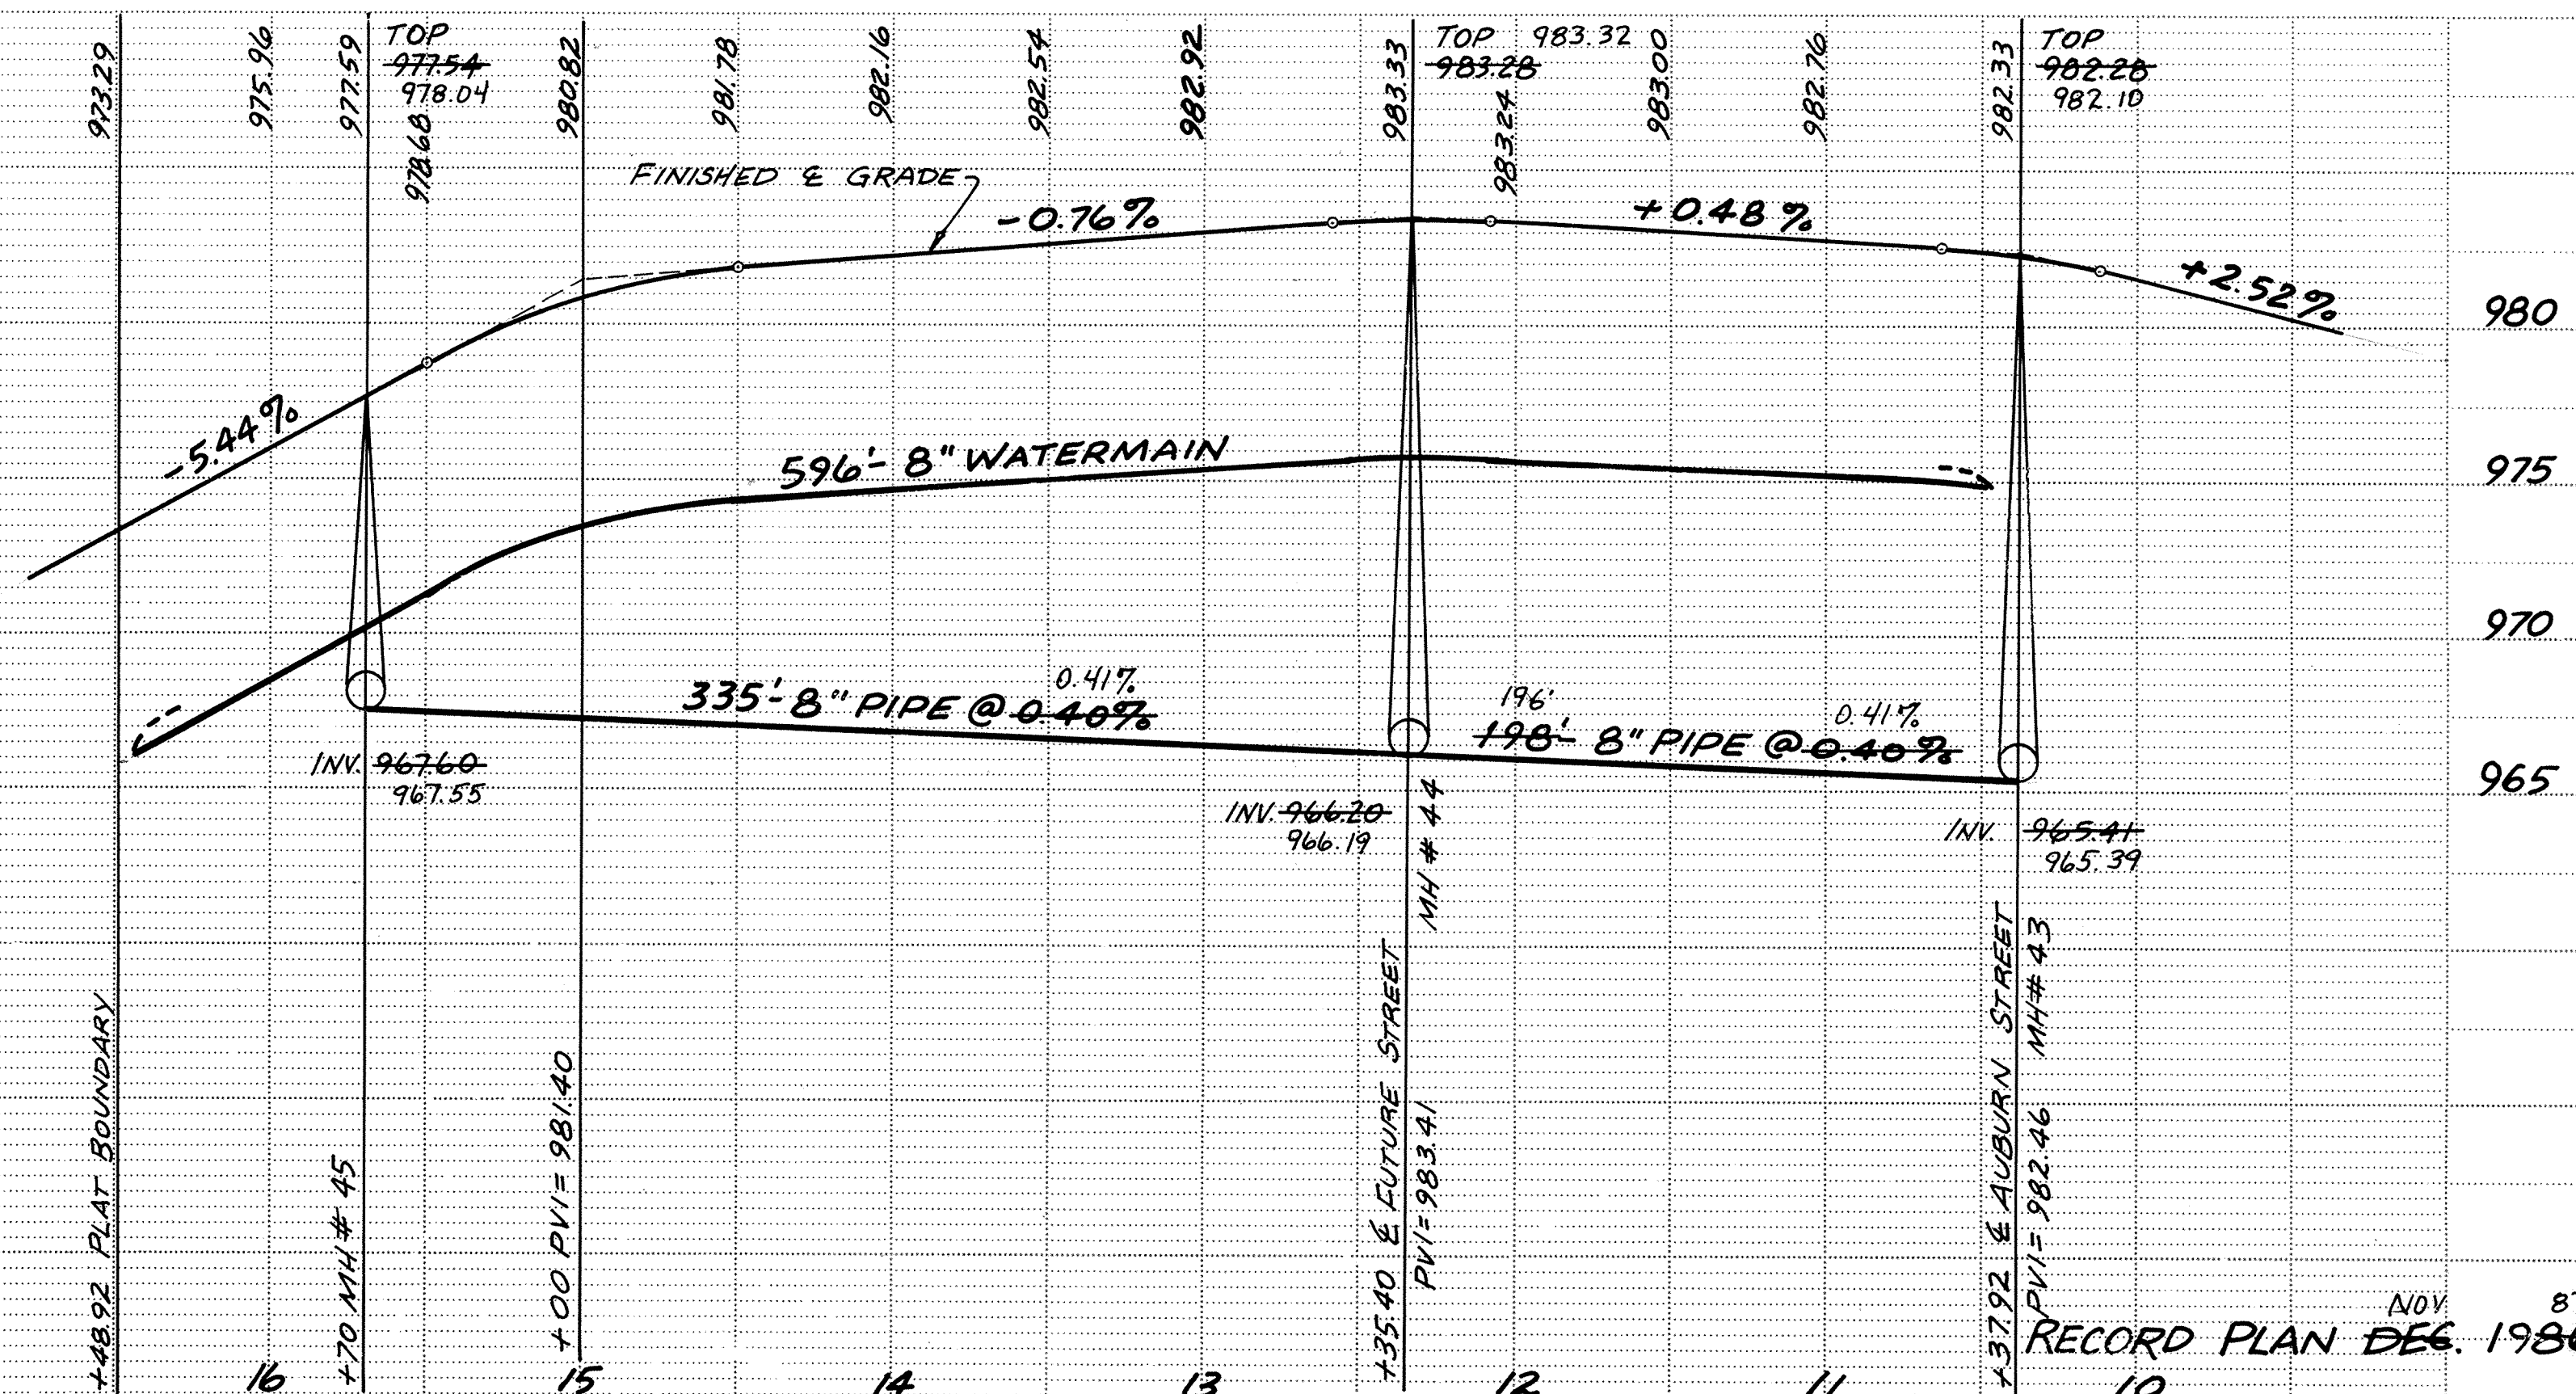
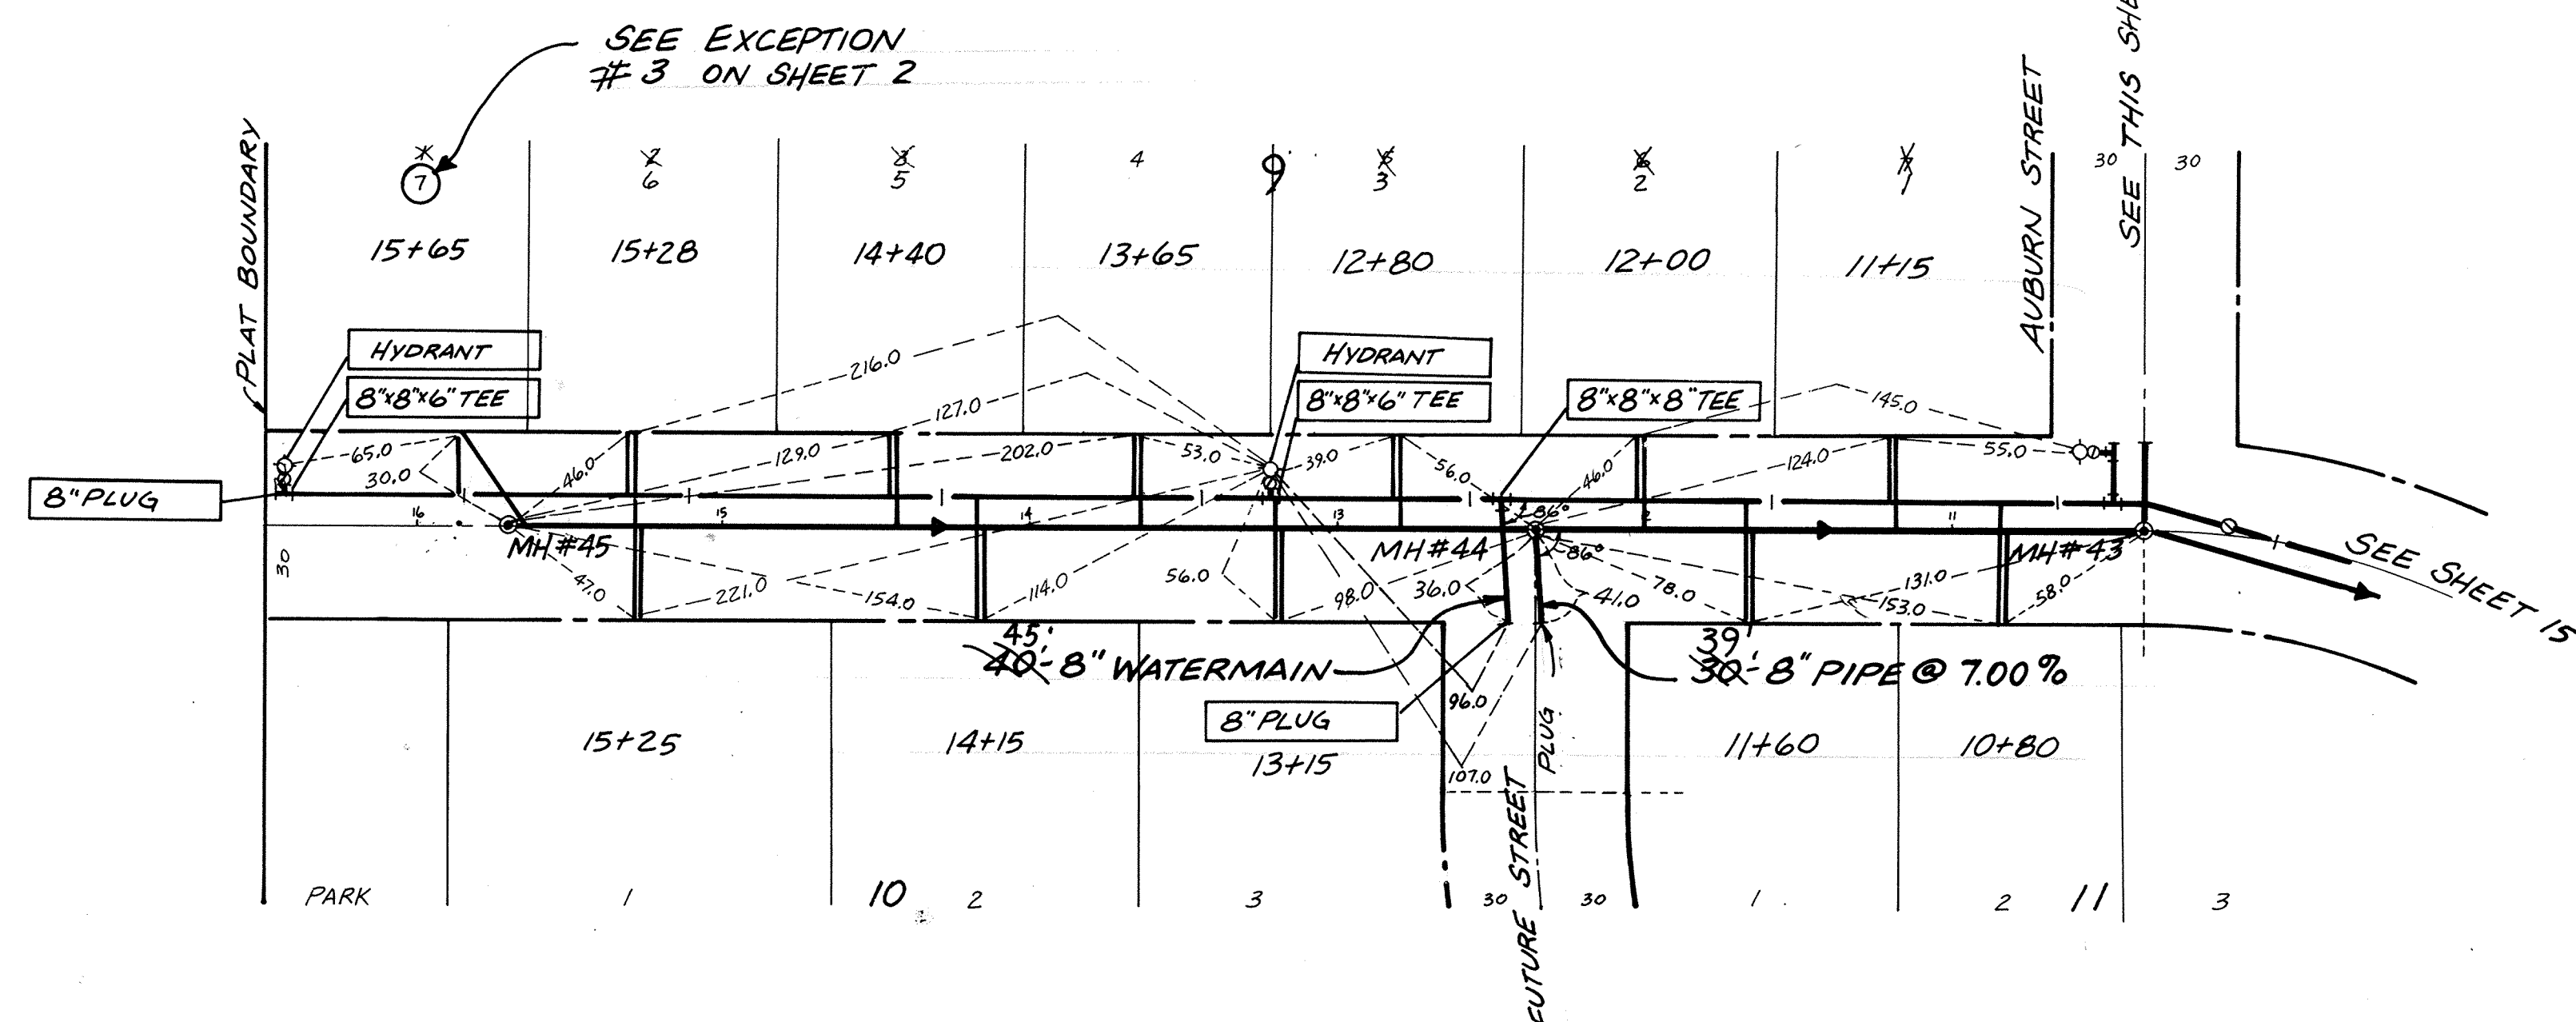


AUBURN STREET

192ND AVENUE

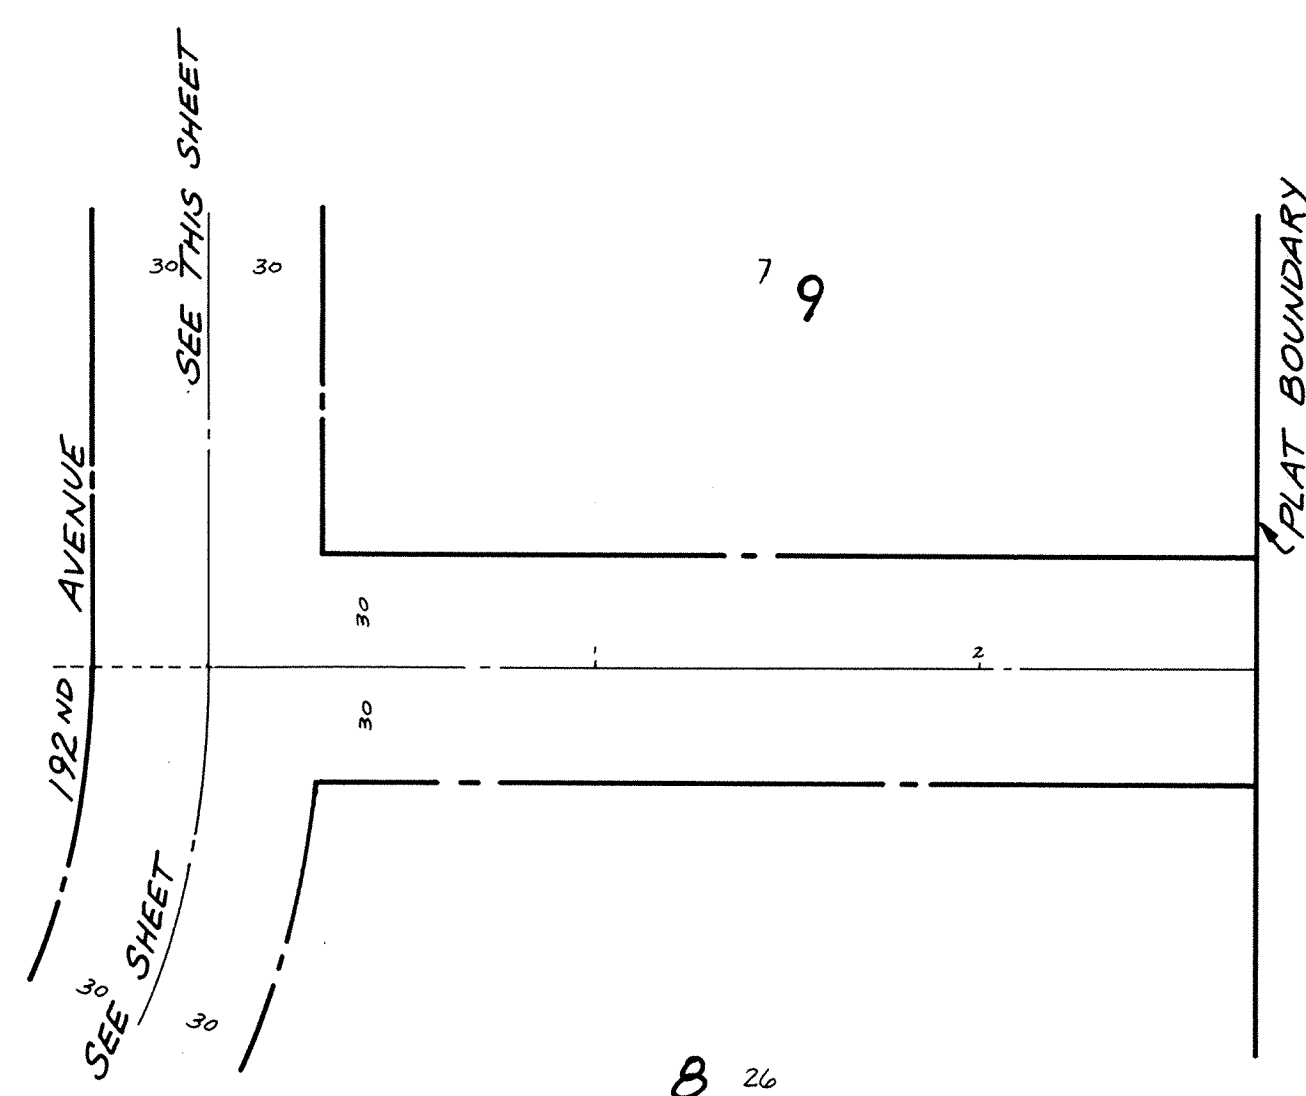

NOV 8
RECORD PLAN DEC. 1980

WSP

CONSULTING ENGINEERS

480 CEDAR STREET

(612)227-9475

ST. PAUL, MINNESOTA 55101

[illegible]

REVISIONS	DATE
	8/28/86

DESCRIPTION
PROFILE

DESIGNED	
CHECKED	
DRAWN	
GRAPHIC	
0	HORI
0	VER

GRAPHIC SCALE
0 HORIZ. 50
0 VERT. 5

CITY OF ELK RIVER
DEERFIELD 3RD ADDITION
SANITARY SEWER AND WATERMAIN
192ND AVENUE

DATE MAY 1986

SHEET 16 OF 31 SHEETS

PROJECT NO.	230-020
-------------	---------