



SAECO PRODUCTS • NEW HOPE, MINNESOTA
REPRODUCED BY PART NUMBER 0553

SAECO PRODUCTS • NEW HOPE, MINNESOTA
REPRODUCED BY PART NUMBER 0553

SAECO PRODUCTS • NEW HOPE, MINNESOTA
REPRODUCED BY PART NUMBER 0553

SAECO PRODUCTS • NEW HOPE, MINNESOTA
REPRODUCED BY PART NUMBER 0553

BALDWIN STREET

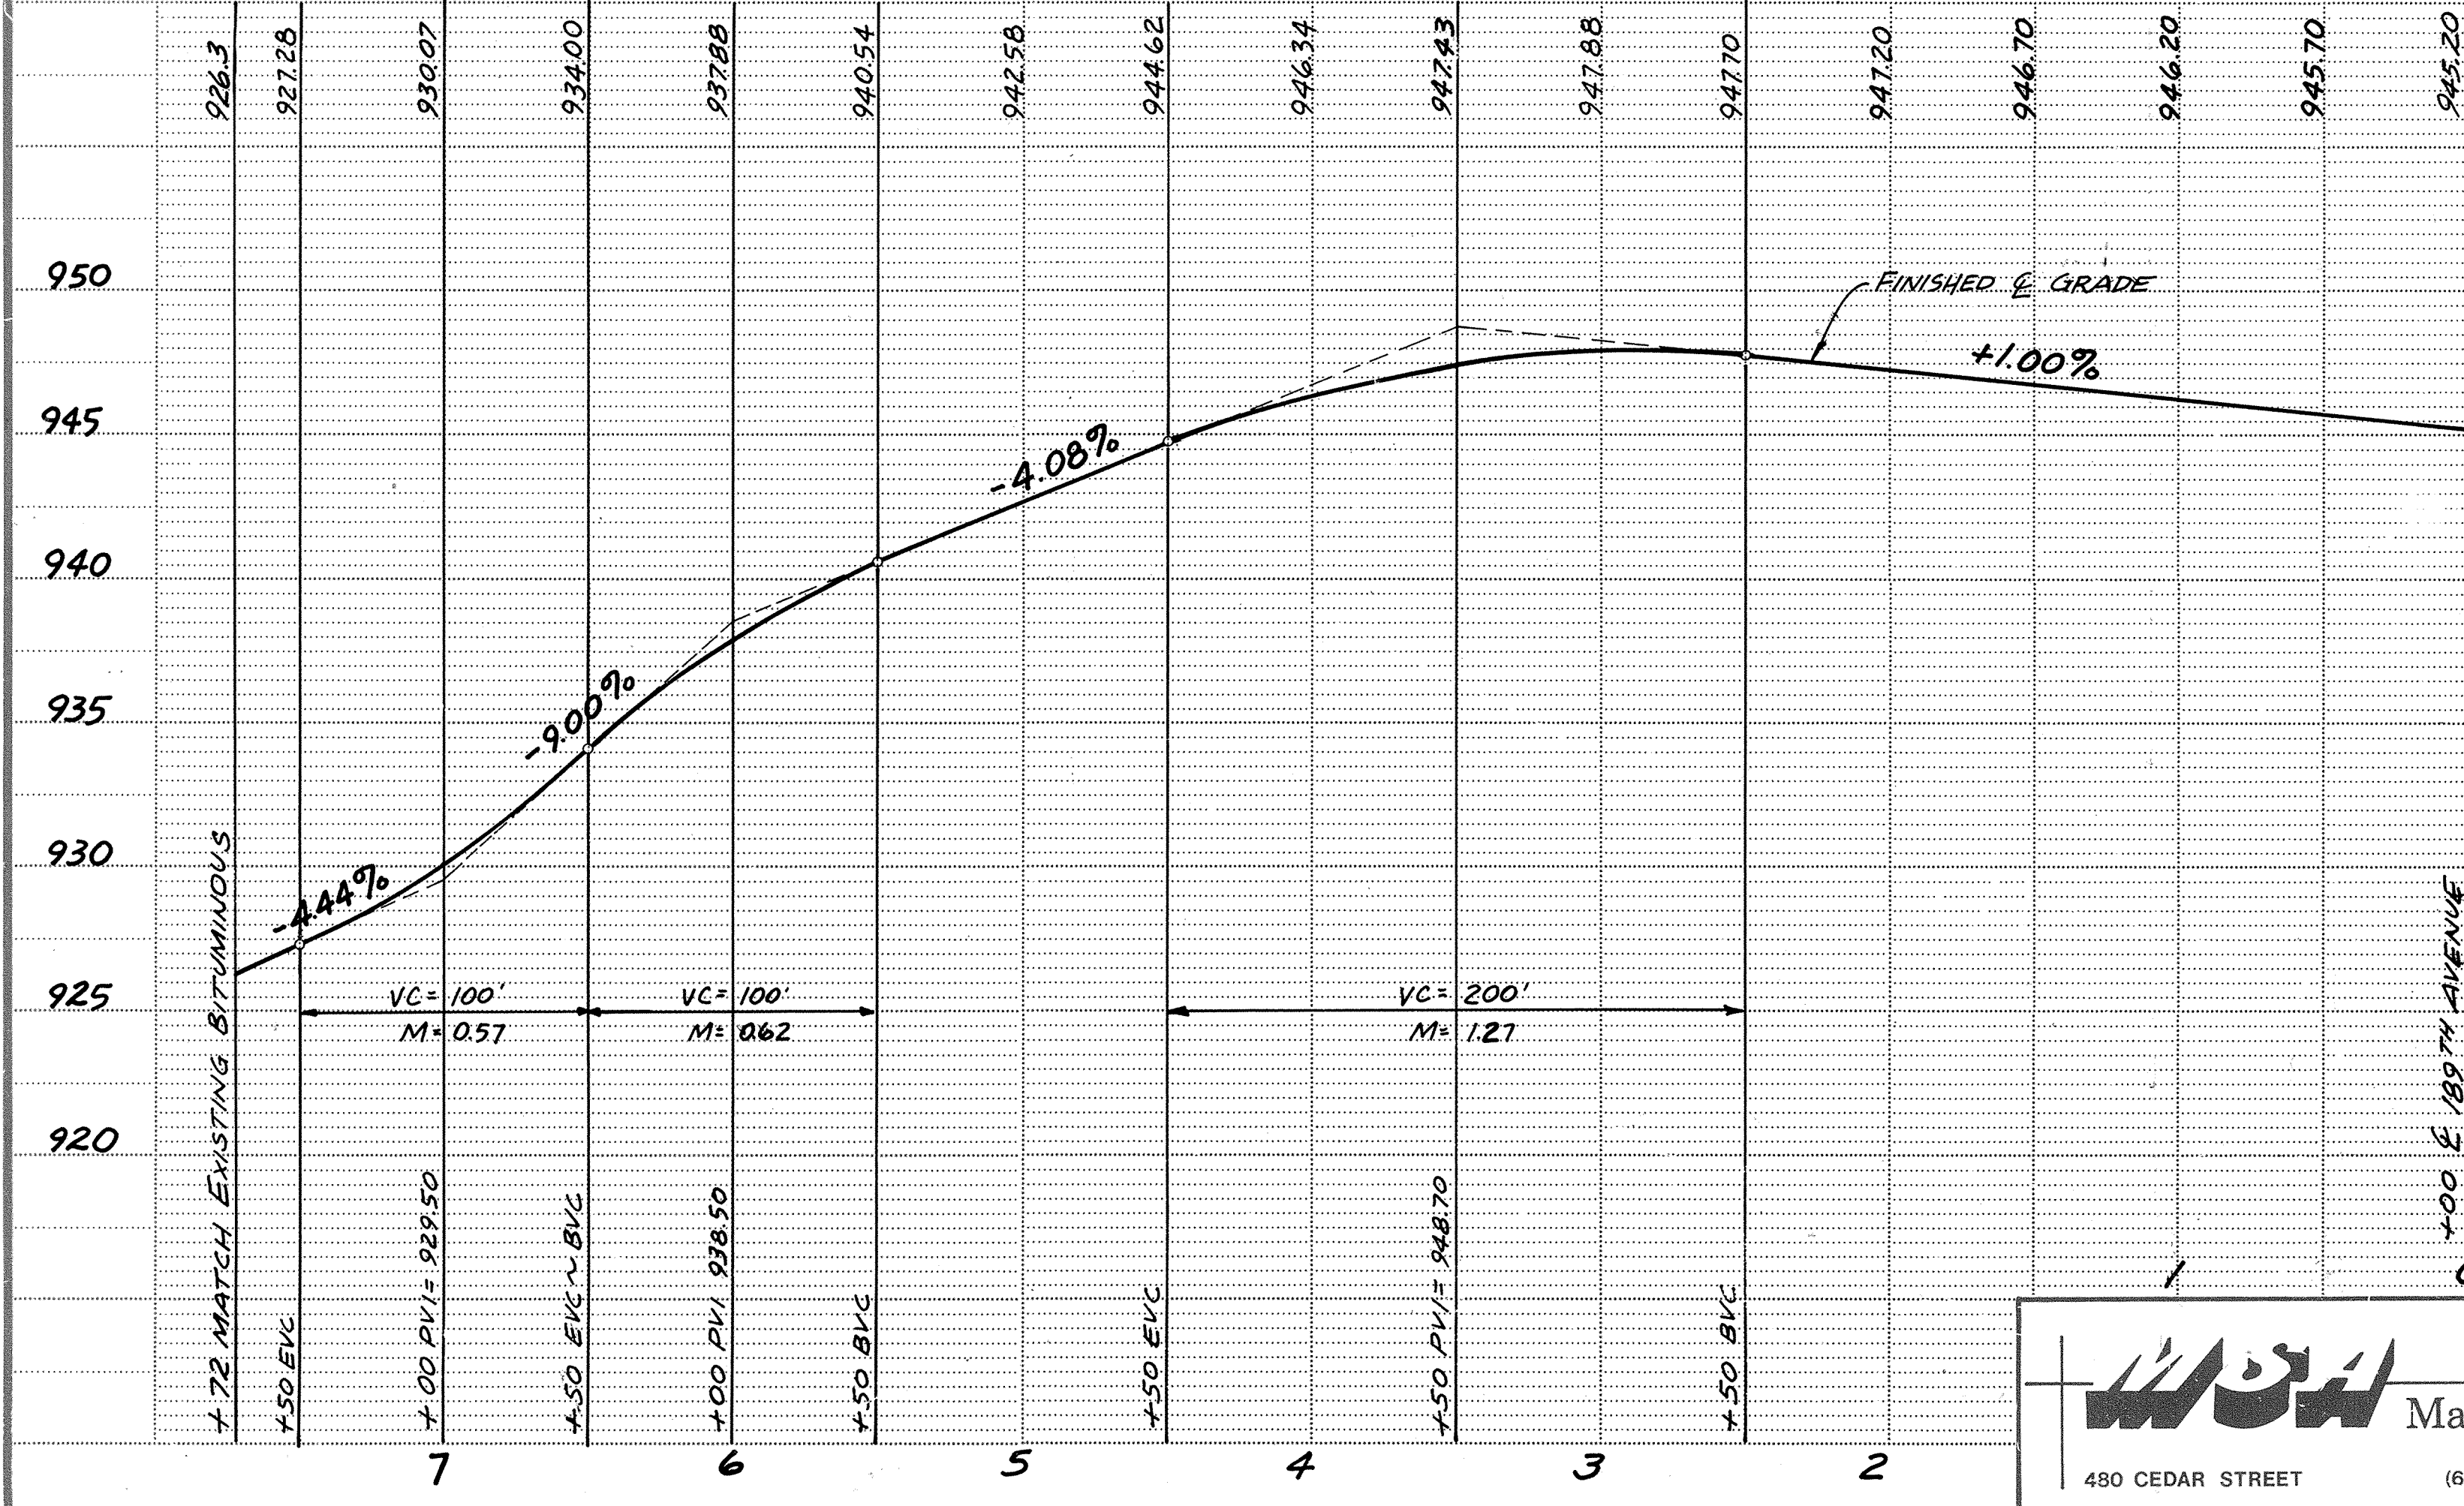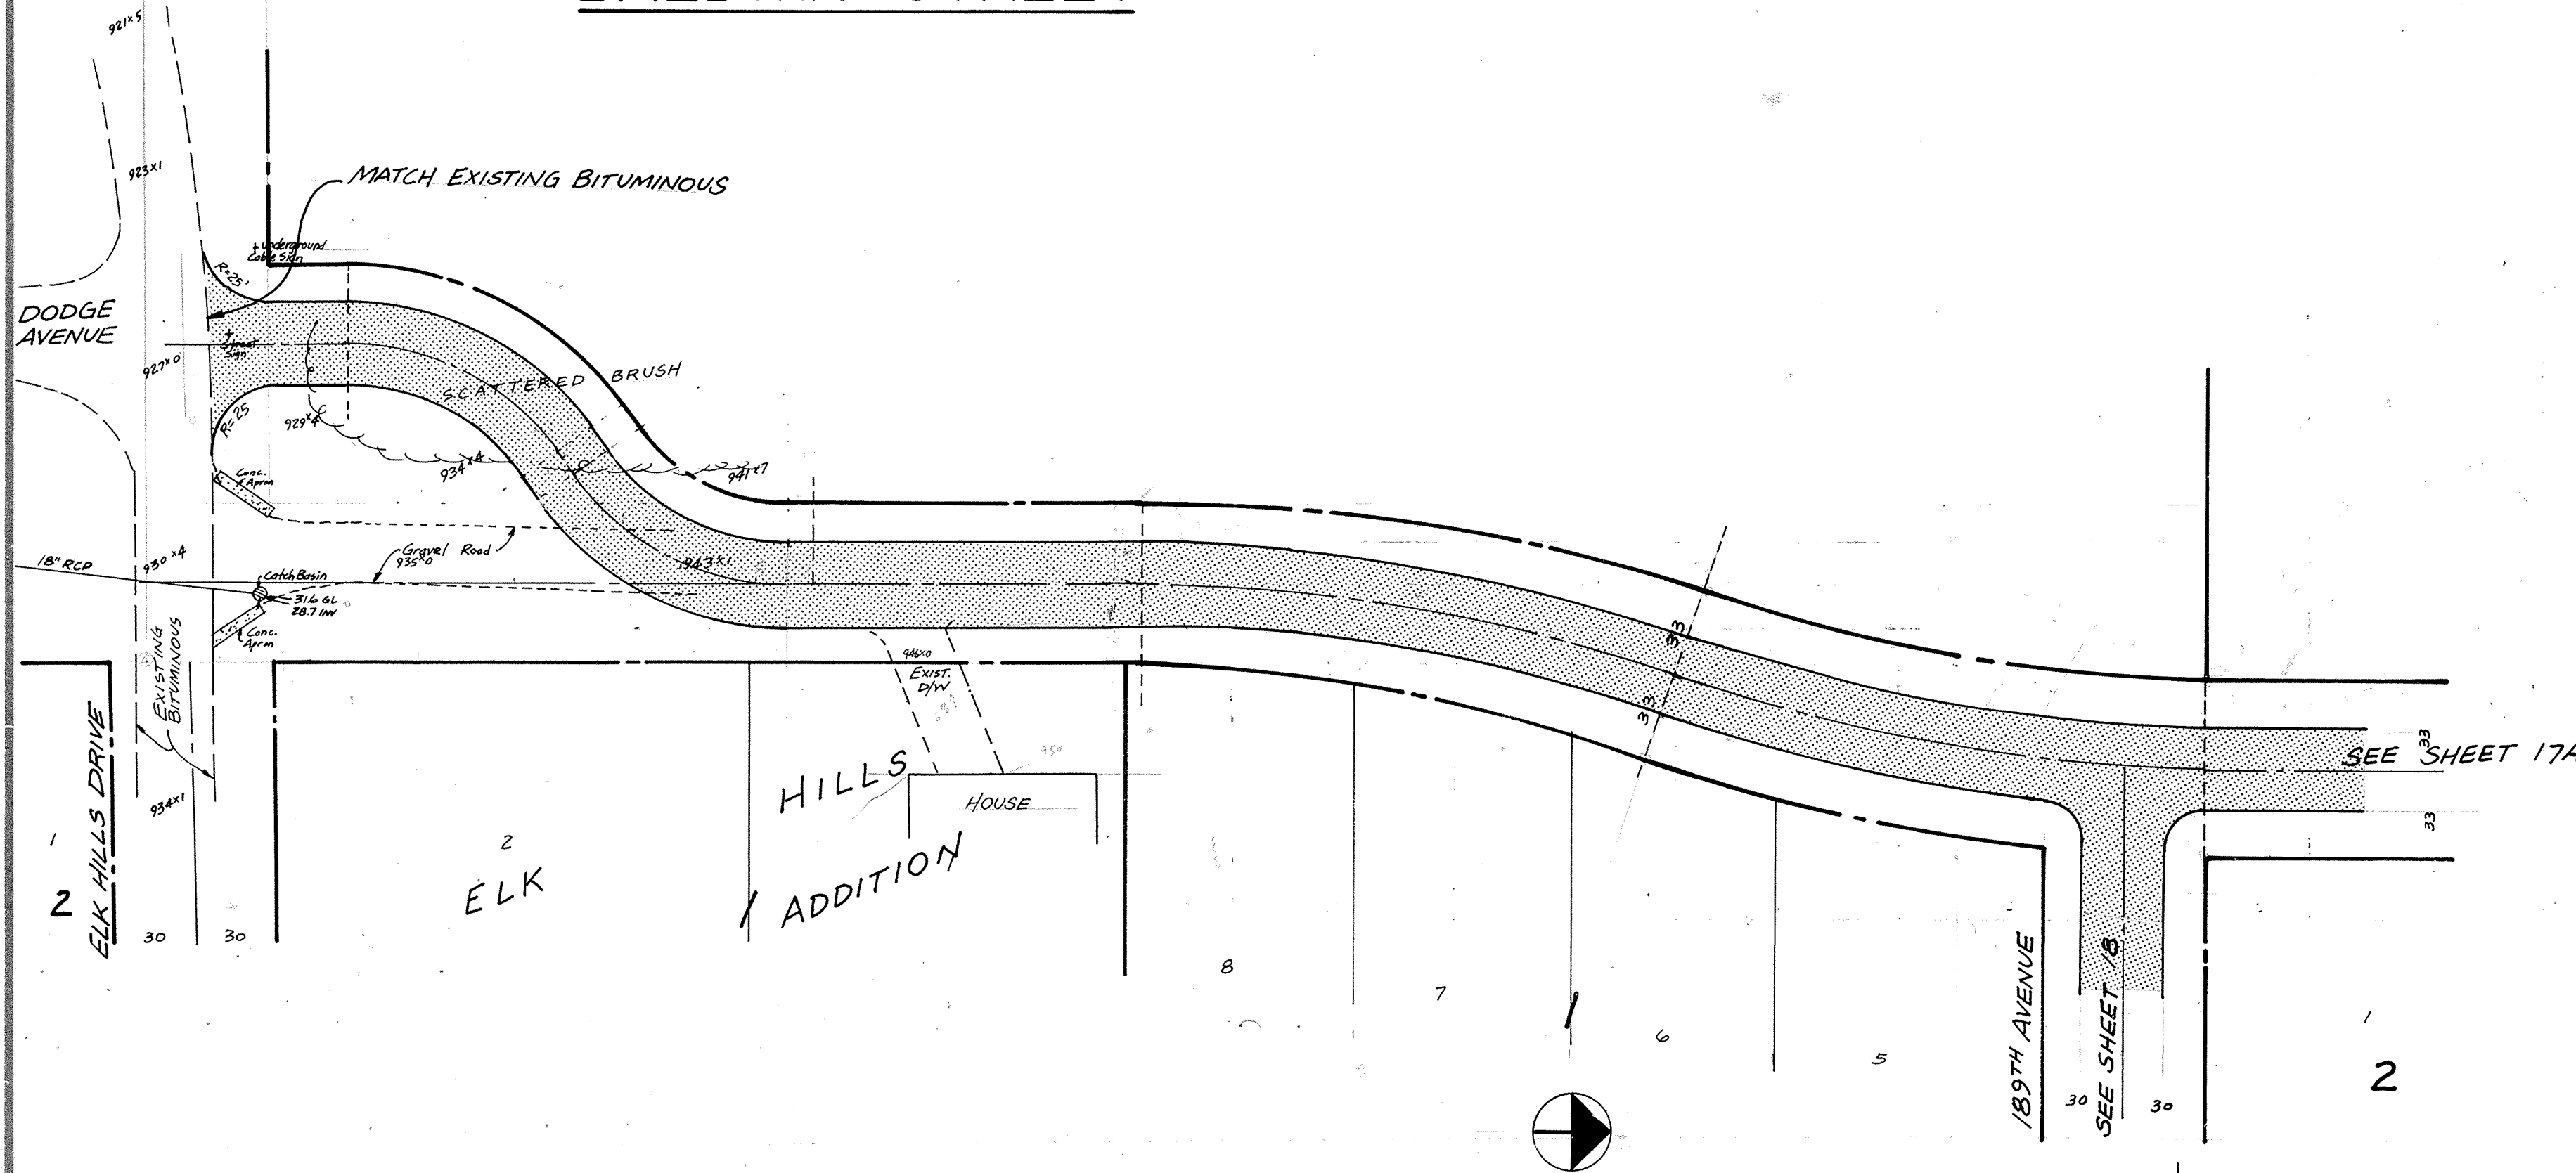

RECORD PLAN NOV 1987



MSA
Maier Stewart & Associates Inc.
CONSULTING ENGINEERS
480 CEDAR STREET (612)227-9475 ST. PAUL, MINNESOTA 55101

REVISIONS	DATE	DESCRIPTION	DESIGNED	CHECKED	DRAWN
	9/17/86	PROFILE			MRJ
			GRAPHIC SCALE		
			0 HORIZ. 50		
			0 VERT. 5		
			CITY OF ELK RIVER		
			DEERFIELD 3RD ADDITION		
			STREET CONSTRUCTION		
			BALDWIN STREET		
			DATE Aug 1986	SHEET 17 OF 31 SHEETS	PROJECT NO. 230-020