
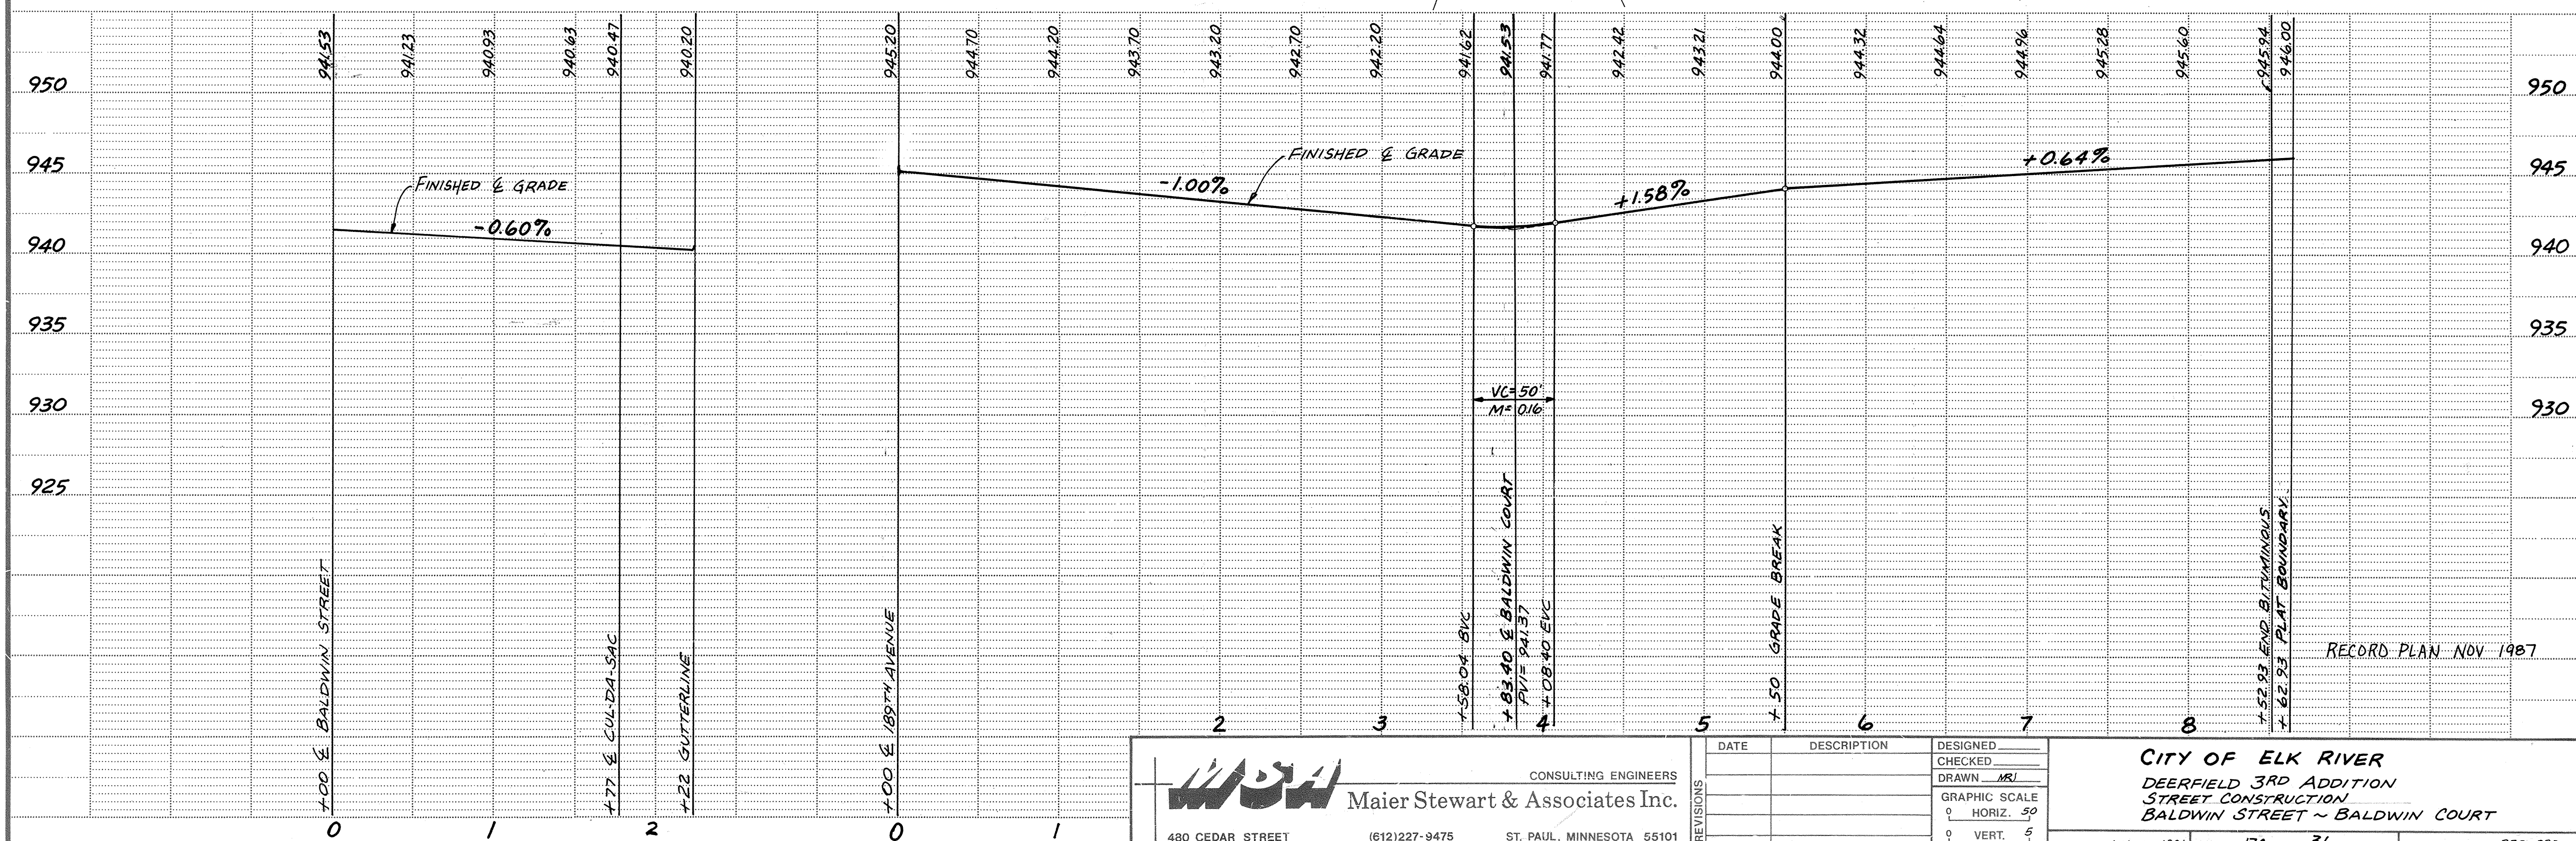


BALDWIN STREET

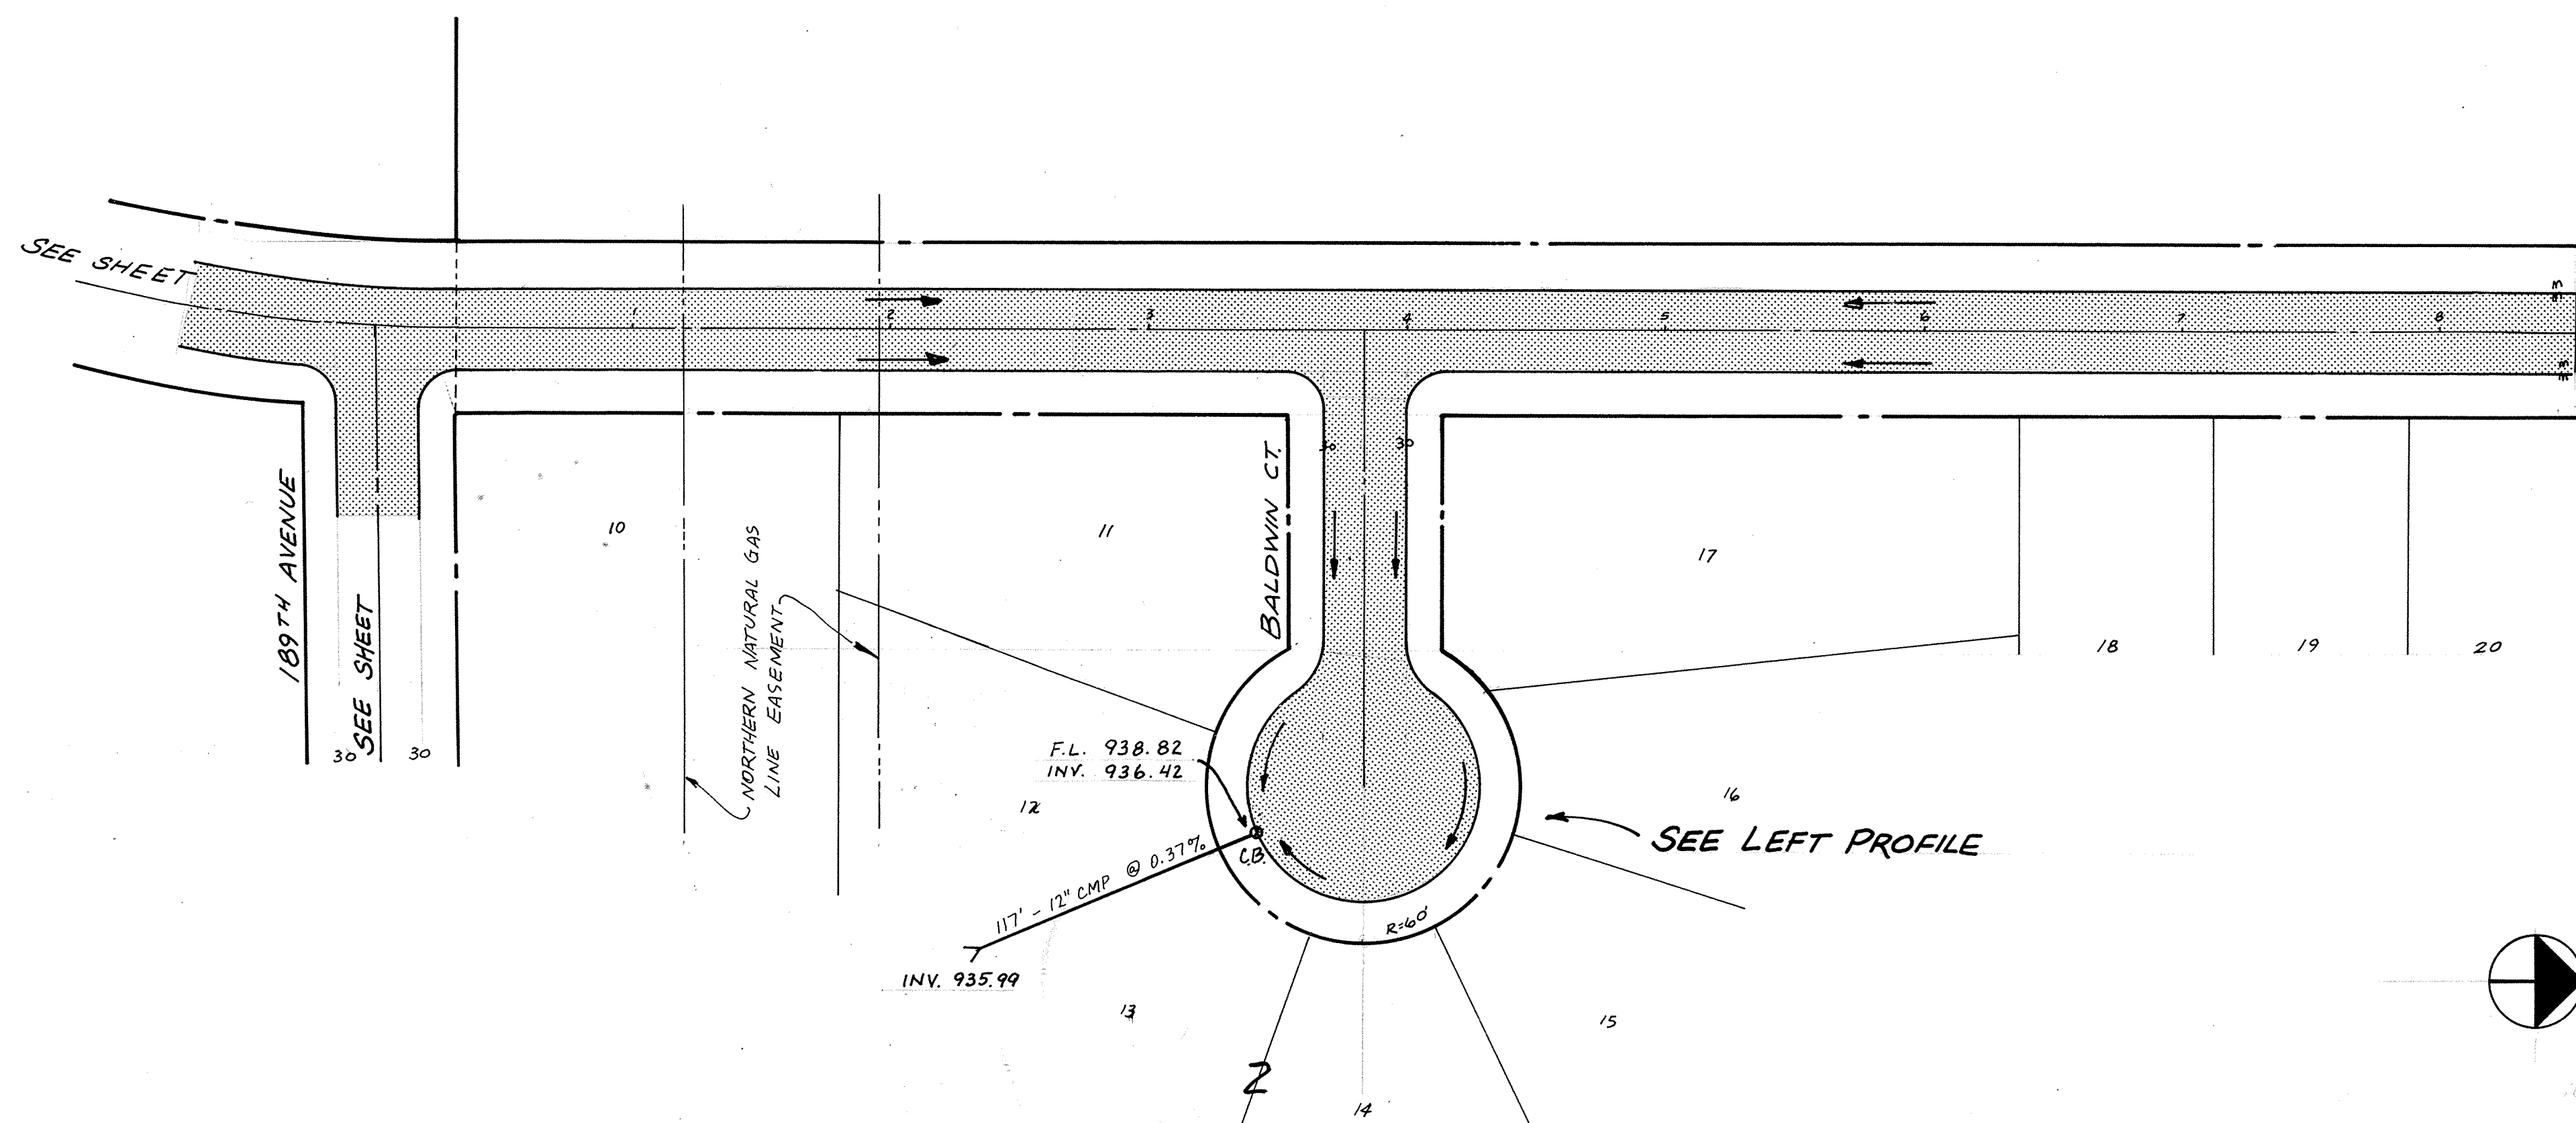

RECORD PLAN NOV 1987

WDA

CONSULTING ENGINEERS

480 CEDAR STREET

(612)227-9475

ST. PAUL, MINNESOTA 55101

REVISIONS	DATE	DESCRIPTION	DESIGNED
			CHECKED
			DRAWN <u>MRJ</u>
			GRAPHIC SCALE
			0 HORIZ. <u>50</u>
			0 VERT. <u>5</u>

CITY OF ELK RIVER
DEERFIELD 3RD ADDITION
STREET CONSTRUCTION
BALDWIN STREET ~ BALDWIN COURT

DATE <u>AUGUST 1986</u>	SHEET <u>17A</u> OF <u>31</u> SHEETS	PROJECT NO. <u>230-020</u>
-------------------------	--------------------------------------	----------------------------