
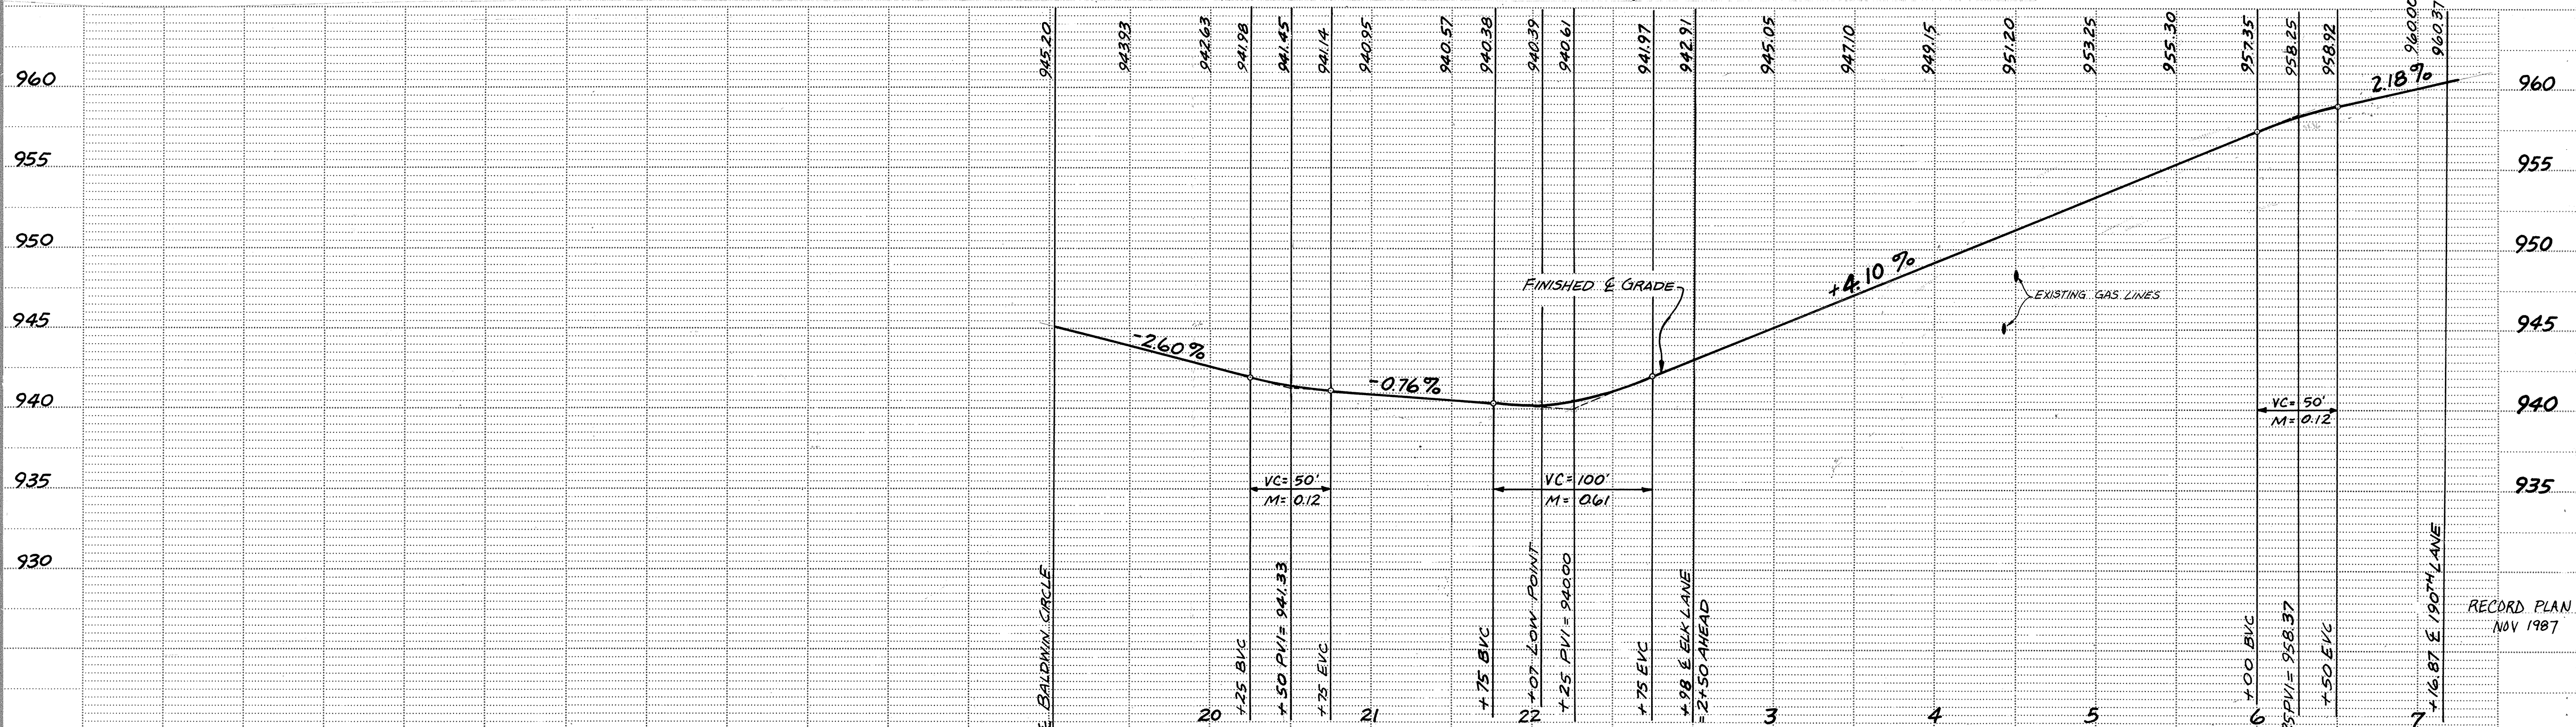


U.S. HIGHWAY NO. 169

189TH AVENUE

ZANE STREET

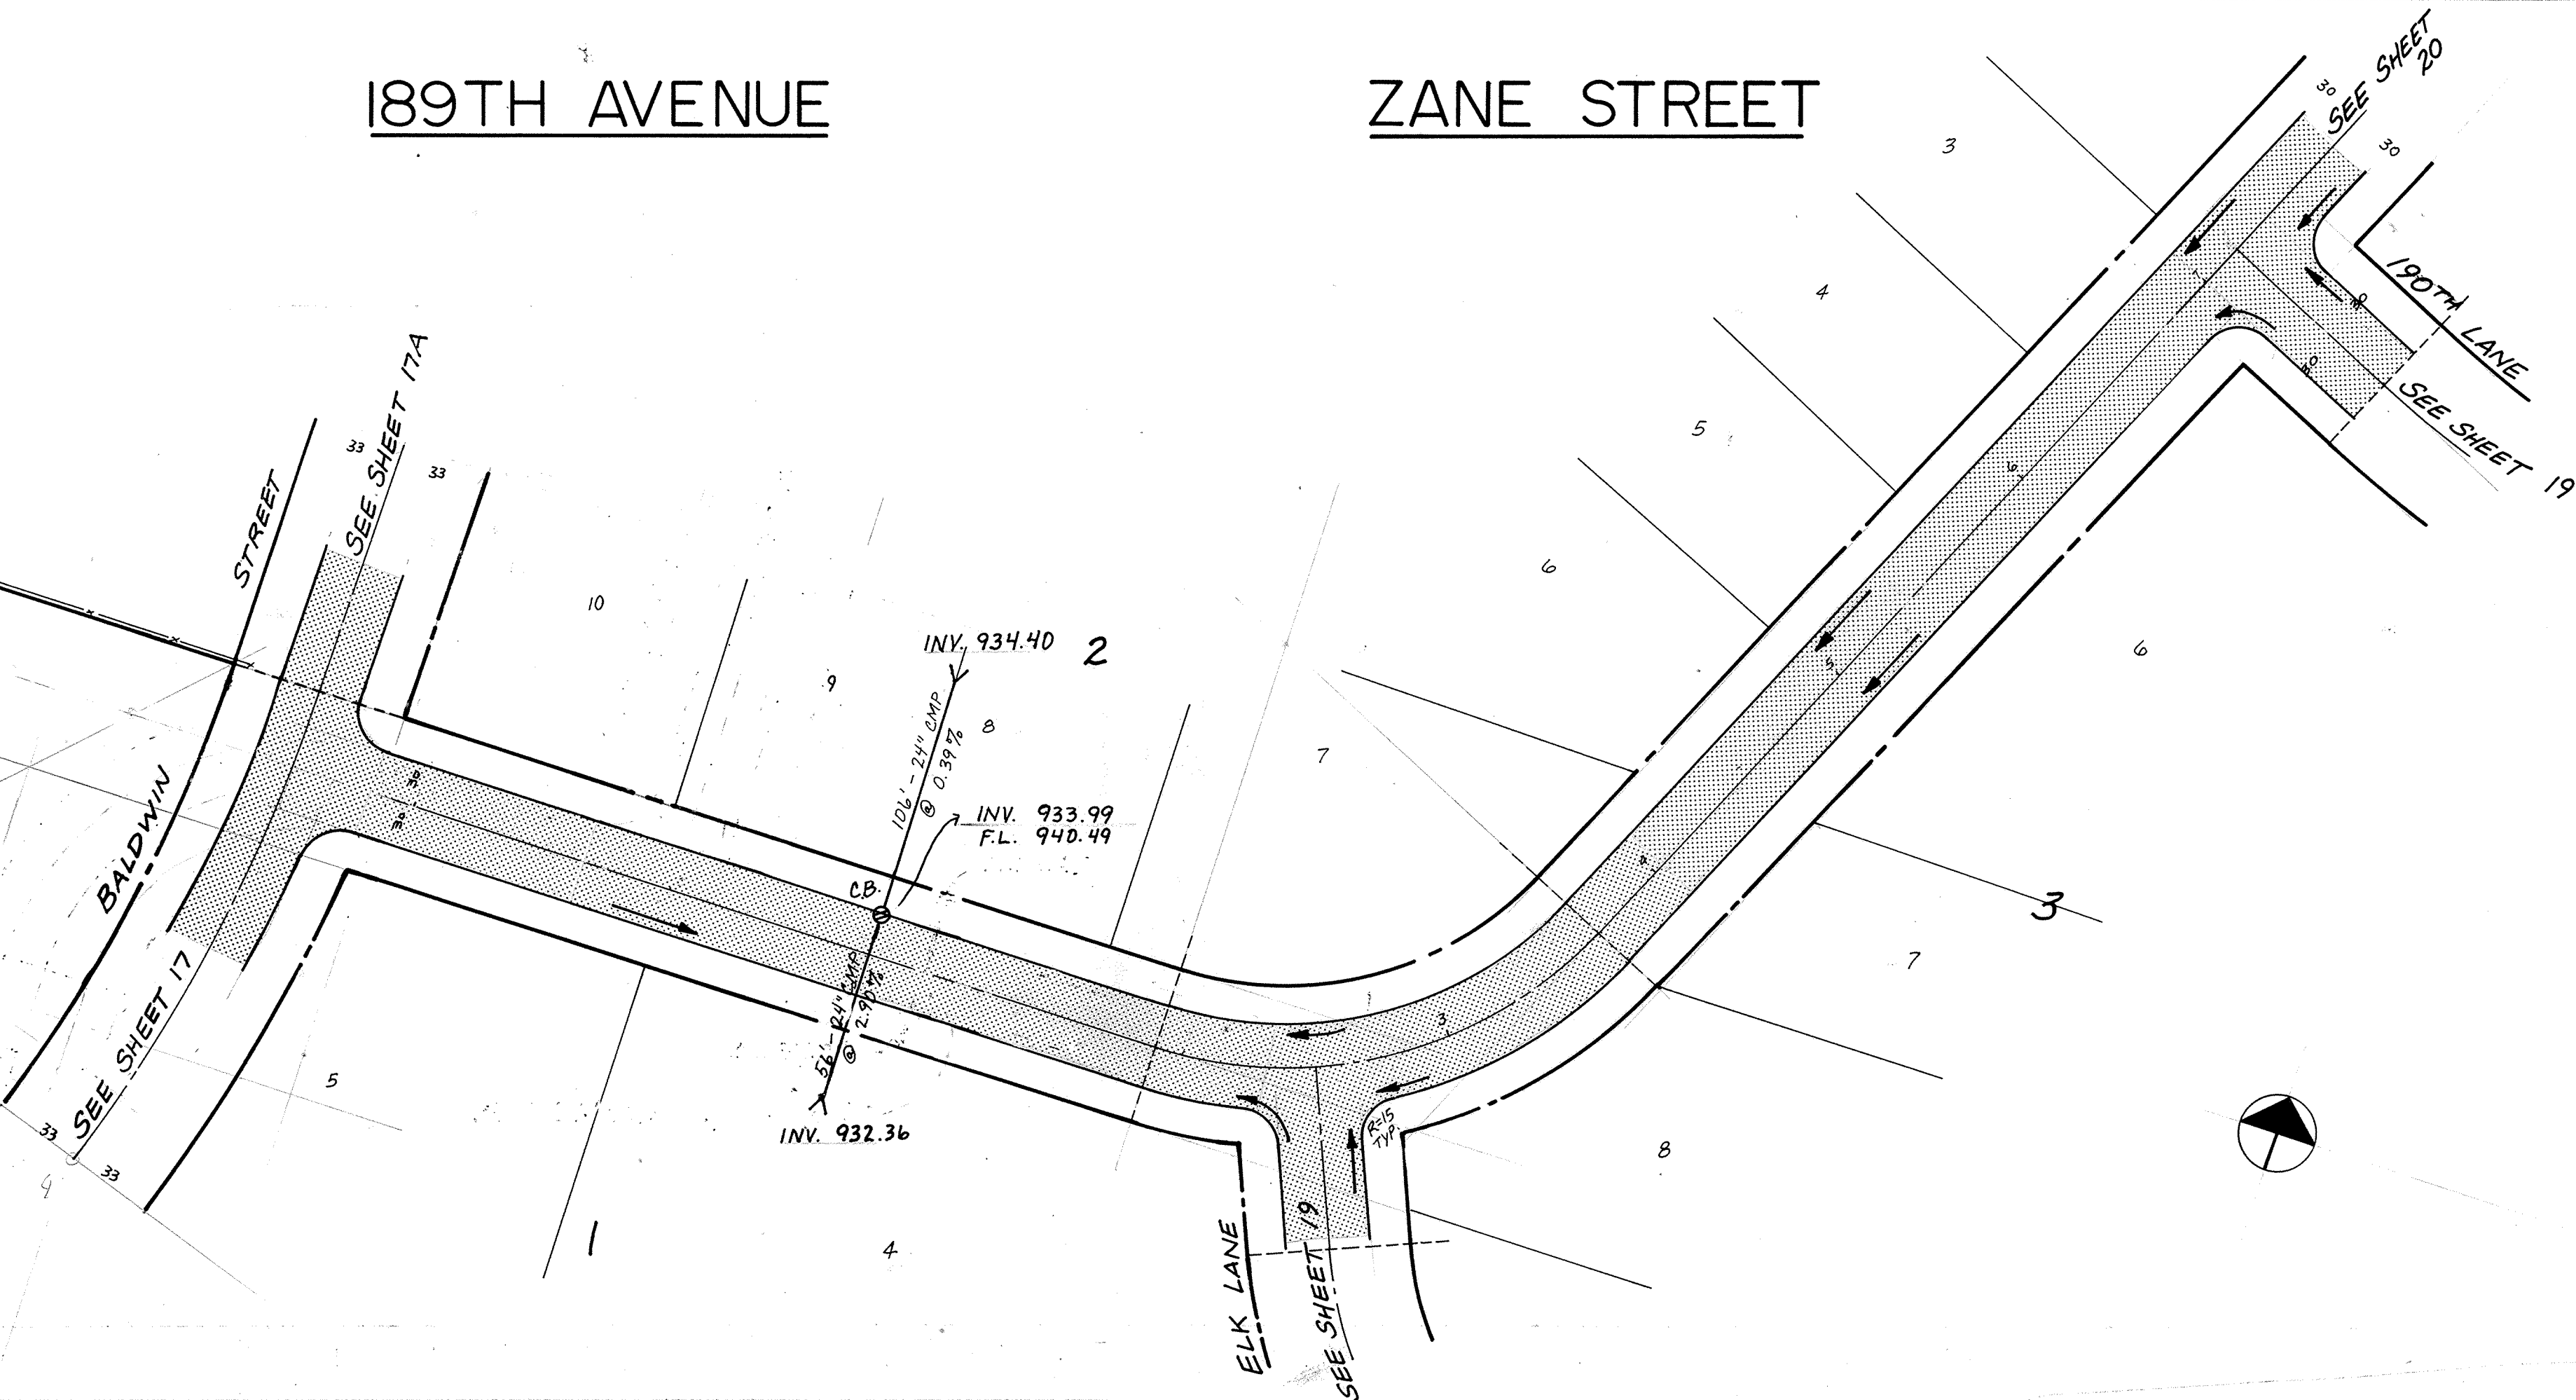

480 CEDAR STREET (612)227-9475 ST. PAUL, MINNESOTA 55101

CONSULTING ENGINEERS

Maier Stewart & Associates Inc.

REVISIONS

DATE	DESCRIPTION
8/14/86	PROFILE

DESIGNED
CHECKED
DRAWN <i>MR</i>
GRAPHIC SCALE
0 HORIZ. 50
0 VERT. 5

CITY OF ELK RIVER
DEERFIELD 3RD ADDITION
STREET CONSTRUCTION
189TH AVENUE ~ ZANE STREET

DATE AUG 1986 SHEET 18 OF 31 SHEETS PROJECT NO. 230-020

RECORD PLAN
NOV 1987

DRAWING NUMBER

DRAWING NUMBER

DRAWING NUMBER

DRAWING NUMBER
DEERF3.86
18

STANDARD PRODUCTS • NEW HAVEN, CONNECTICUT
REPRODUCED BY PLAN NUMBER 8833