
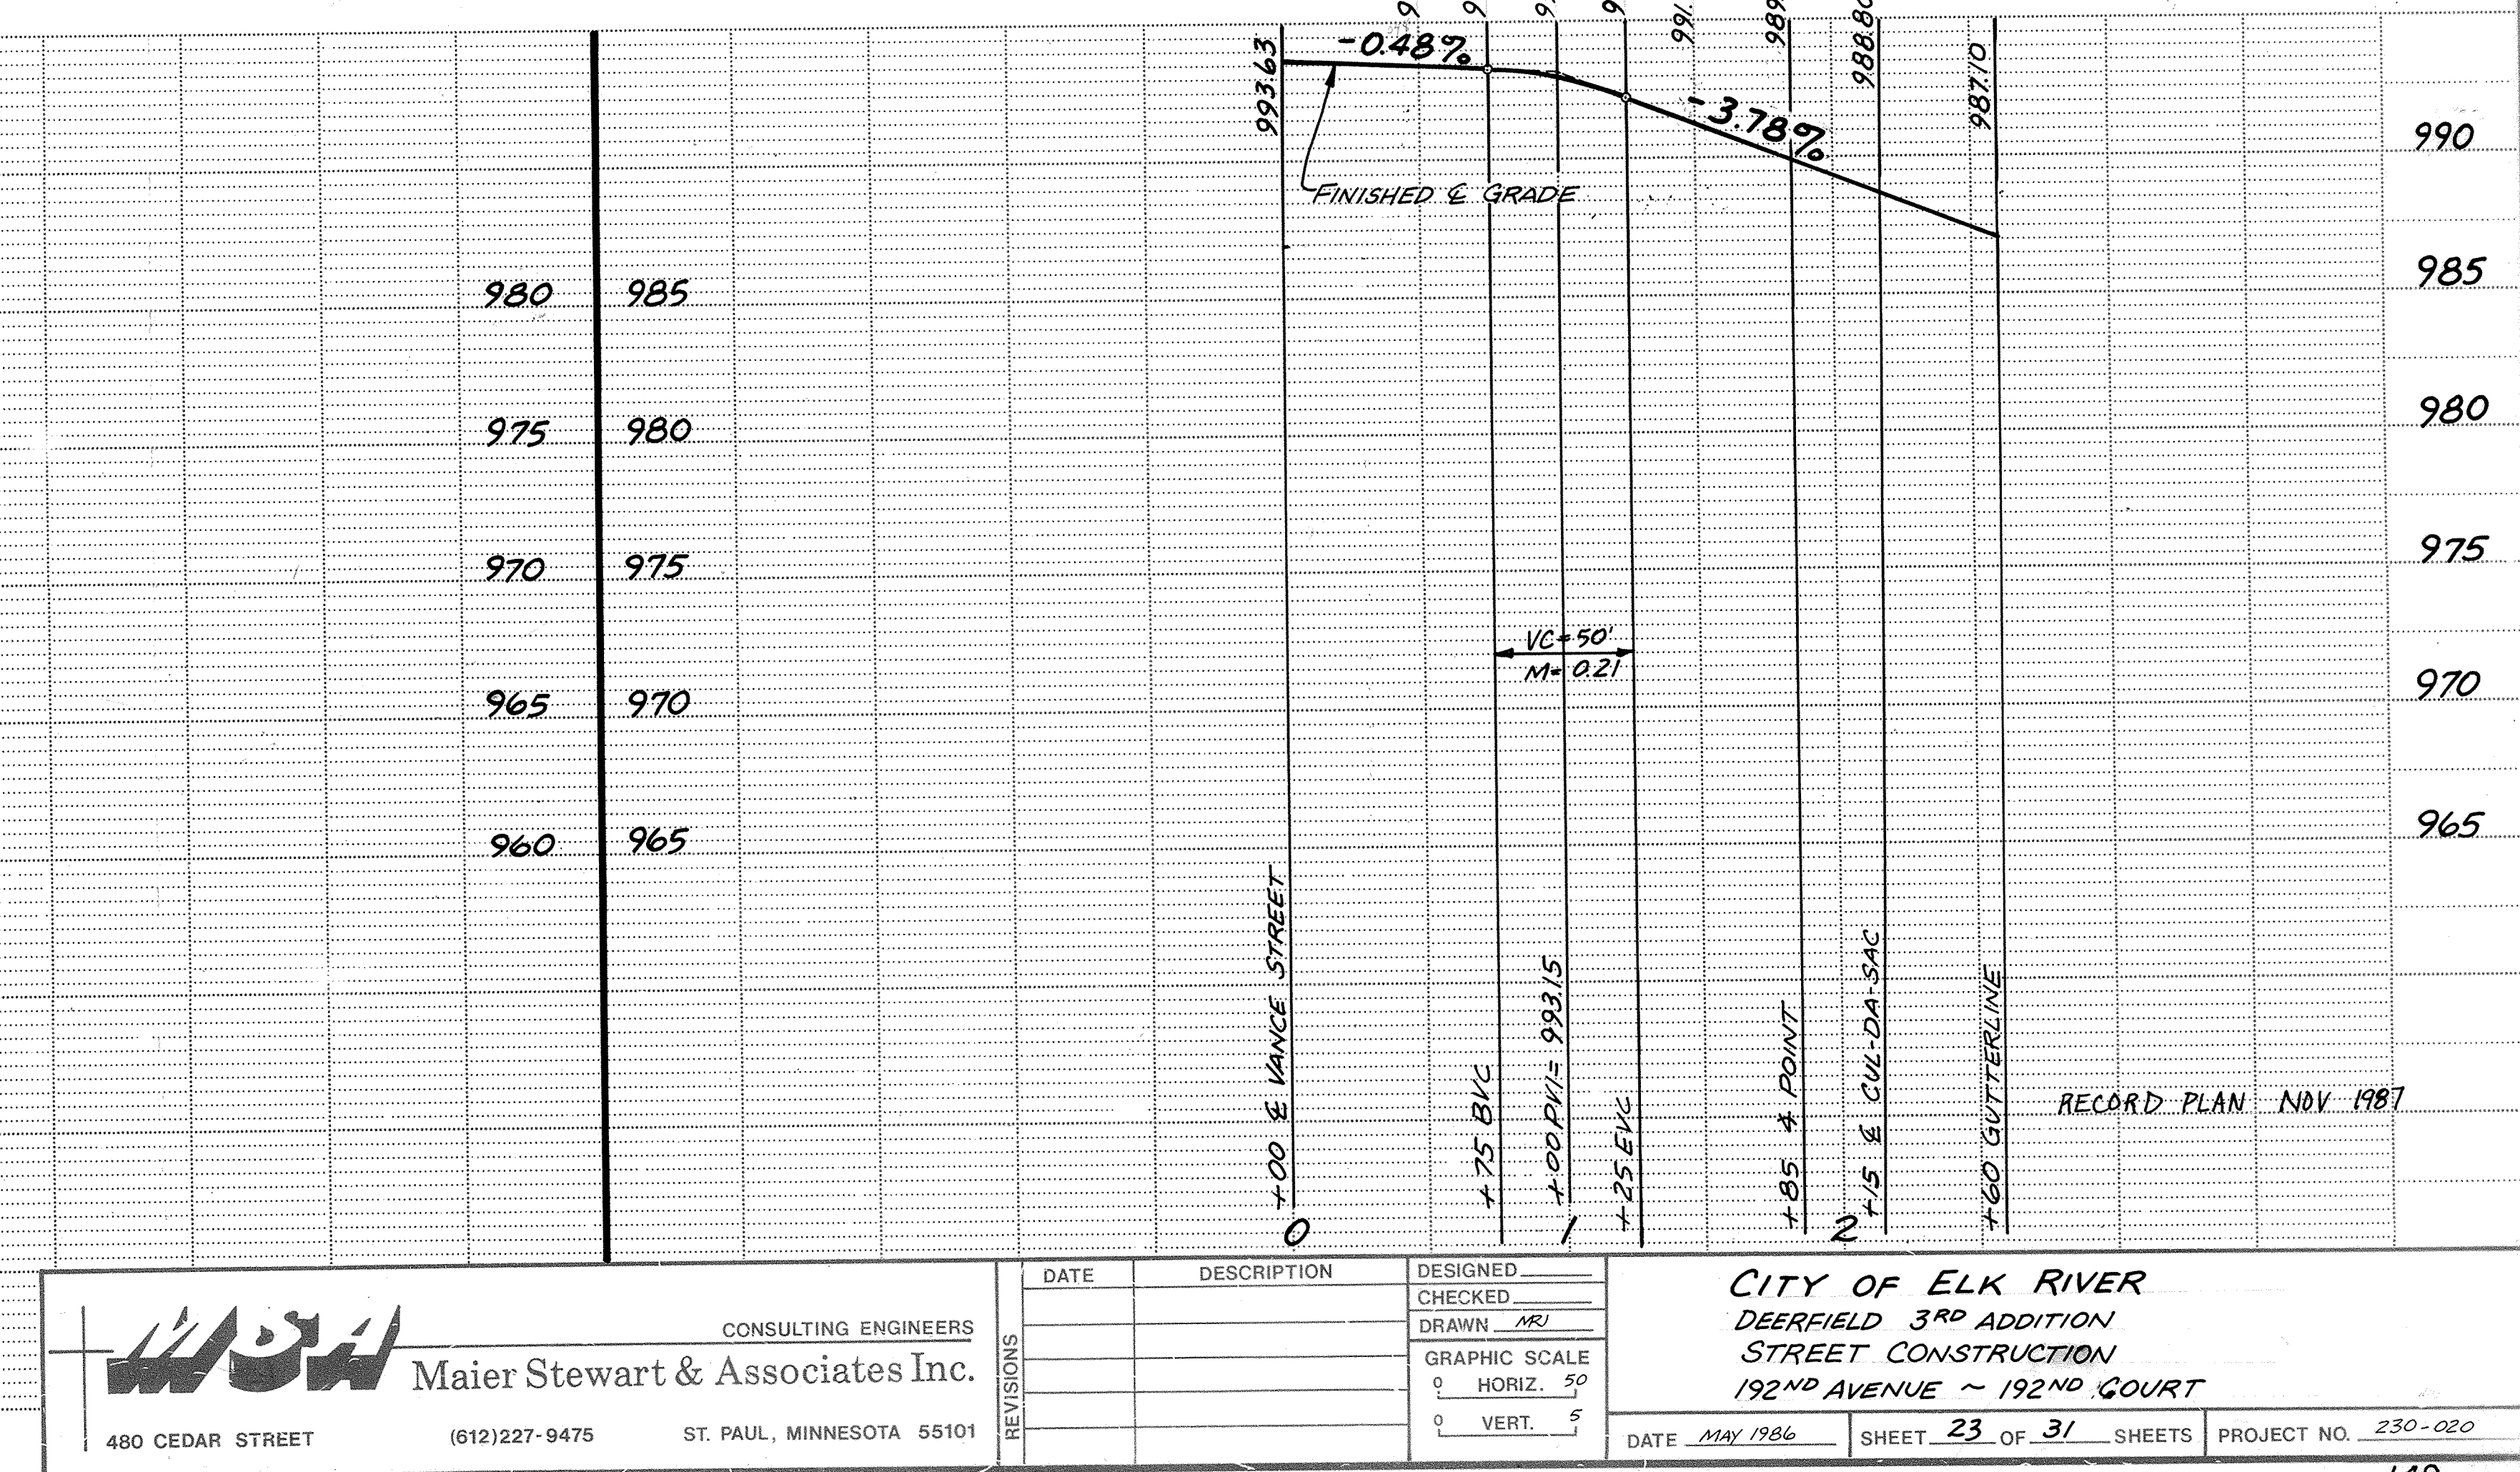
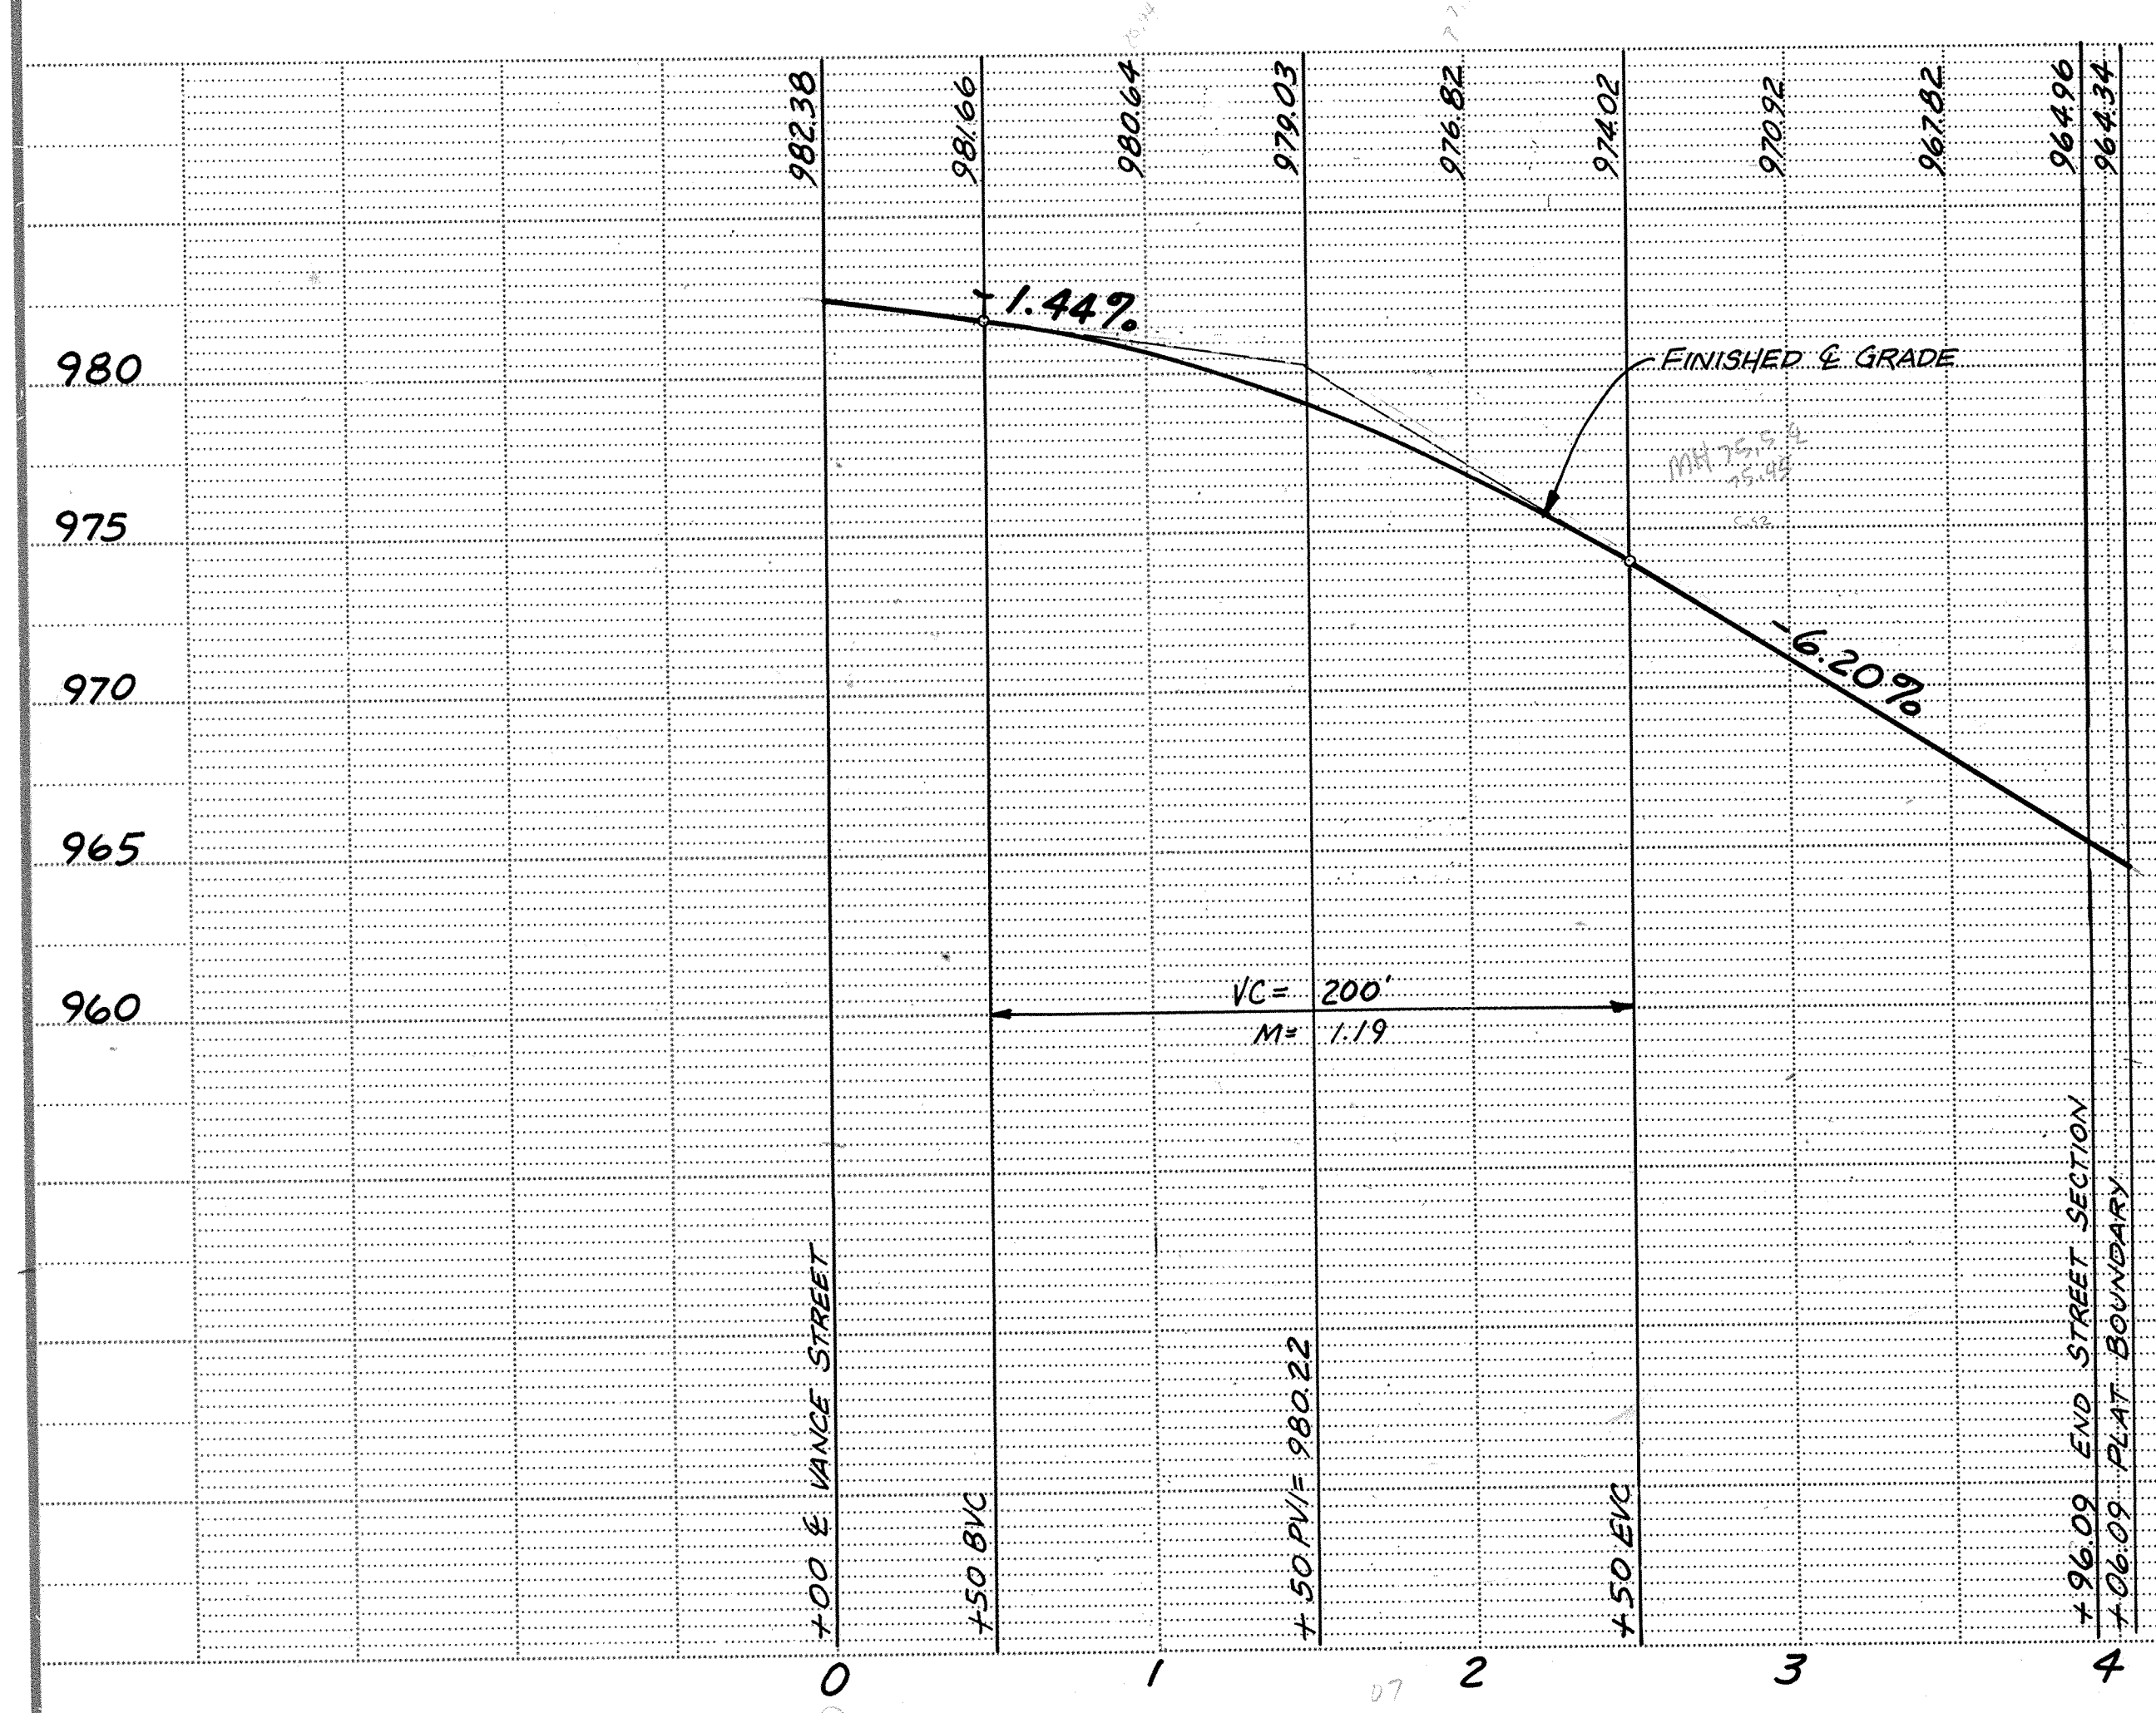
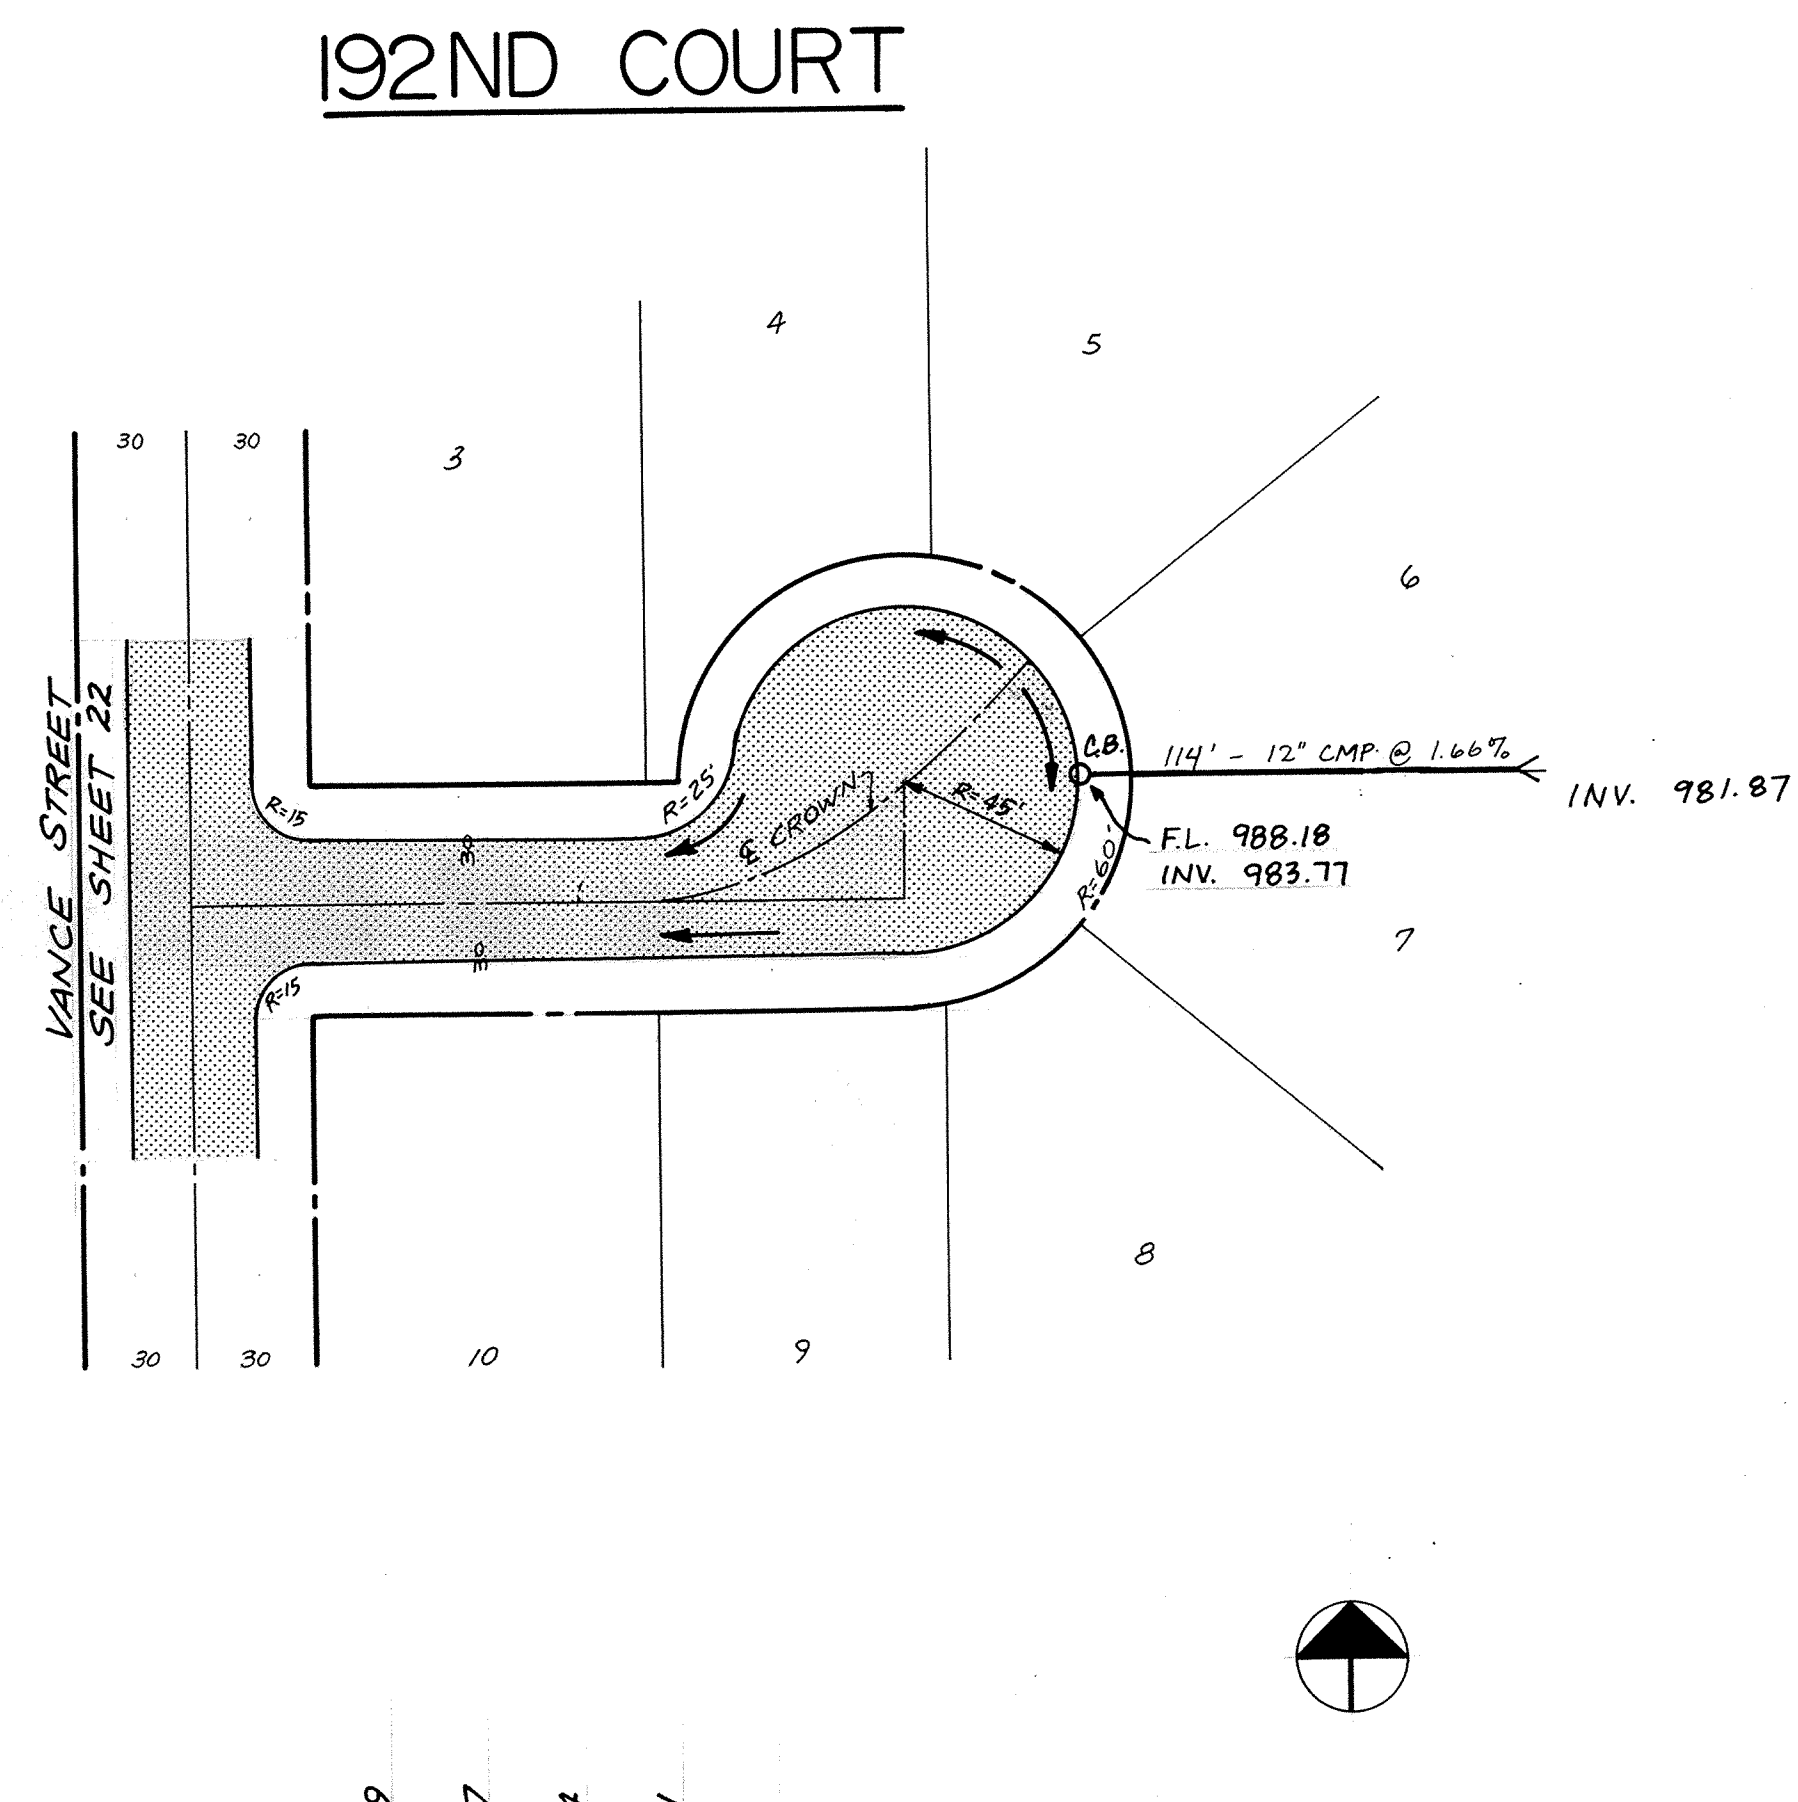


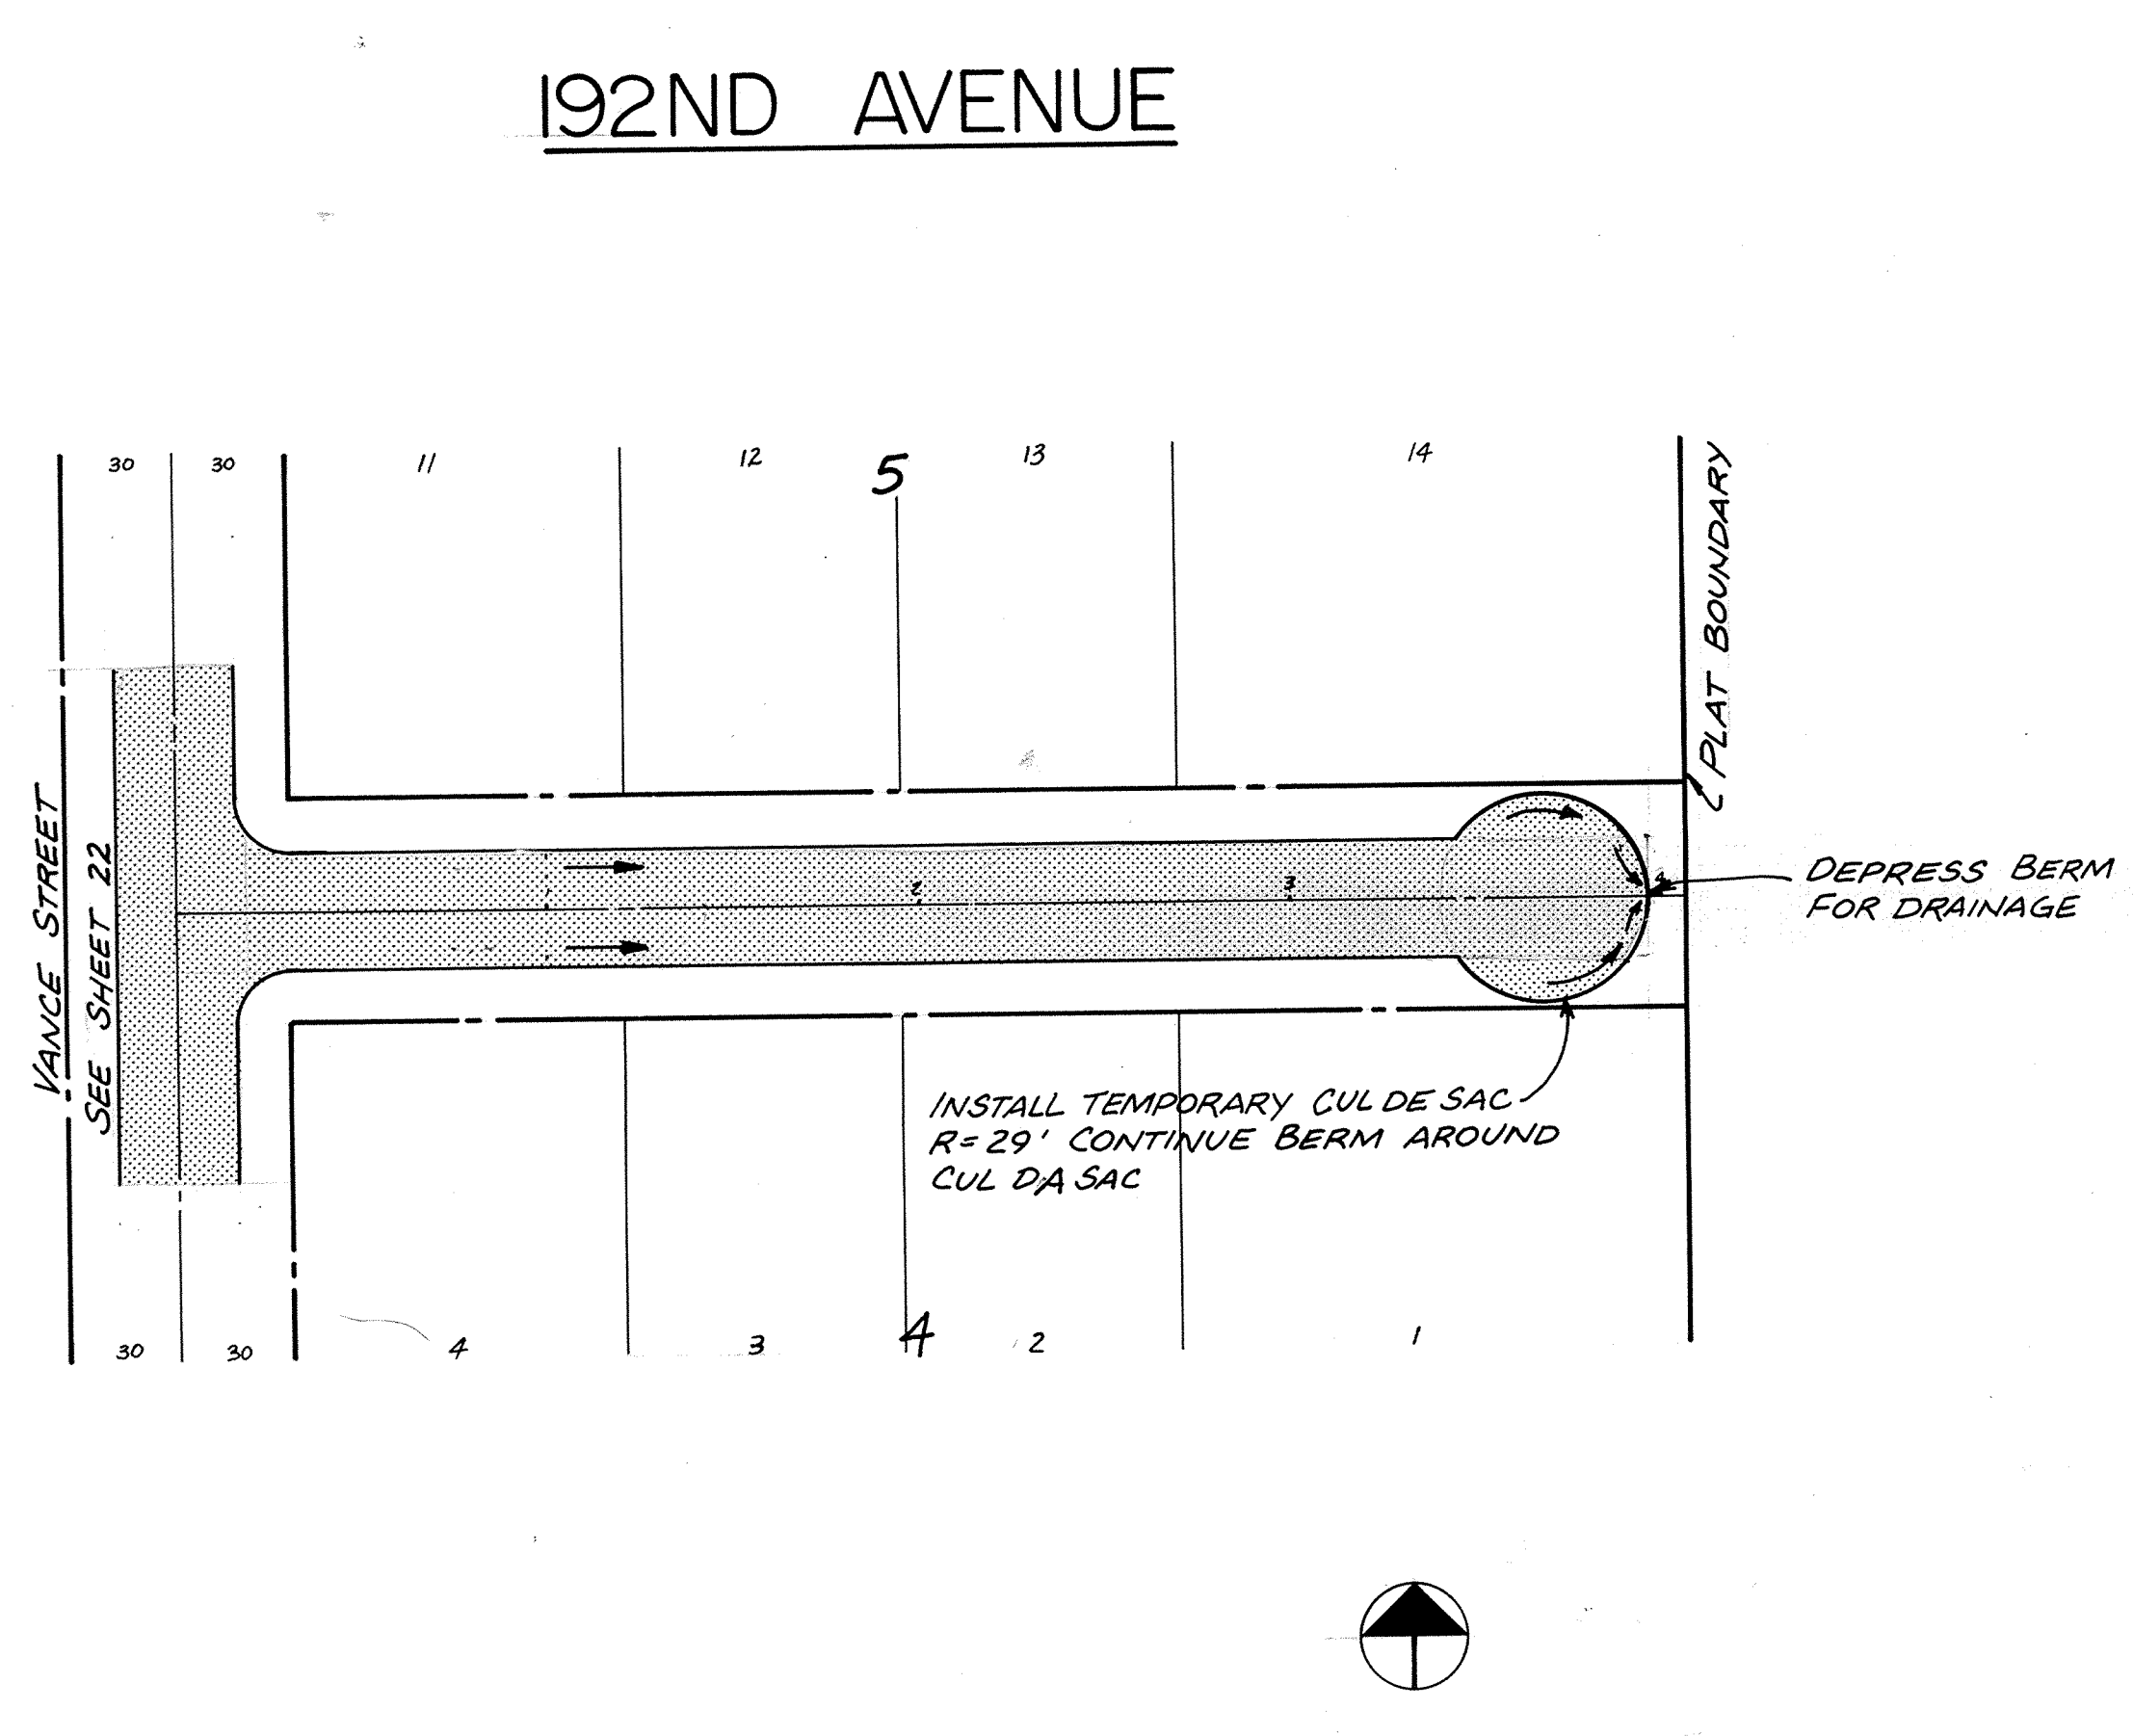

MSA CONSULTING ENGINEERS Maier Stewart & Associates Inc. 480 CEDAR STREET (612) 227-9475 ST. PAUL, MINNESOTA 55101		DESIGNED CHECKED DRAWN <u>MRJ</u> GRAPHIC SCALE 0 HORIZ. 50 0 VERT. 5	CITY OF ELK RIVER DEERFIELD 3RD ADDITION STREET CONSTRUCTION 192ND AVENUE ~ 192ND COURT DATE <u>MAY 1986</u> SHEET <u>23</u> OF <u>31</u> SHEETS PROJECT NO. <u>230-020</u>
---	--	--	---