
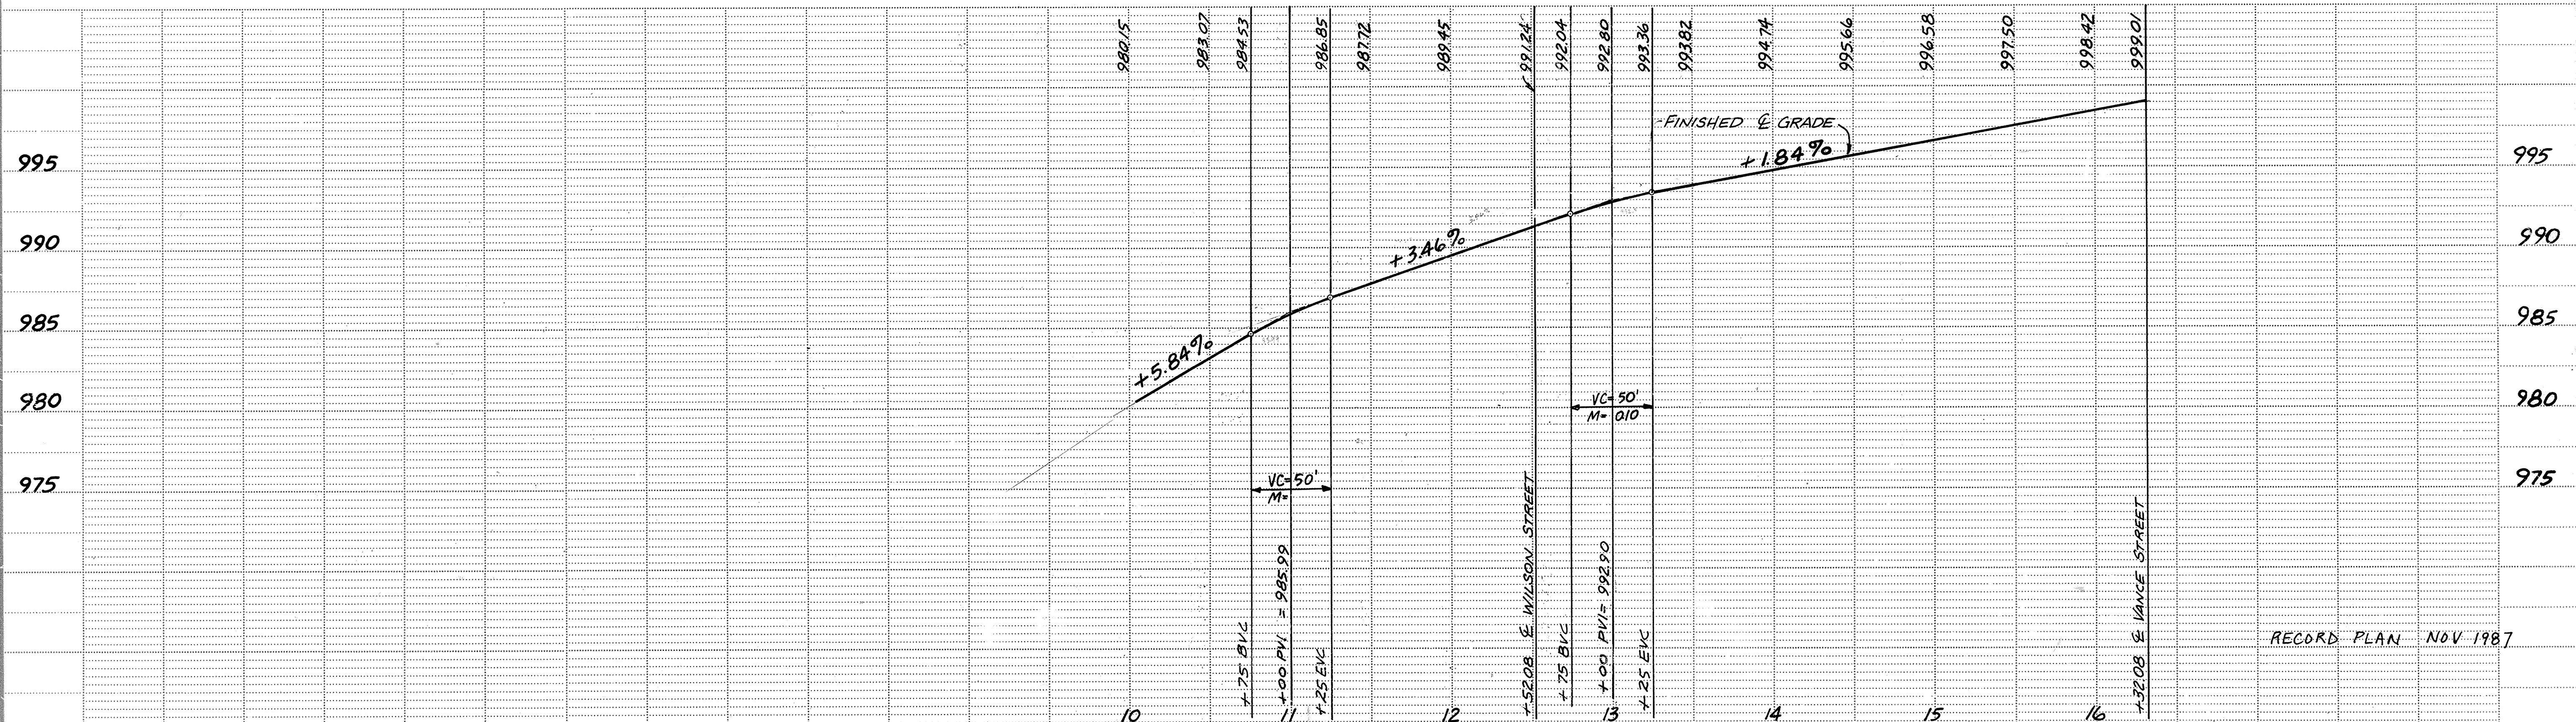


193RD AVENUE

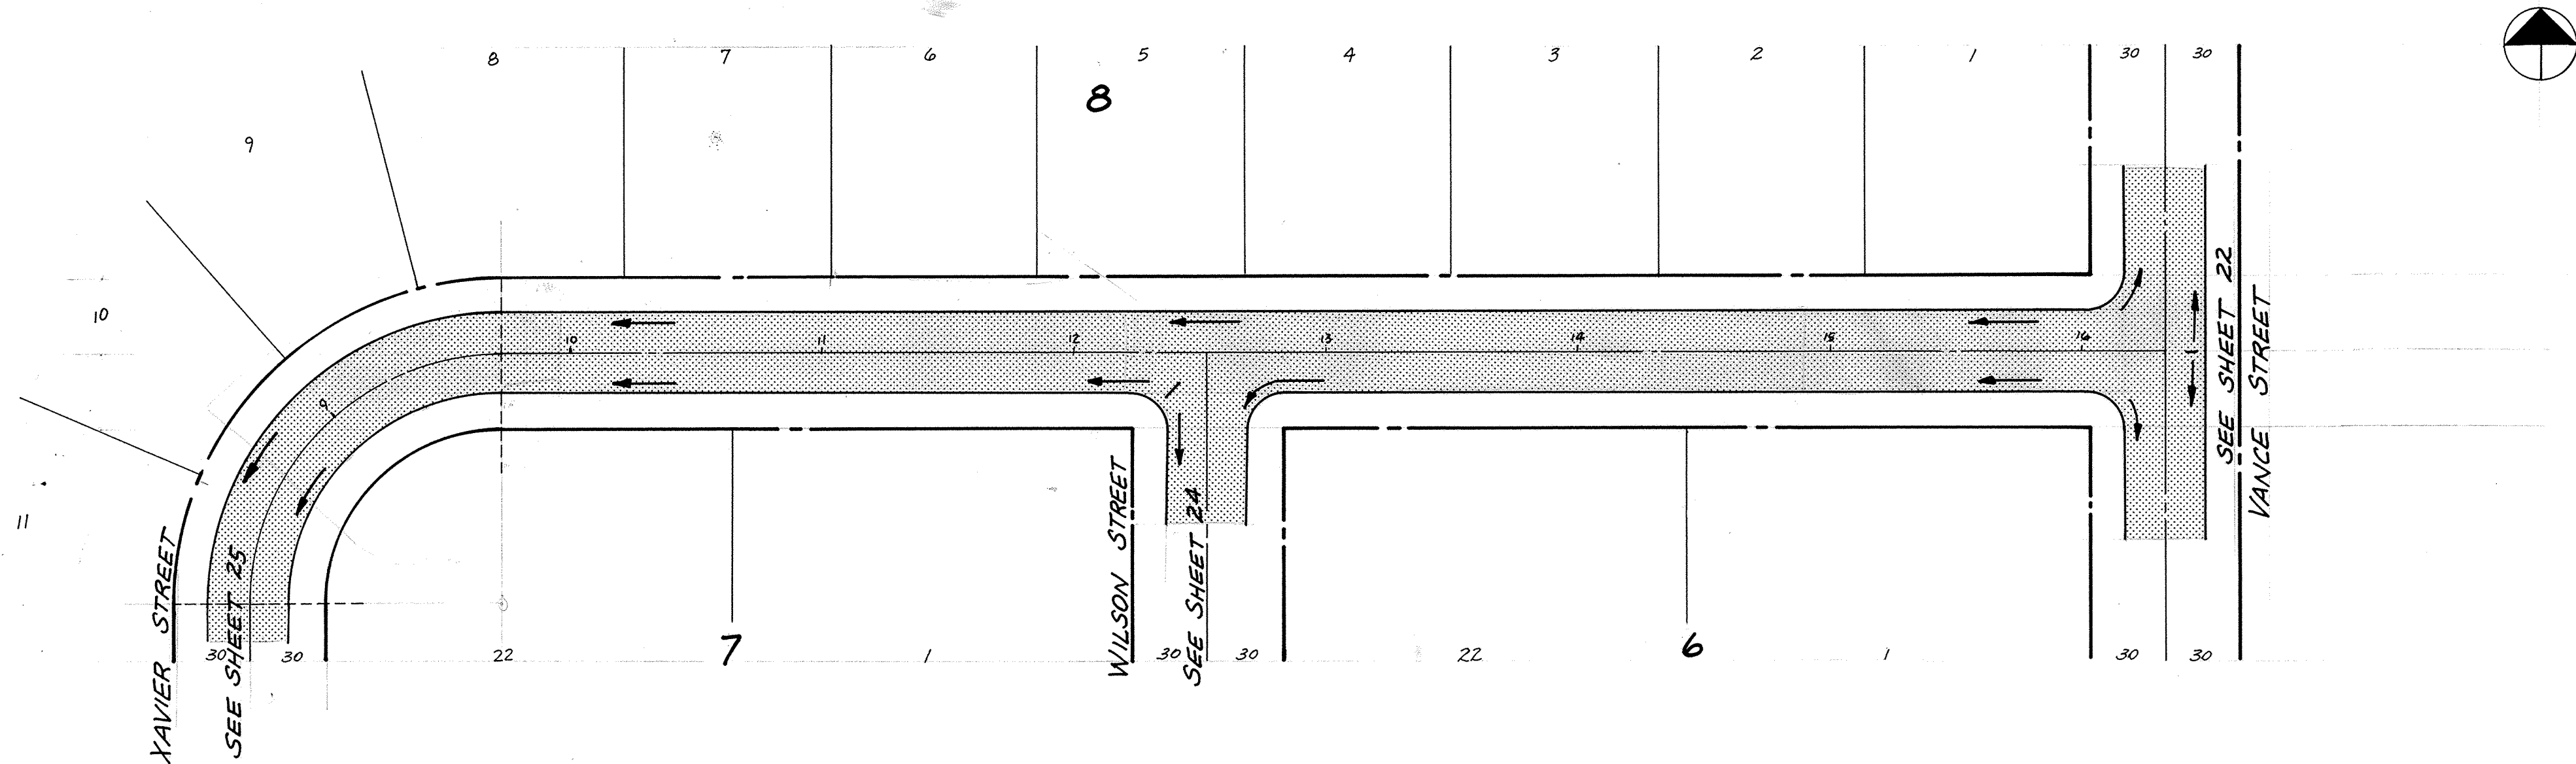

 CONSULTING ENGINEERS Maier Stewart & Associates Inc. 480 CEDAR STREET (612) 227-9475 ST. PAUL, MINNESOTA 55101	DATE 8/24/86	DESCRIPTION PROFILE	DESIGNED CHECKED DRAWN GRAPHIC SCALE 0 HORIZ. 50 0 VERT. 5	CITY OF ELK RIVER DEERFIELD 3RD ADDITION STREET CONSTRUCTION 193RD AVENUE DATE MAY 1986 SHEET 26 OF 31 SHEETS PROJECT NO. 230-020	
	REVISIONS				