

DRAWING NUMBER

DRAWING NUMBER

DRAWING NUMBER

DRAWING NUMBER



SACD PRODUCTS • NEW HAVEN, CONNECTICUT
REORDER BY PART NUMBER 6553

SACD PRODUCTS • NEW HAVEN, CONNECTICUT
REORDER BY PART NUMBER 6553

SACD PRODUCTS • NEW HAVEN, CONNECTICUT
REORDER BY PART NUMBER 6553

SACD PRODUCTS • NEW HAVEN, CONNECTICUT
REORDER BY PART NUMBER 6553

192ND AVENUE

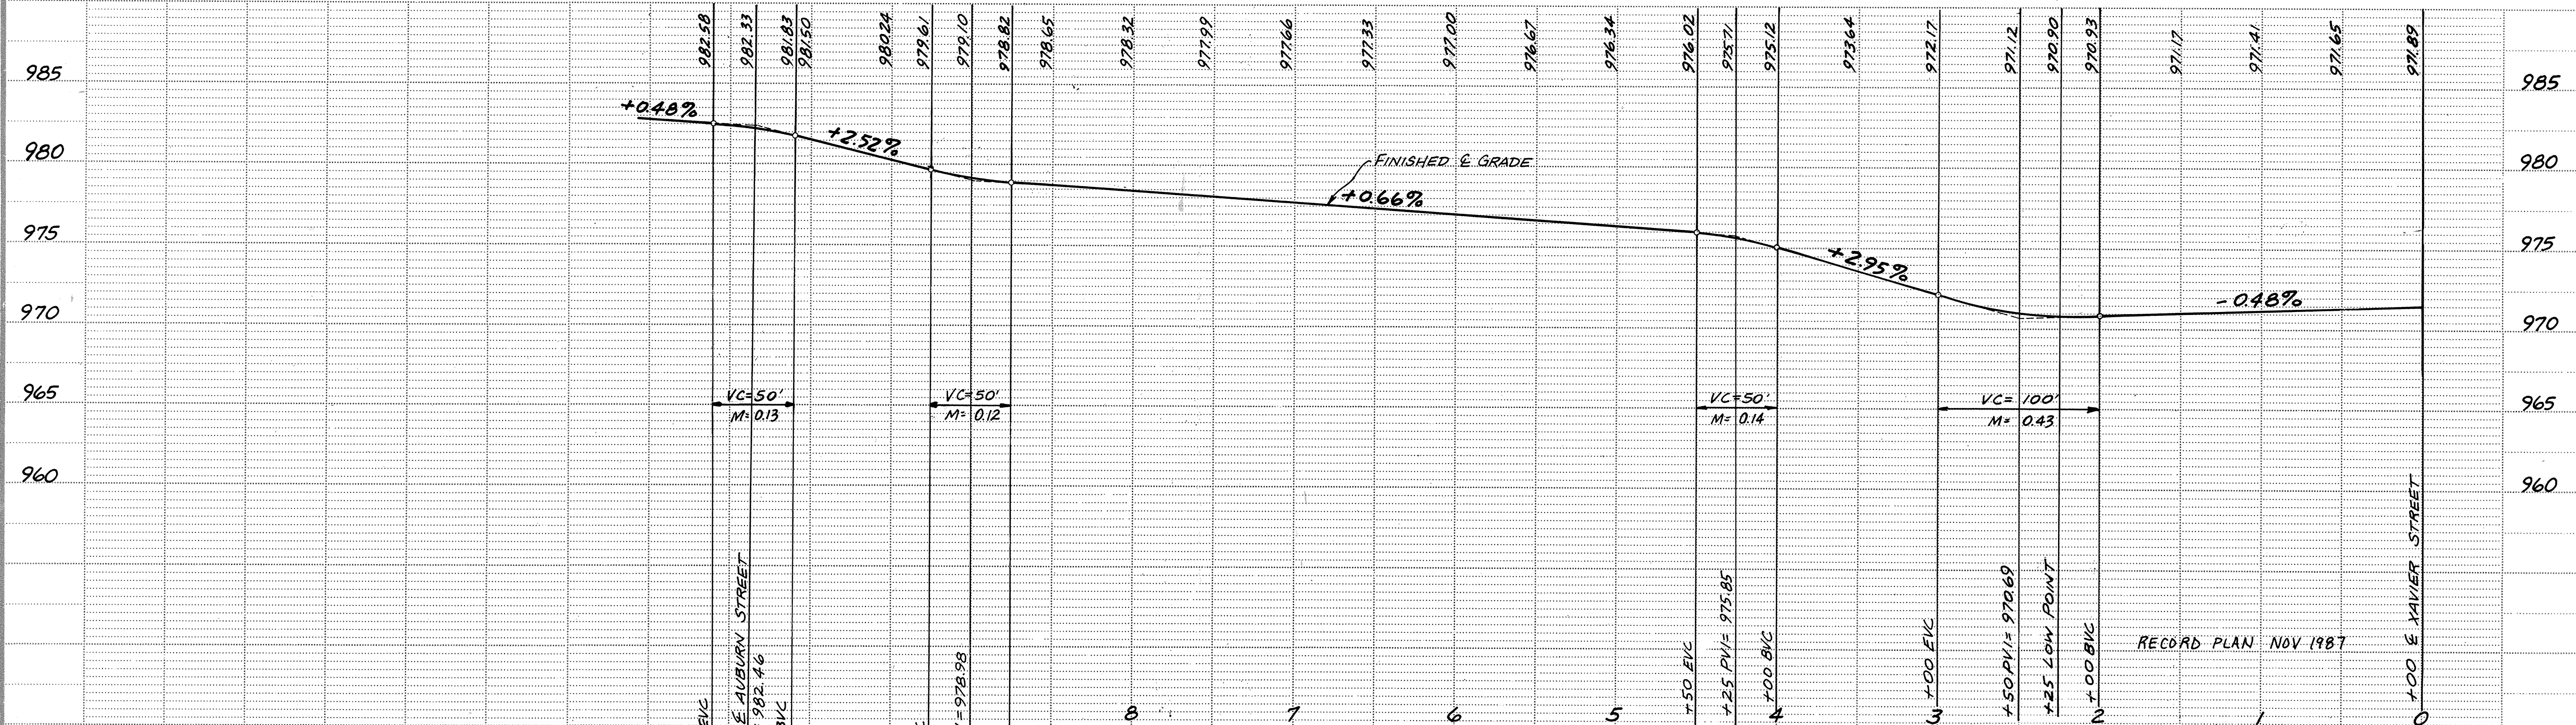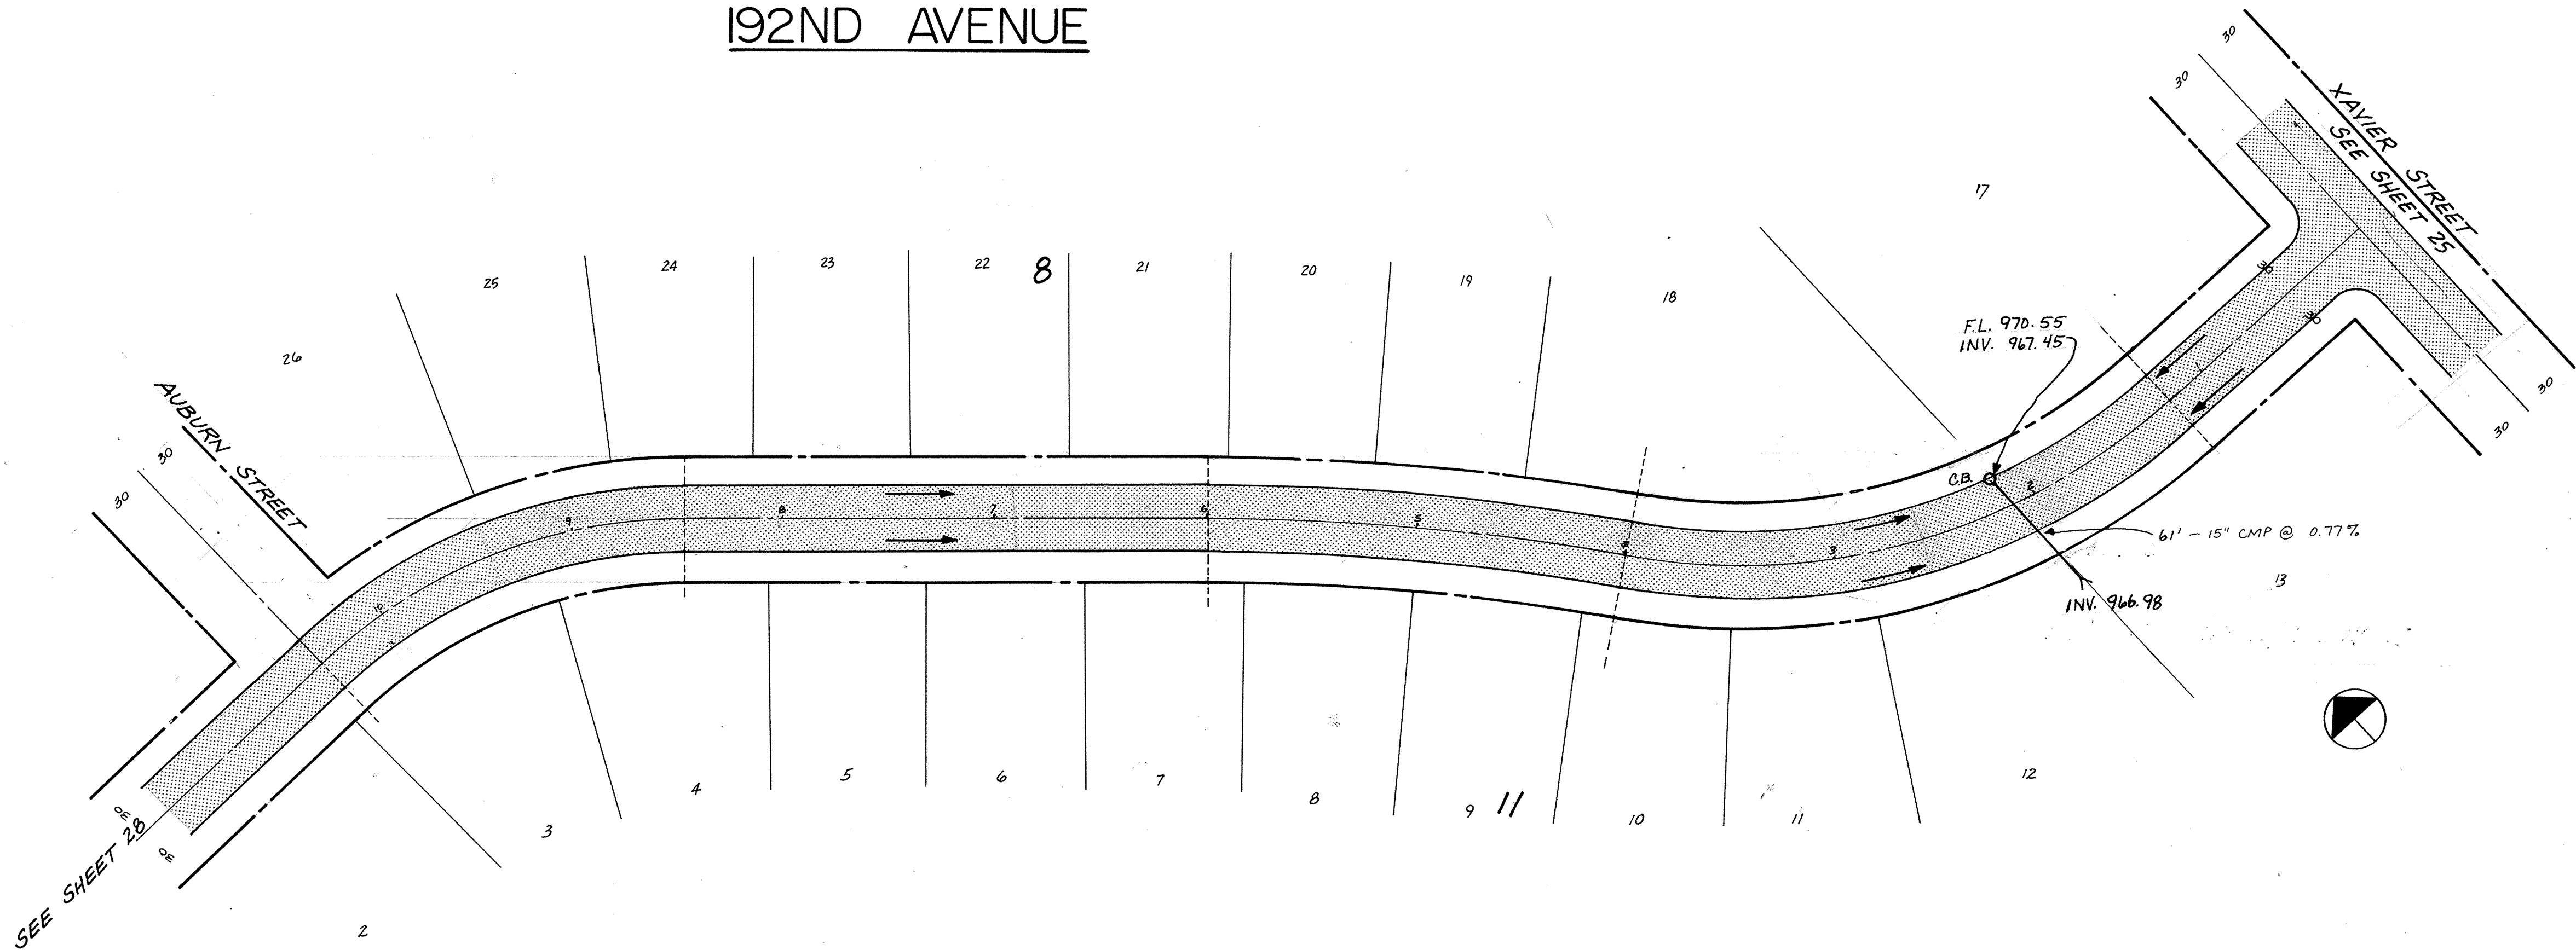

Maier Stewart & Associates Inc.
CONSULTING ENGINEERS
480 CEDAR STREET (612)227-9475 ST. PAUL, MINNESOTA 55101

DATE	DESCRIPTION	DESIGNED
10/1/86	PROFILE	CHECKED
		DRAWN ARJ
		GRAPHIC SCALE
		0 HORIZ. 50
		0 VERT. 5

CITY OF ELK RIVER
DEERFIELD 3RD ADDITION
STREET CONSTRUCTION
192ND AVENUE

DATE MAY 1986 SHEET 27 OF 31 SHEETS PROJECT NO. 230-020