
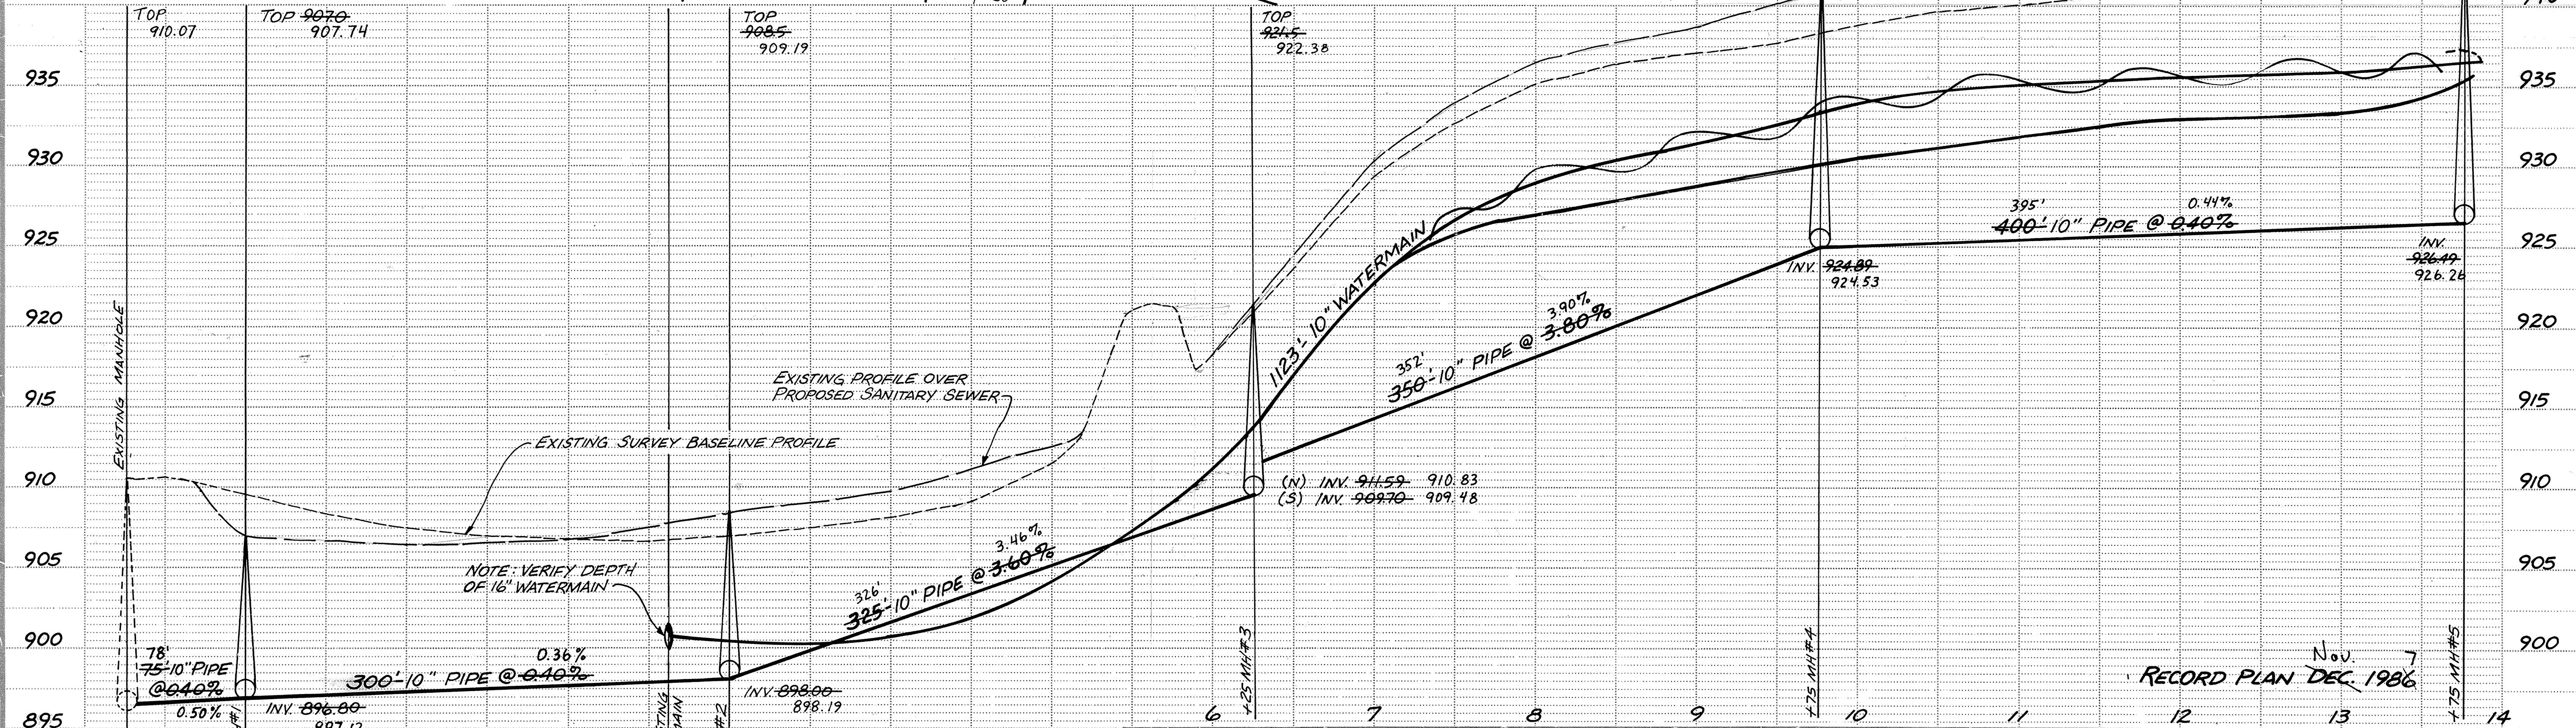
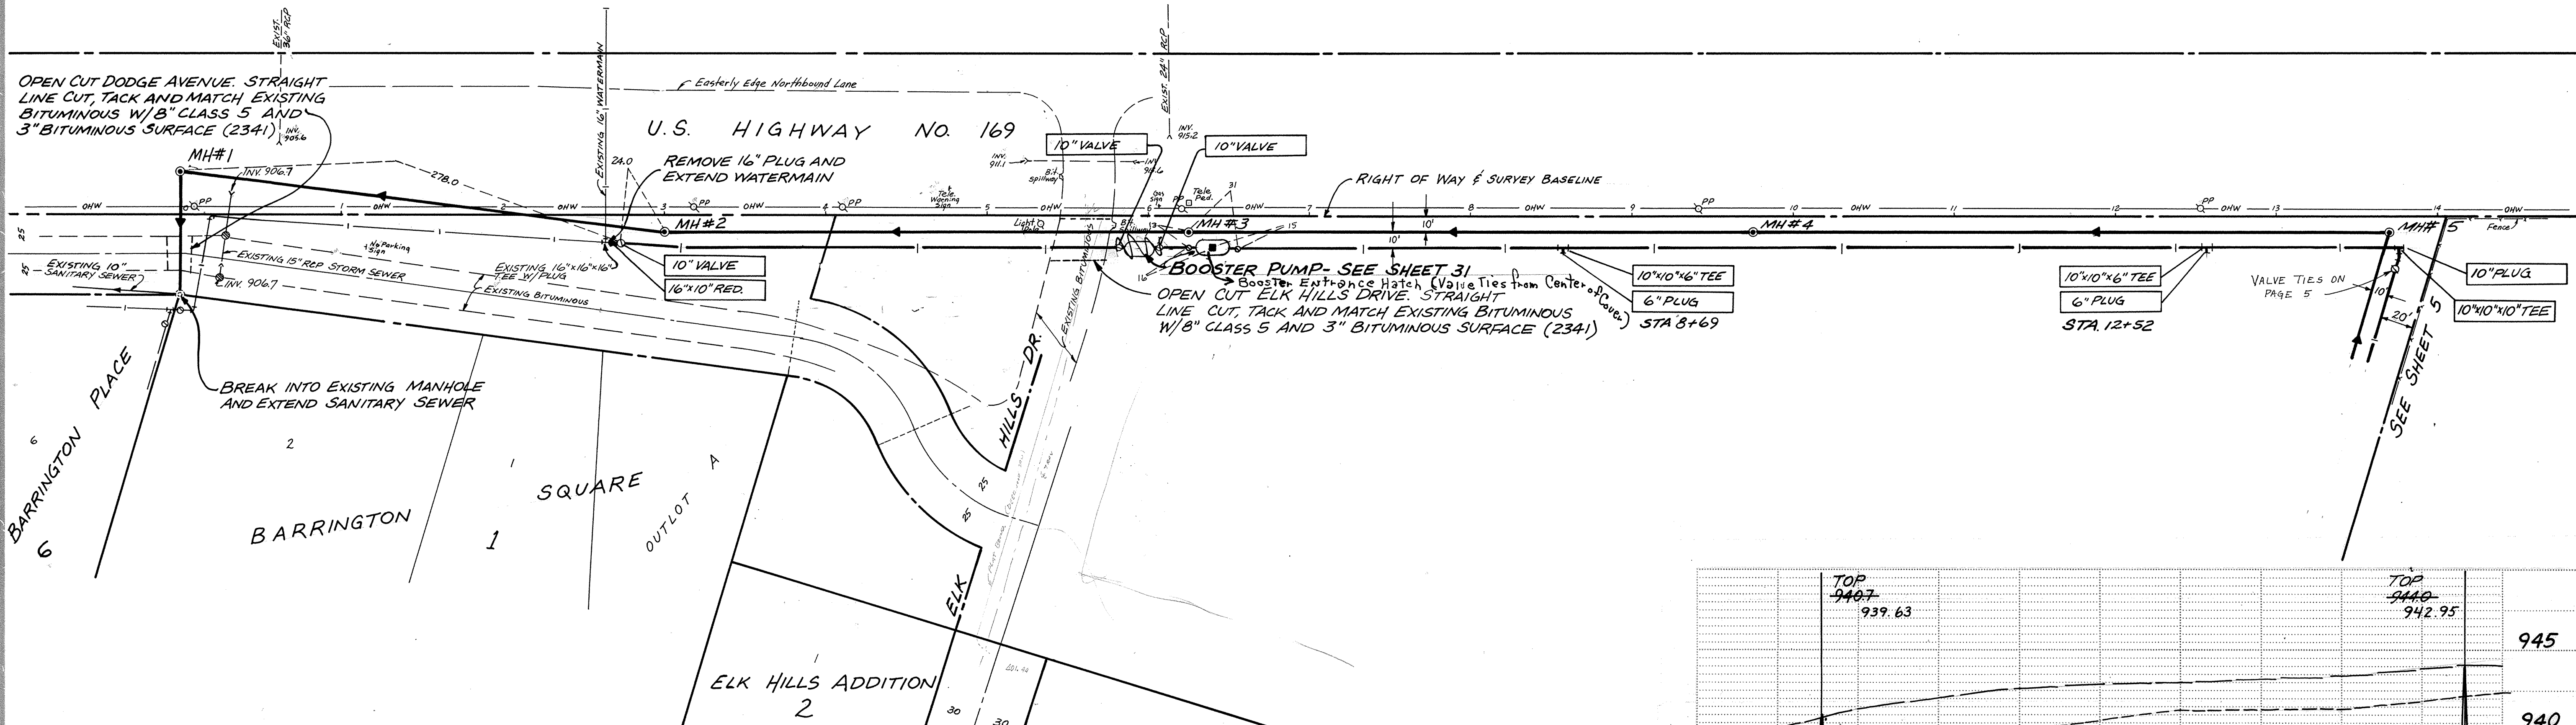


DODGE AVENUE

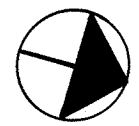

CONSULTING ENGINEERS
480 CEDAR STREET (612) 227-9475 ST. PAUL, MINNESOTA 55101

REVISIONS	DATE	DESCRIPTION	DESIGNED	CHECKED	DRAWN
					MRJ

GRAPHIC SCALE
0 HORIZ. 50
0 VERT. 5

CITY OF ELK RIVER
DEER FIELD 3RD ADDITION
SANITARY SEWER AND WATERMAIN
DODGE AVENUE

DATE MAY 1986 SHEET 4 OF 31 SHEETS PROJECT NO. 230-020