
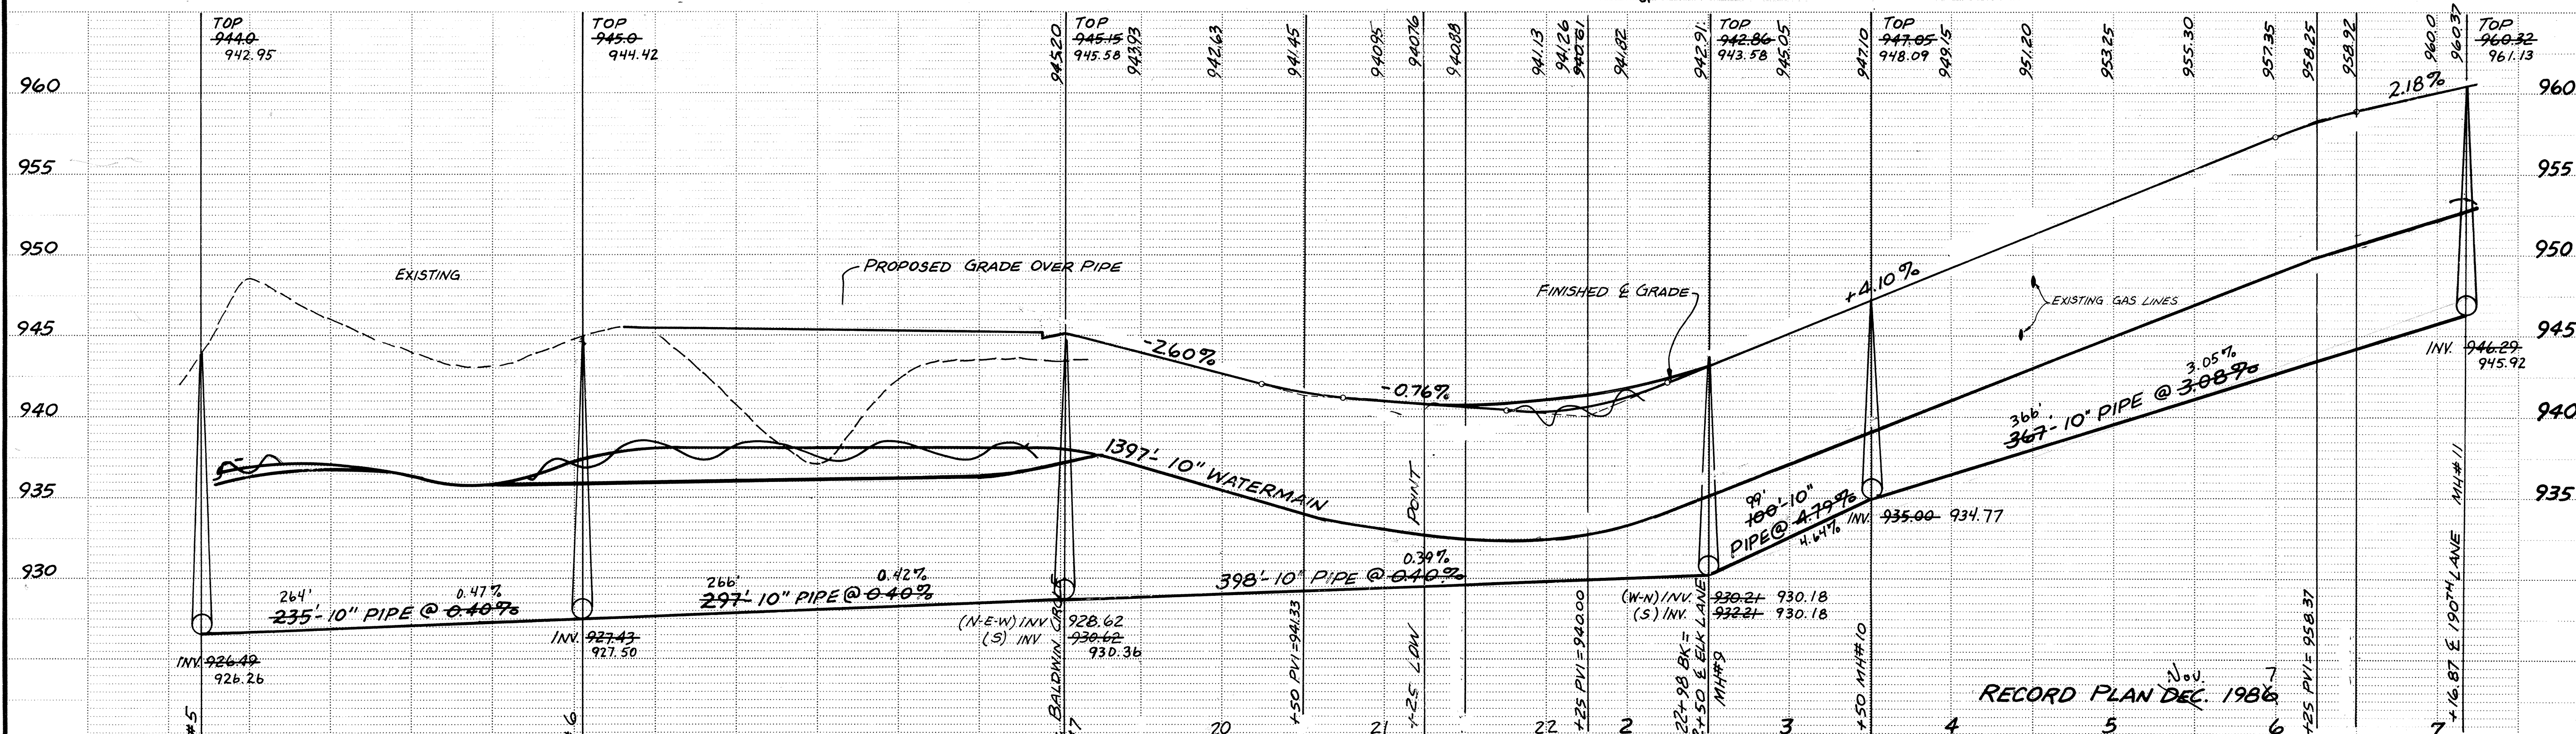


U.S. HIGHWAY NO. 169

189TH AVENUE

ZANE STREET

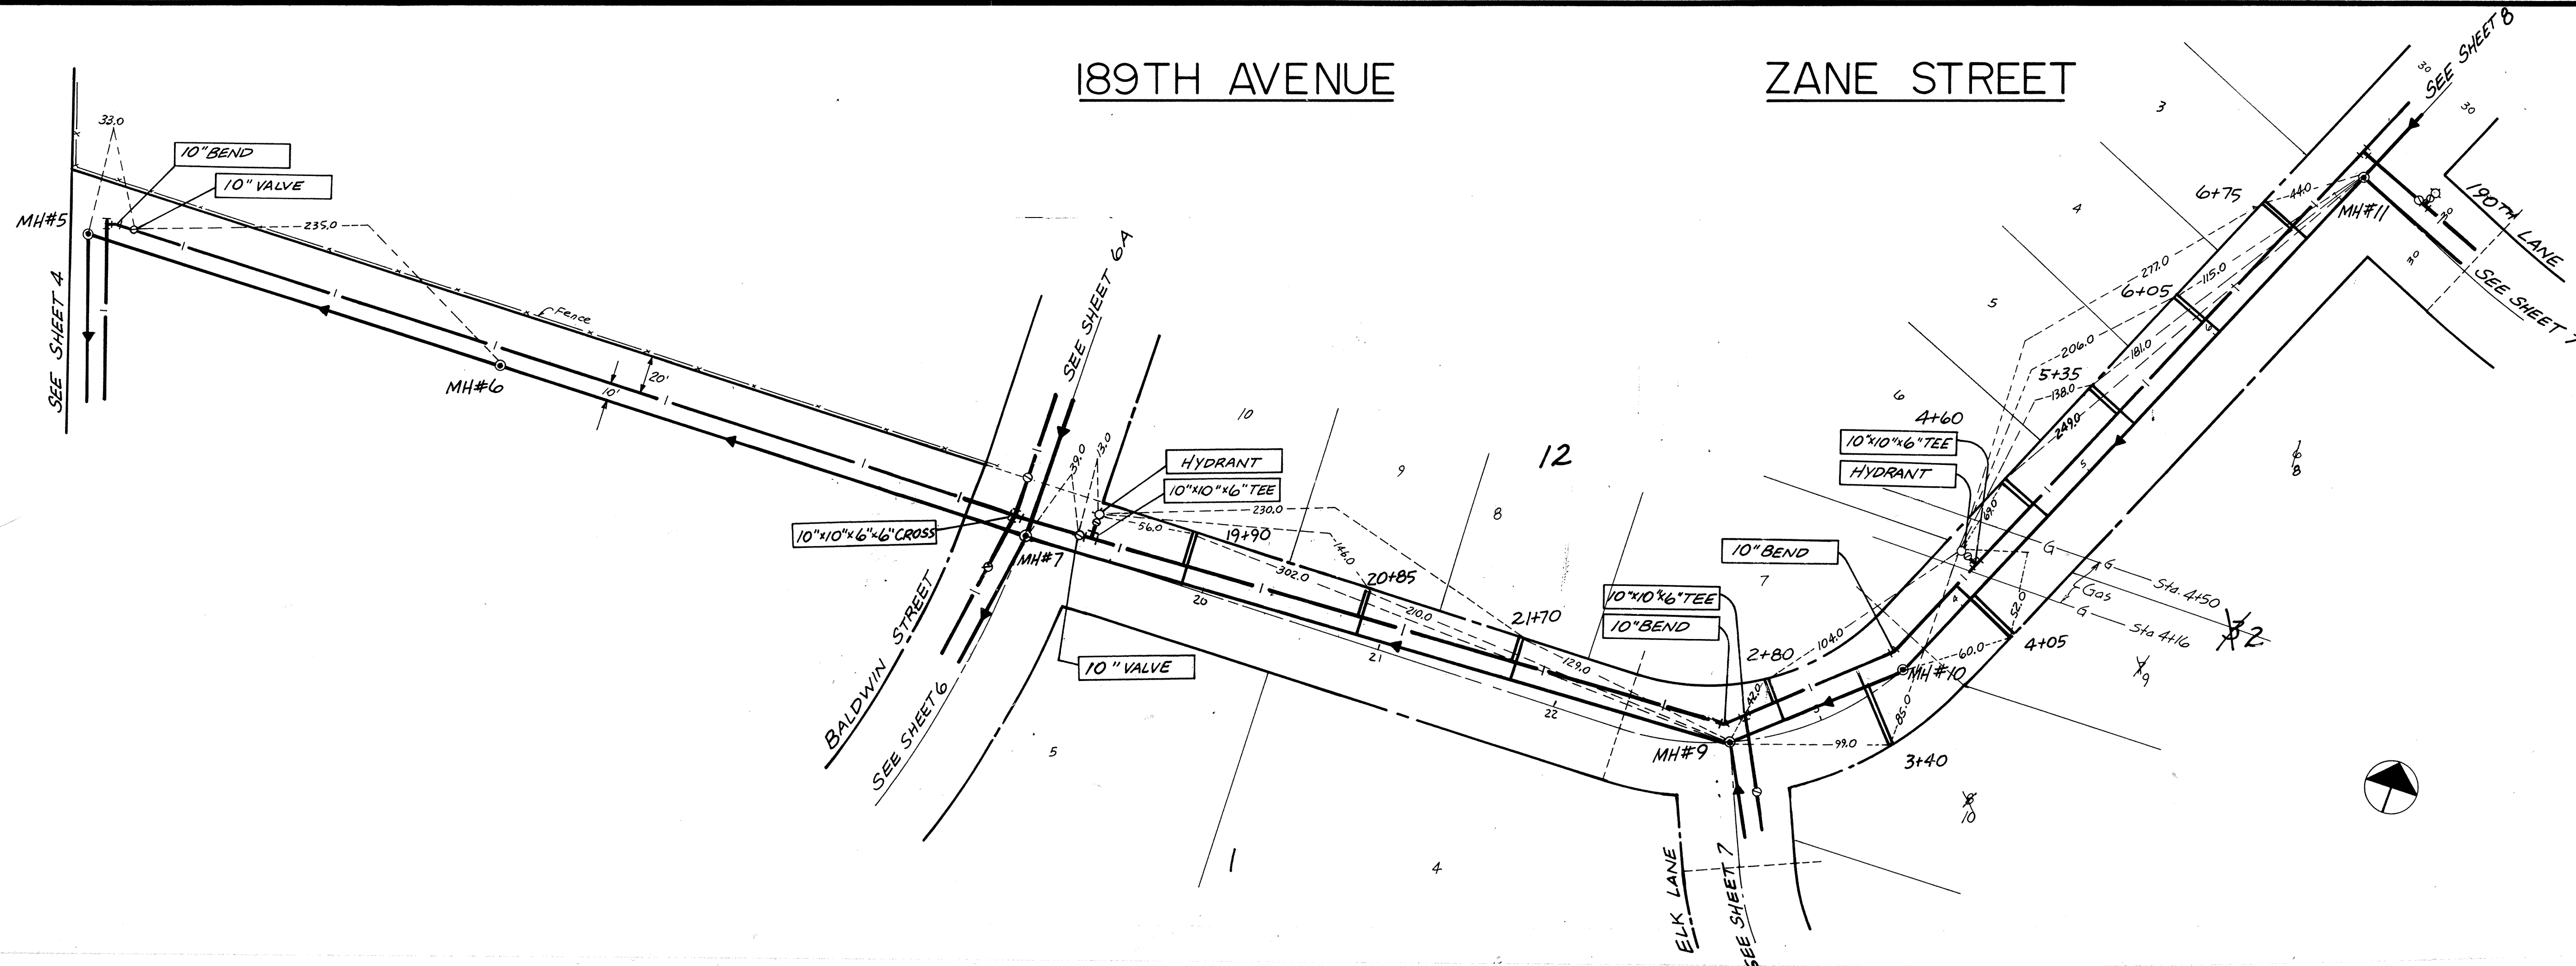

480 CEDAR STREET

(612) 227-9475

ST. PAUL, MINNESOTA 55101

CONSULTING ENGINEERS

Maier Stewart & Associates Inc.

DATE	DESCRIPTION	DESIGNED
8/14/86	PROFILE	CHECKED
		DRAWN MRL
		GRAPHIC SCALE
		0 HORIZ. 50
		0 VERT. 5

CITY OF ELK RIVER

DEERFIELD 3RD ADDITION
SANITARY SEWER AND WATERMAIN
189TH AVENUE ~ ZANE STREET

DATE AUG 1986 SHEET 5 OF 31 SHEETS PROJECT NO. 230-020