
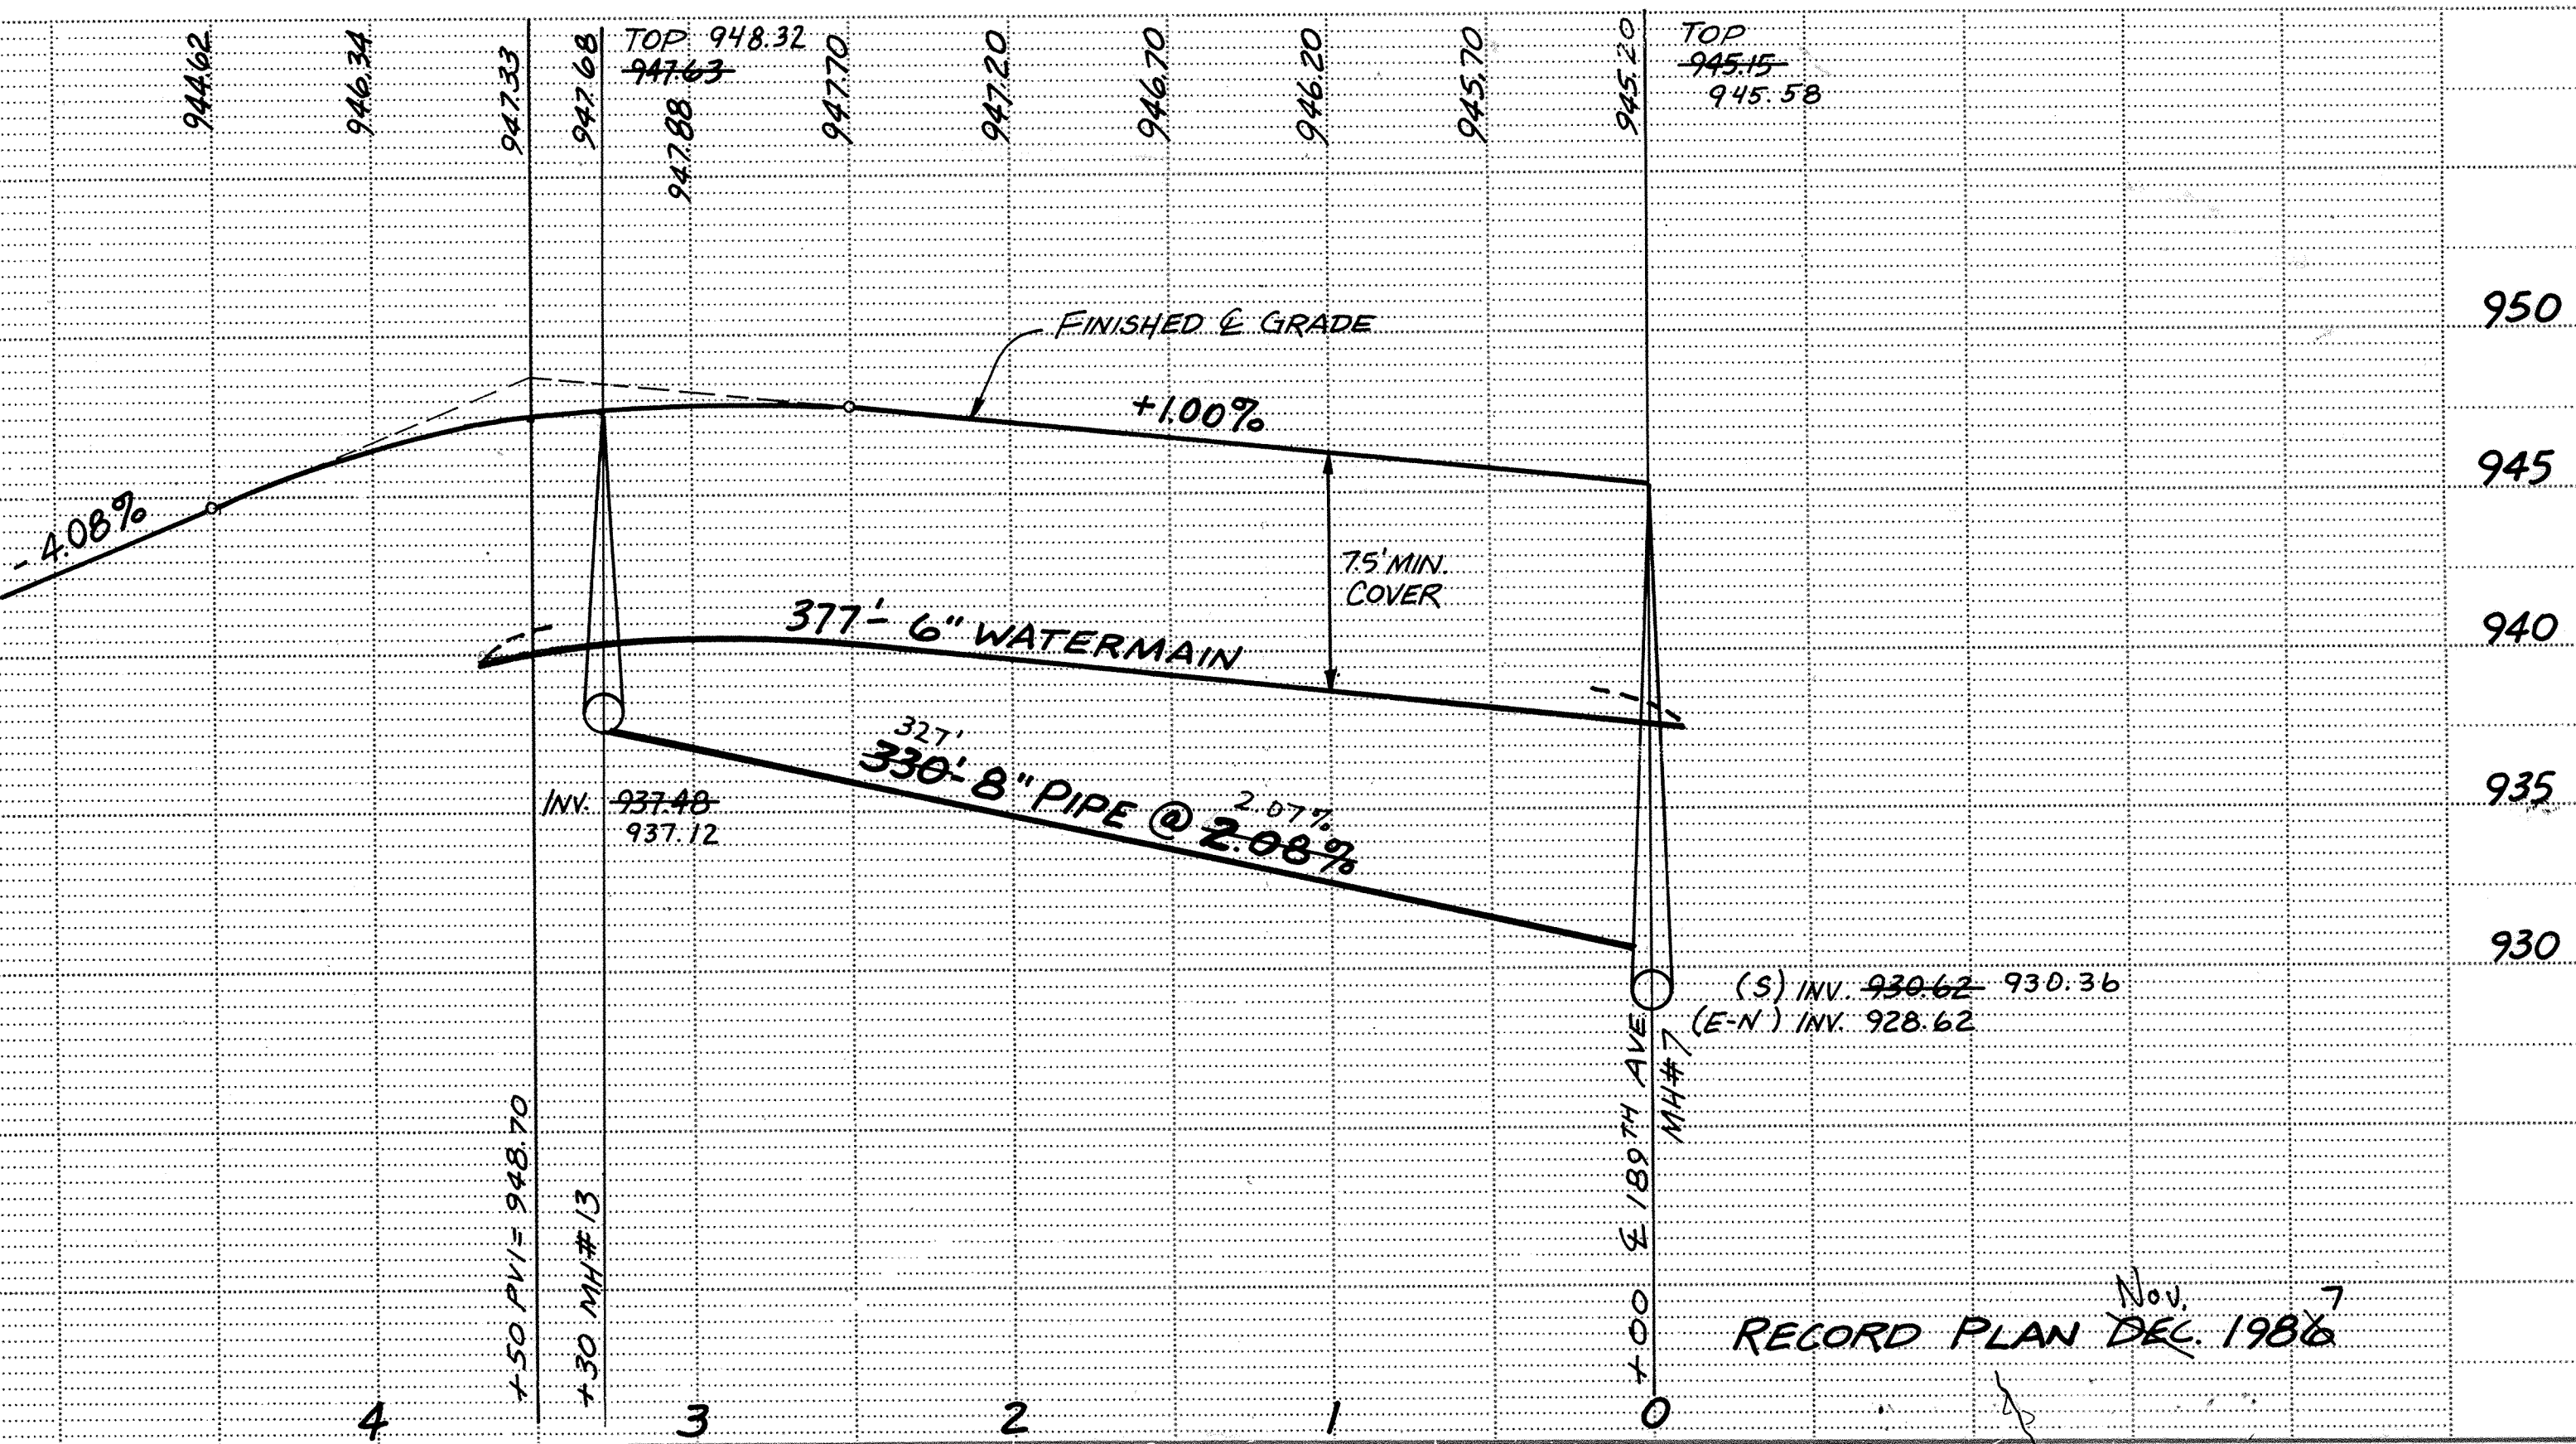


BALDWIN STREET

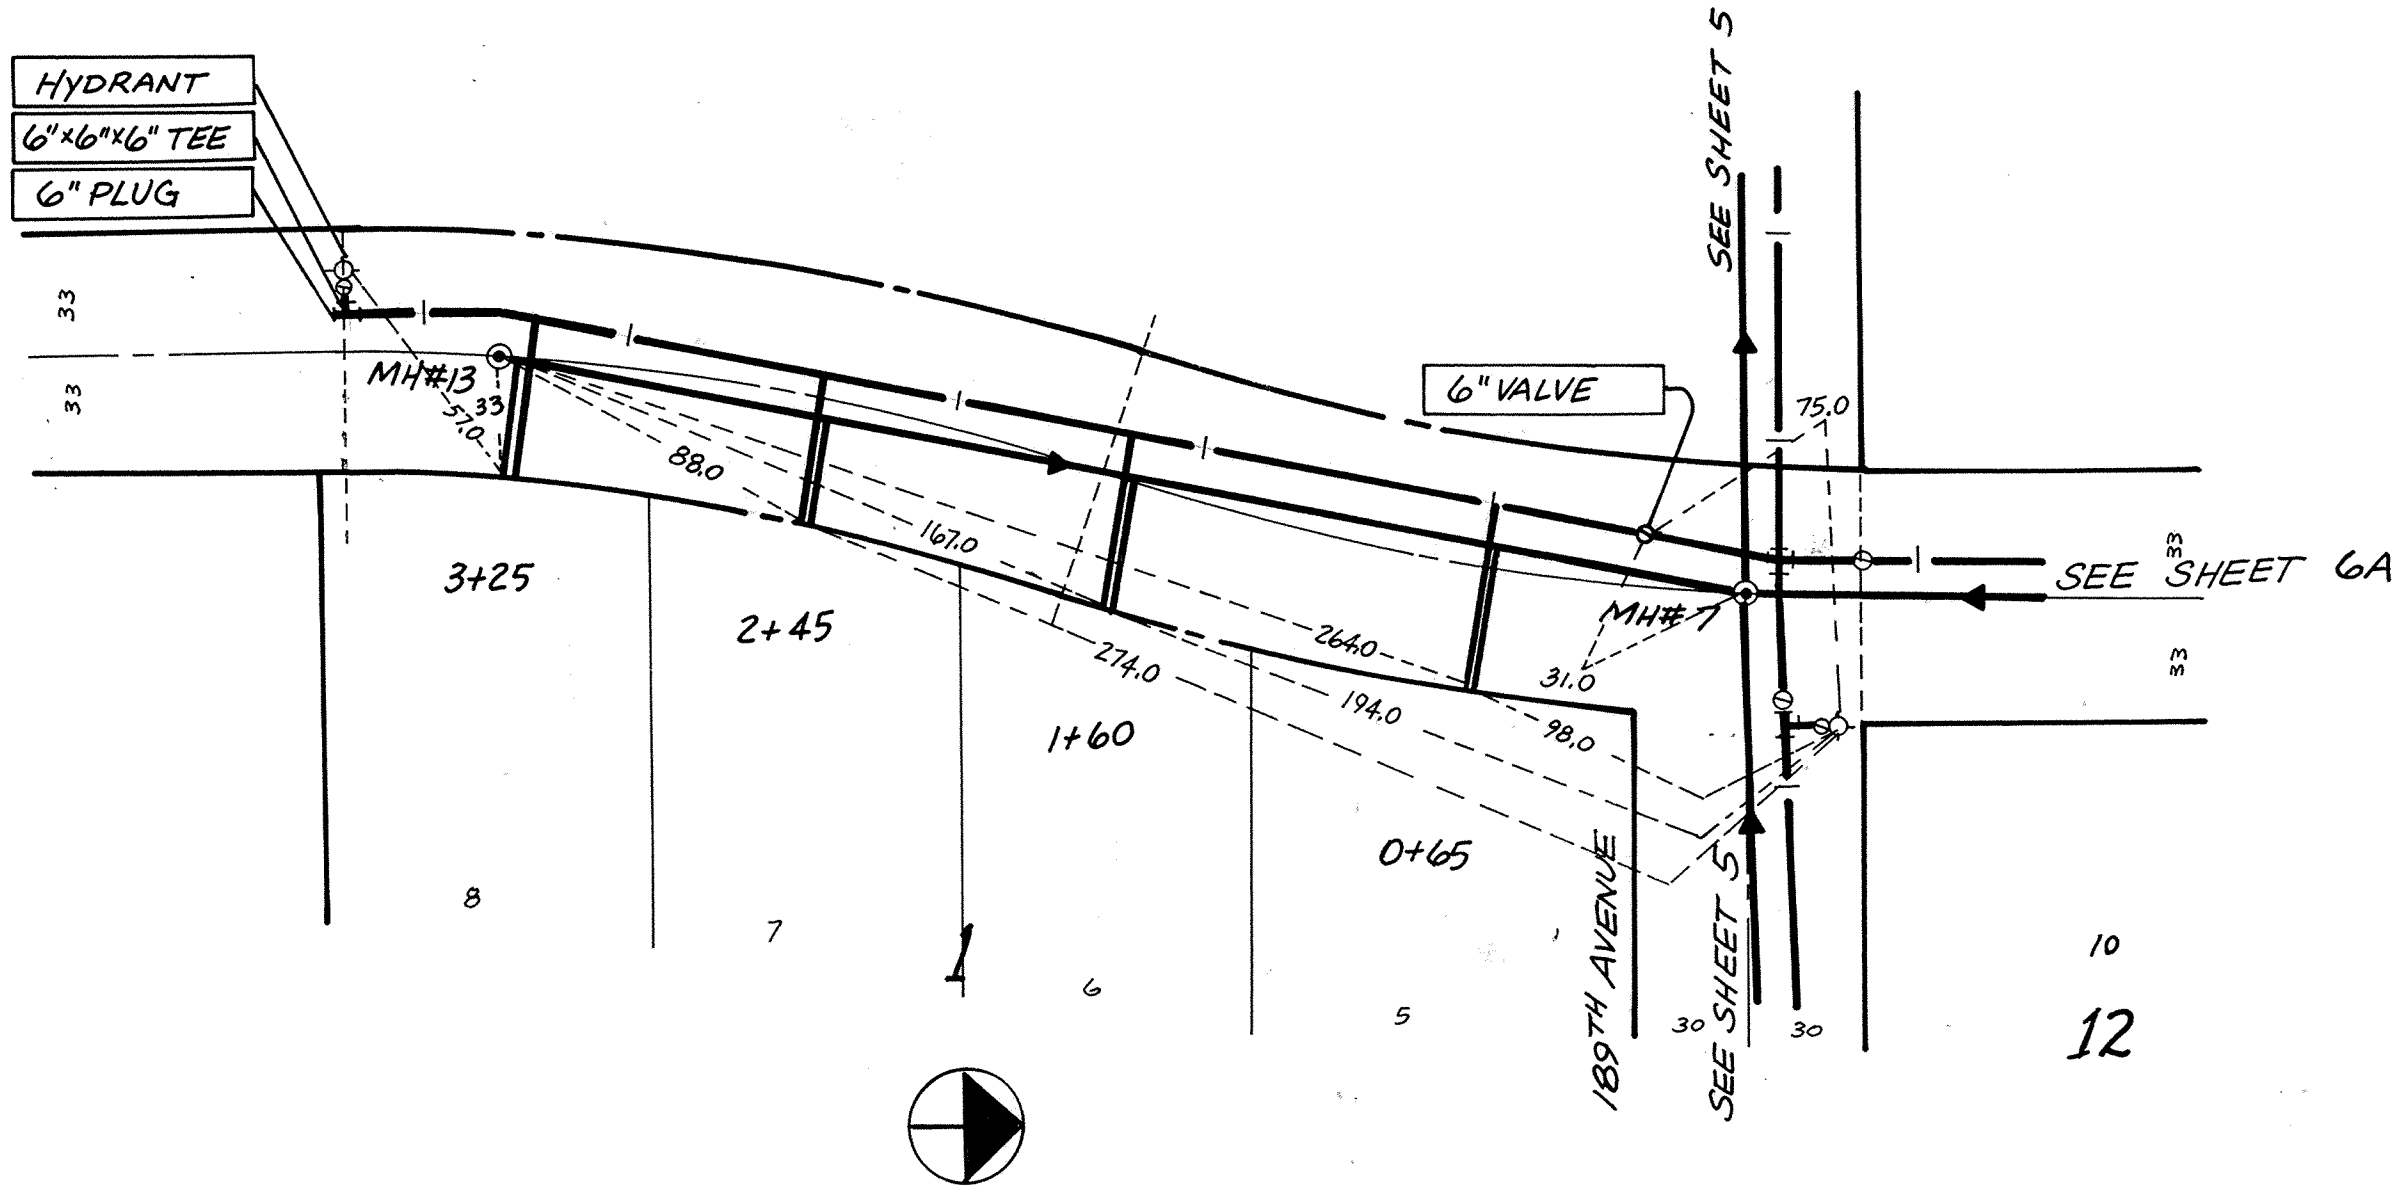

	CC:SULTING ENGINEERS	DESIGNED	CITY OF ELK RIVER DEERFIELD 3RD ADDITION SANITARY SEWER AND WATERMAIN BALDWIN STREET			
	Maier Stewart & Associates Inc.	CHECKED				
	480 CEDAR STREET	DRAWN				
	(612)227-9475	GRAPHIC SCALE				
ST. PAUL, MINNESOTA 55101	DATE 9/17/86	DESCRIPTION PROFILE	HORIZ. 50	DATE AUG 1986	SHEET 6 OF 31 SHEETS	PROJECT NO. 230-020
	REVISIONS		VERT. 5			