

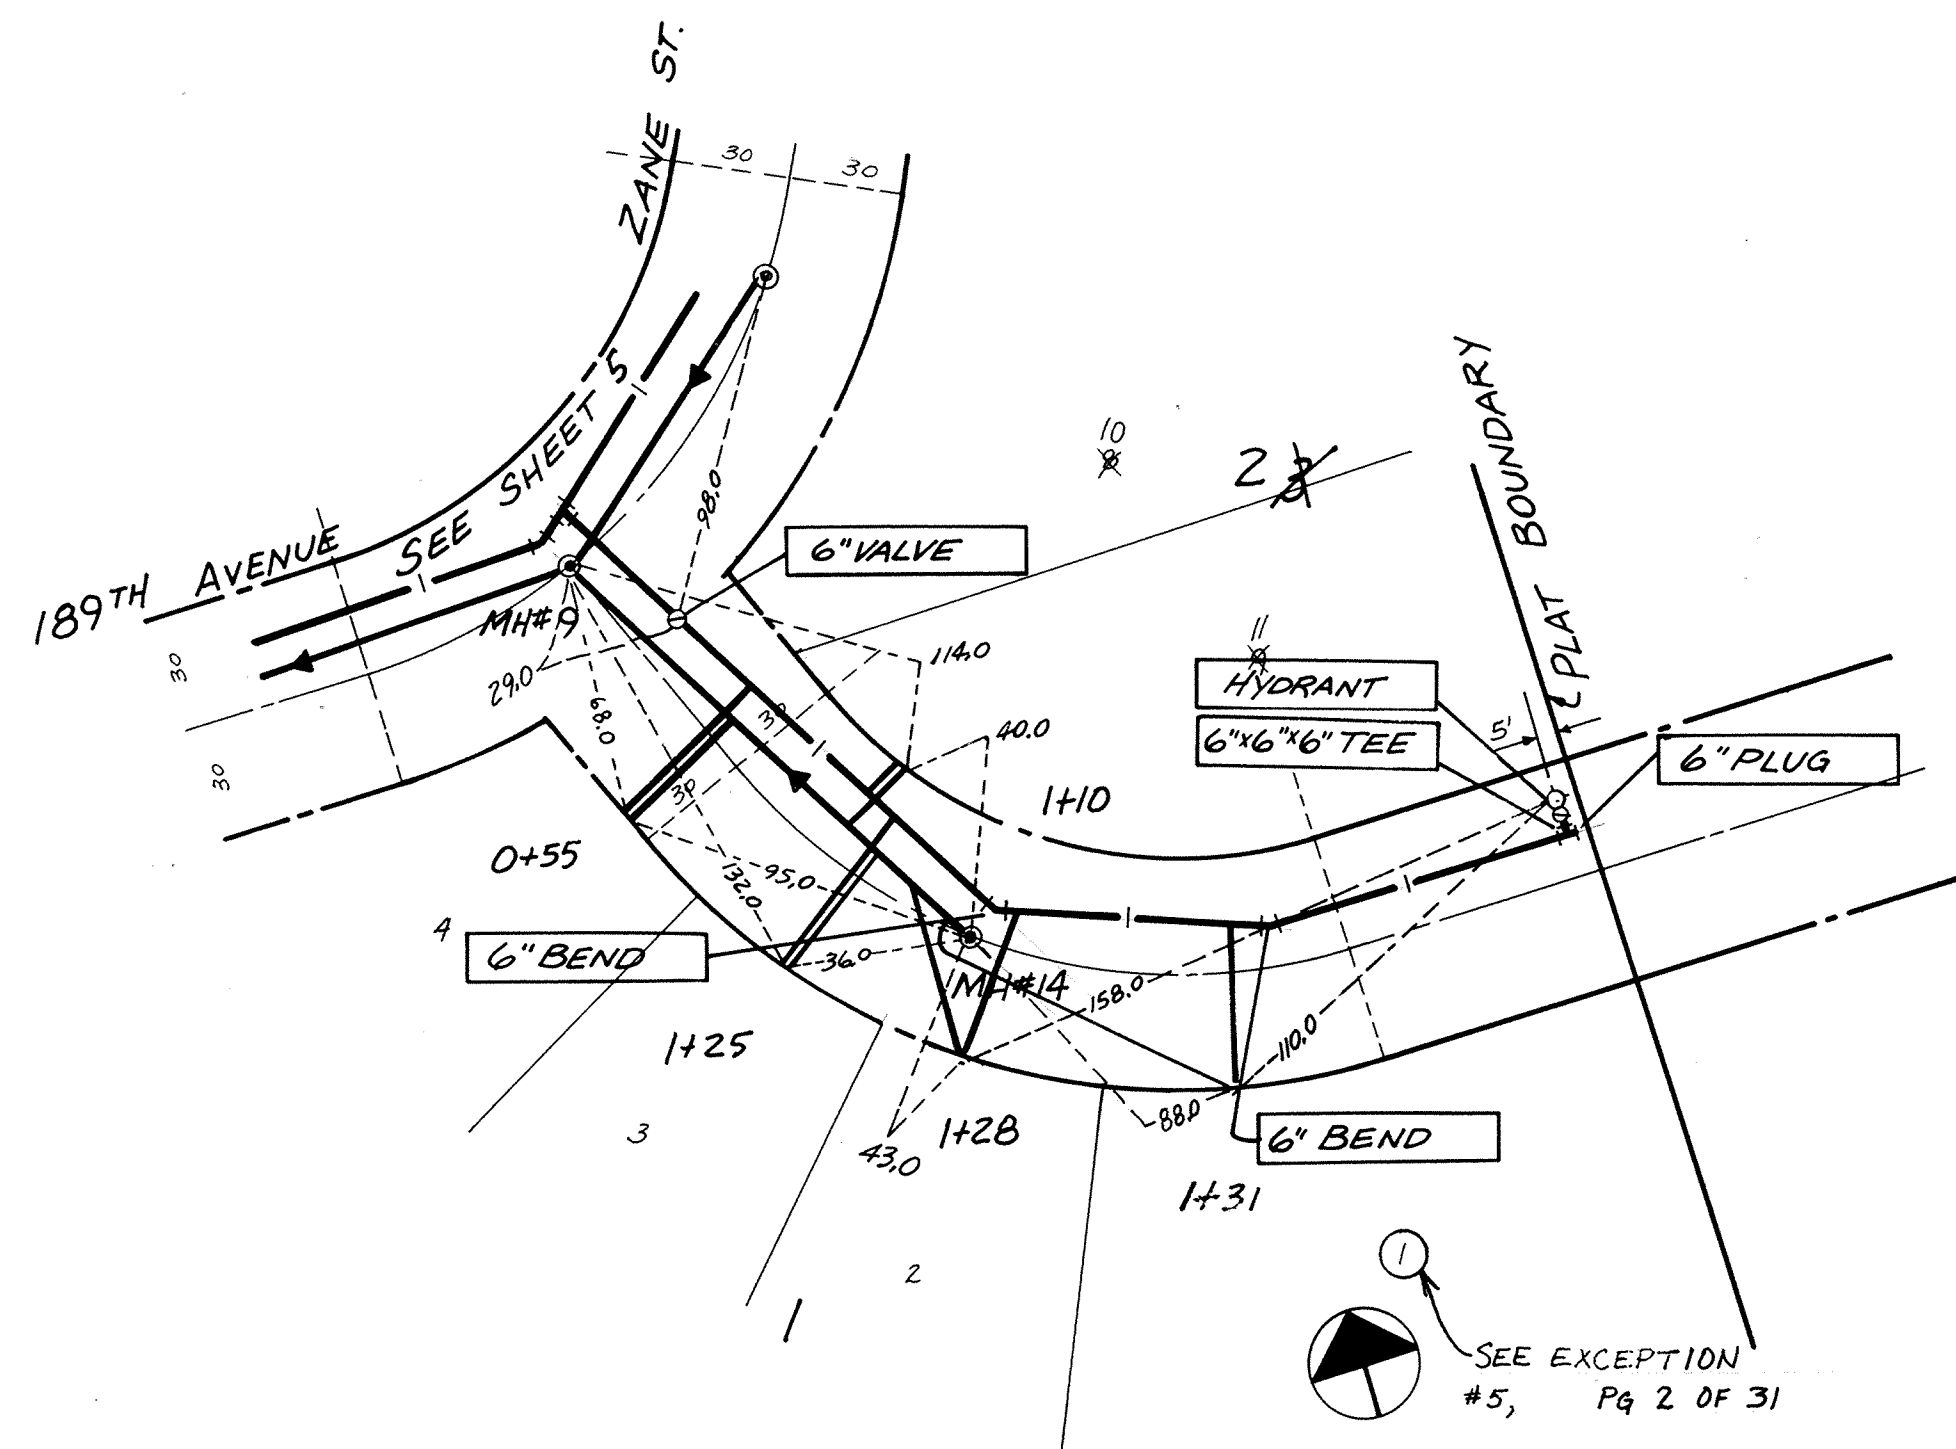
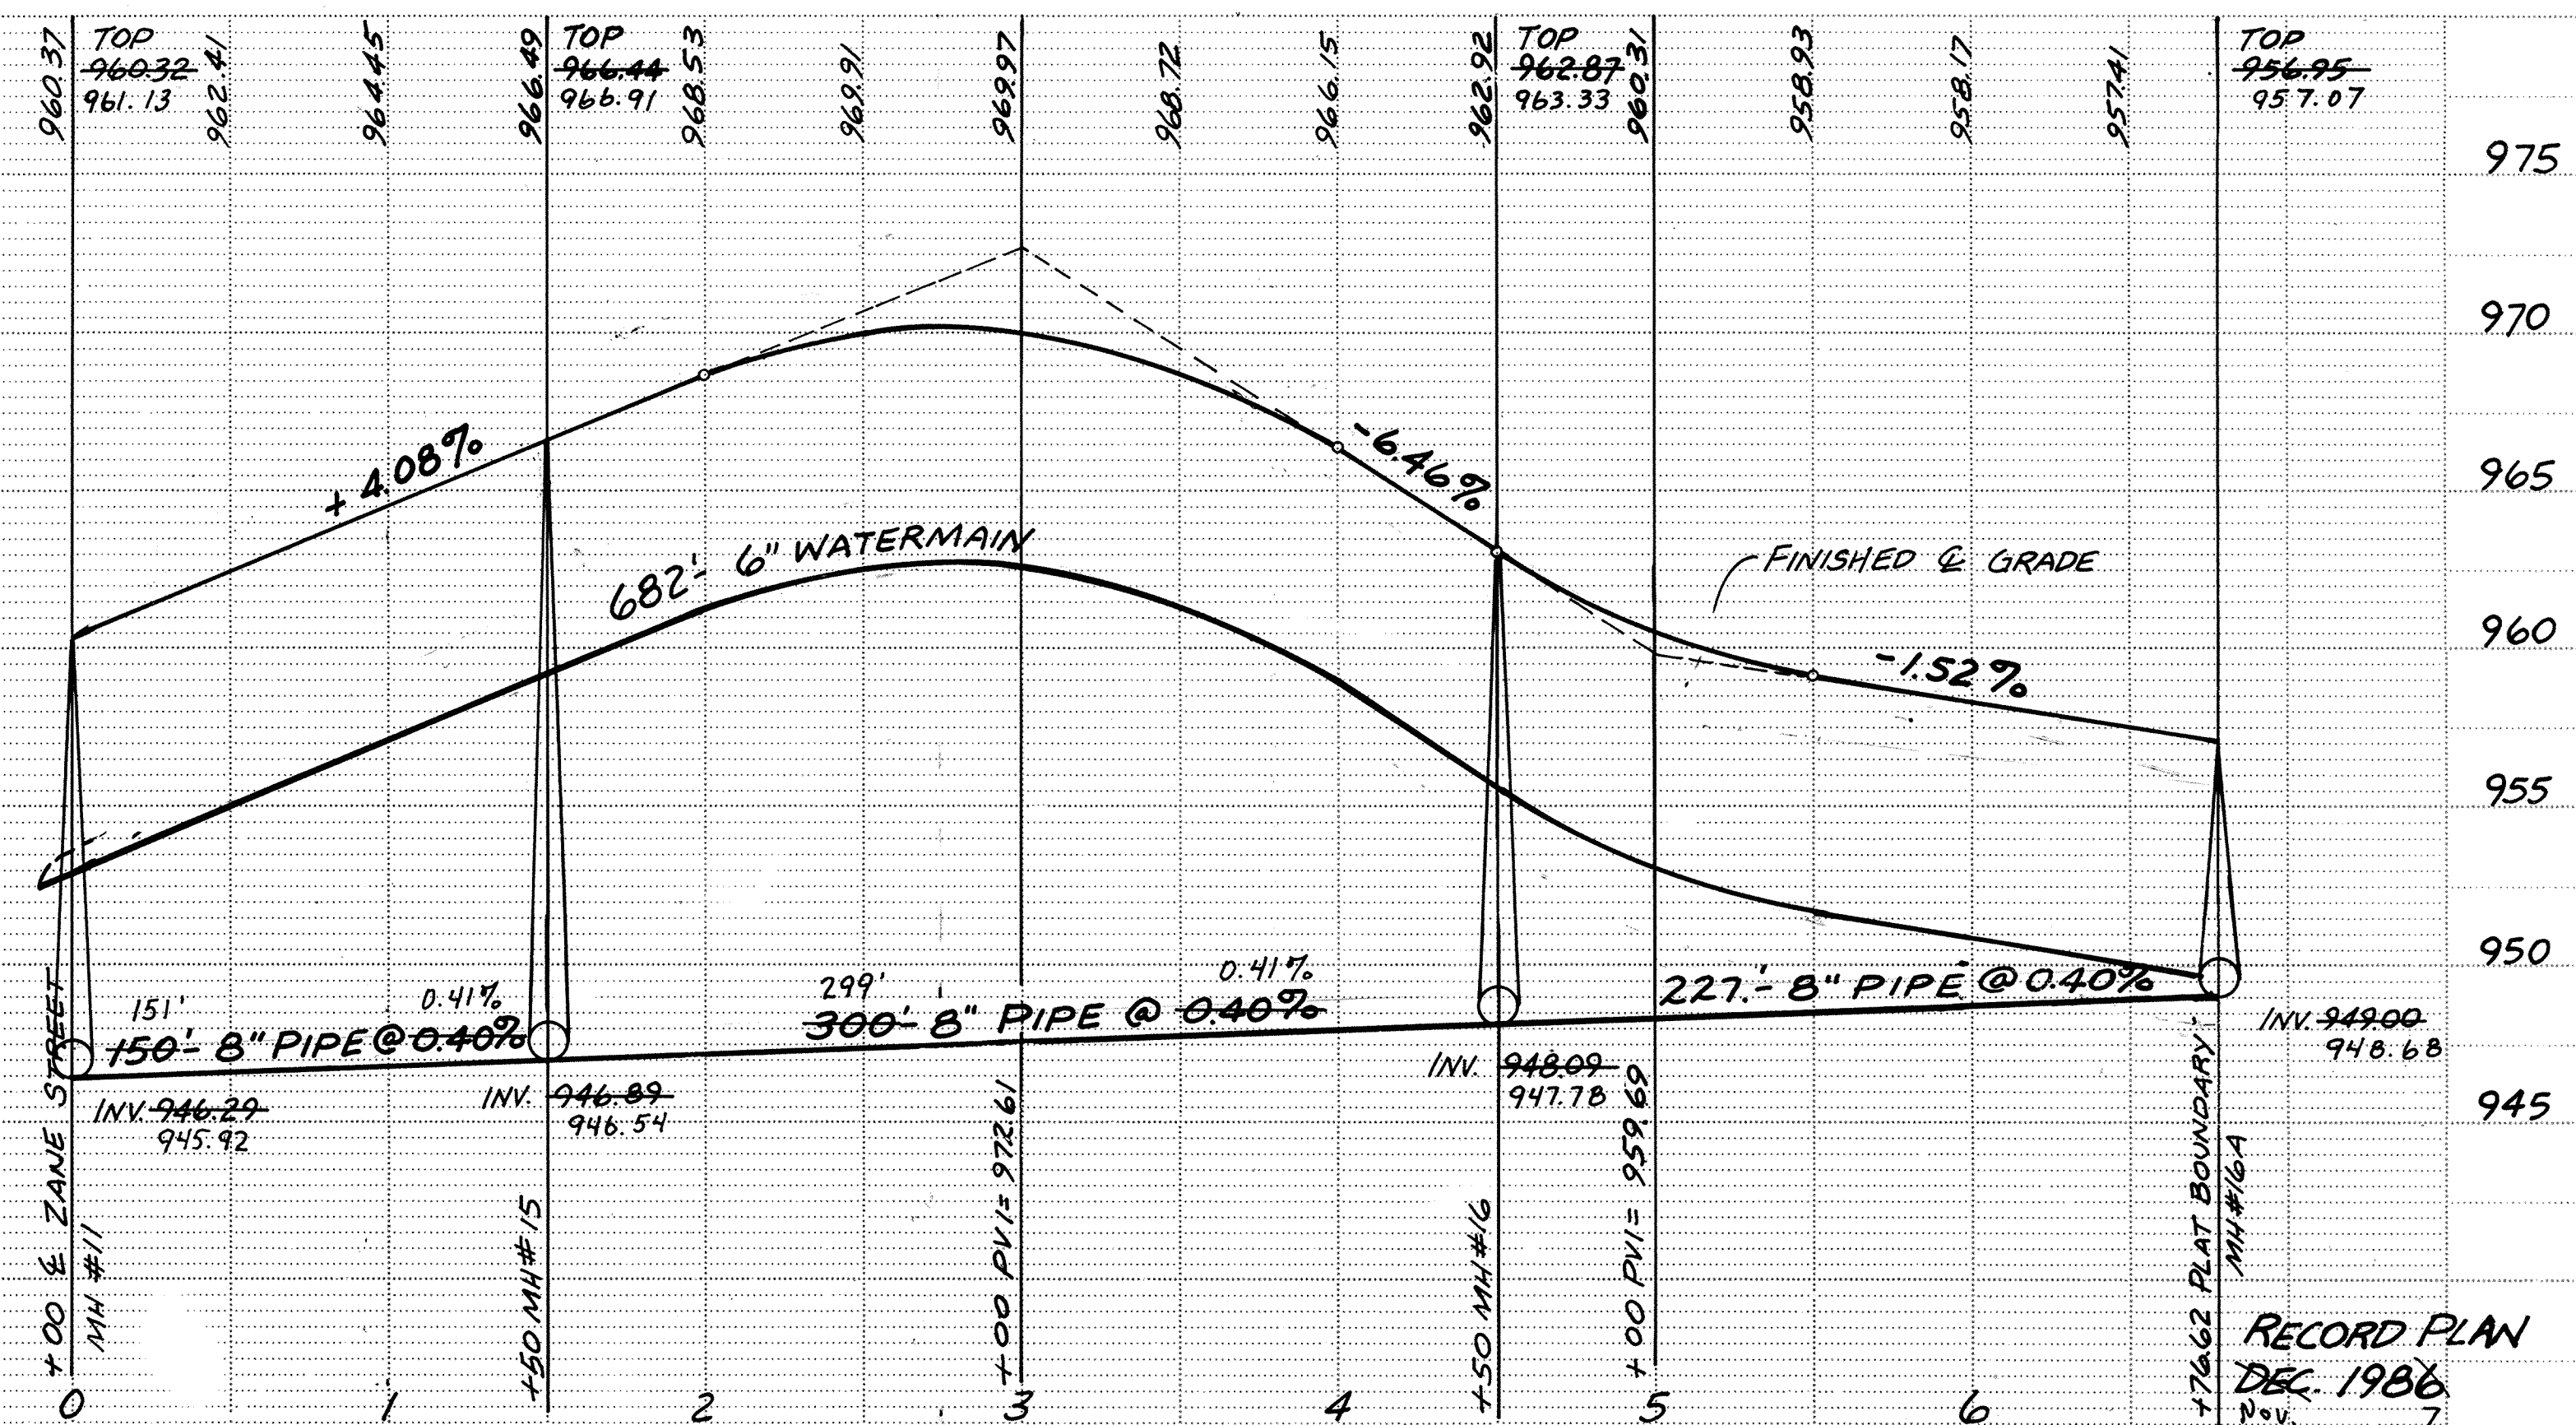


ELK LANE

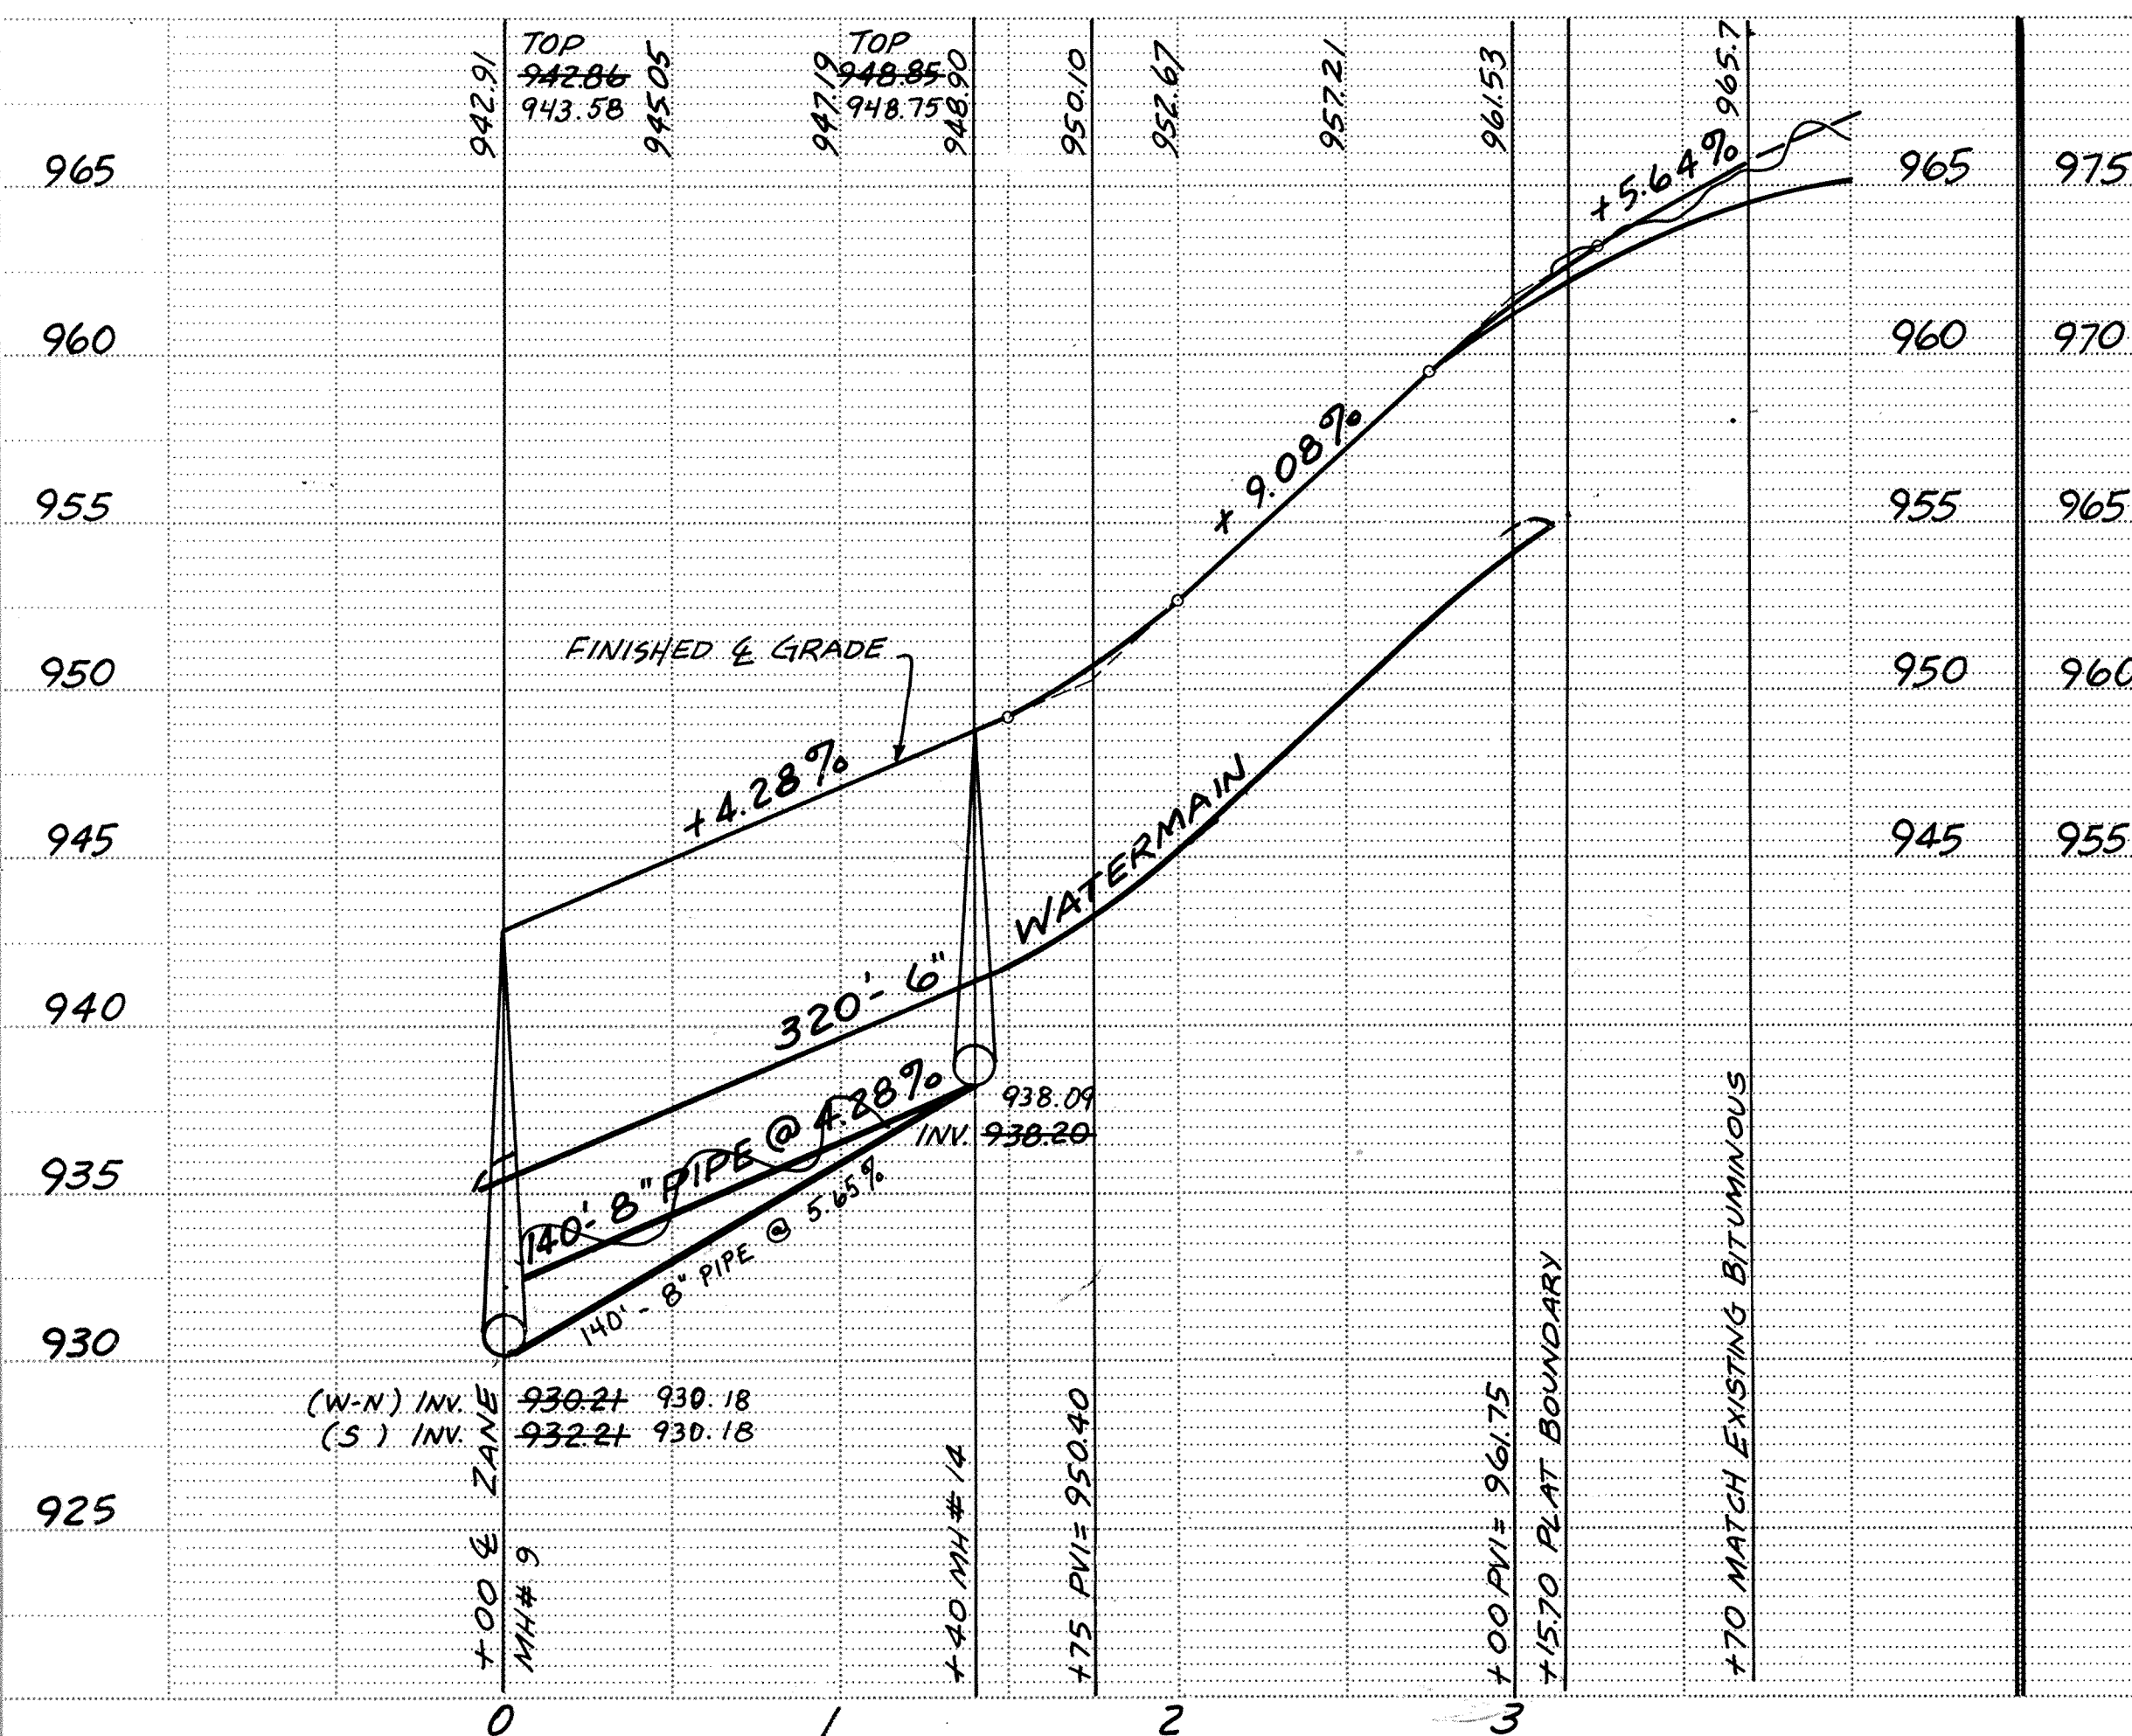

190TH LANE

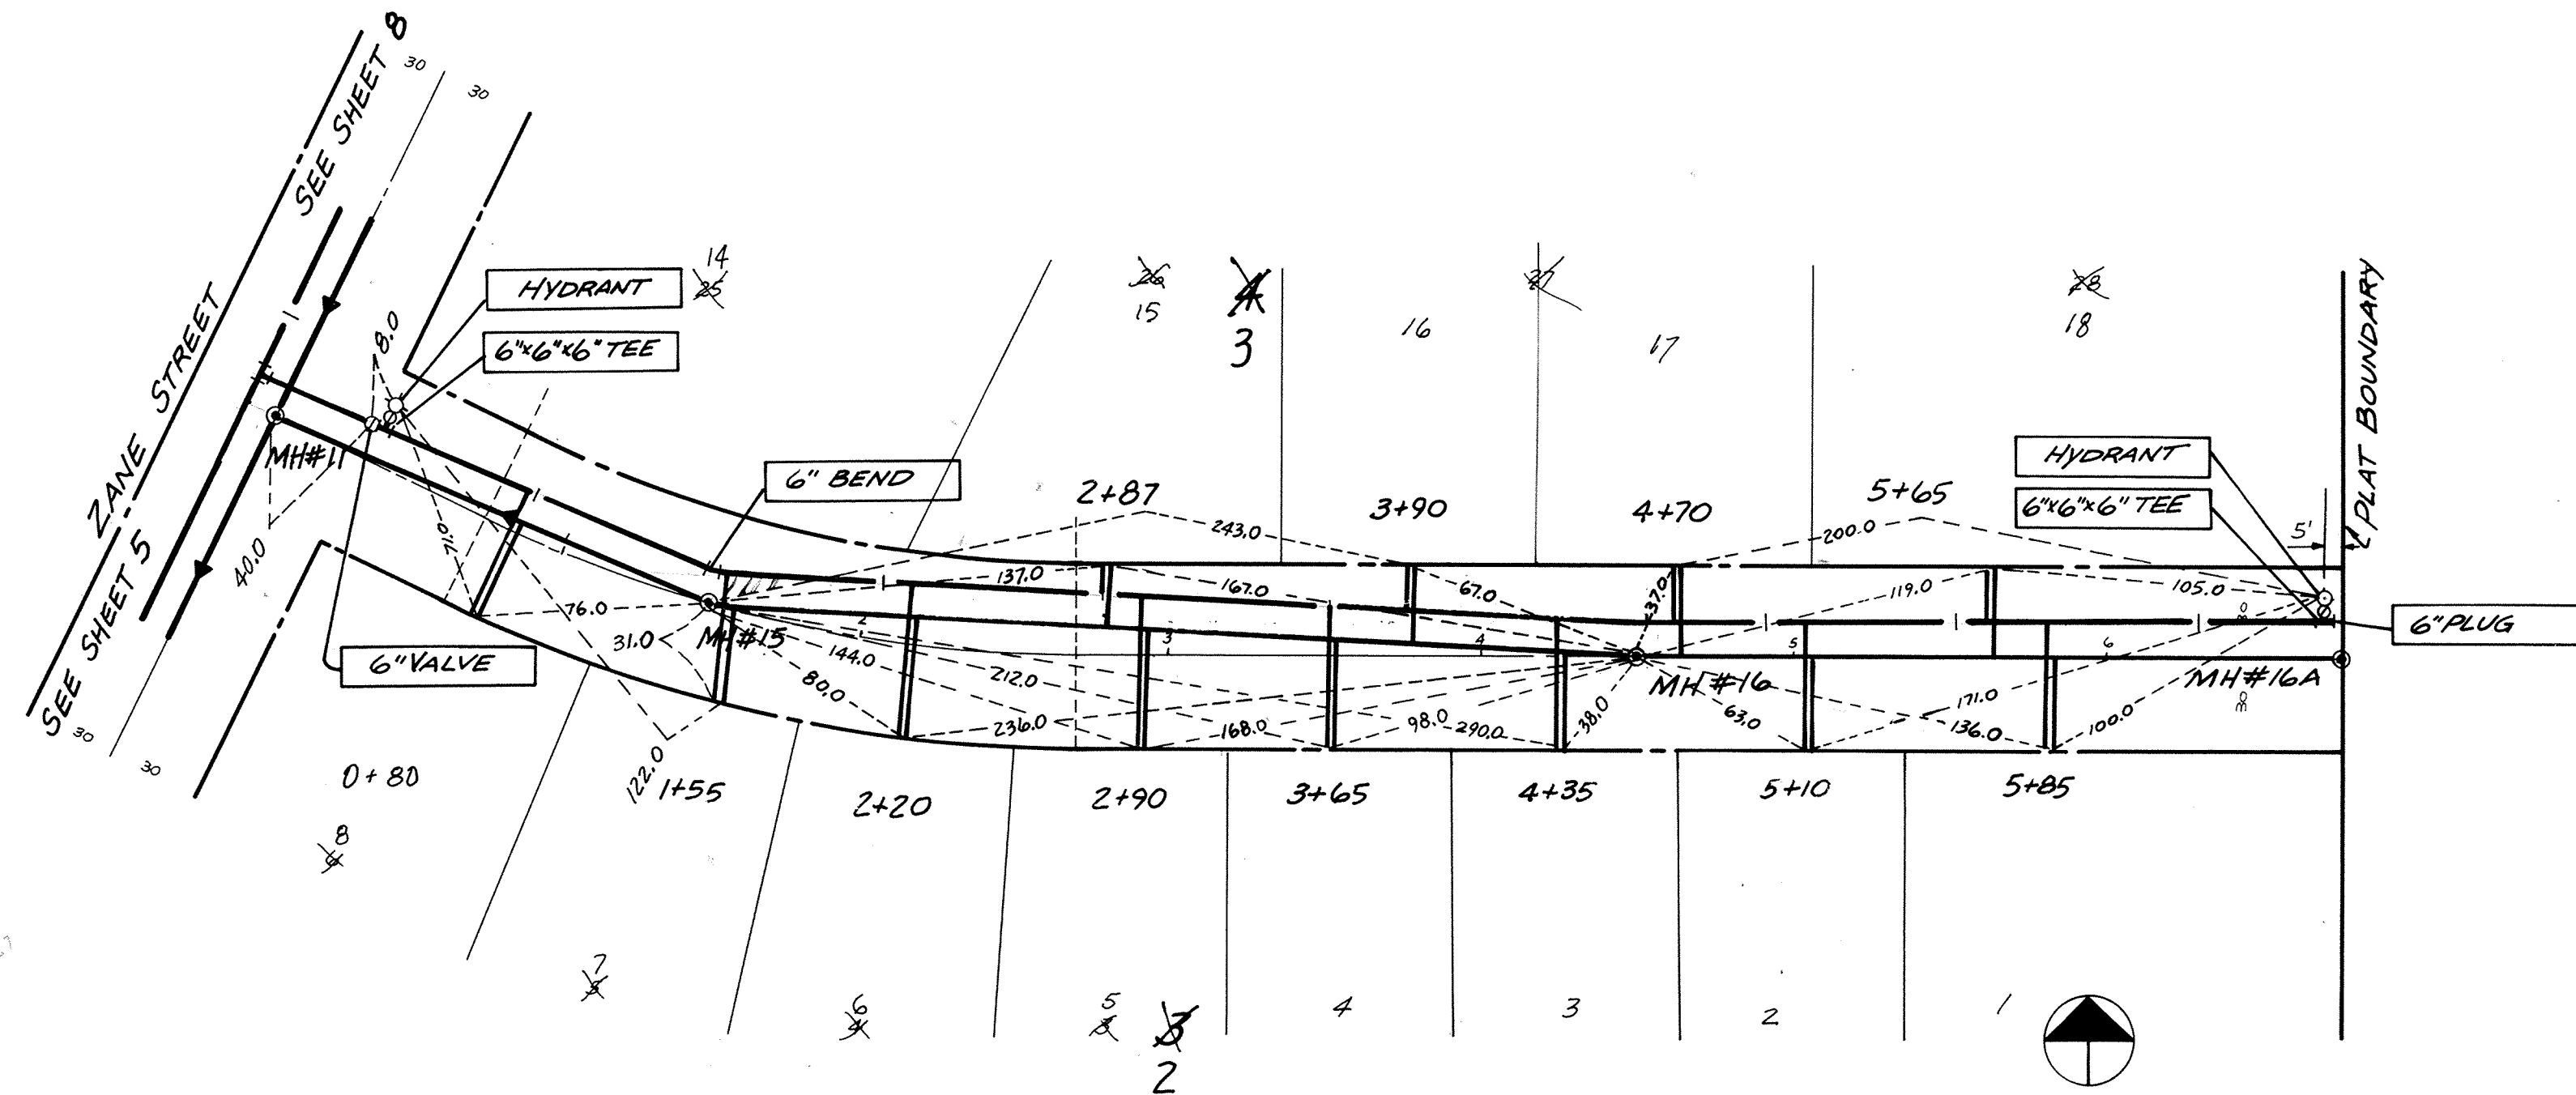

CONSULTING ENGINEERS
Maier Stewart & Associates Inc.
480 CEDAR STREET (612) 227-9475 ST. PAUL, MINNESOTA 55101

DATE	DESCRIPTION	DESIGNED
8/24/86	PROFILE	CHECKED
		DRAWN: MRJ
		GRAPHIC SCALE
		0 HORIZ. 50
		0 VERT. 5
		CITY OF ELK RIVER
		DEERFIELD 3RD ADDITION
		SANITARY SEWER AND WATERMAIN
		ELK LANE ~ 190TH LANE
DATE	MAY 1986	SHEET 7 OF 31 SHEETS
PROJECT NO.	230-020	

RECORD PLAN
DEC. 1986
Rev. 7