
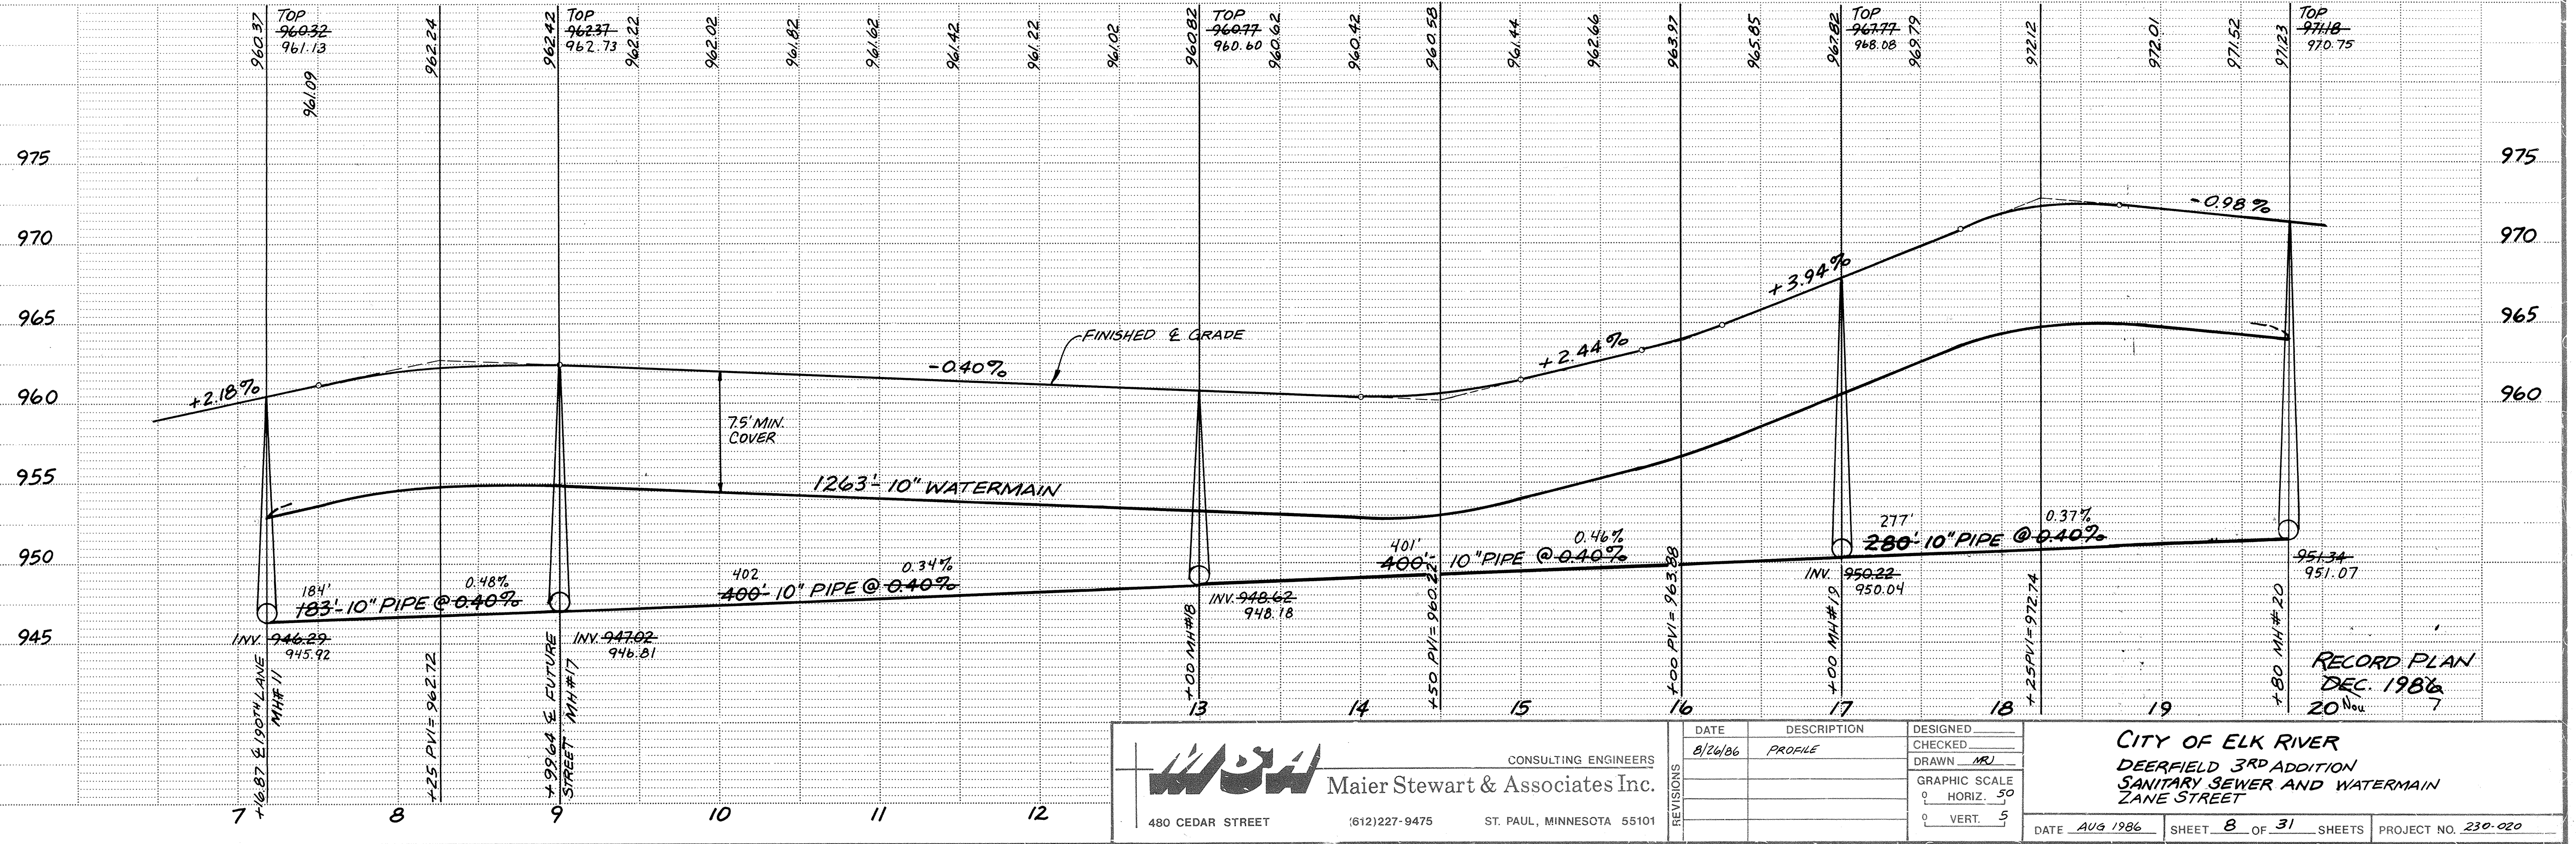


ZANE STREET

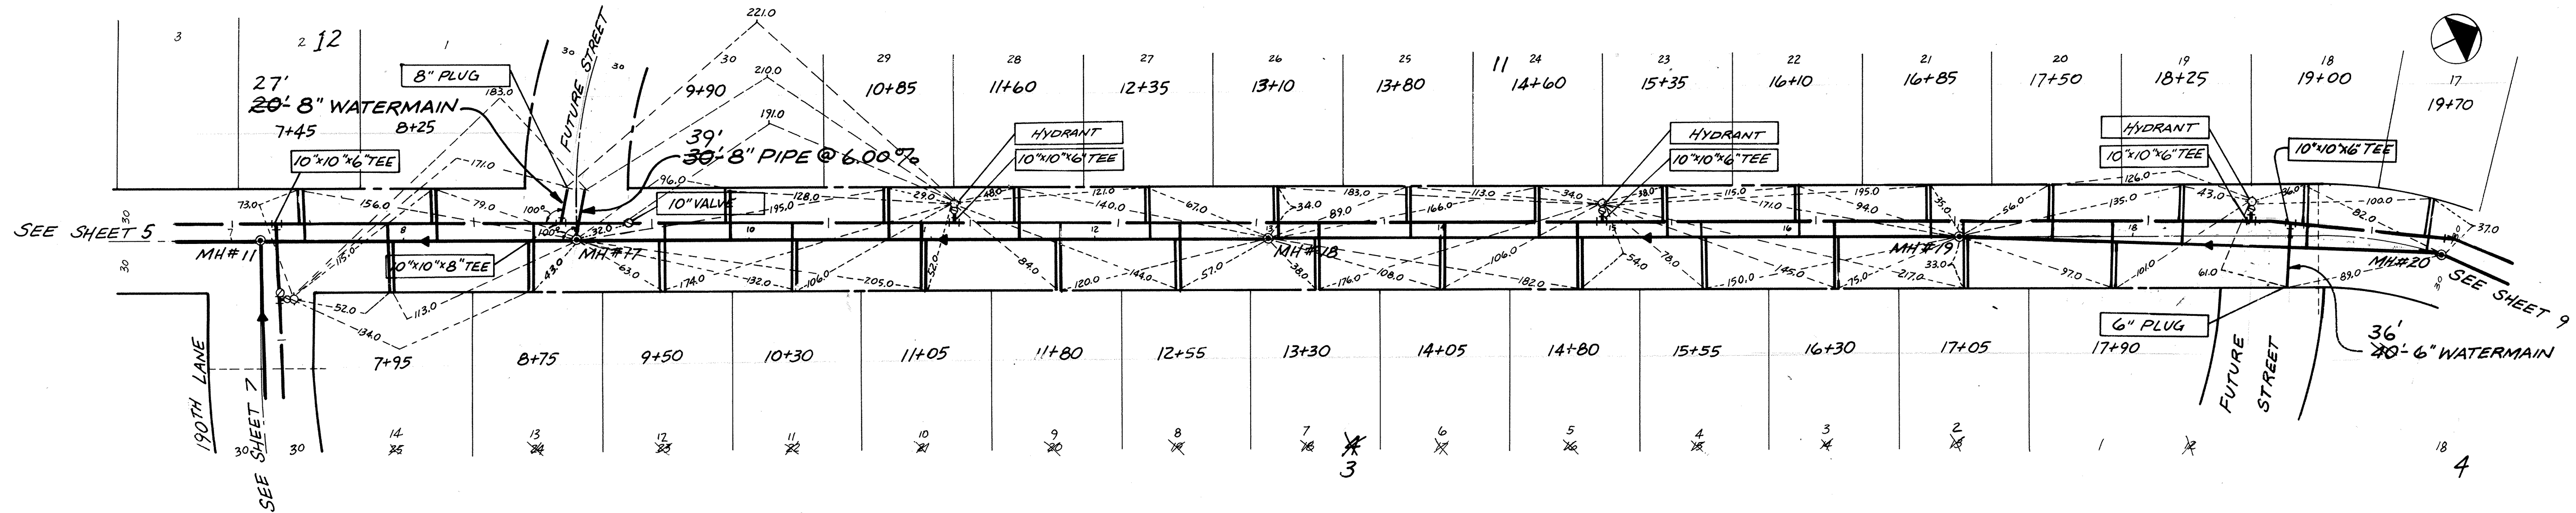

CONSULTING ENGINEERS
Maier Stewart & Associates Inc.
480 CEDAR STREET (612) 227-9475 ST. PAUL, MINNESOTA 55101

REVISIONS	DATE	DESCRIPTION	DESIGNED	CHECKED	DRAWN
	8/26/86	PROFILE			MRJ

CITY OF ELK RIVER DEERFIELD 3RD ADDITION SANITARY SEWER AND WATERMAIN ZANE STREET	
DATE AUG 1986	SHEET 8 OF 31 SHEETS
PROJECT NO. 230.020	

DRAWING NUMBER

DRAWING NUMBER

DRAWING NUMBER

DRAWING NUMBER
DEERF3.86