
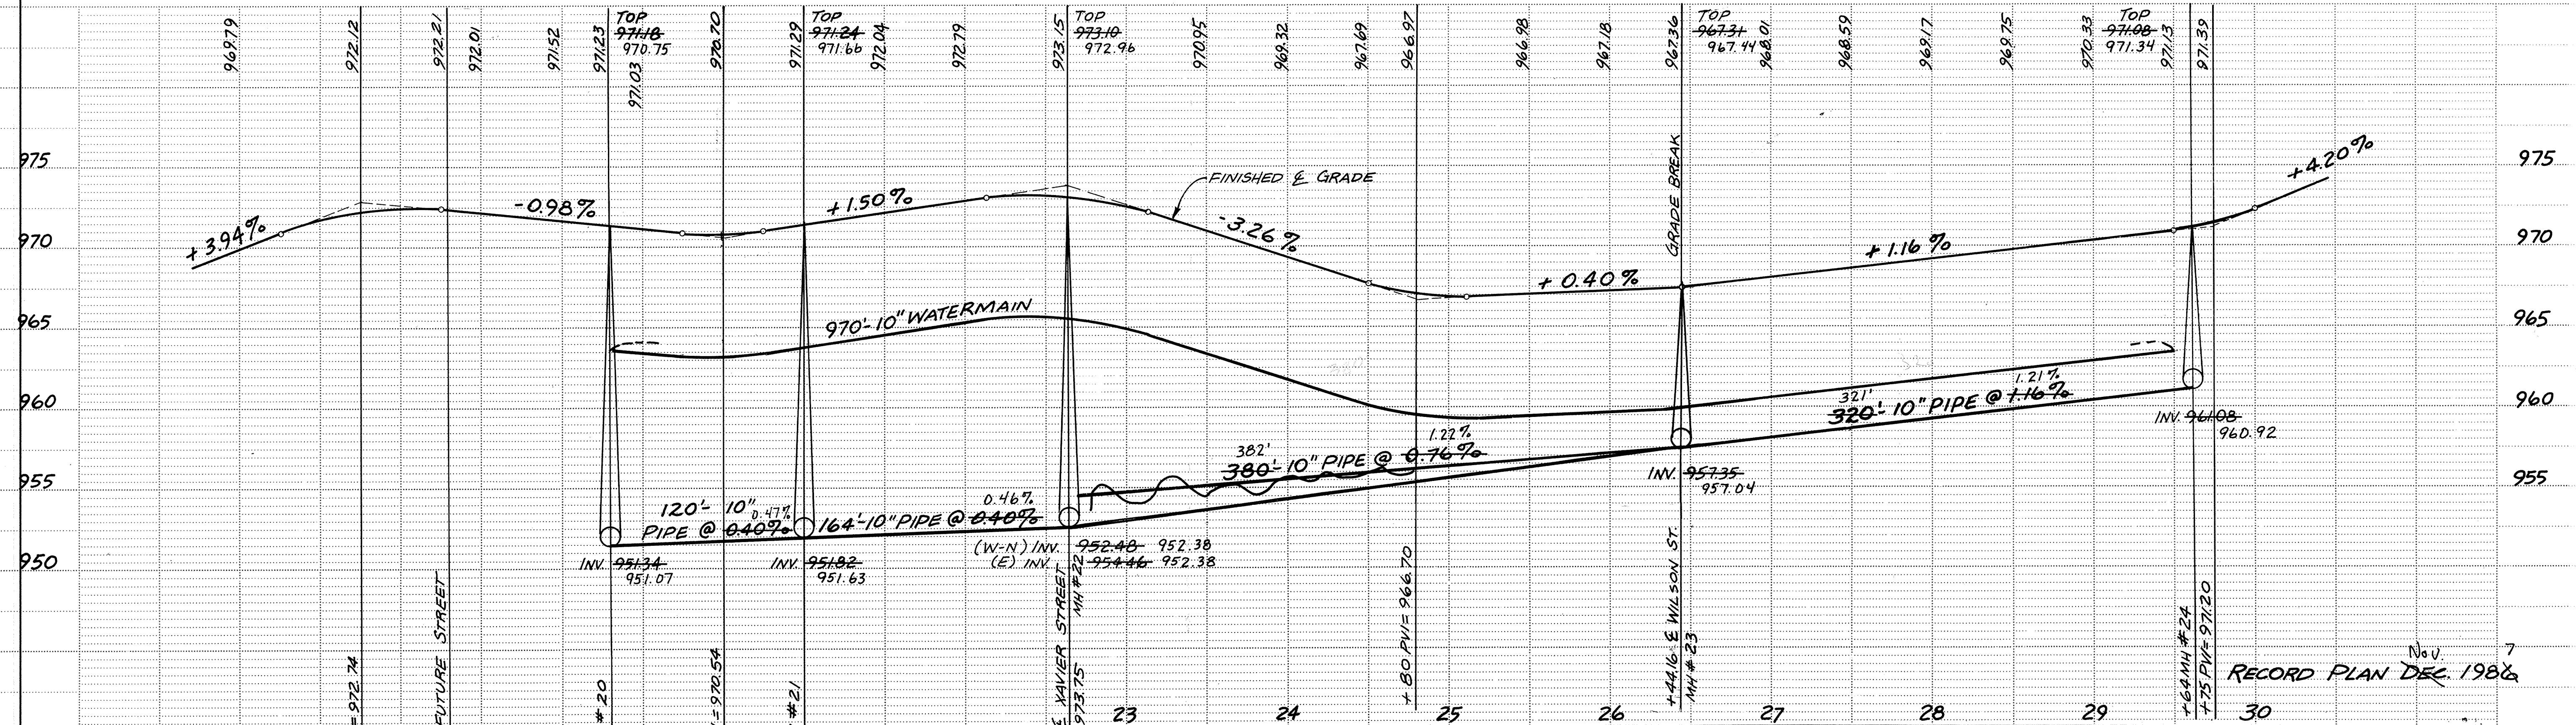


191ST AVENUE

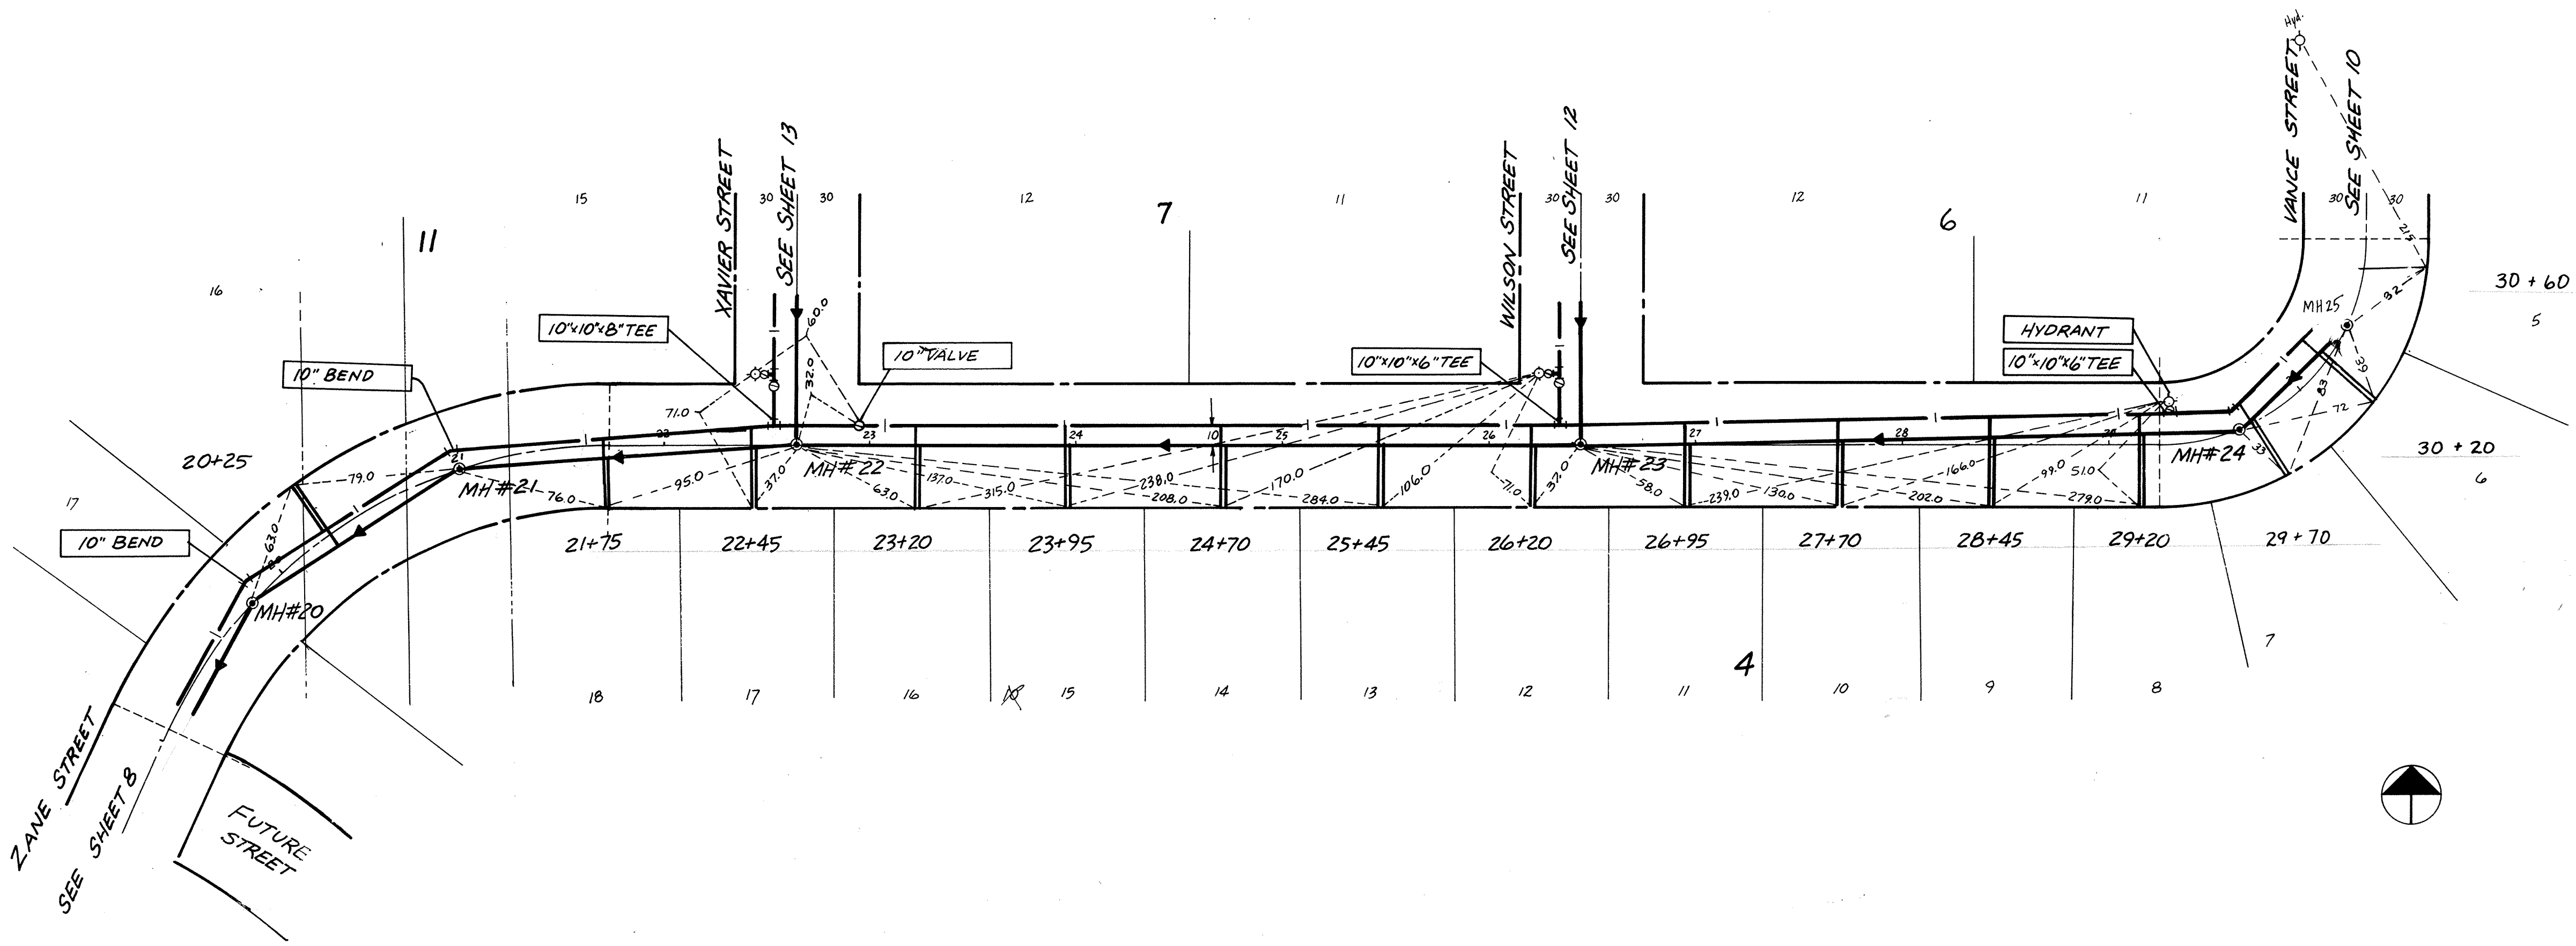

Maier Stewart & Associates Inc.
CONSULTING ENGINEERS
480 CEDAR STREET (612)227-9475 ST. PAUL, MINNESOTA 55101

DATE	DESCRIPTION	DESIGNED
8/24/86	PROFILE	CHECKED
		DRAWN <u>ARI</u>
		GRAPHIC SCALE
		0 HORIZ. 50
		0 VERT. 5

CITY OF ELK RIVER
DEERFIELD 3RD ADDITION
SANITARY SEWER AND WATERMAIN
191ST AVENUE
DATE MAY 1986 SHEET 9 OF 31 SHEETS PROJECT NO. 230-020