


DEERFIELD 3RD ADDITION

STORMWATER SYSTEM IMPROVEMENTS

I HEREBY CERTIFY THAT THIS PLAN, SPECIFICATION OR REPORT WAS PREPARED BY ME OR UNDER MY DIRECT SUPERVISION AND THAT I AM A DULY REGISTERED PROFESSIONAL ENGINEER UNDER THE LAWS OF THE STATE OF MINNESOTA.

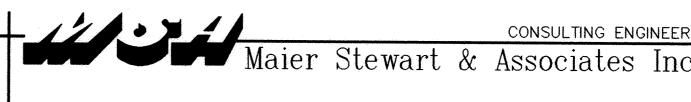

1326 ENERGY PARK DRIVE [612] 644-4389 9800 SHELARD PARKWAY [612] 546-0432

ST. PAUL, MINNESOTA 55108 MINNEAPOLIS, MINNESOTA 55441

PREPARED FOR:



1 of 7

RECORD PLAN AUGUST 1994

ER195-T

PLAN
1994